

APPROX. LIMIT OF CONSTRUCTION
STA. 9+91 GIDDINGS ST.

BM
CMS HH 24 (MDC)
NW CORNER NEW BRITAIN AVE.
EL. 55.087'

BM
PK IN HELCO POLE NO. 4289
EL. 57.447

CURB REMOVAL

LEFT OR WEST SIDE			RIGHT OR EAST SIDE		
TYPE OF CURB	FROM STATION	TO STATION	TYPE OF CURB	FROM STATION	TO STATION
CONCRETE	10+03.5	10+72	GRANITE	10+06.40	11+40
GRANITE	10+72	10+94			
CONCRETE	11+04	12+39.9			
GRANITE	12+39.9	12+85	CONCRETE	11+40	12+65.7
CONCRETE	12+85	13+00.5	GRANITE	12+65.7	12+81.7
GRANITE	13+00.5	13+47.7	CONCRETE	12+81.7	12+84.2
CONCRETE	13+47.7	13+83.4	GRANITE	12+84.2	12+94.5
GRANITE	13+83.4	14+23.8	CONCRETE	12+94.5	18+00.3

CONSTRUCT NEW 8" REINF. SIDEWALK RAMP
(TYPE I) RESET CURB

CONSTRUCT NEW 8" REINF. CONC. SIDEWALK RAMP
(TYPE 2). 5" CONC. WALK AND RESET RADIUS
GRANITE CURB

INSTALL 6" B.C.L.C. FROM STA. 10+03.56
TO STA. 14+00 (EXCEPT DRIVEWAYS)

IT EXCAVATION 12" TRAPROCK BASE, 3% PREMIX
BINDER, 1/2" SURFACE INSTALL GEOTEXTILE FABRIC, ETC.

STRIP EXIST. BIT. CONC. CONSTRUCT 2" PREMIXED
CONC. BINDER COURSE AND 2" BIT. CONC. SUR-
FACE COURSE (CLASS 1) STA. 9+91 TO STA. 14+00

R=12.00'
L=18.60'
Δ=87°15'30.00"
T=11.40'

R=12.00'
L=19.30'
Δ=92°44'40.00"
T=11.50'

AVE.
E 159000

CMS-1
N 139390.9800
E 559016.6633

PT.
EL. 54.59 G

EL. 54.69 G

PC STA. 10+03.56
EL. 54.79 G

PC STA. 10+06.40
EL. 54.75 G

EL. 55.14 G

PT.
EL. 55.53 G

E 159100

NEW BRITAIN
N 139400


INSTALL STOP BAR
(12" WHITE PREFORMED PLASTIC
PAVEMENT MARKINGS)

INSTALL 6" B.C.L.C. FROM STA. 10+06.40
TO STA. 14+00 (EXCEPT DRIVEWAYS)

PLAN

NOTE:
TOP OF PROP. CURB SHALL FOLLOW 6"
ABOVE GUTTER GRADE (TYP.)

APPROX. LIMIT OF CONSTRUCTION
STA. 9+91 GIDDINGS STREET

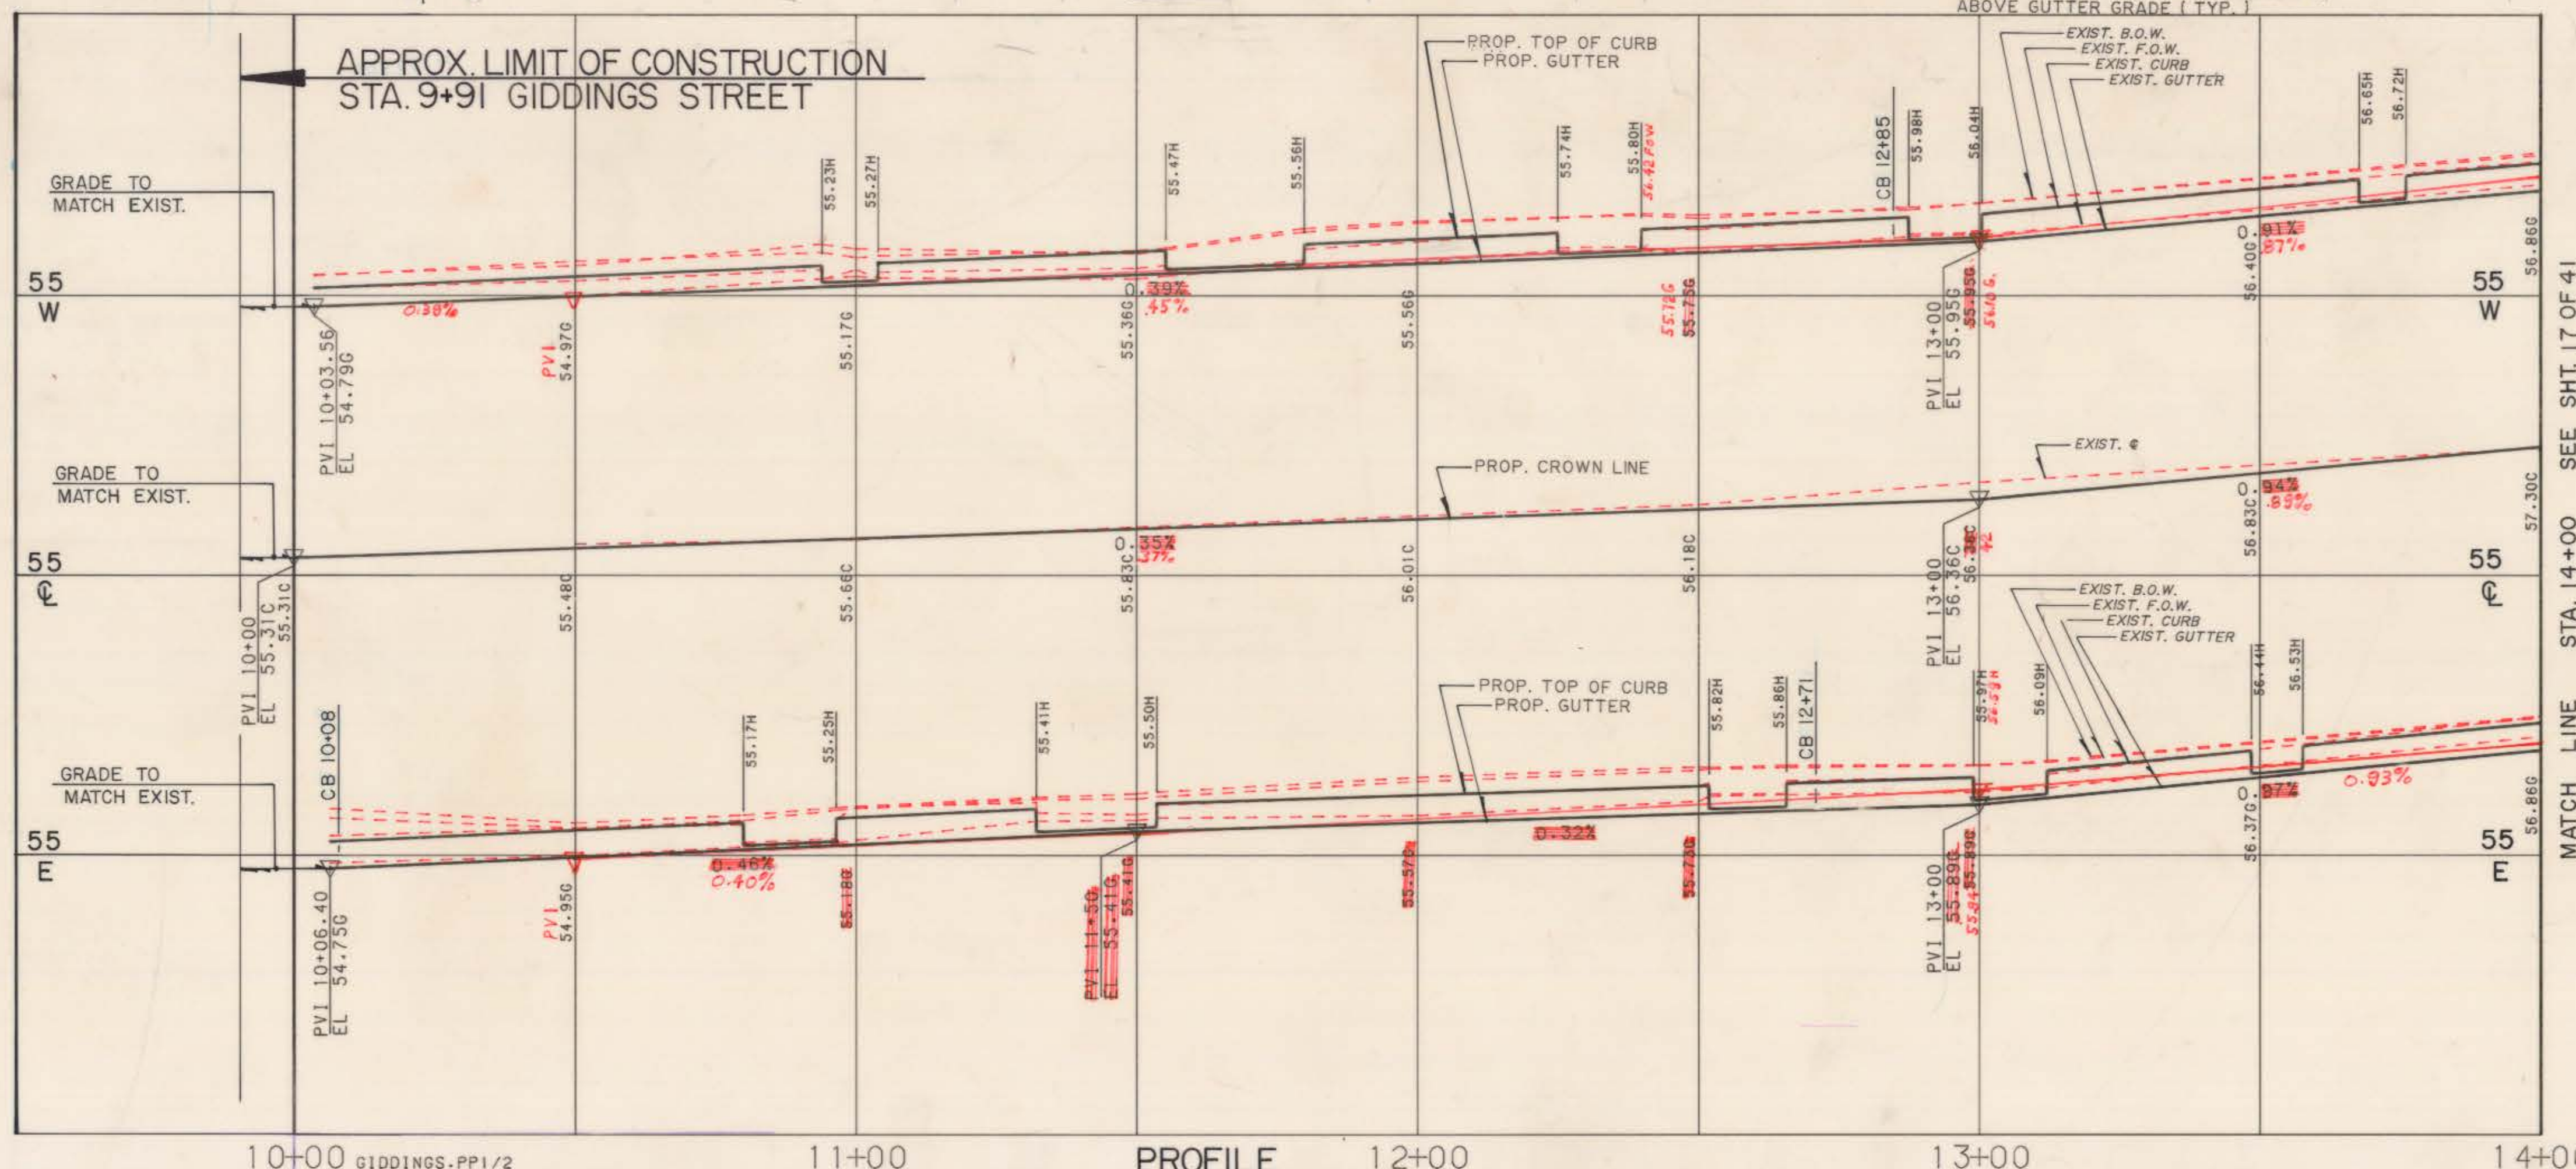

NOTE: CHECK GRAPHIC SCALES BEFORE USING DRAWINGS

SUPV. JAC		
DESIGN MDH/AEC		
DRAWN N.D.FORTIN		
CHECKED JAC		
DATE 02/01/86		
NO.	DATE	DESCRIPTION
REVISIONS		

GRAPHIC SCALES
HORIZ. 1"=20'
VERT. 1"=2'

ROADWAY RECONSTRUCTION
HARTFORD, CONNECTICUT



Hayden | Wegman
Consulting Engineers

WEST HARTFORD
NEW YORK • BOSTON • BUFFALO
ATLANTA • MEMPHIS

CITY OF HARTFORD, CONNECTICUT
DEPARTMENT OF PUBLIC WORKS
BUREAU OF ENGINEERING SERVICES

DAYBOOK NO. 011005

DATE

GIDDINGS STREET
STA. 10+00 TO STA. 14+00

PLAN AND PROFILE

Contract No. E86-2 Job No. 852534

SHEET 16

OF 41

515/A Z