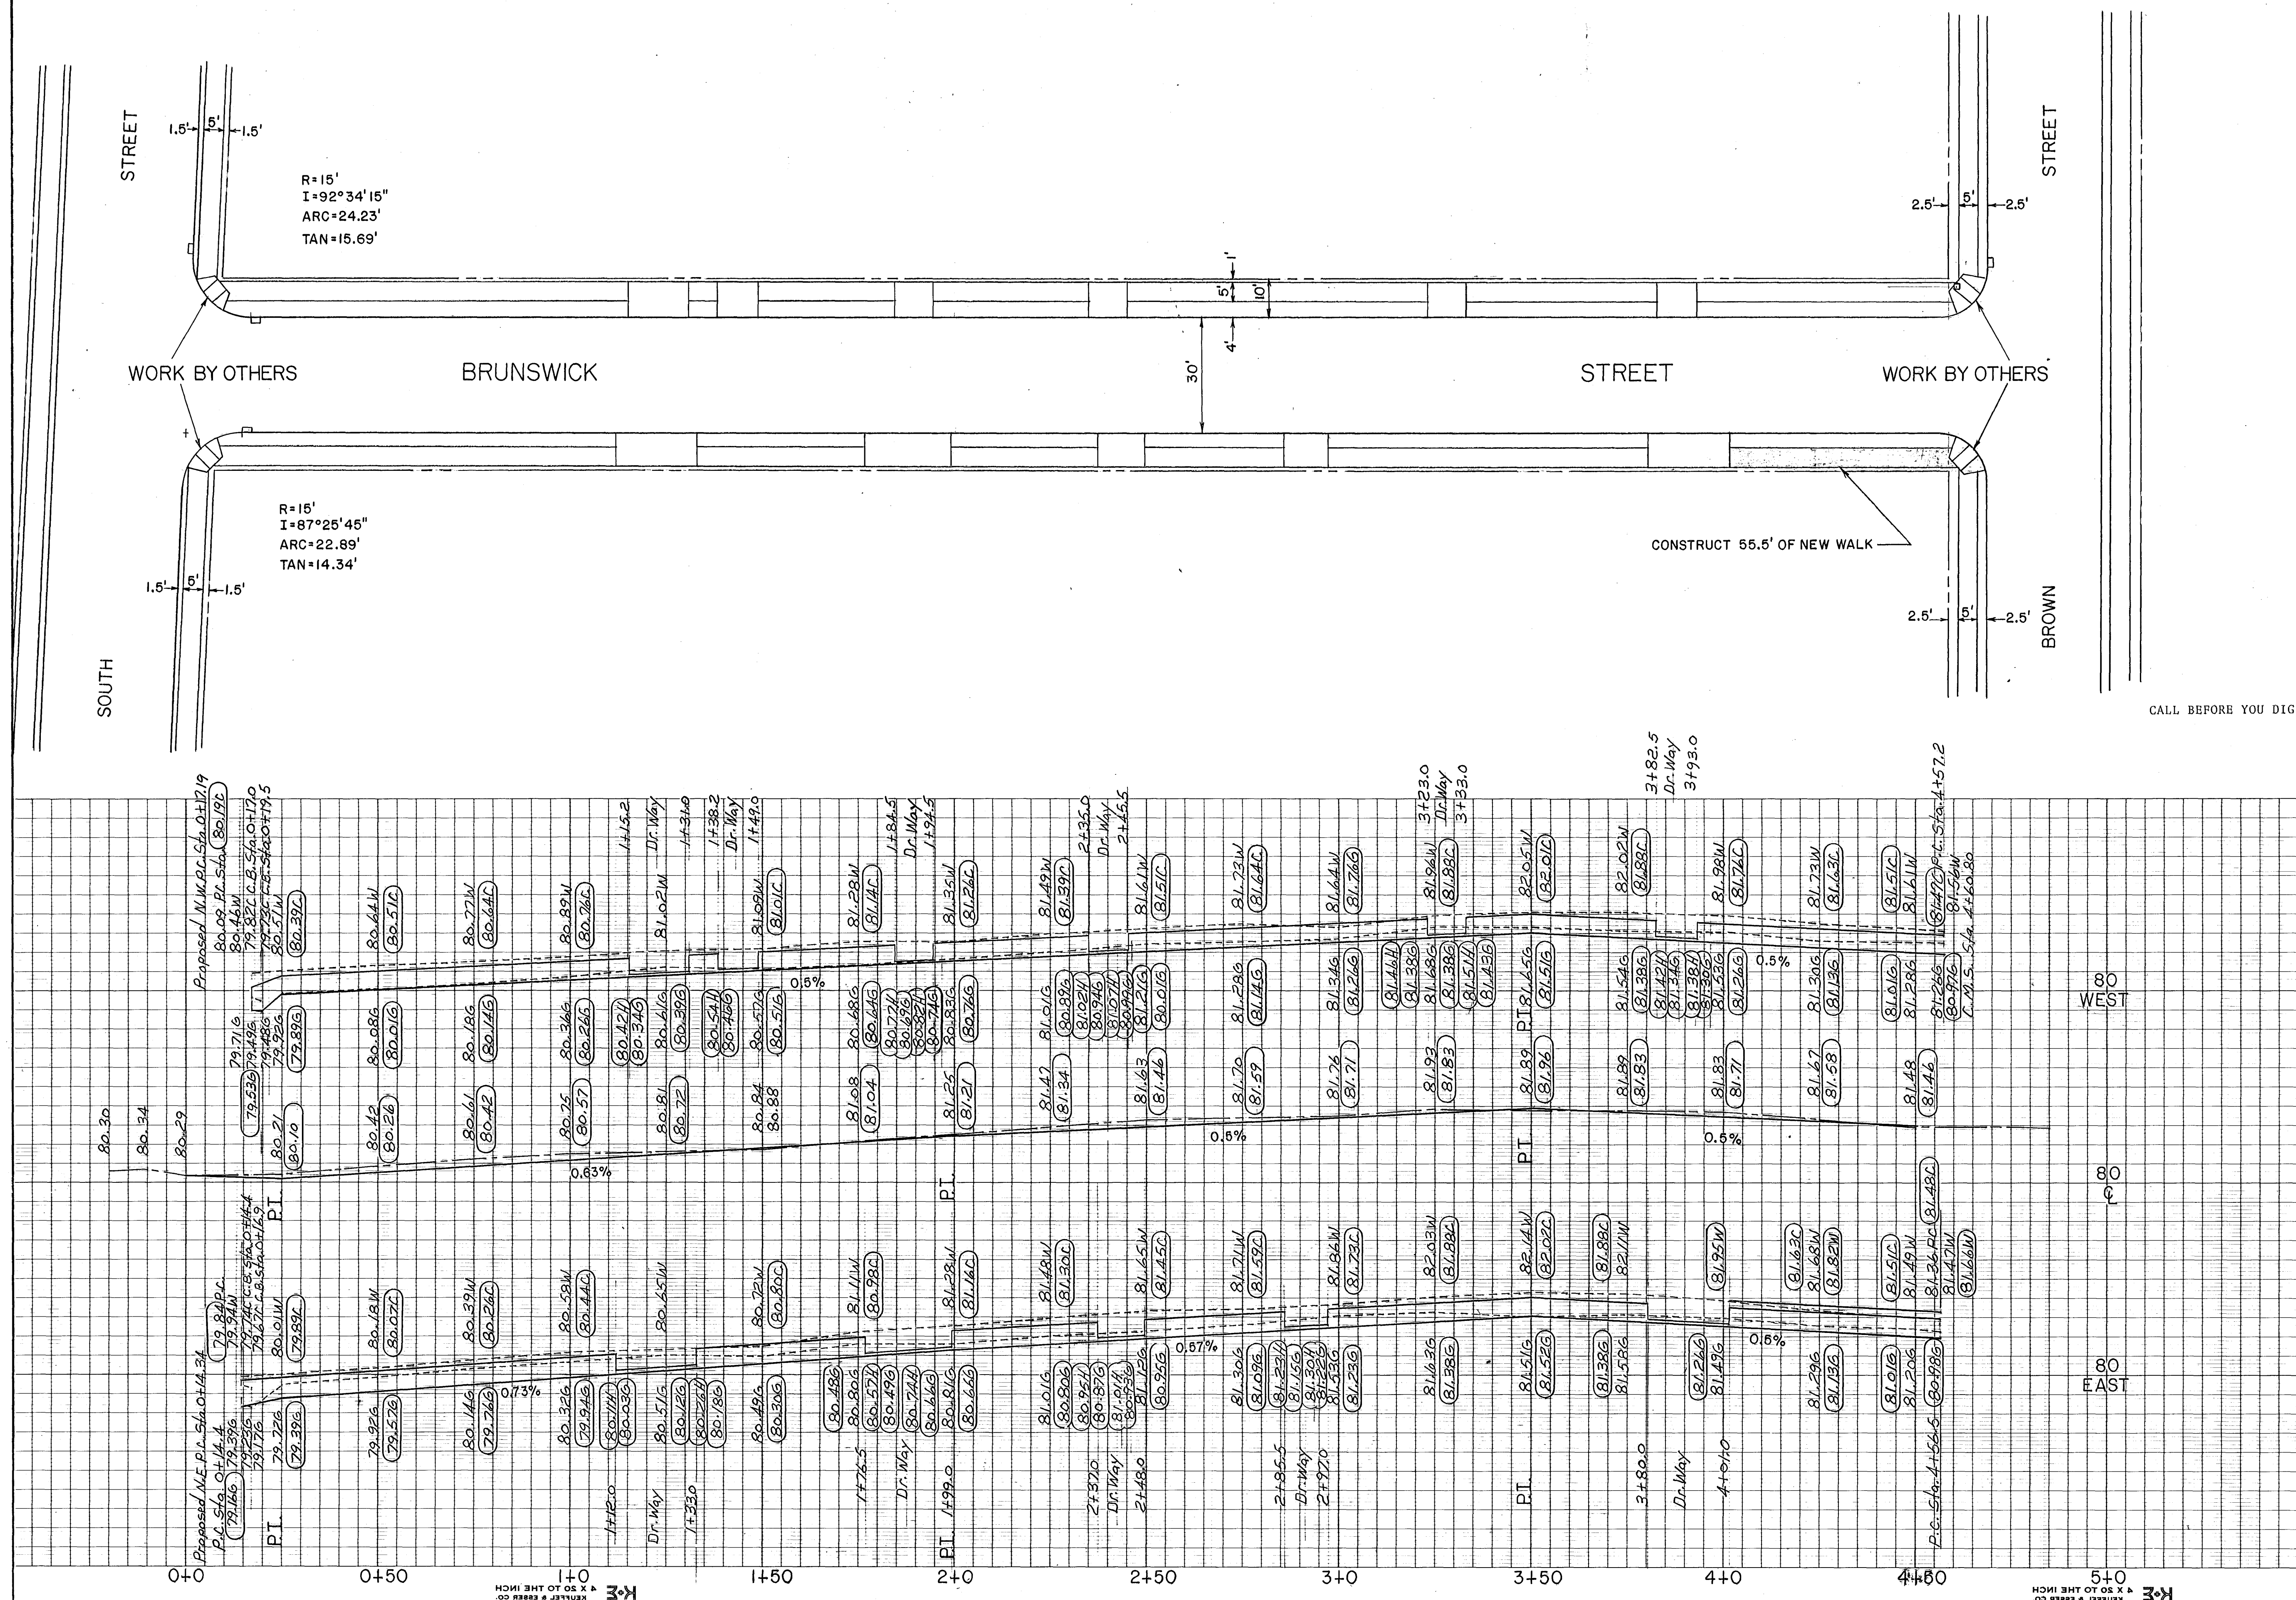


CALL BEFORE YOU DIG - The contractor is hereby reminded that Title 16 Chapter 293 of the Connecticut General Statutes requires notification to Utility public companies of pending excavation at or near public utilities. The contractor shall call 1-800-922-4455 at least 48 hours prior to excavation.

CITY OF HARTFORD, CONNECTICUT DEPARTMENT OF PUBLIC WORKS BUREAU OF ENGINEERING SERVICES		
PLAN & PROFILE OF BRUNSWICK STREET		
SUBMITTED	RECOMMENDED	APPROVED
PROJECT ENGINEER	DIVISION MANAGER	CITY ENGINEER, ESB
DRAWN LAL	SCALE 1"=20' HOR. 1"=2' VERT.	DAYBOOK NO. 011191
CHECKED RA		DATE JUNE 1985