
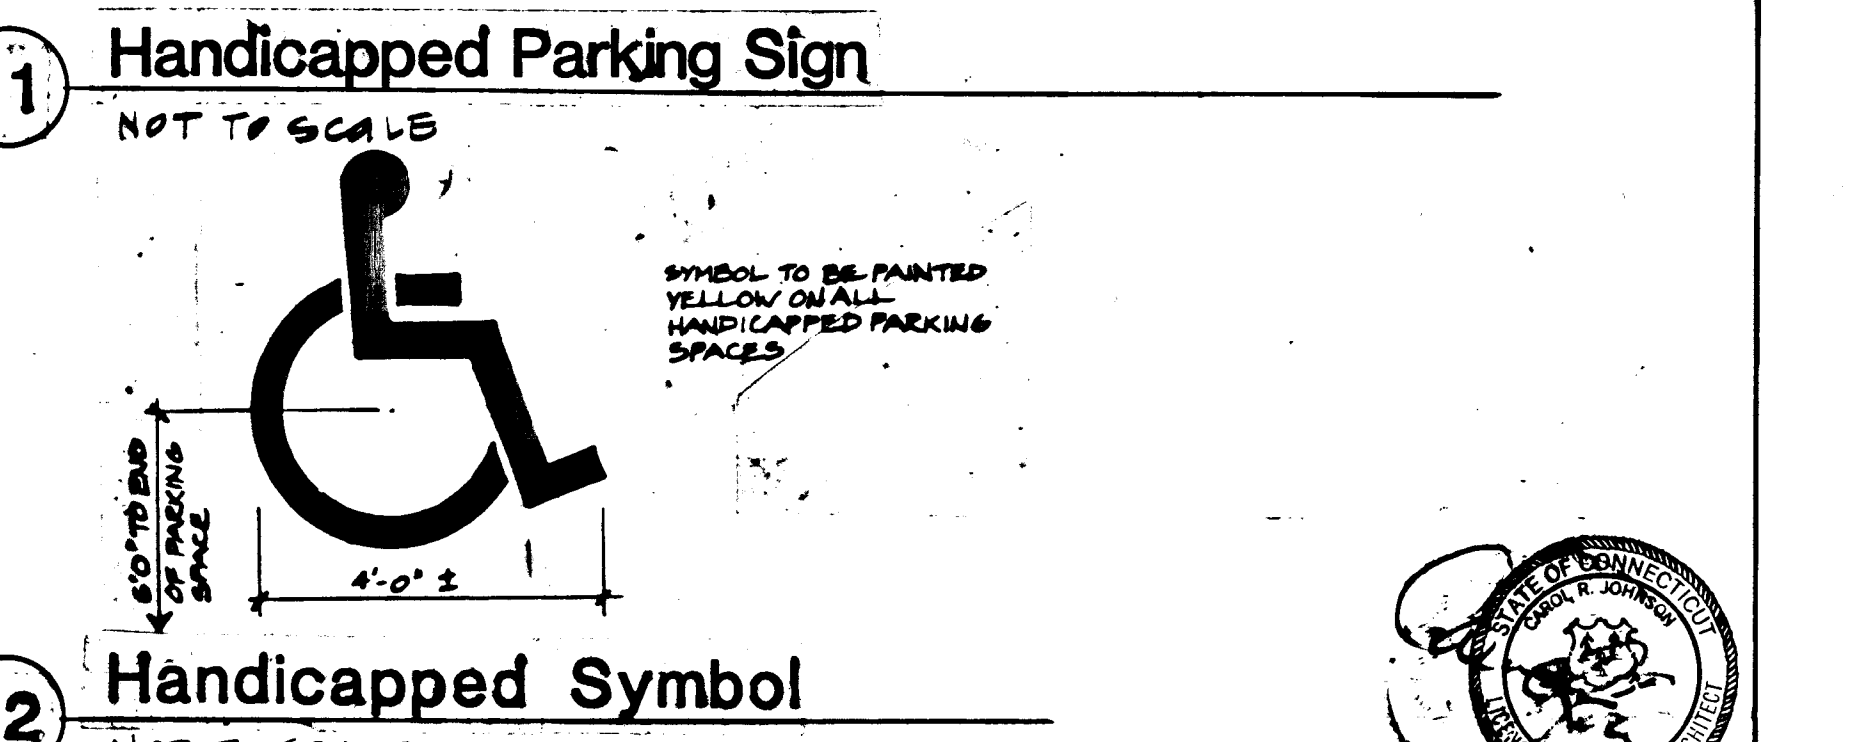
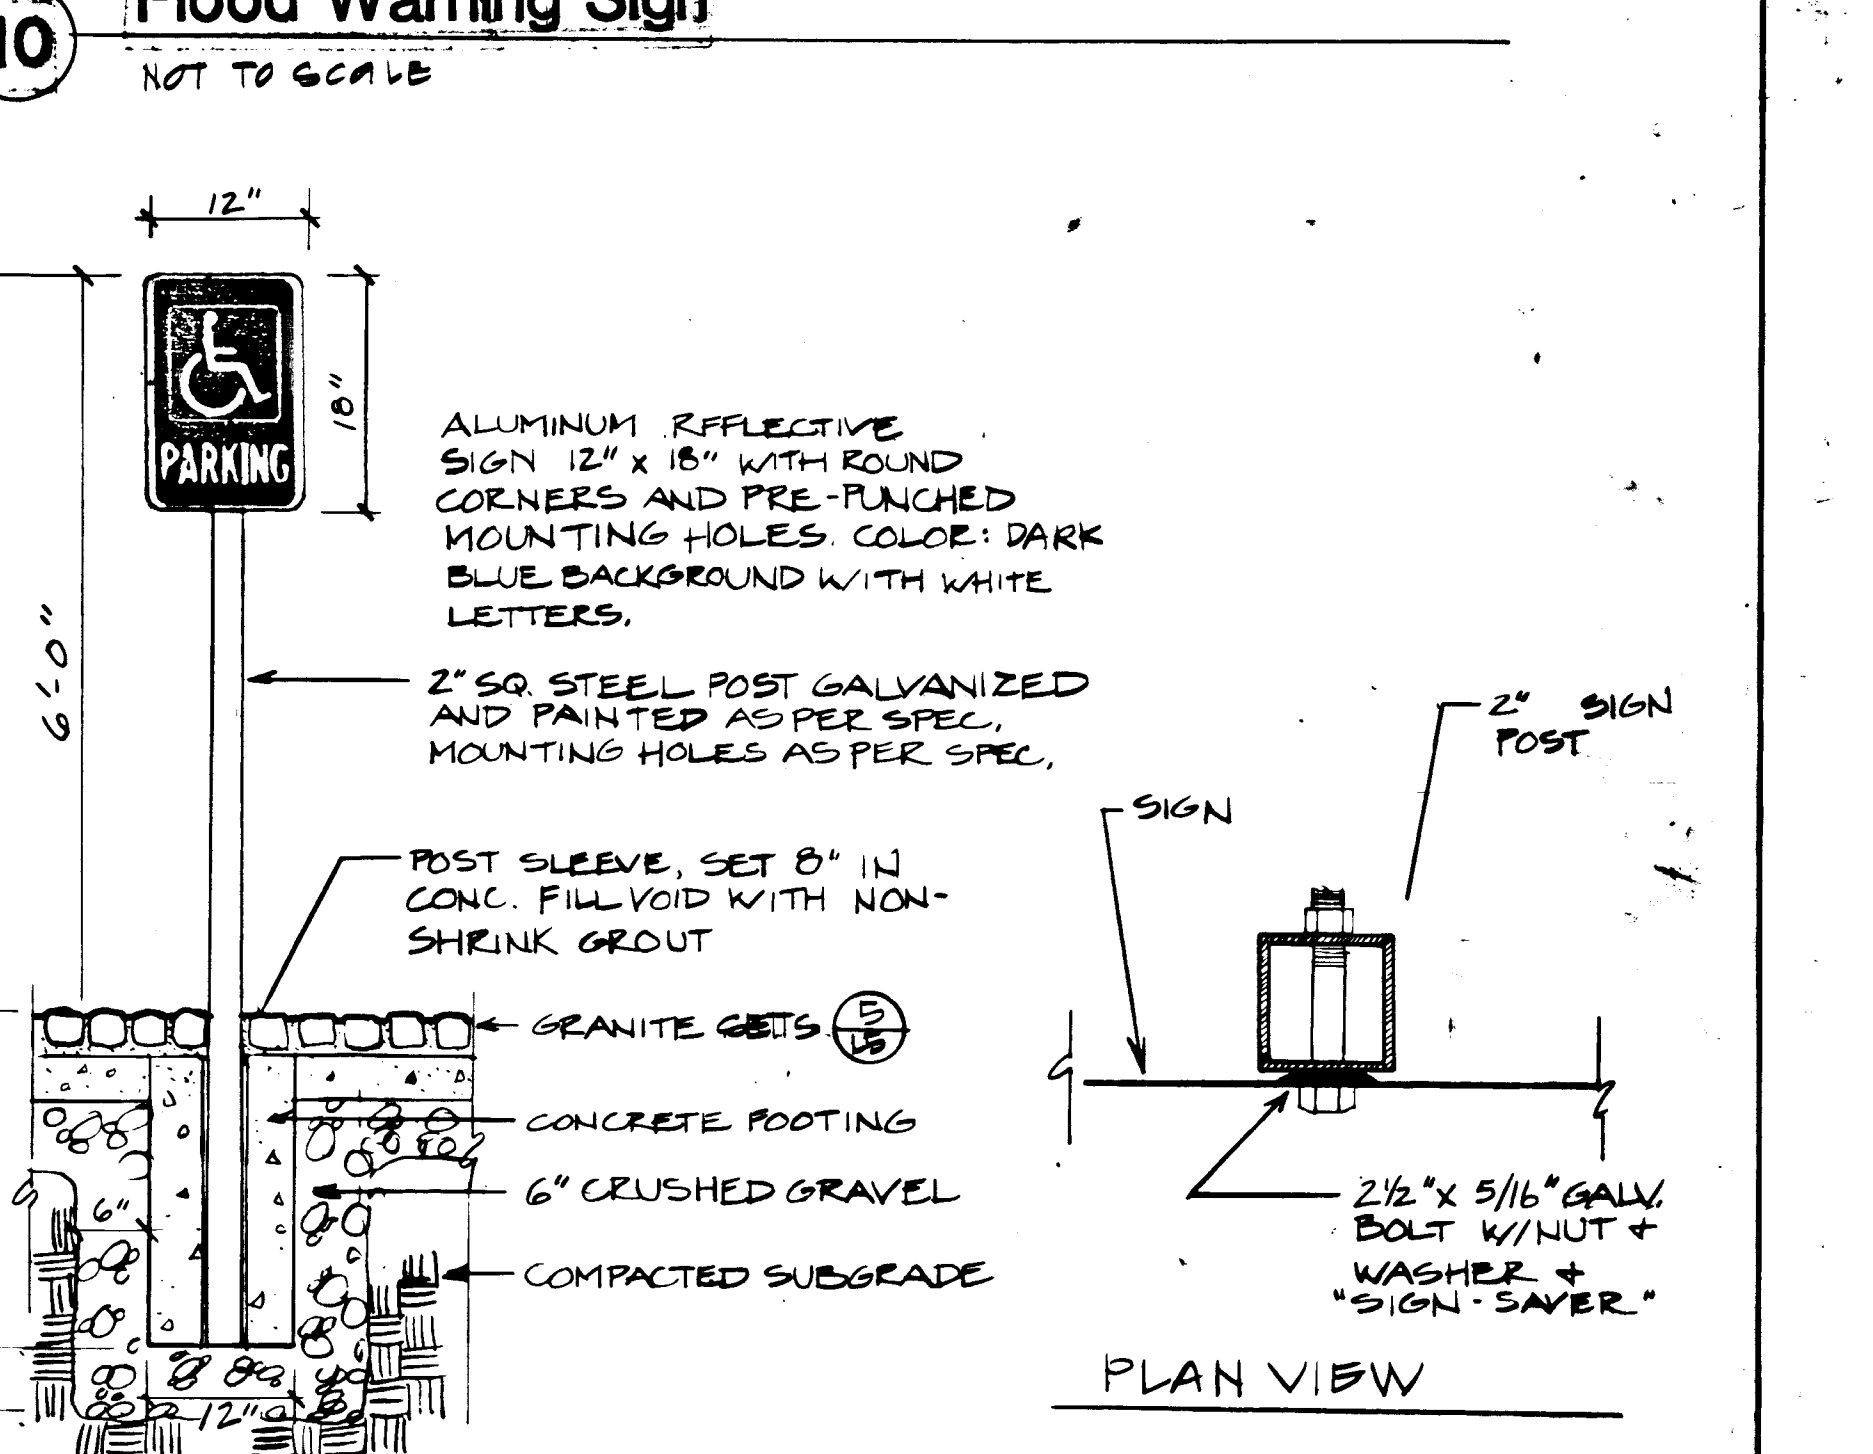
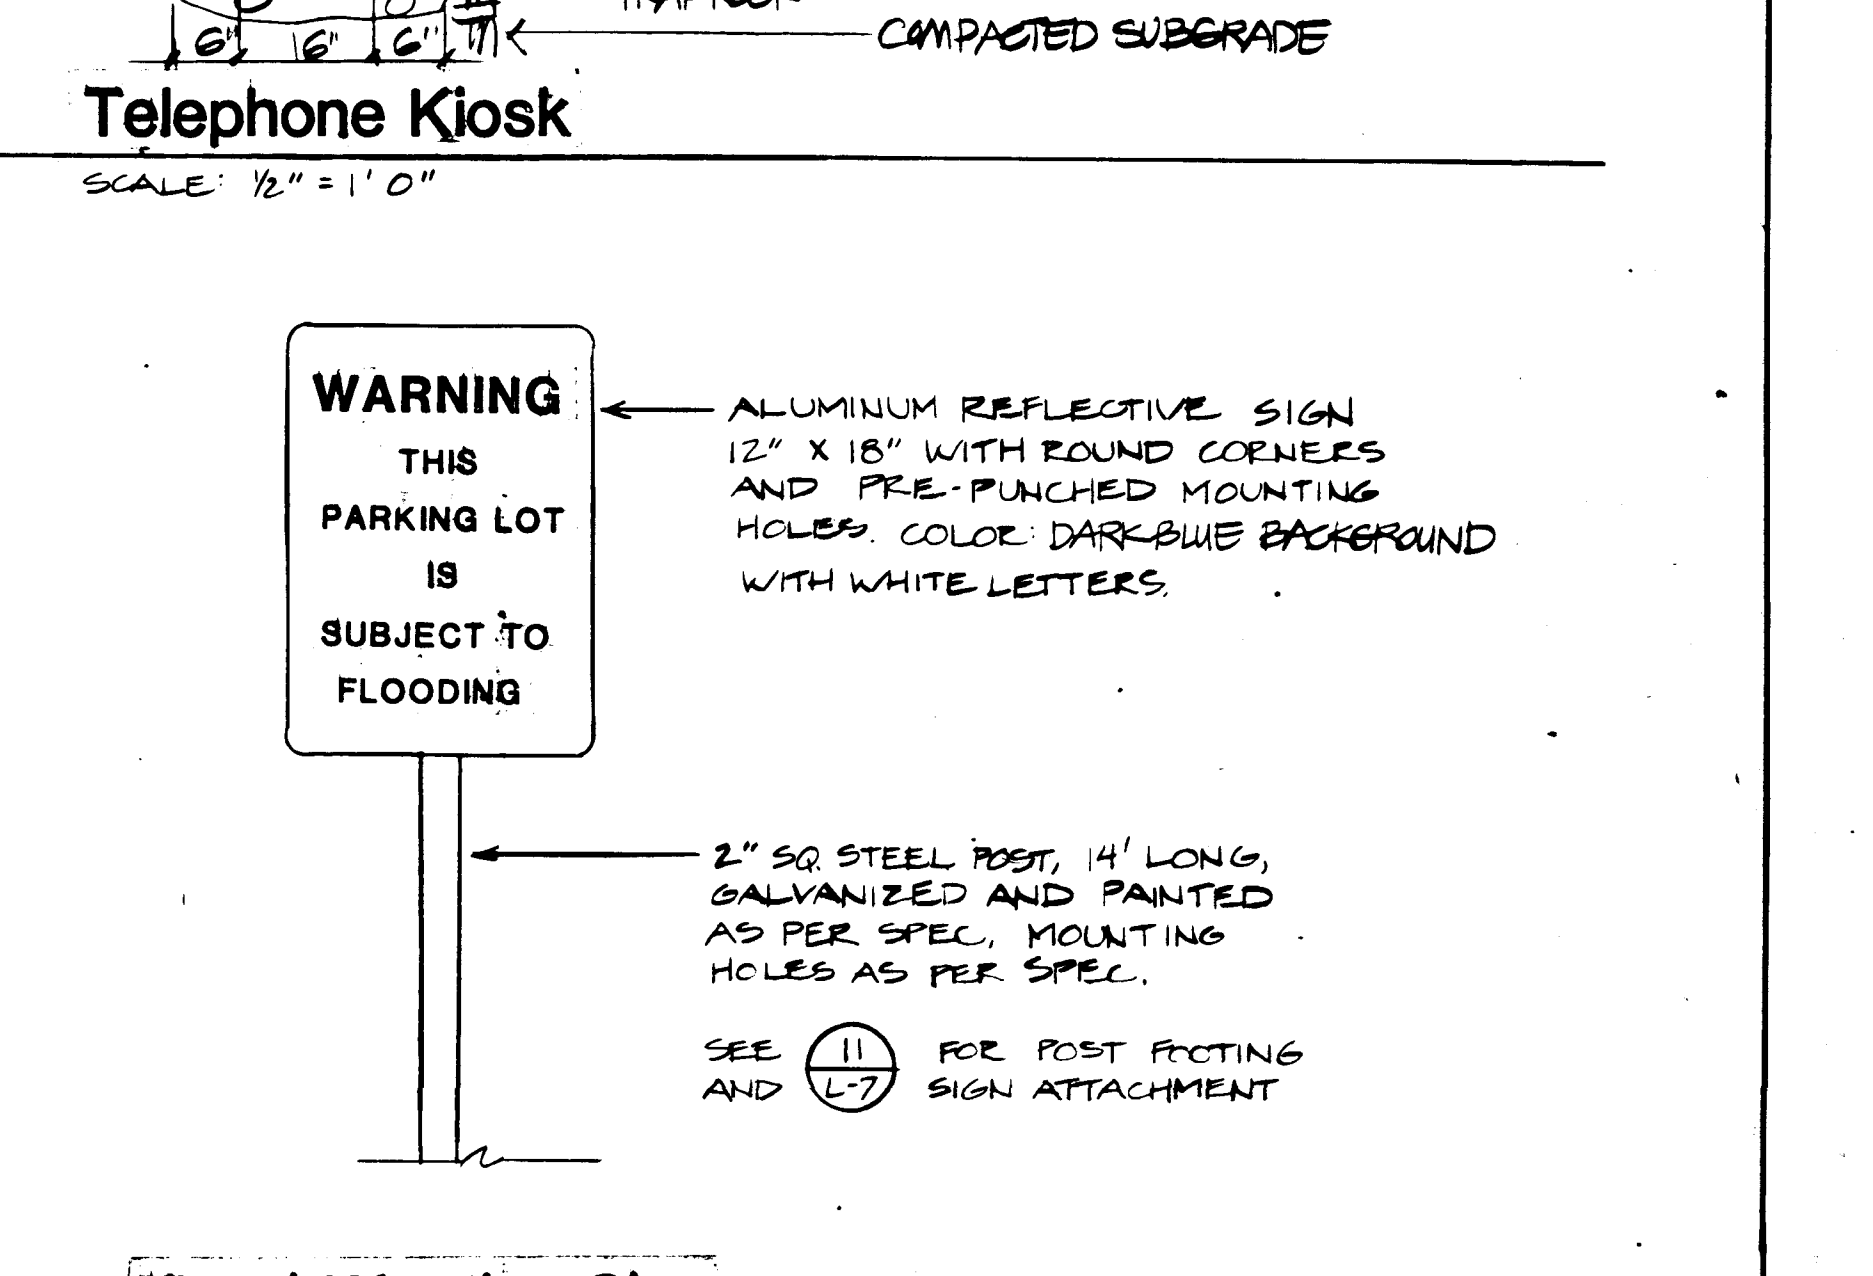
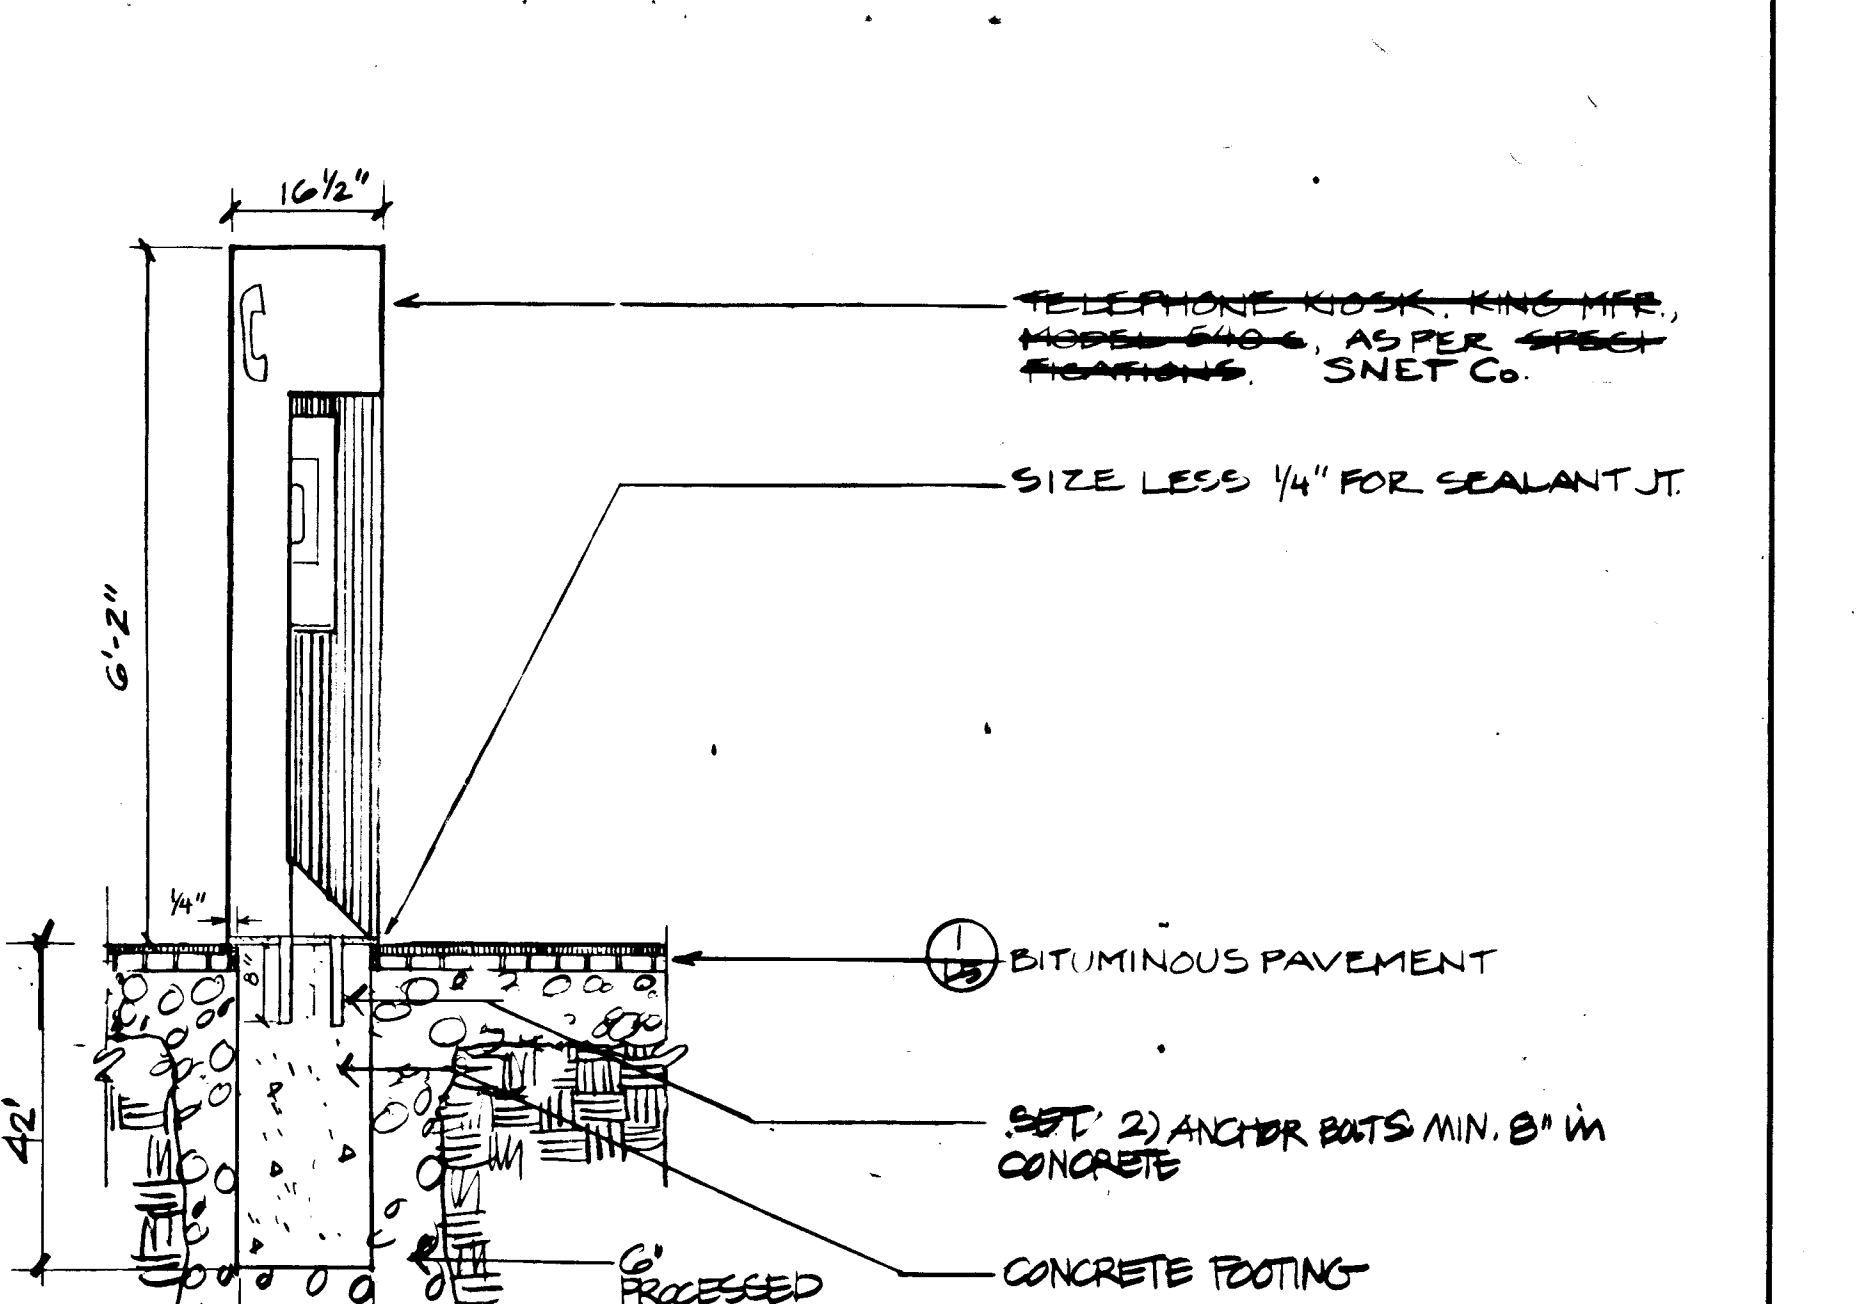
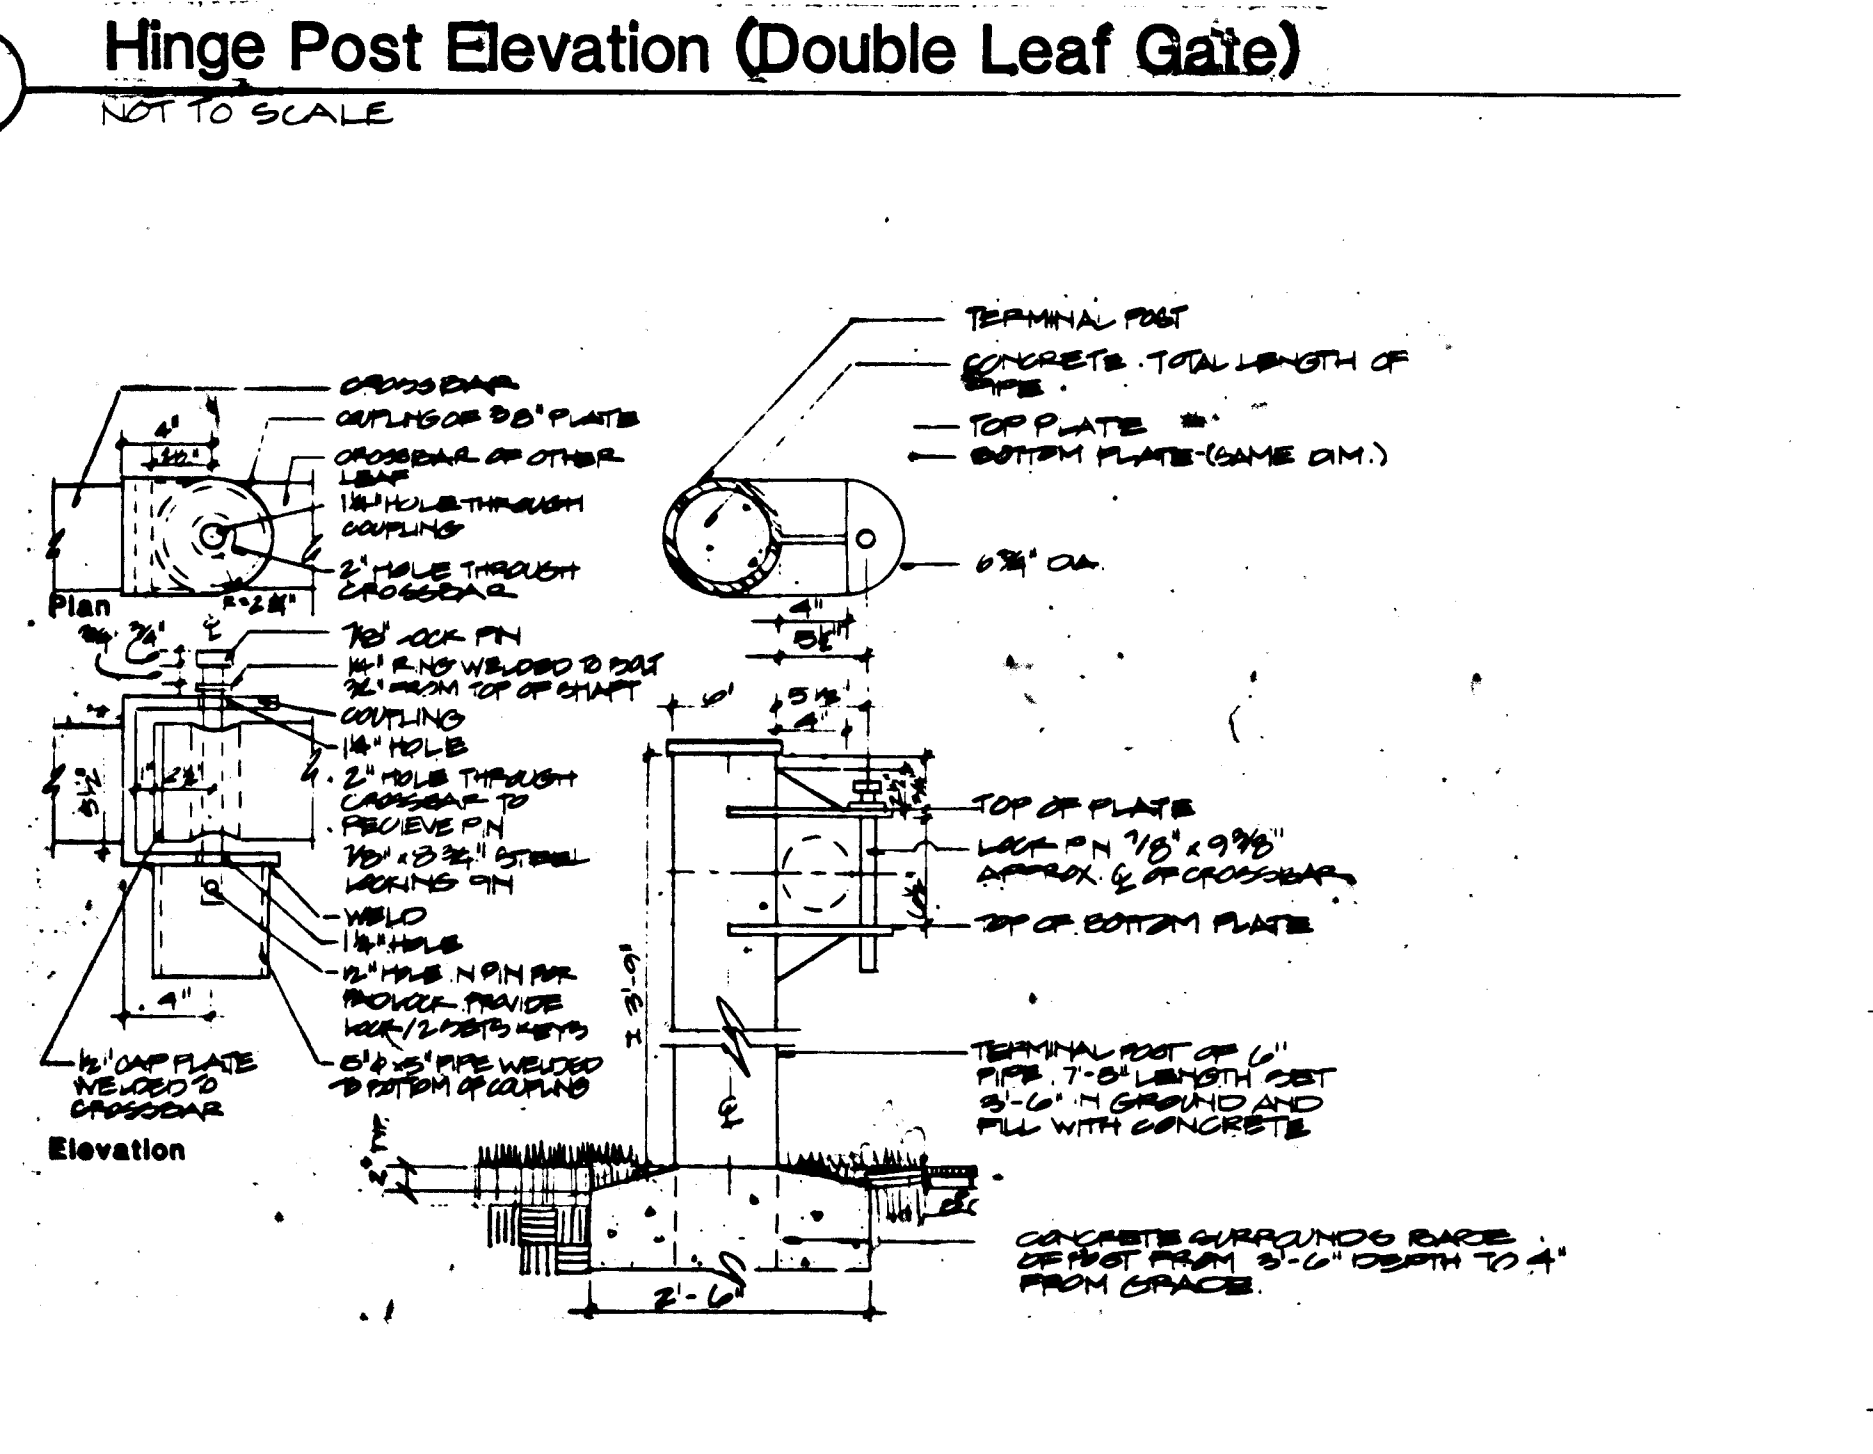
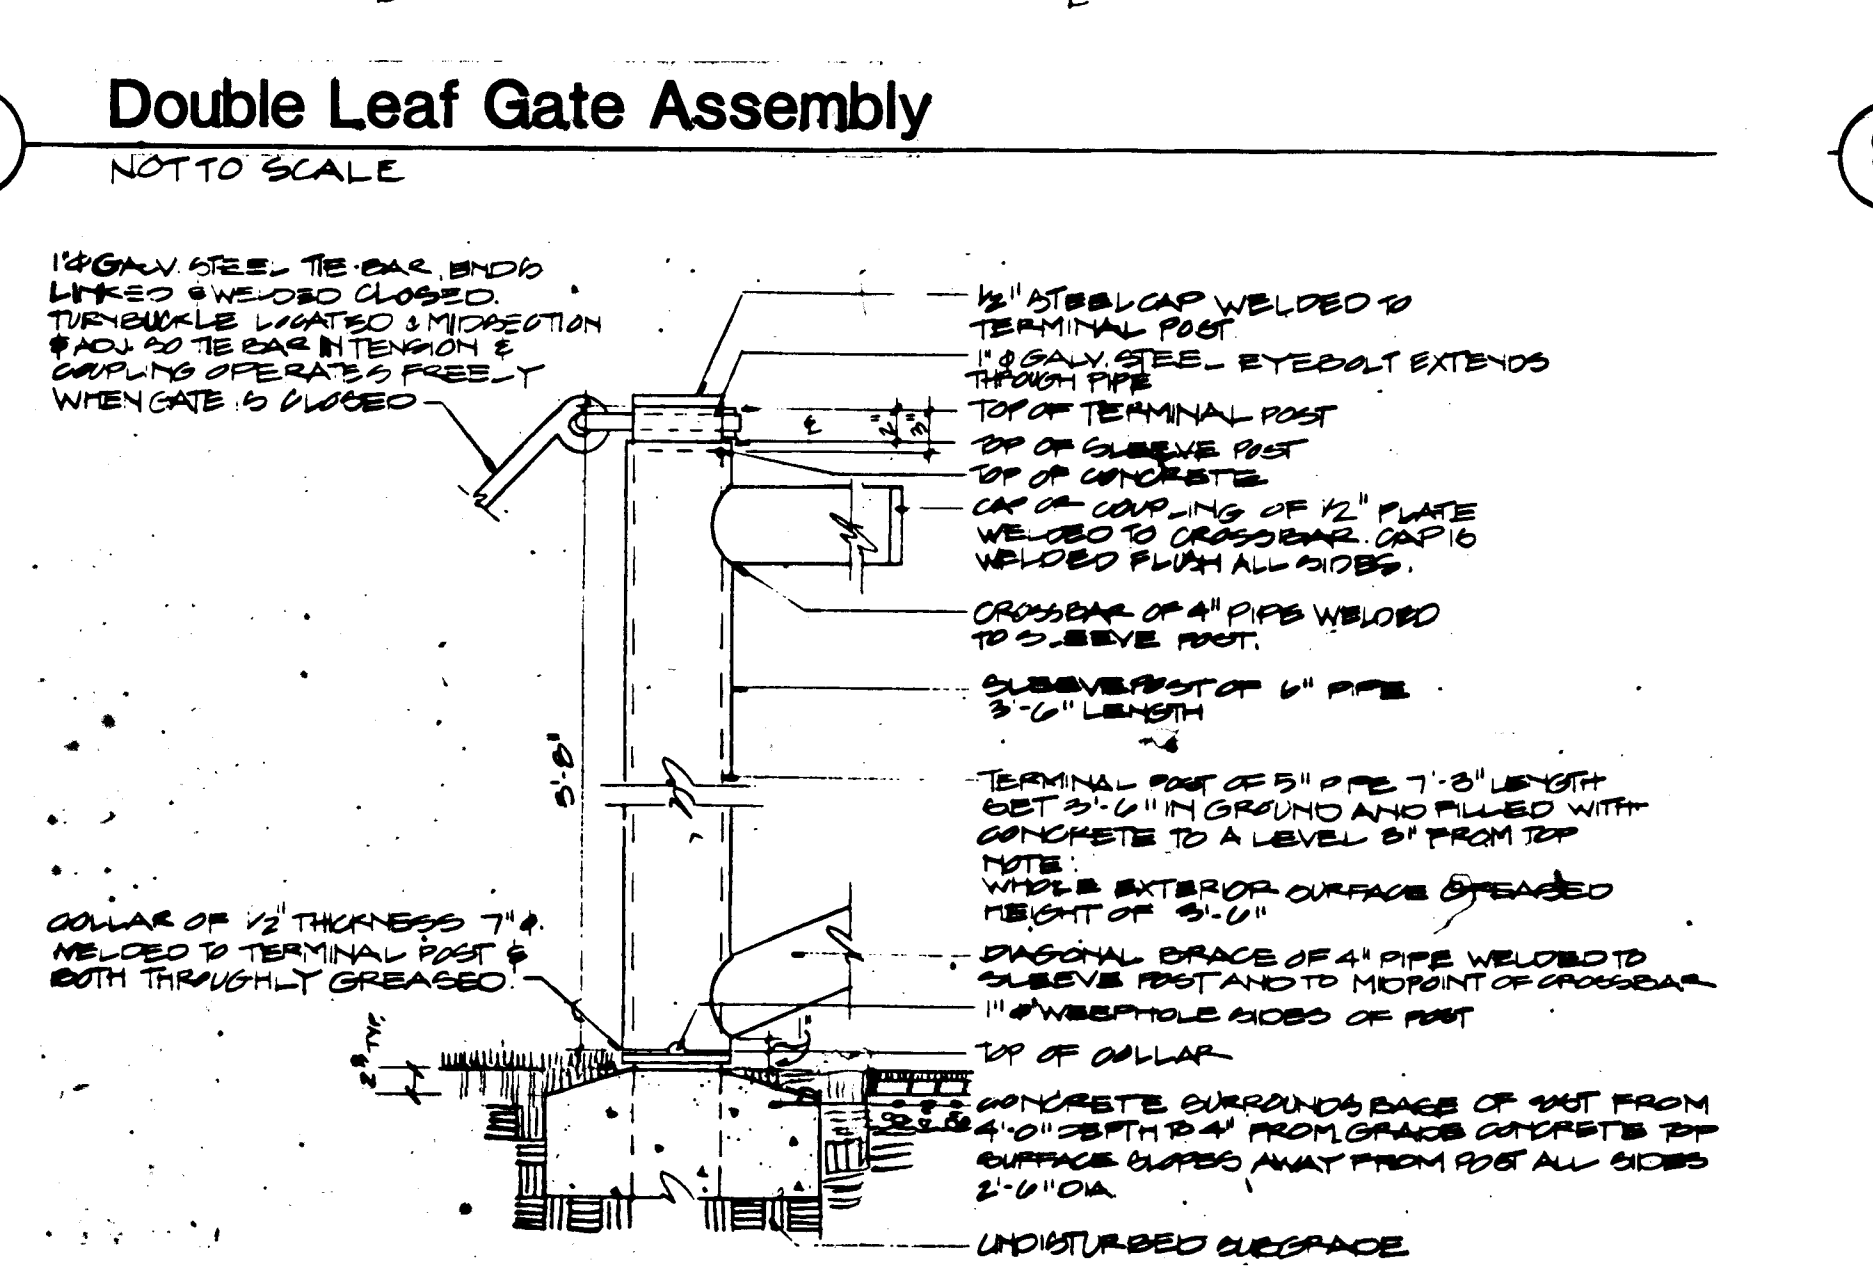
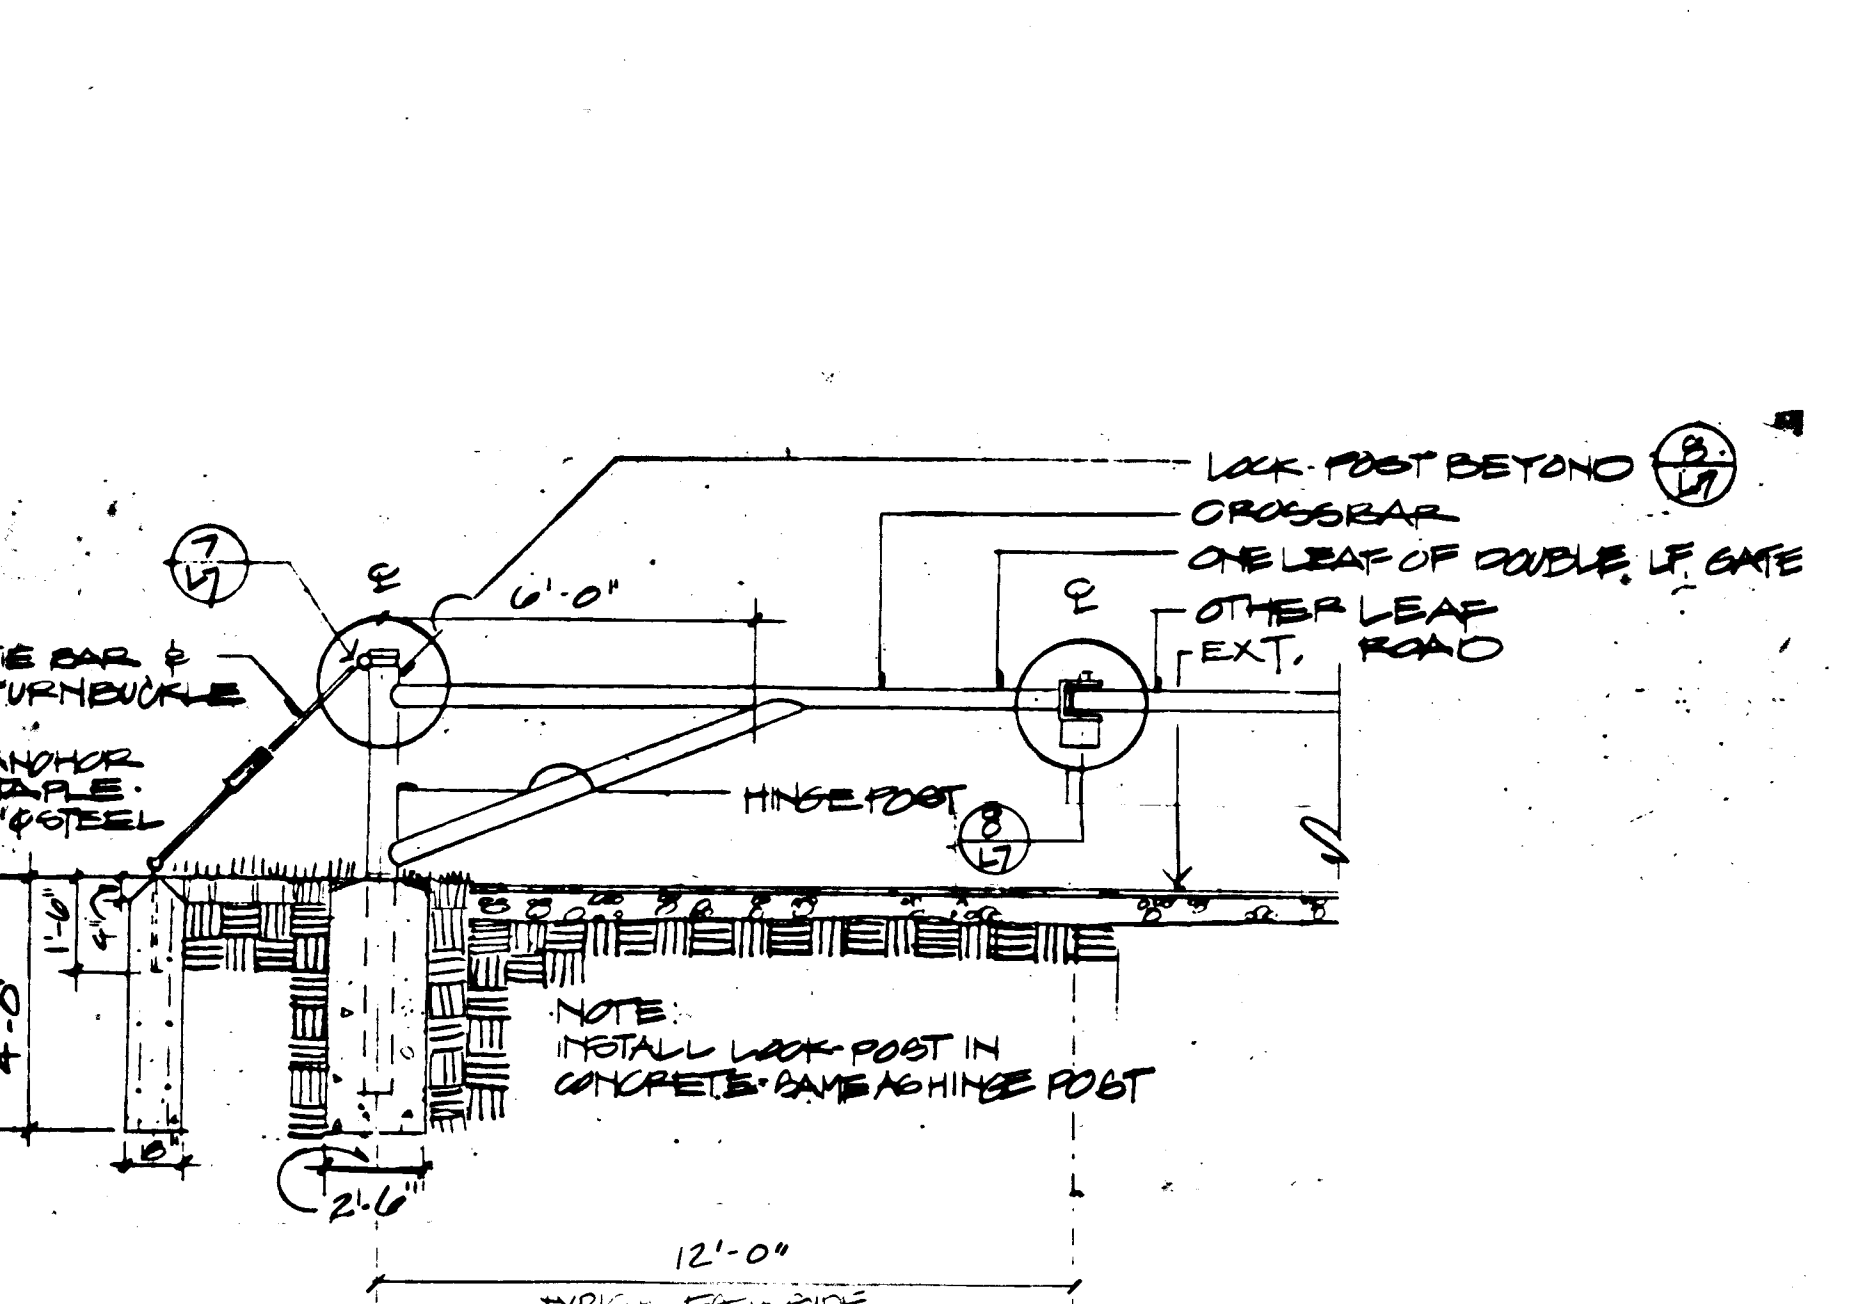
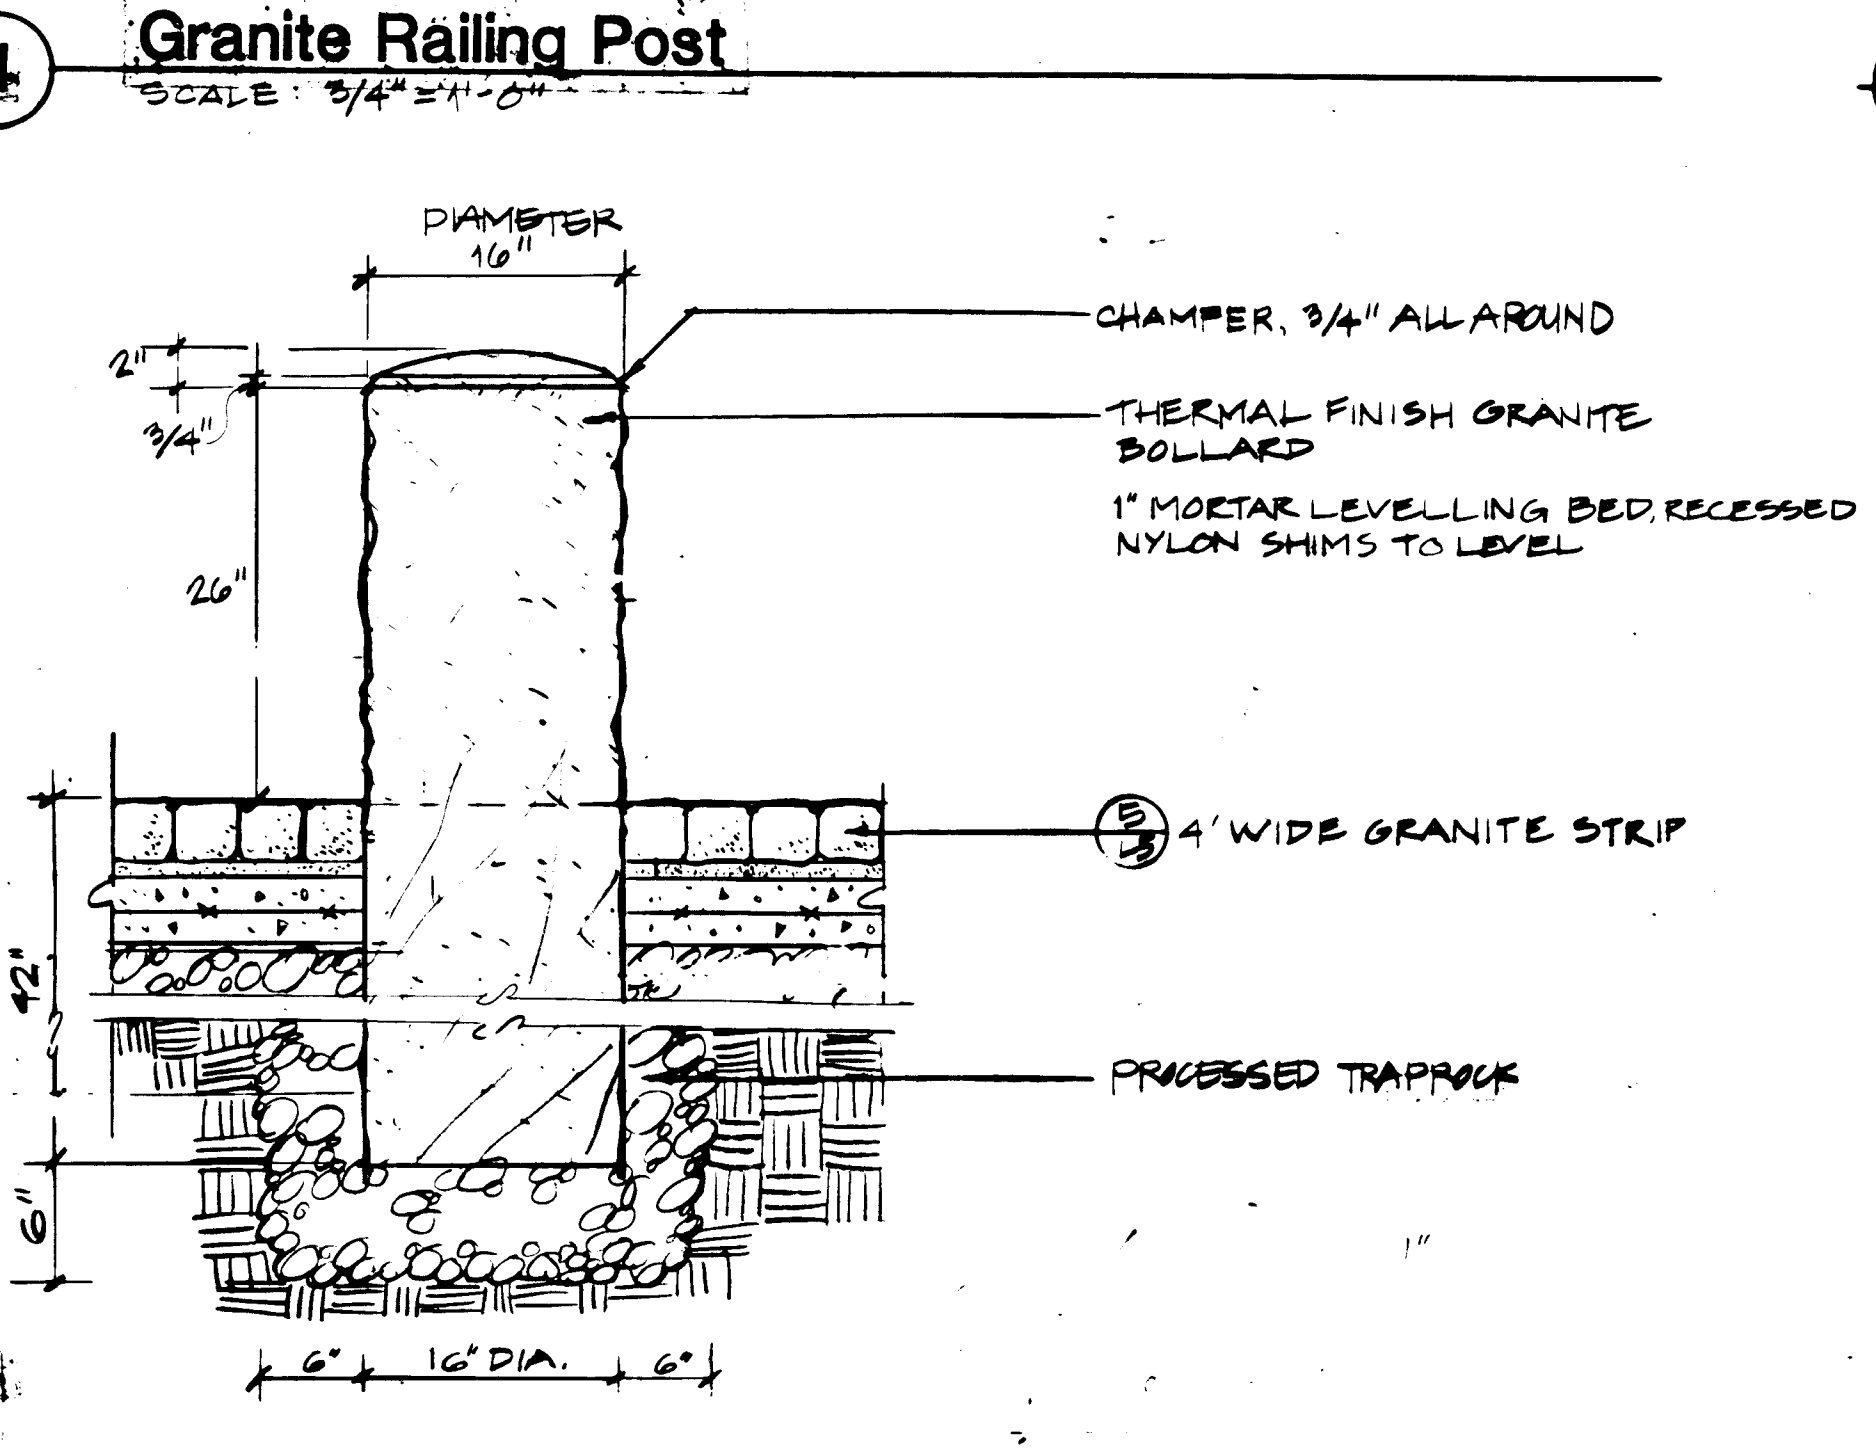
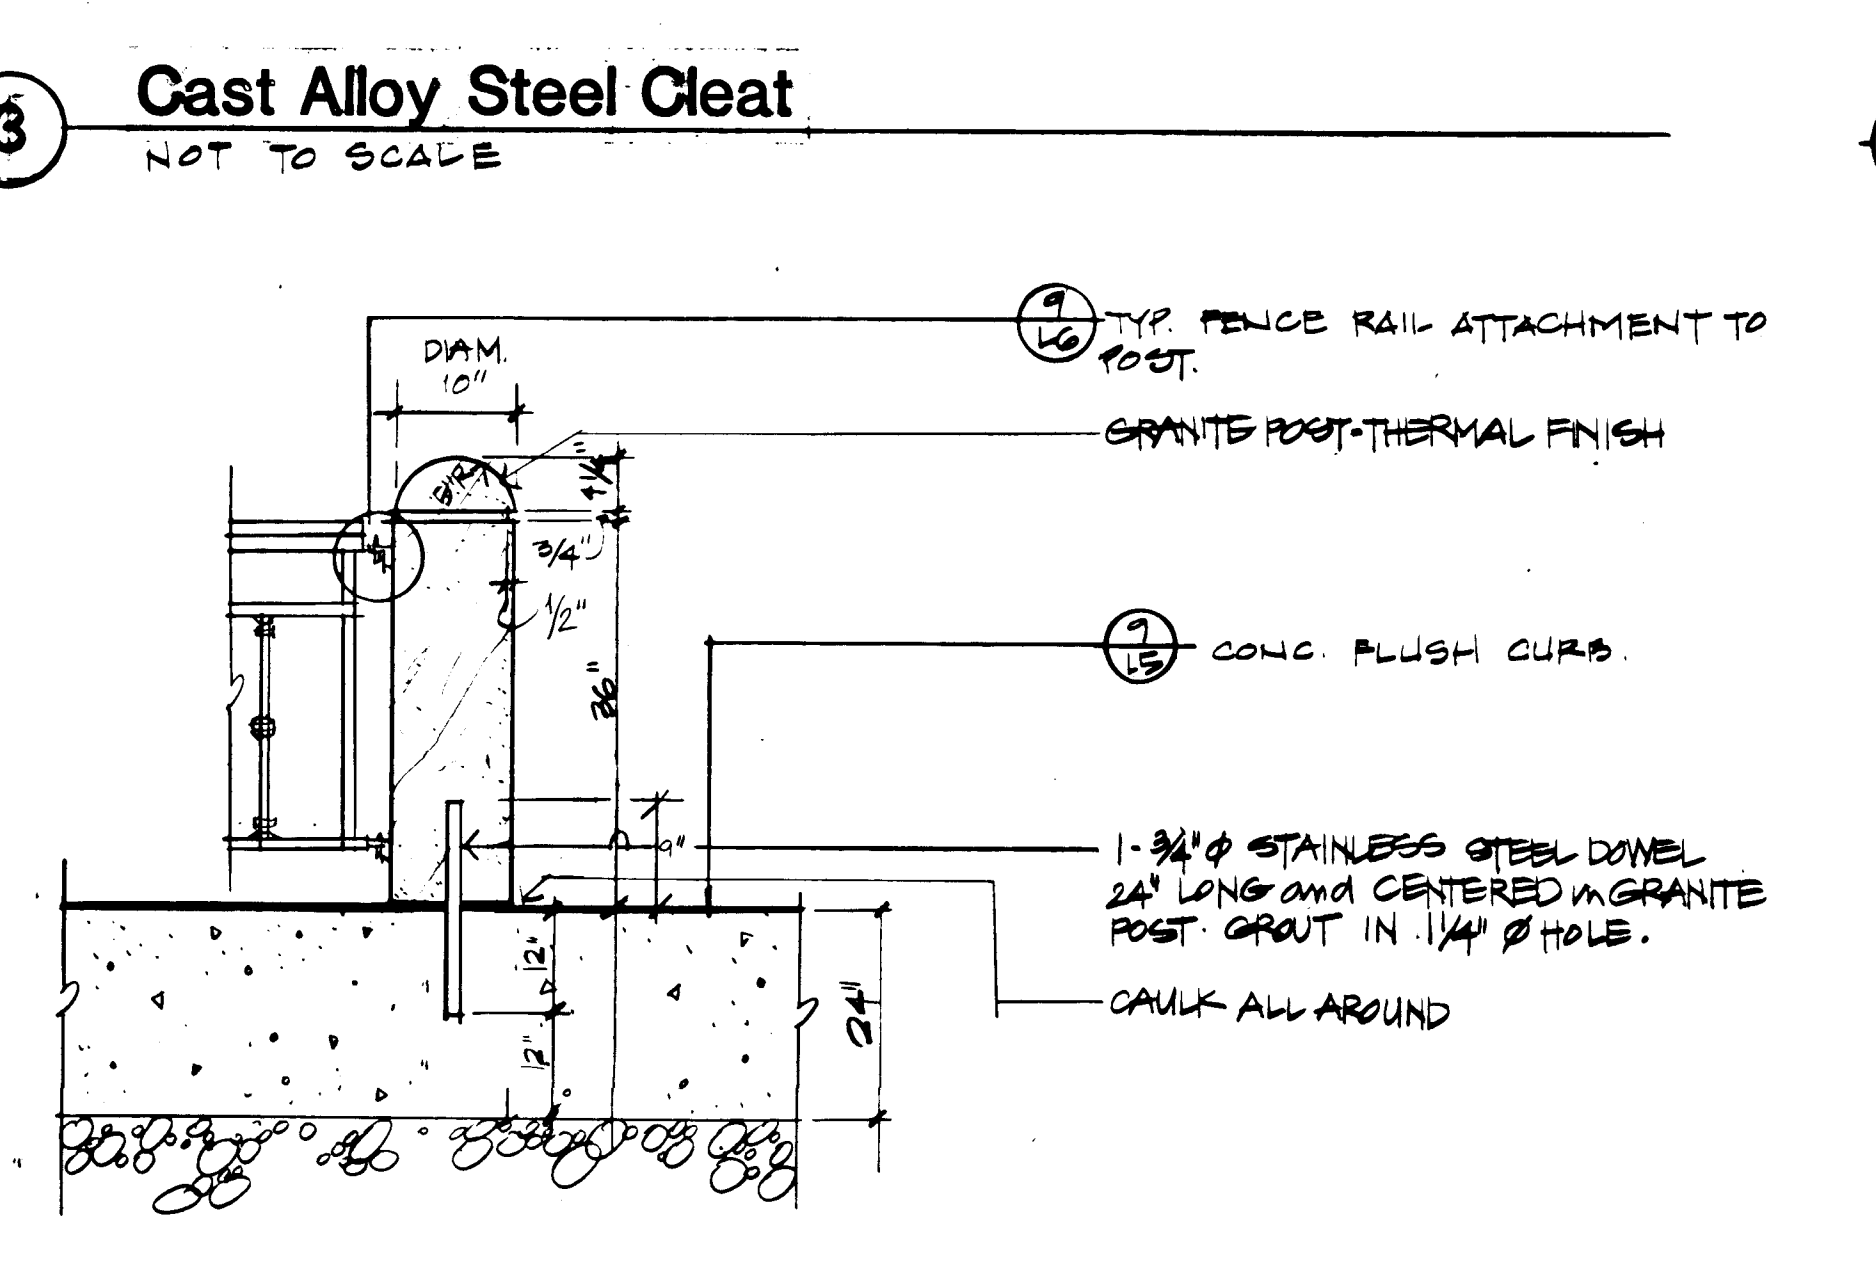
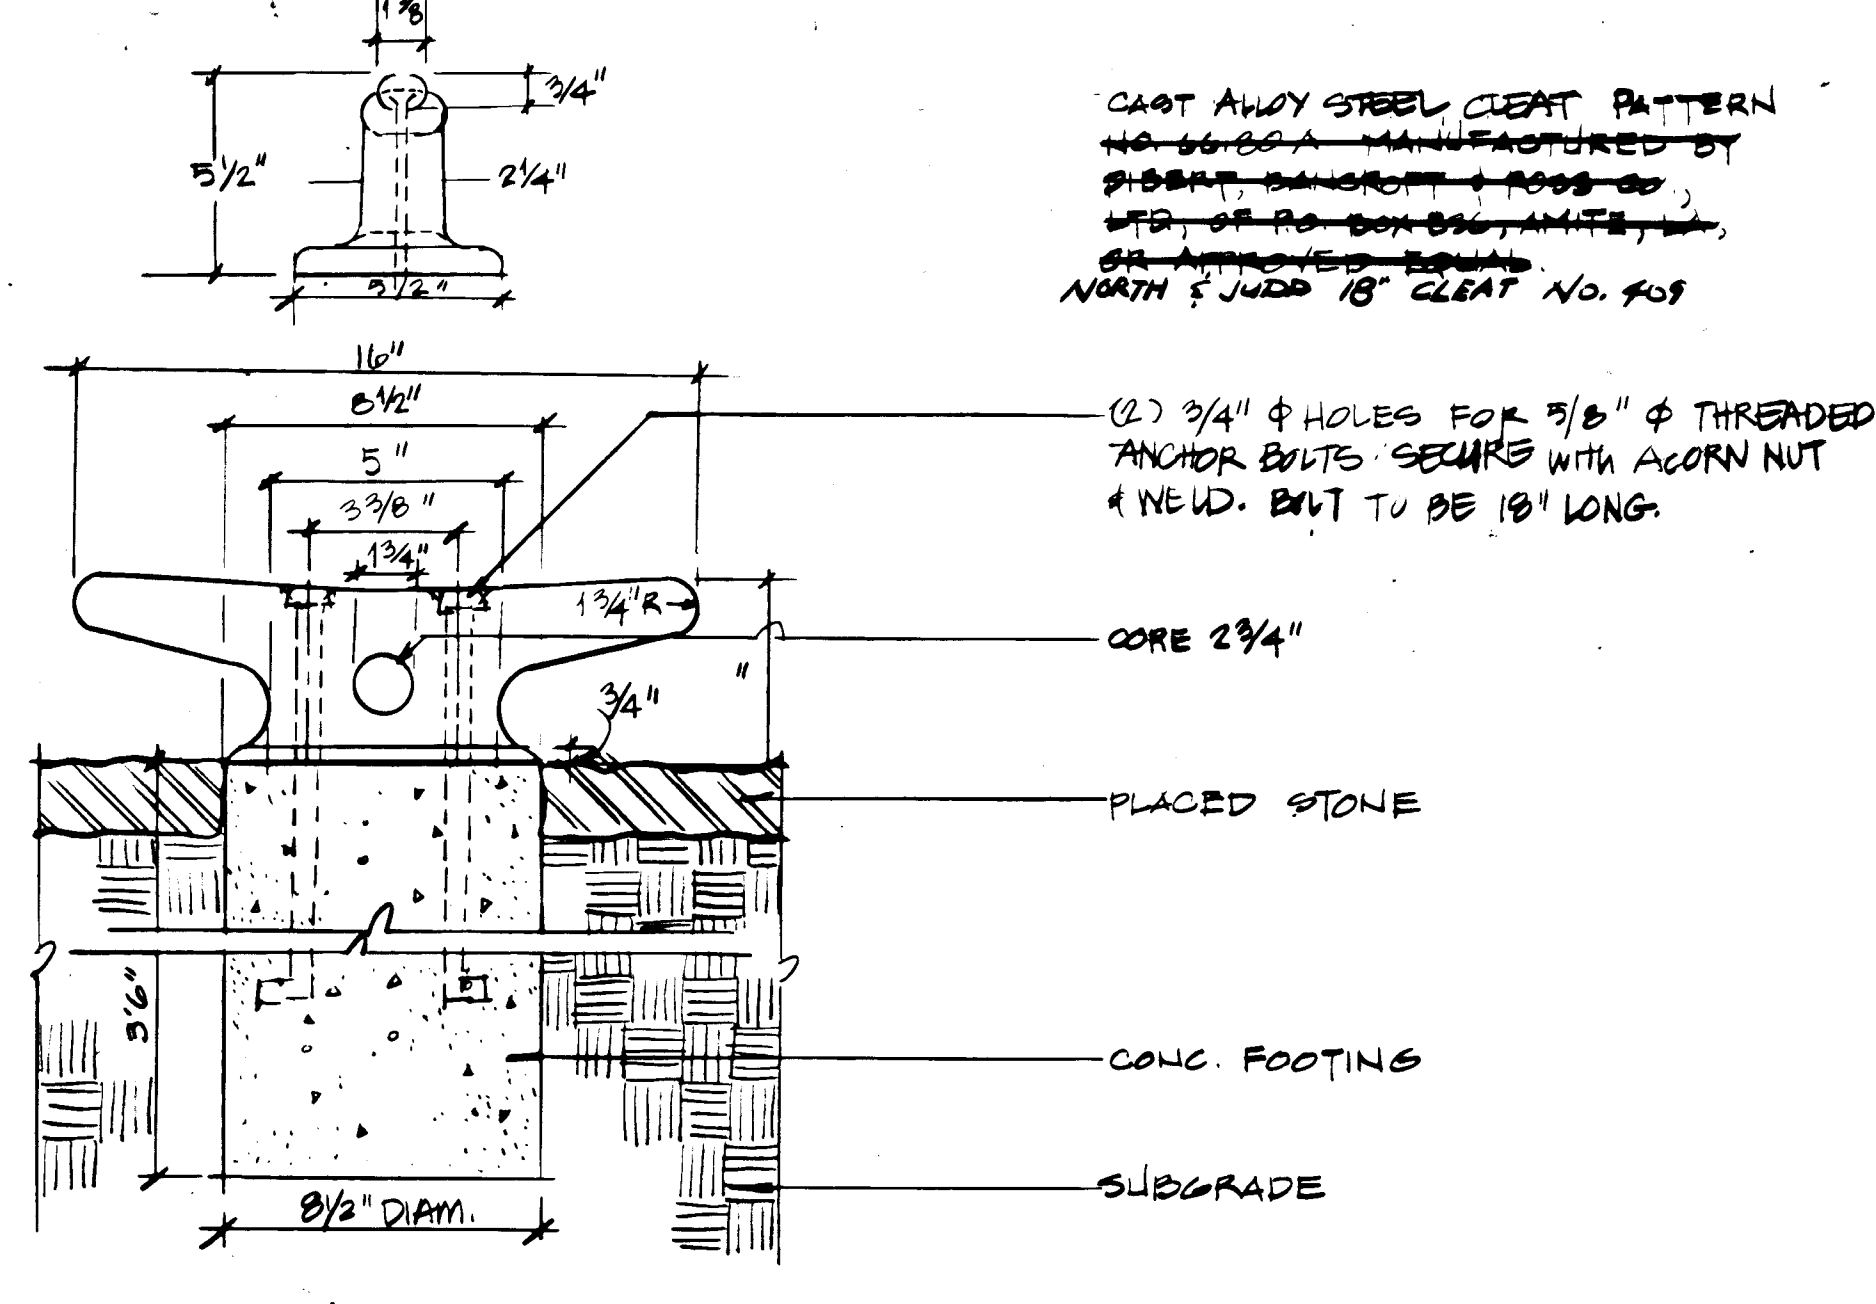
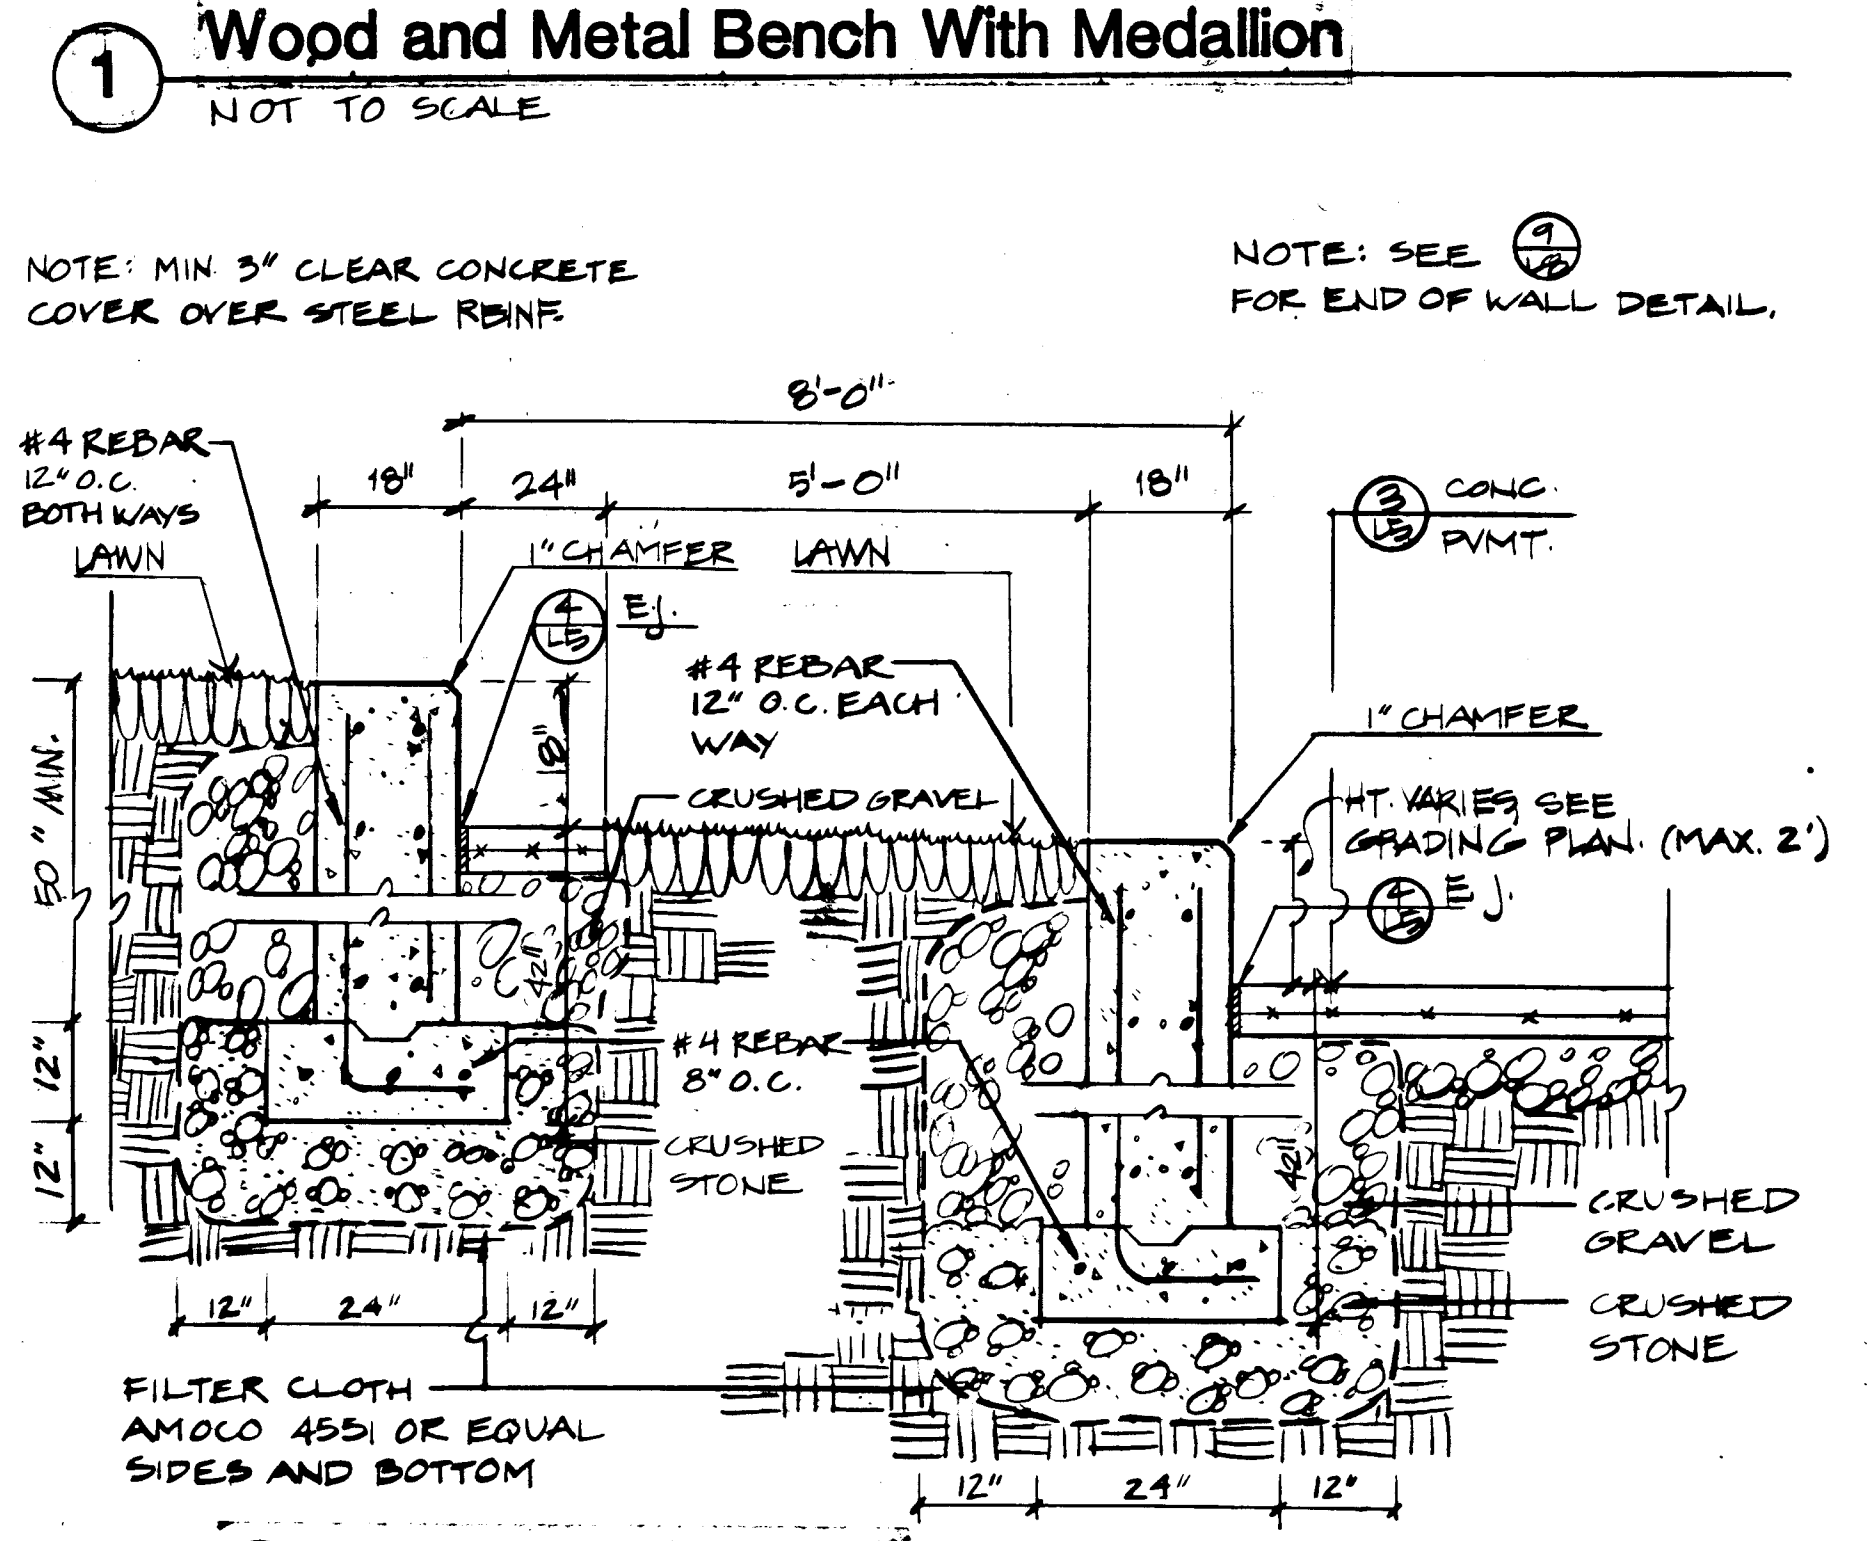
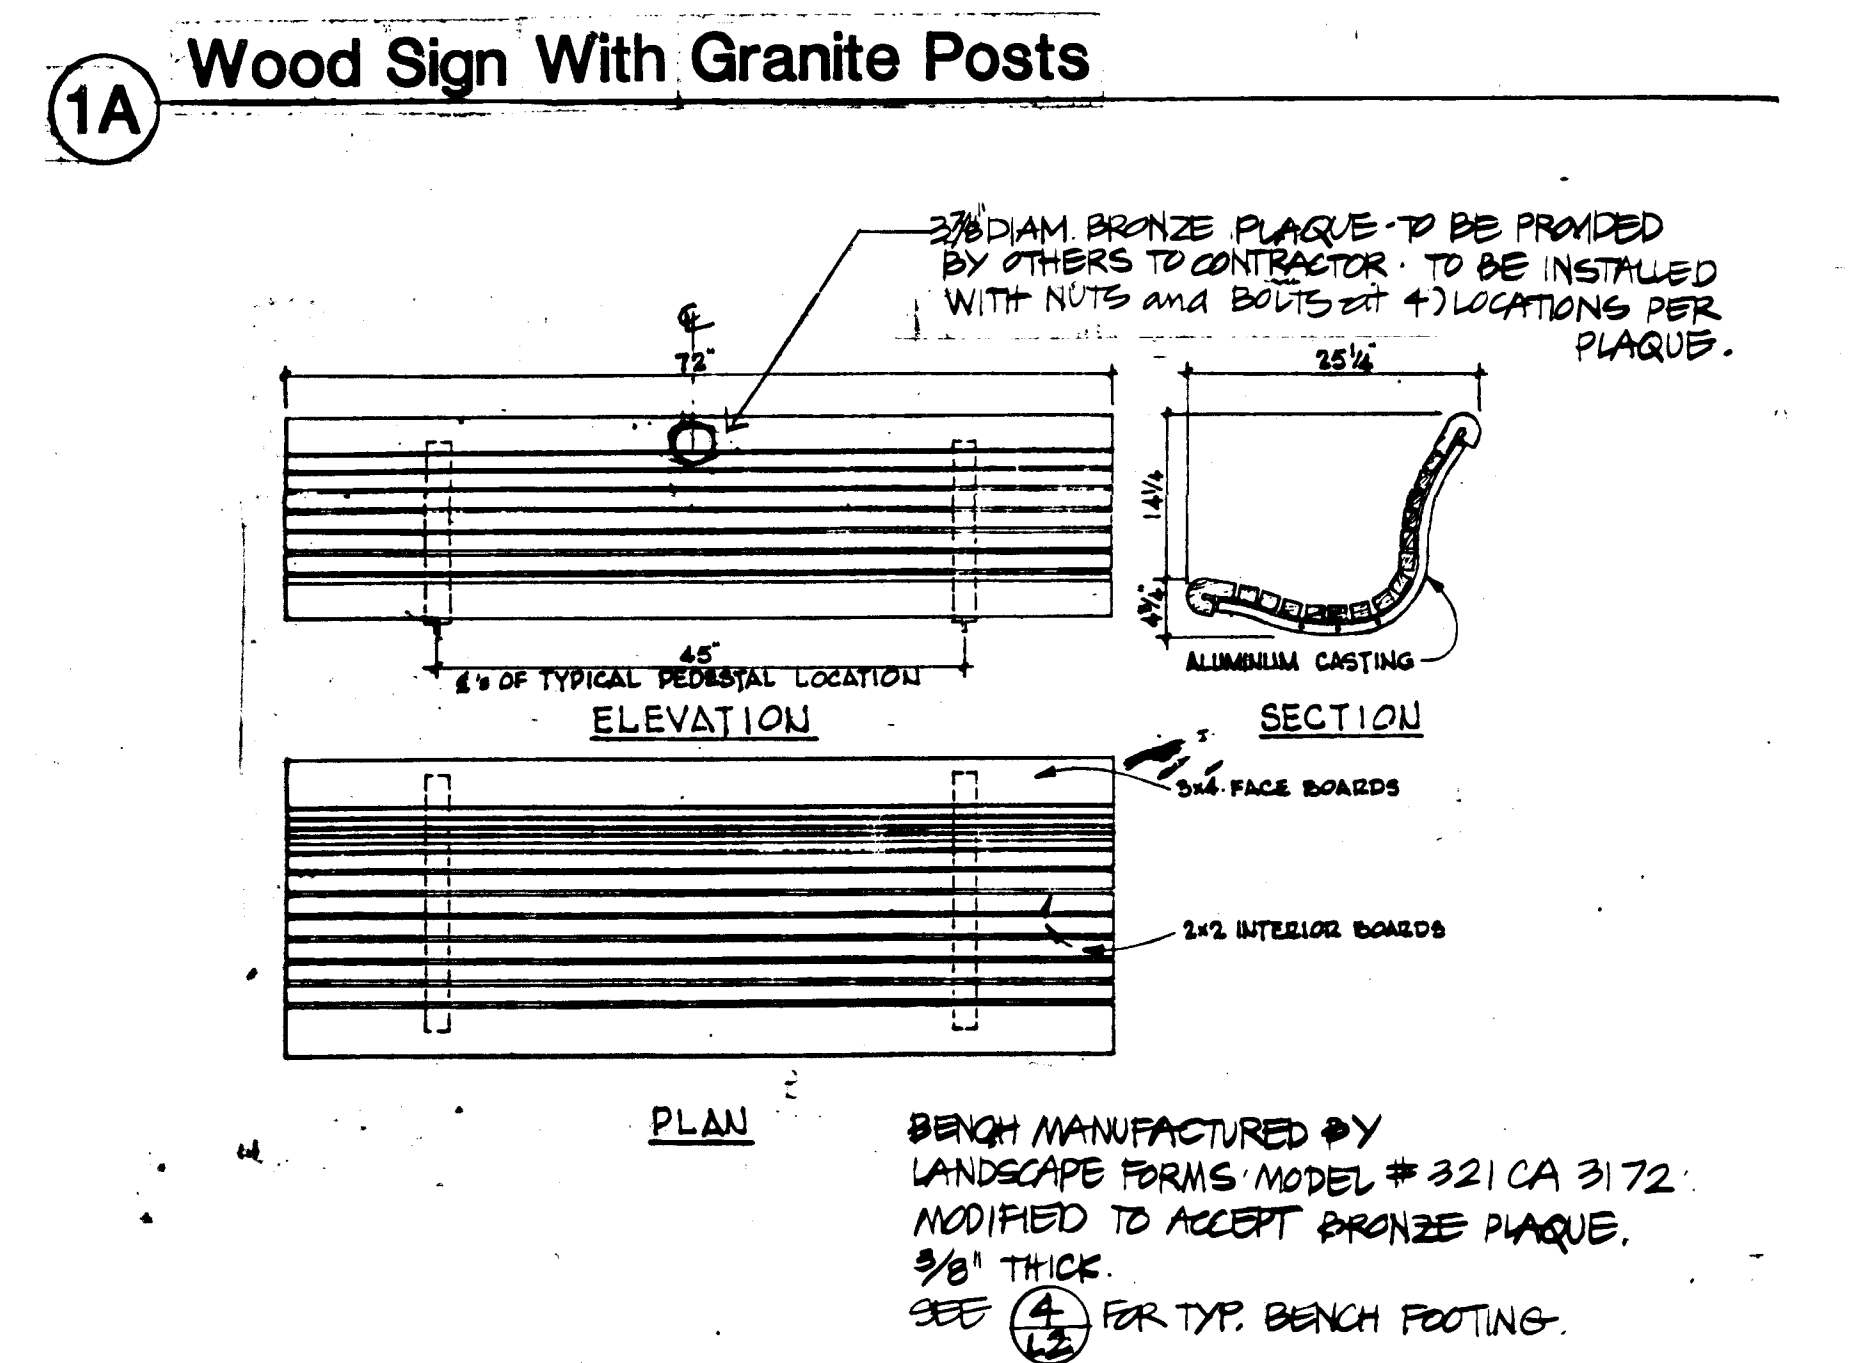


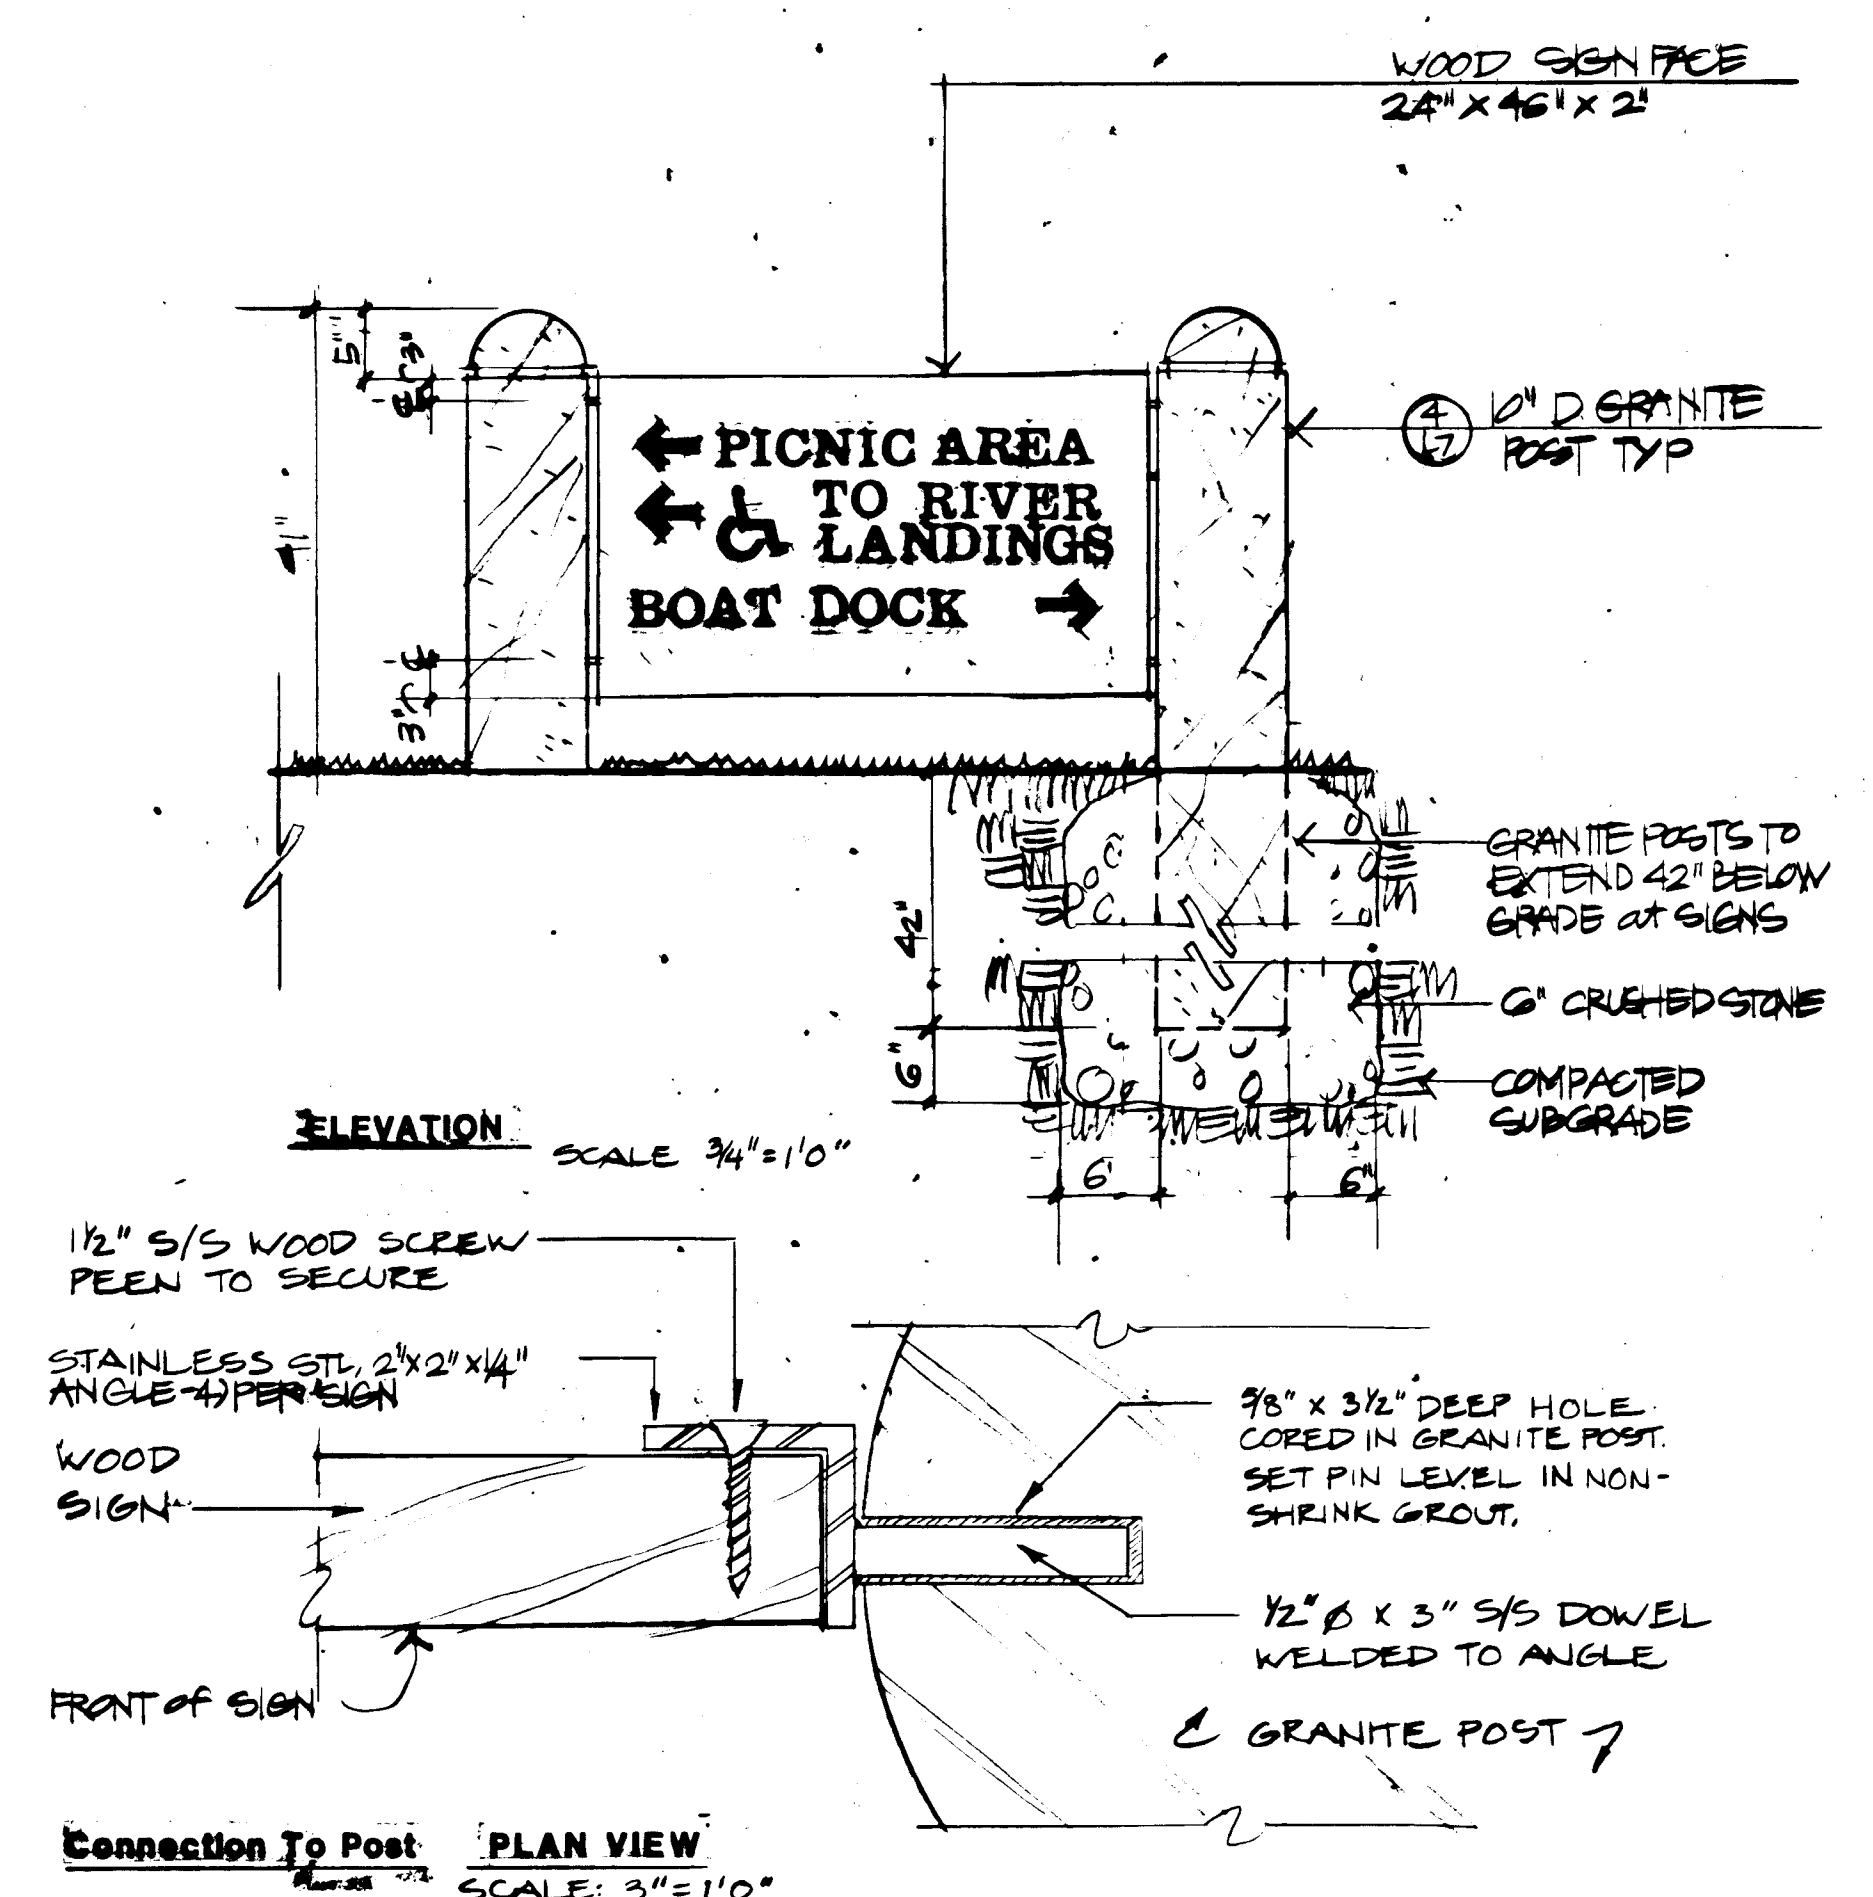

CHARTER OAK PARK
HARTFORD, CONNECTICUT

Riverfront Recapture Inc.
103 Constitution Plaza
Hartford, Connecticut 06103
(203) 277-6881

Carol R. Johnson and Associates Inc.
LANDSCAPE ARCHITECTS SITE PLANNERS
1100 Massachusetts Avenue
Cambridge, Massachusetts 02138 (617) 888-6115

Date: 28 DEC. 87
Drawn By: E.H.
Checked By:
Revisions:
28 DEC. 87

Site Details

L-7