

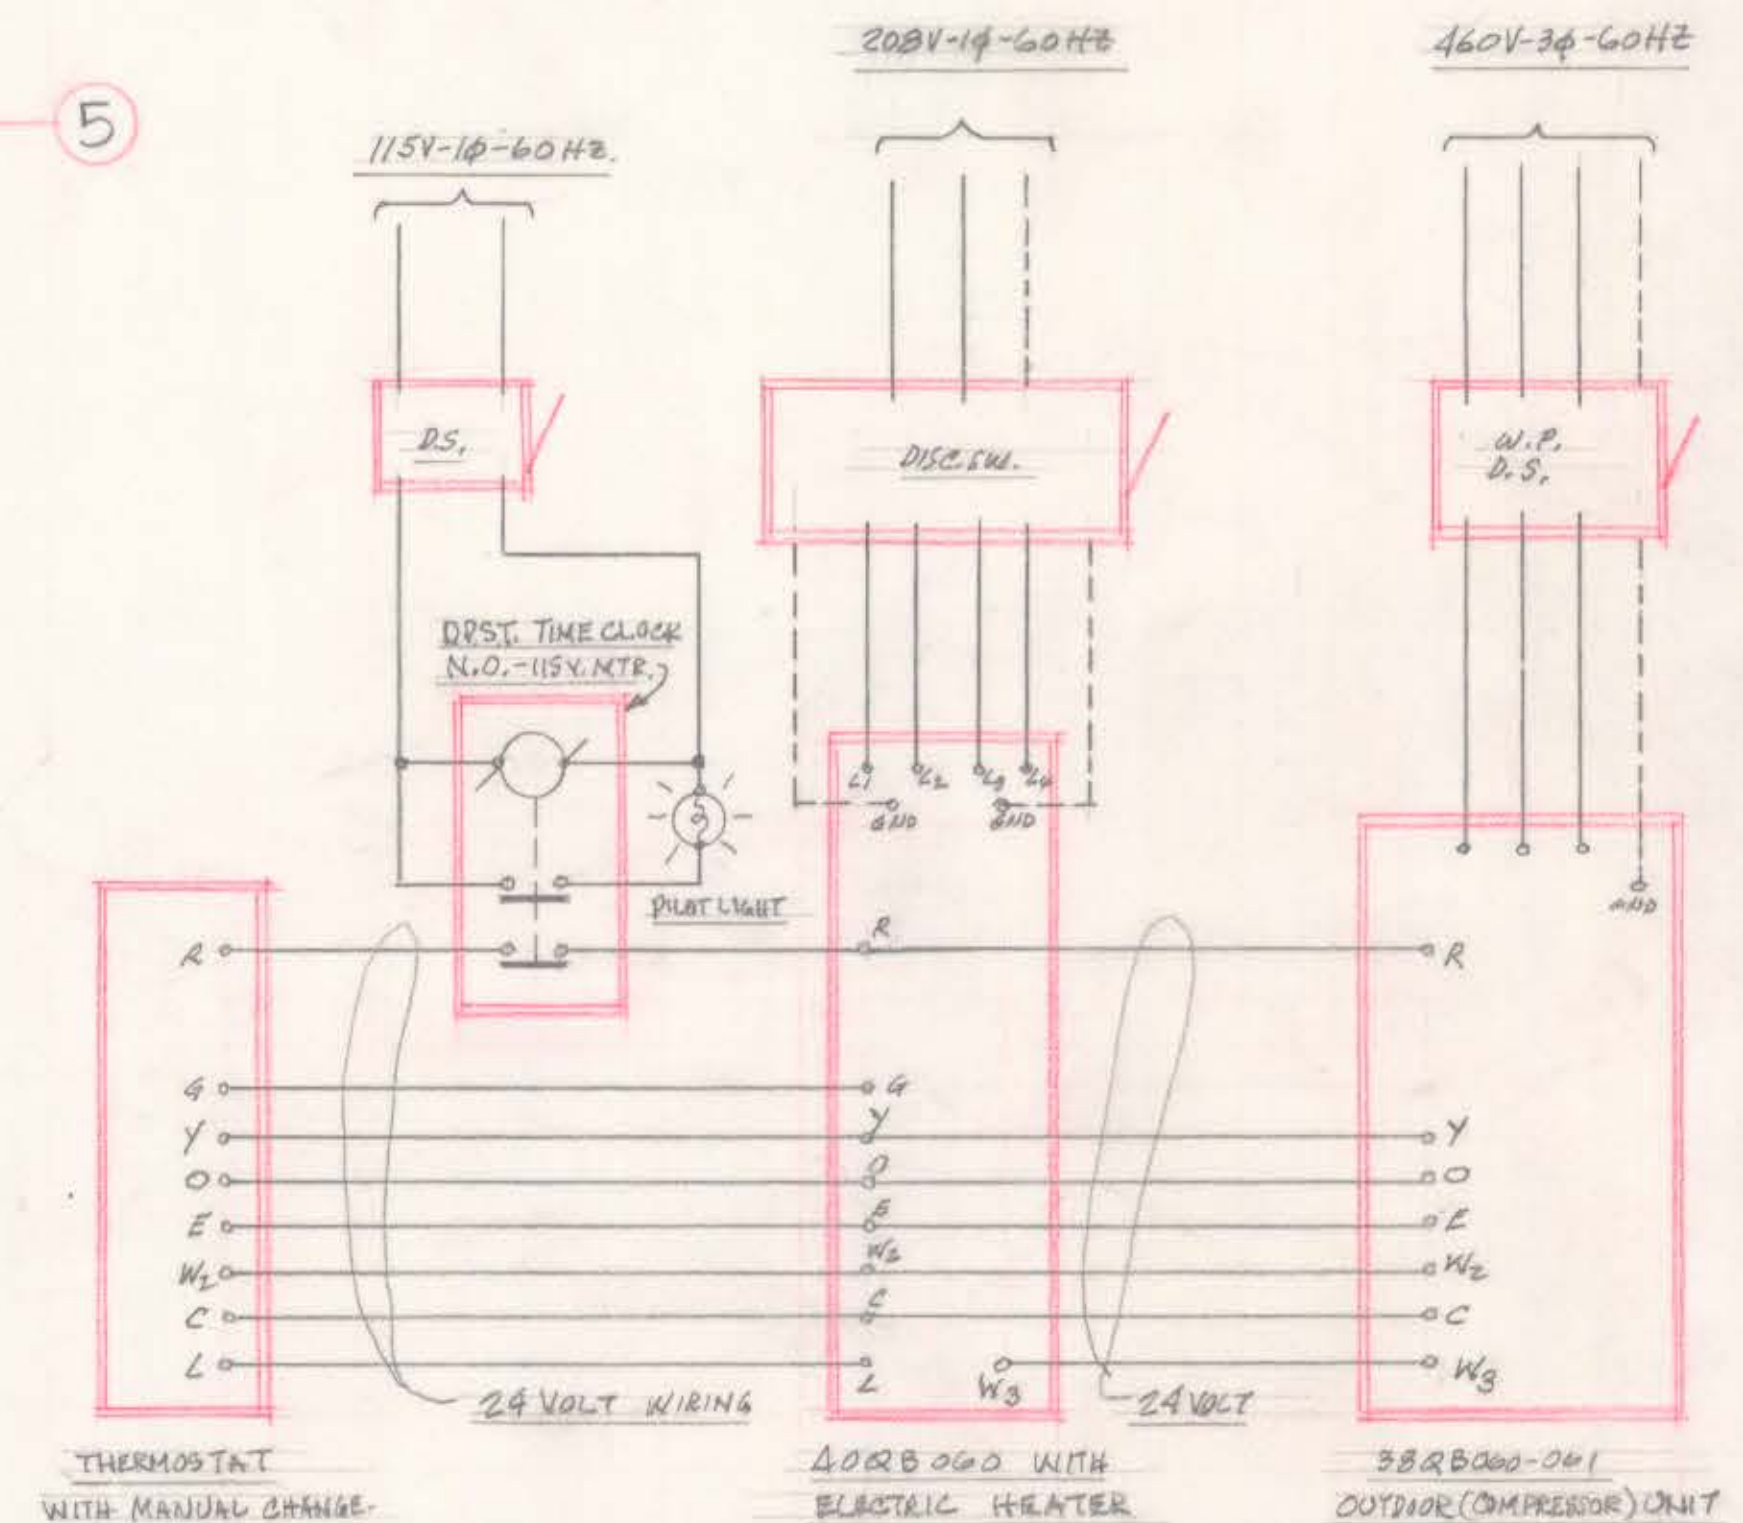
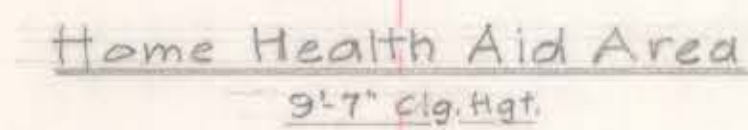
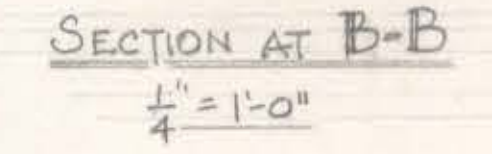
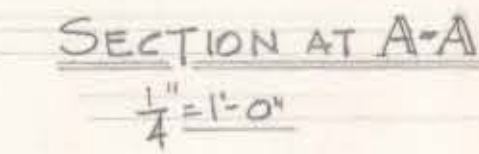


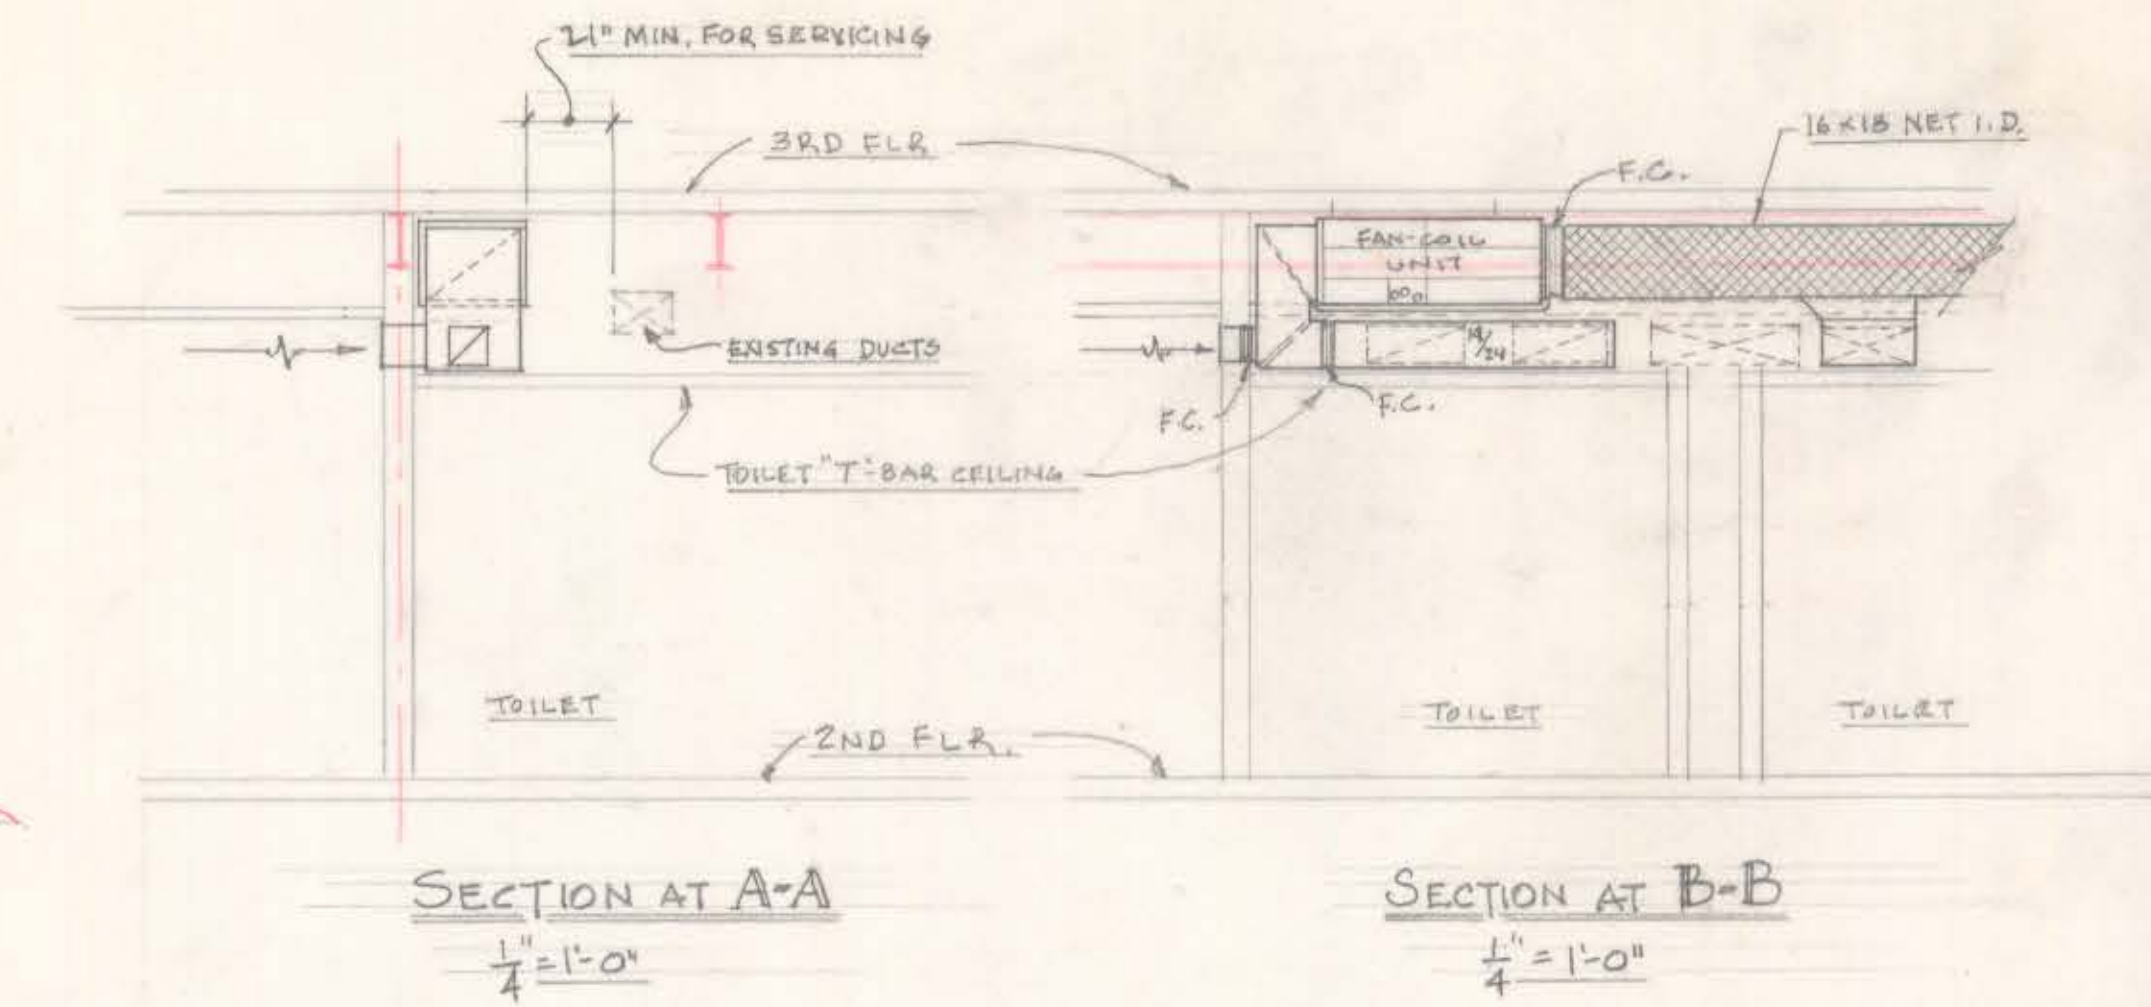

FIELD WIRING SCHEMATIC - N.T.S.

NOTE: SET TIME CLOCK TO CLOSE CONTACTS AT 4:30 PM, MON. THRU FRIDAY, AND 7:30 AM, SATURDAY AND SUNDAY, AND TO OPEN CONTACTS AT 11:00 PM. EVERY NIGHT.

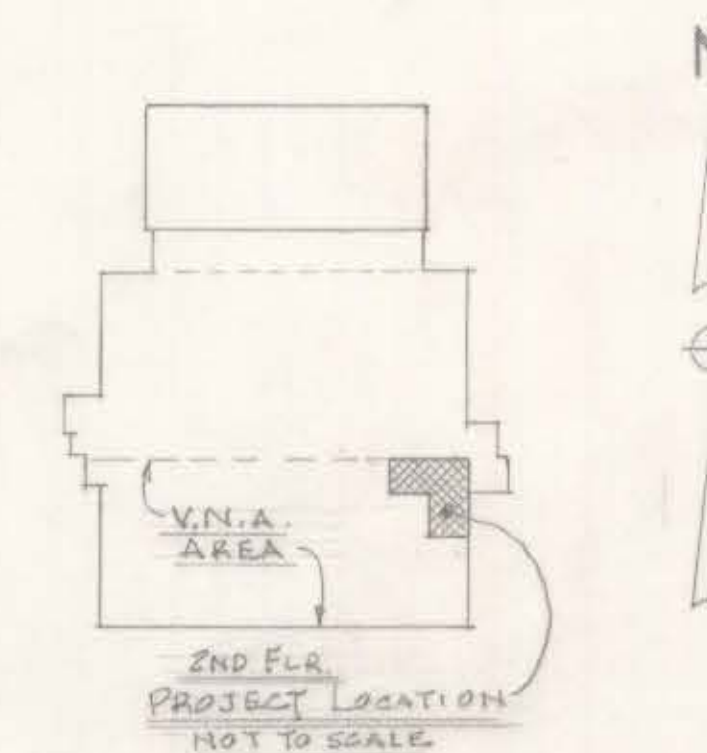

- SUPPLEMENTARY (OFF-HOURS) HEATING & COOLING -
- HOME HEALTH AID AREA (1,200 SQ. FT.) -
- VISITING NURSES ASSOCIATION (2ND FL.) -
- BURGDORF HEALTH CENTER, 80 QUINCY ST., HARTFORD, CT.

SUBMITTED <i>AS NOTED</i>	APPROVED <i>Paul Anthony George</i>	APPROVED <i>Jeffrey</i>
DRAWN G.L.M.	DAYBOOK NO. 010834-A	
CHECKED	DATE MAR 21 1993	DRAWING NO. H&C-1
SCALE <i>AS NOTED</i>		