


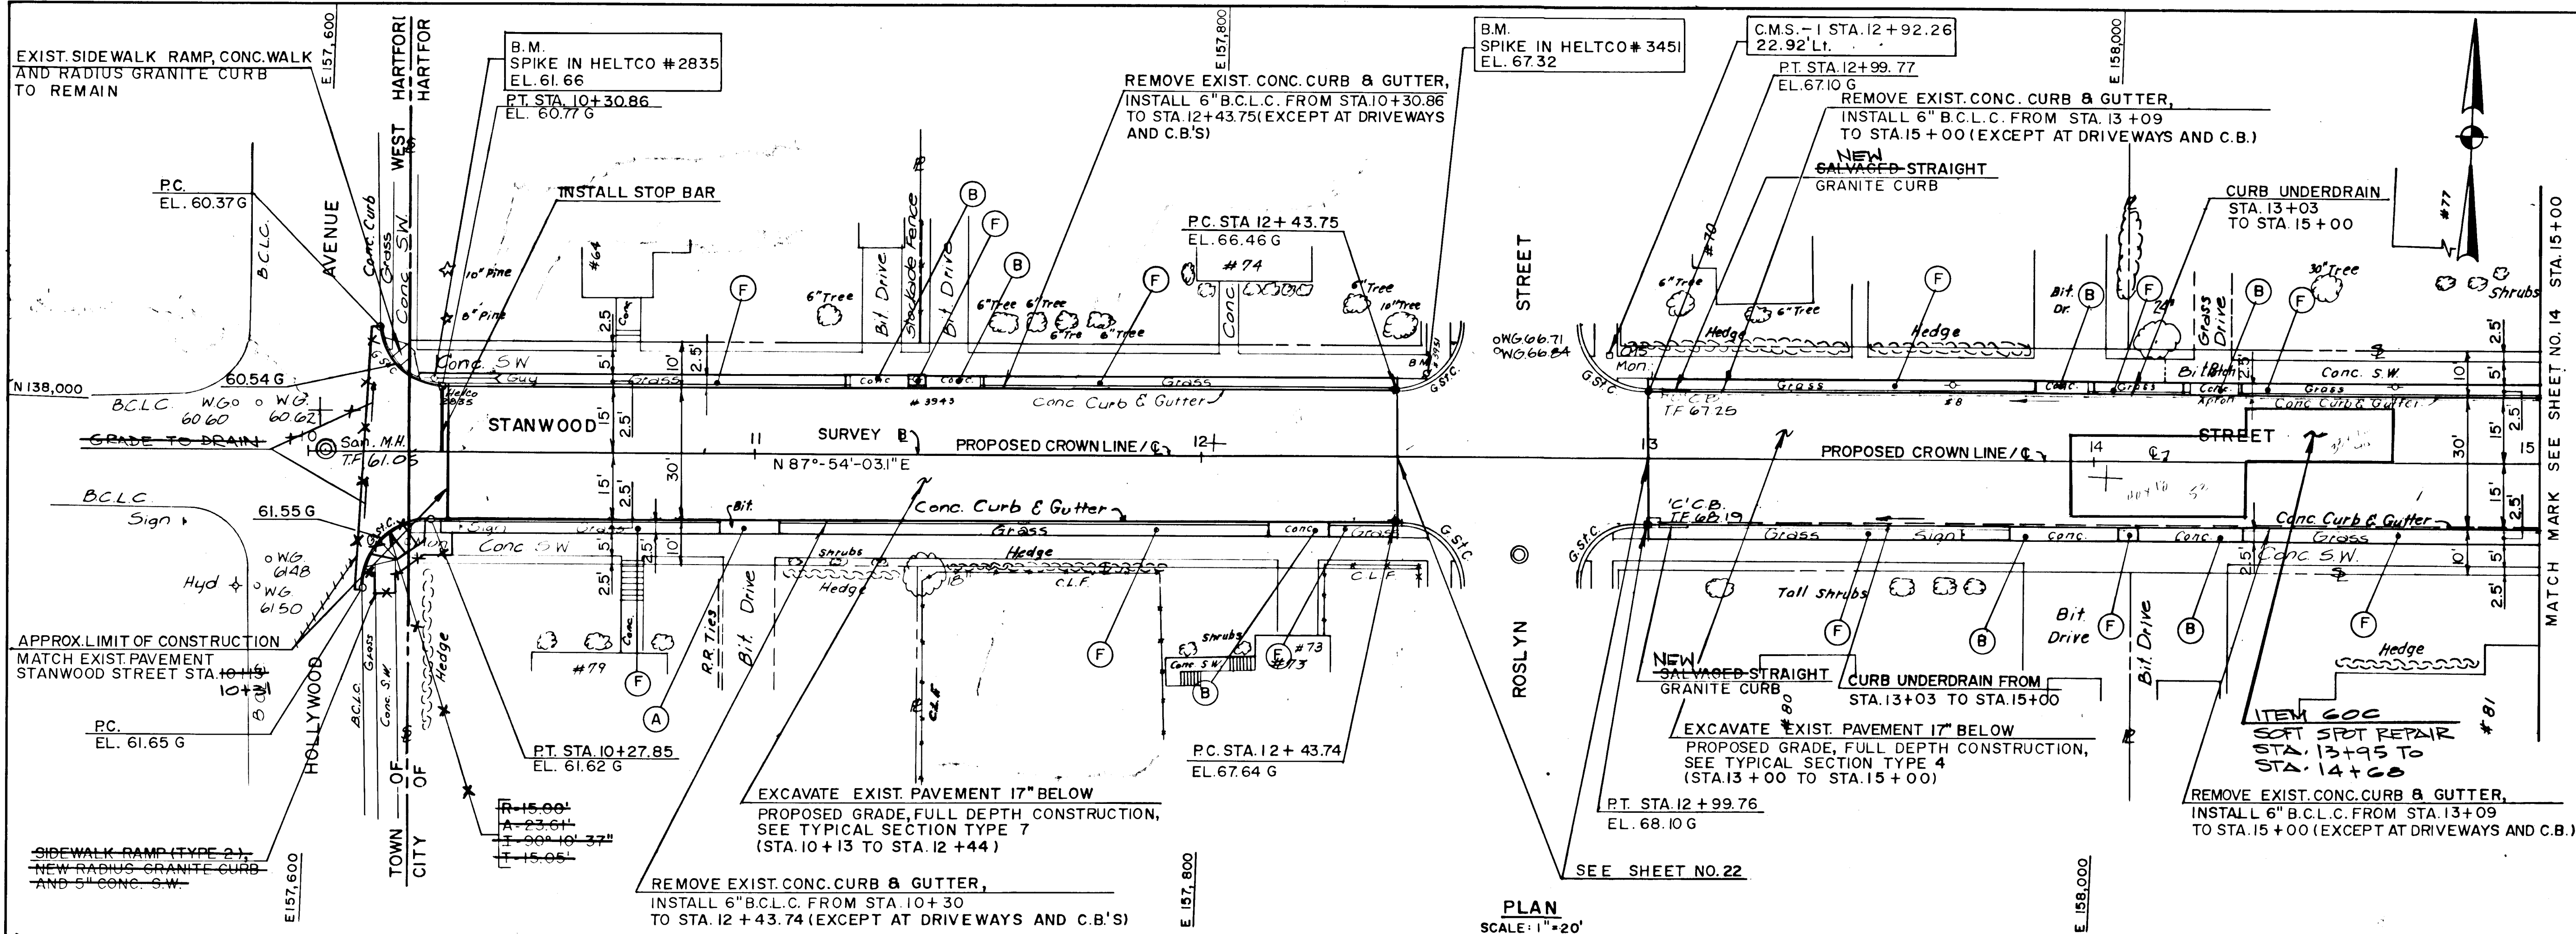


- NOTES
- (A) CONSTRUCT BIT CONC. DRIVEWAY RAMP

(B) SAWCUT BETWEEN EXISTING RAMPED SECTION AND SIDEWALK, AND CONSTRUCT 8\" REINFORCED CONC. DRIVEWAY RAMP.

(D) CONSTRUCT 8\" REINFORCED CONC. SIDEWALK

(F) SEEDING AND MULCHING.

(G) CONSTRUCT 8\" REINFORCED CONC. DRIVEWAY RAMP.
 - FOR GENERAL NOTES AND LIST OF ABBREVIATIONS SEE SHEET NO. 2
 - FOR CONSTRUCTION NOTES SEE SHEET NO. 8
 - SURVEY BASELINE IS LOCATED 22.92' SOUTH OF C.M. - 1.

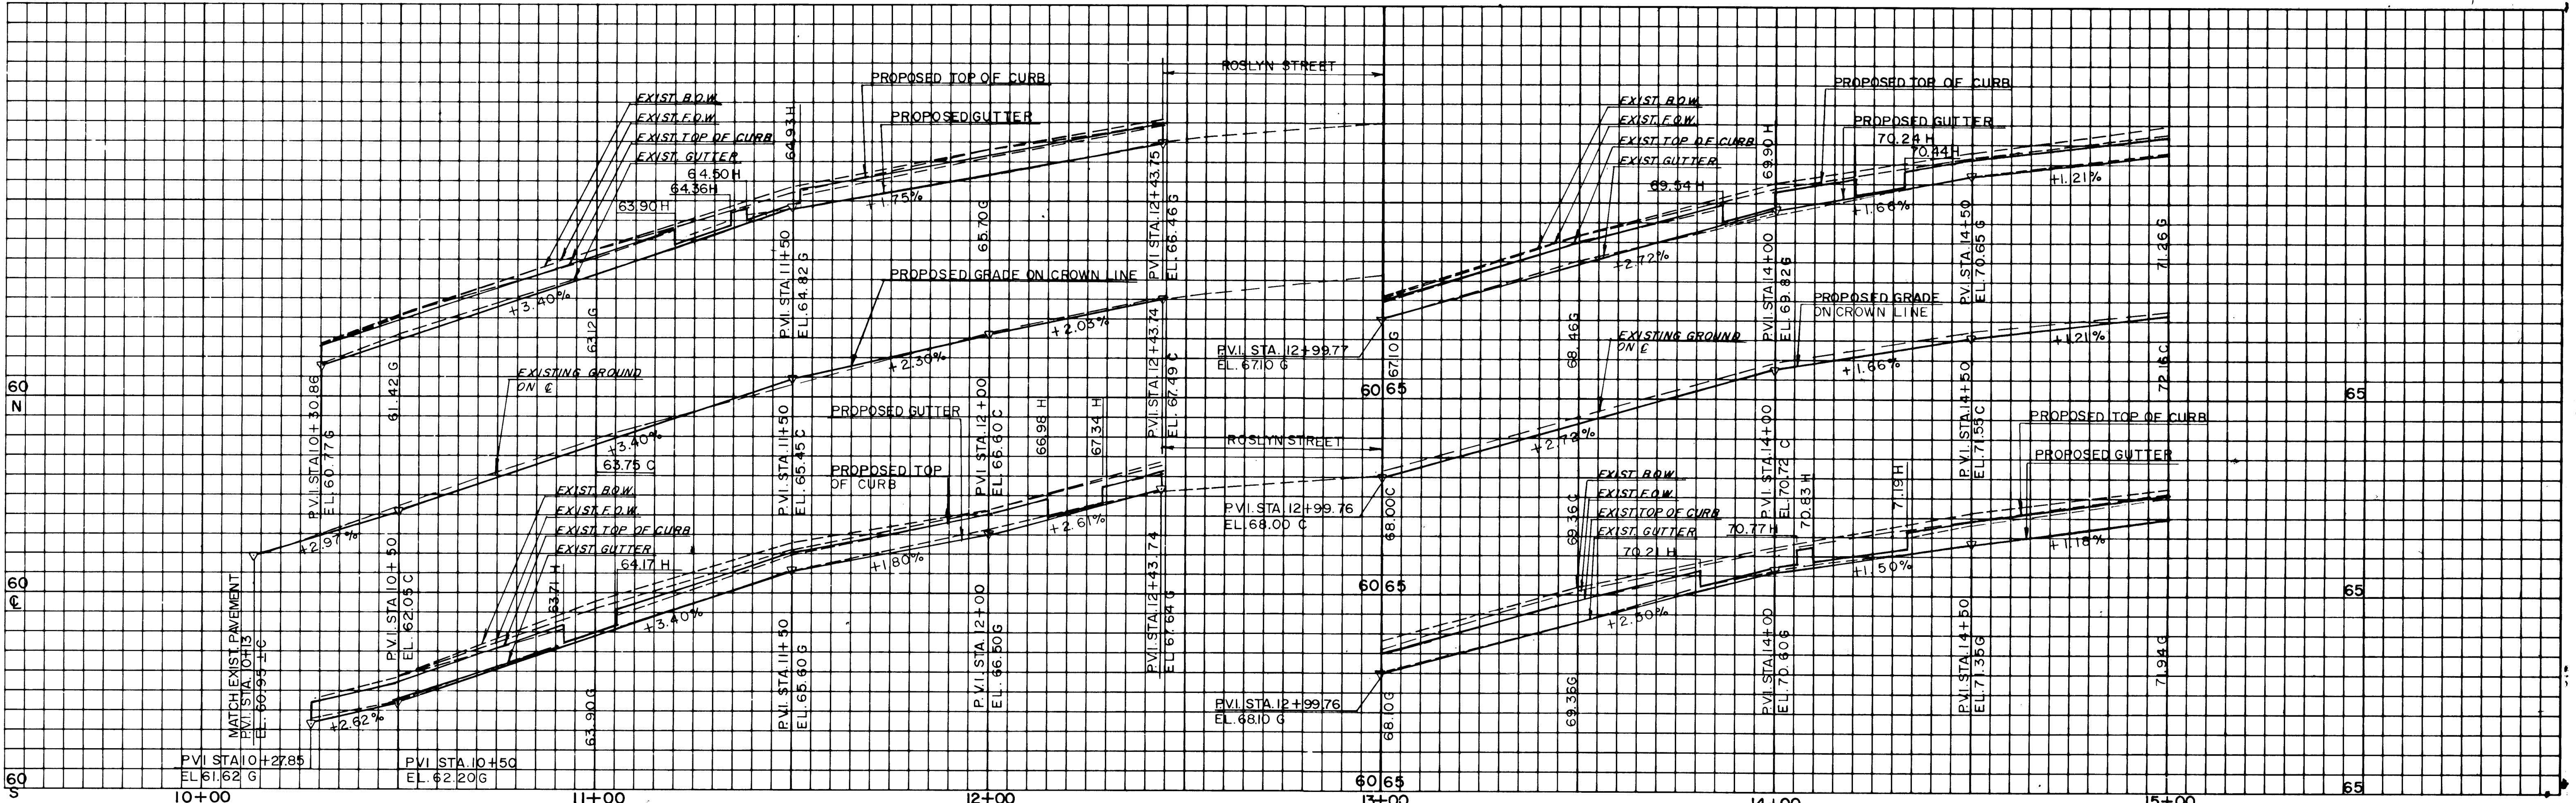

PROFILE
SCALE:
VERT. 1" = 2'
HORIZ. 1" = 20'

STANWOOD STREET PLAN AND PROFILE				THE CITY OF HARTFORD, CONNECTICUT		SHEET NO. 13 OF 46 DAYBOOK NO. 01113A
NO.	DATE	REVISION	DESIGNED: P.L.	DRAWN: C.L.P.	DATE: MARCH 23, 1998	
1	7/20/98	DRAINAGE	CHECKED: A.M.	APPROVED: R.C.G.	SCALE: AS NOTED	

