
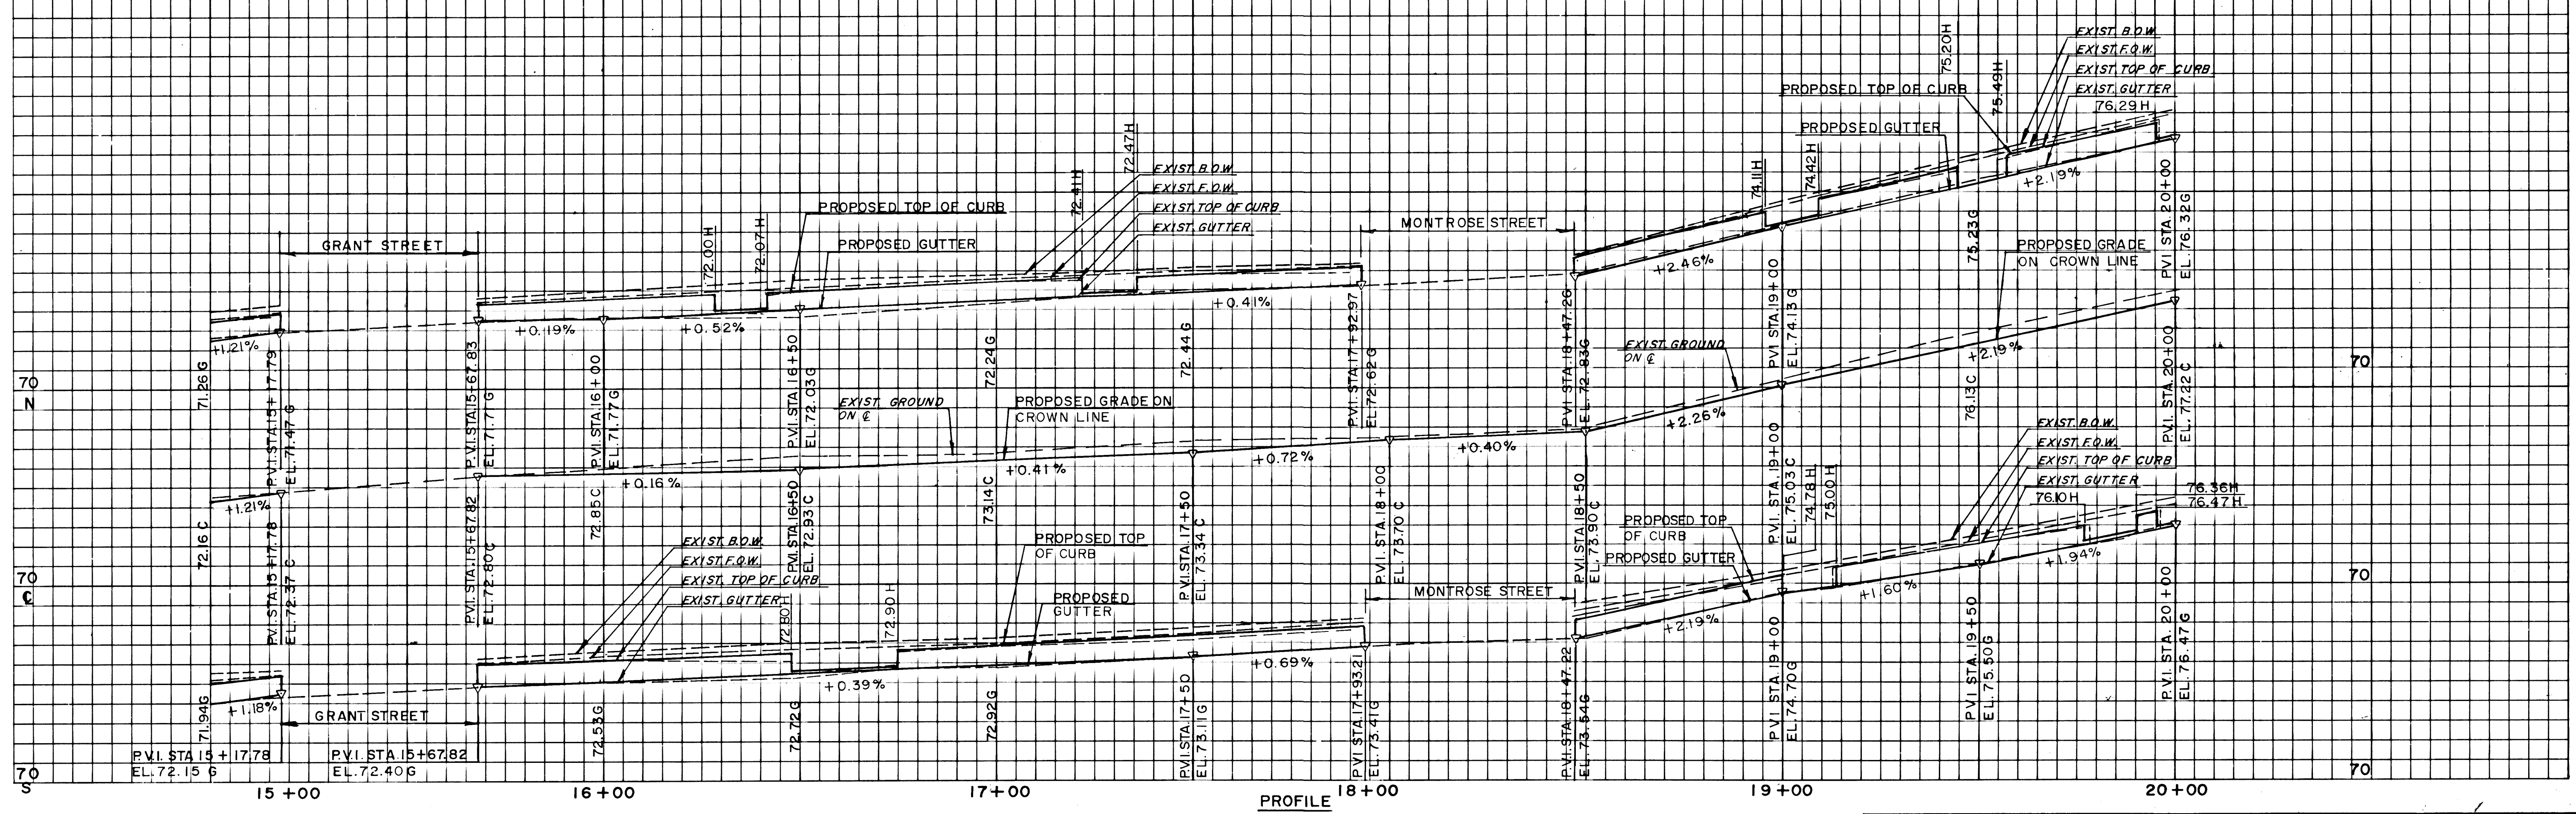


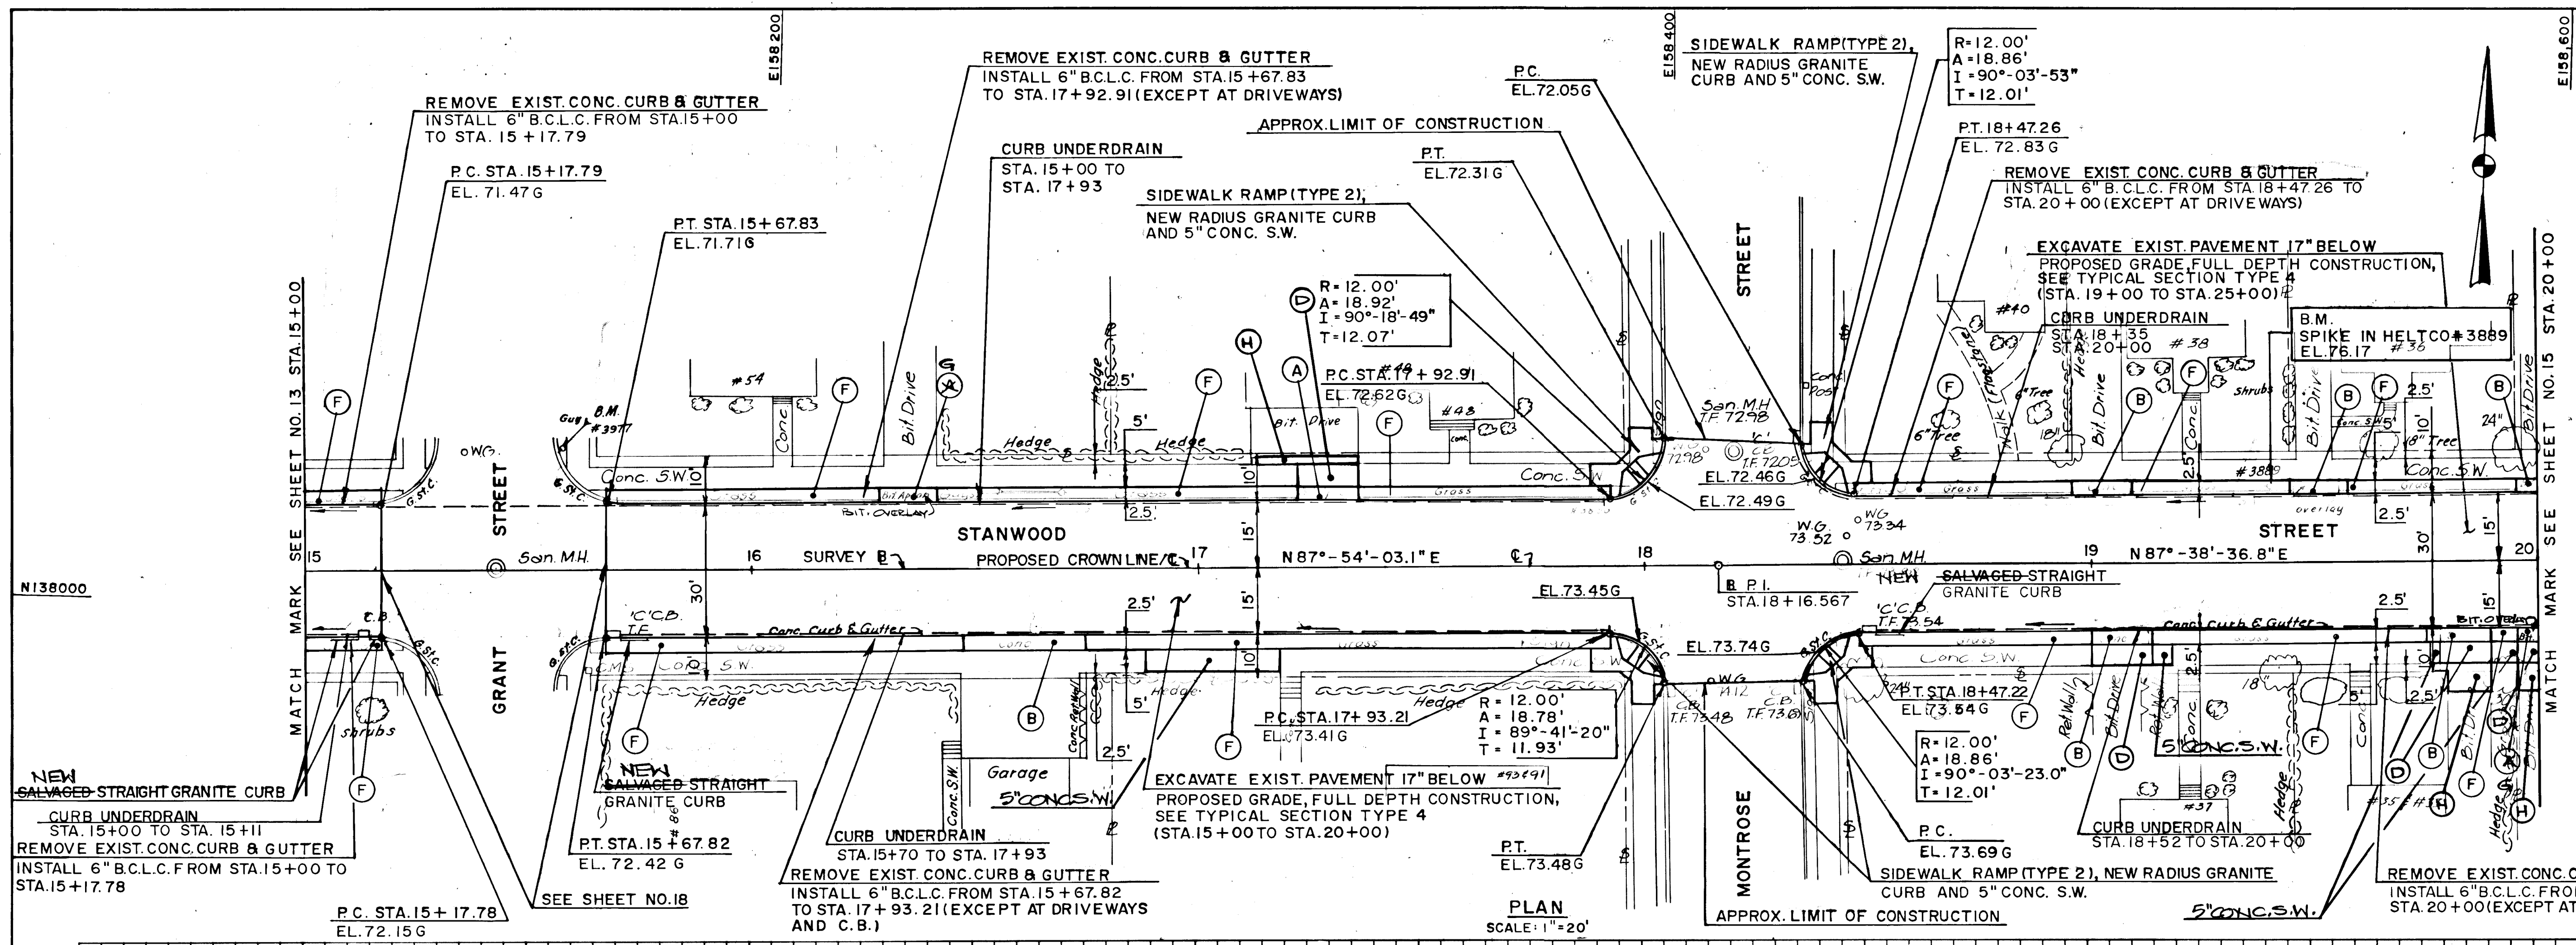

STANWOOD STREET			
PLAN AND PROFILE			
THE CITY OF HARTFORD, CONNECTICUT			
DESIGNED: P.L.	DATE: MARCH 23, 1988	PURCELL ASSOCIATES SHEET NO. 14 OF 48 DAYBOOK NO. 01113A	
DRAWN: C.L.P.	SCALE: AS NOTED		
CHECKED: A.M.			
APPROVED: R.C.G.			