



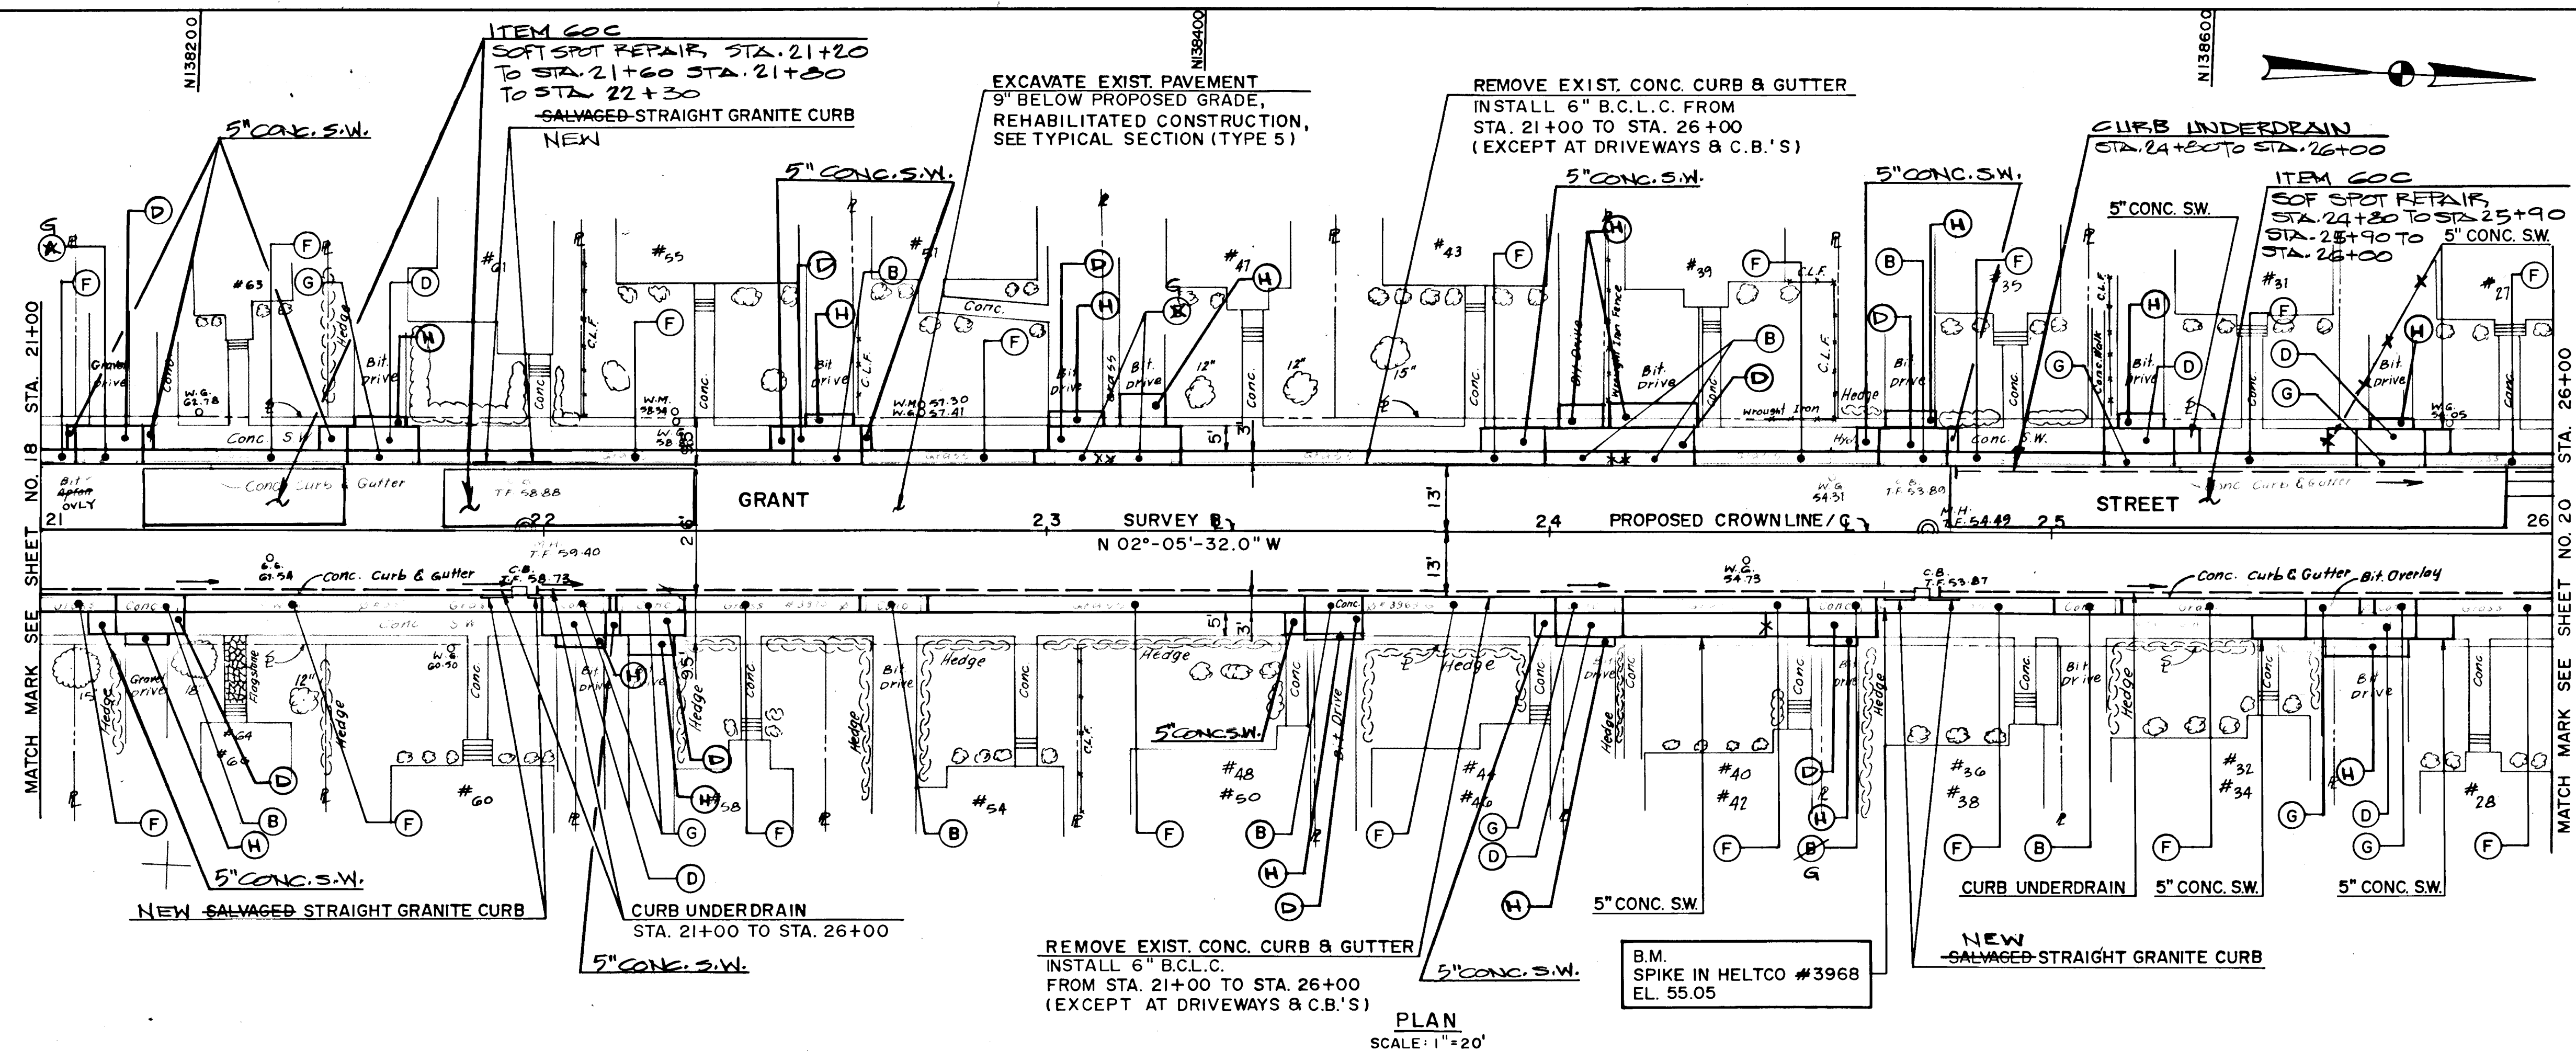

- NOTES:**
1. (A) CONSTRUCT BIT. CONC. DRIVEWAY RAMP
 - (B) SAWCUT BETWEEN EXISTING RAMPED SECTION AND SIDEWALK, AND CONSTRUCT 8\" REINFORCED CONC. DRIVEWAY RAMP.
 - (D) CONSTRUCT 8\" REINFORCED CONC. SIDEWALK.
 - (F) SEEDING AND MULCHING.
 - (G) CONSTRUCT 8\" REINFORCED CONC. DRIVEWAY RAMP.
 - (H) CONSTRUCT BIT. CONC. DRIVEWAY
 2. FOR GENERAL NOTES AND LIST OF ABBREVIATIONS SEE SHEET NO. 2
 3. FOR CONSTRUCTION NOTES SEE SHEET NO. 8
 4. SURVEY BASELINE IS LOCATED 13.00 FT. WEST FROM FACE OF EAST CURB.

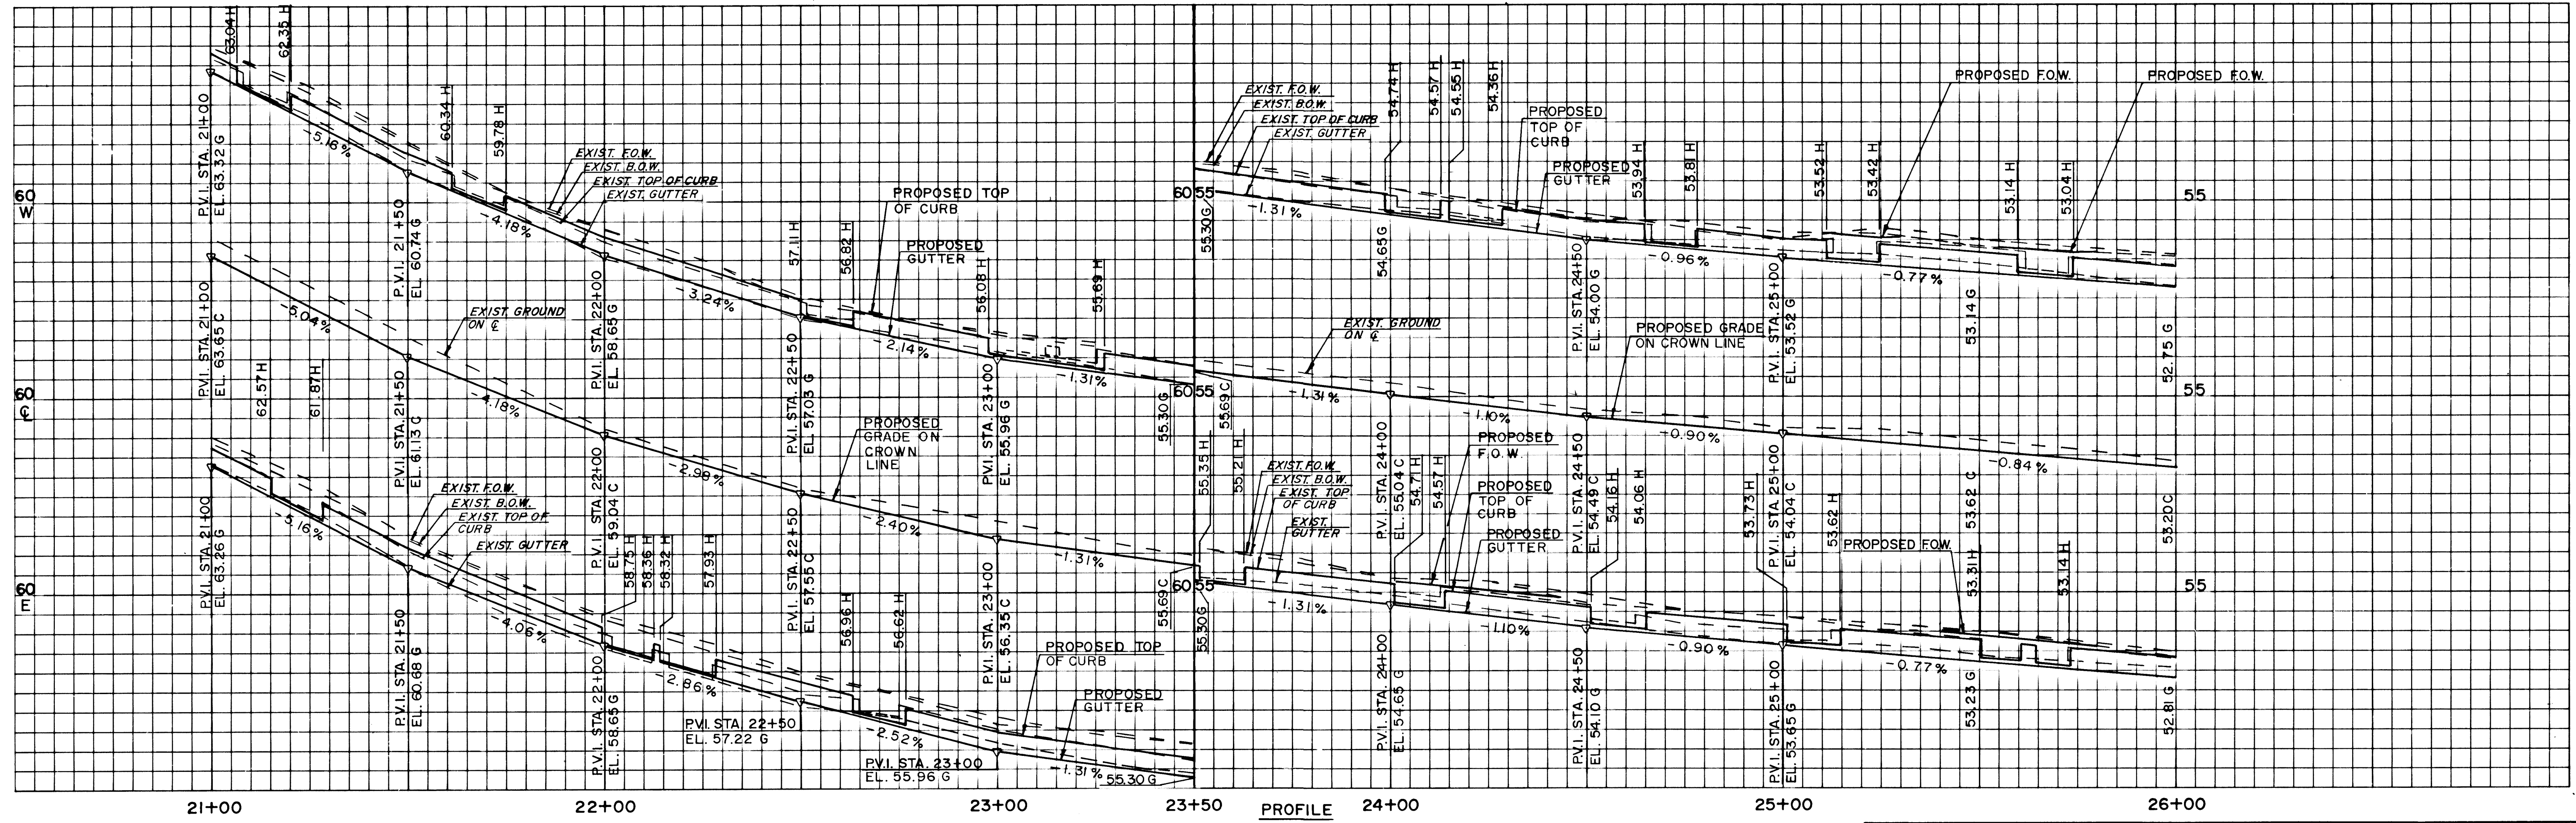

GRANT STREET	
PLAN AND PROFILE	
THE CITY OF HARTFORD, CONNECTICUT	
DESIGNED: D.M.	DATE MARCH 23, 1988
DRAWN: T.N.S.	SCALE AS NOTED
CHECKED: A.M.	
APPROVED: R.C.G.	
SHEET NO. 19 OF 48	
DAYBOOK NO. 011113B	