



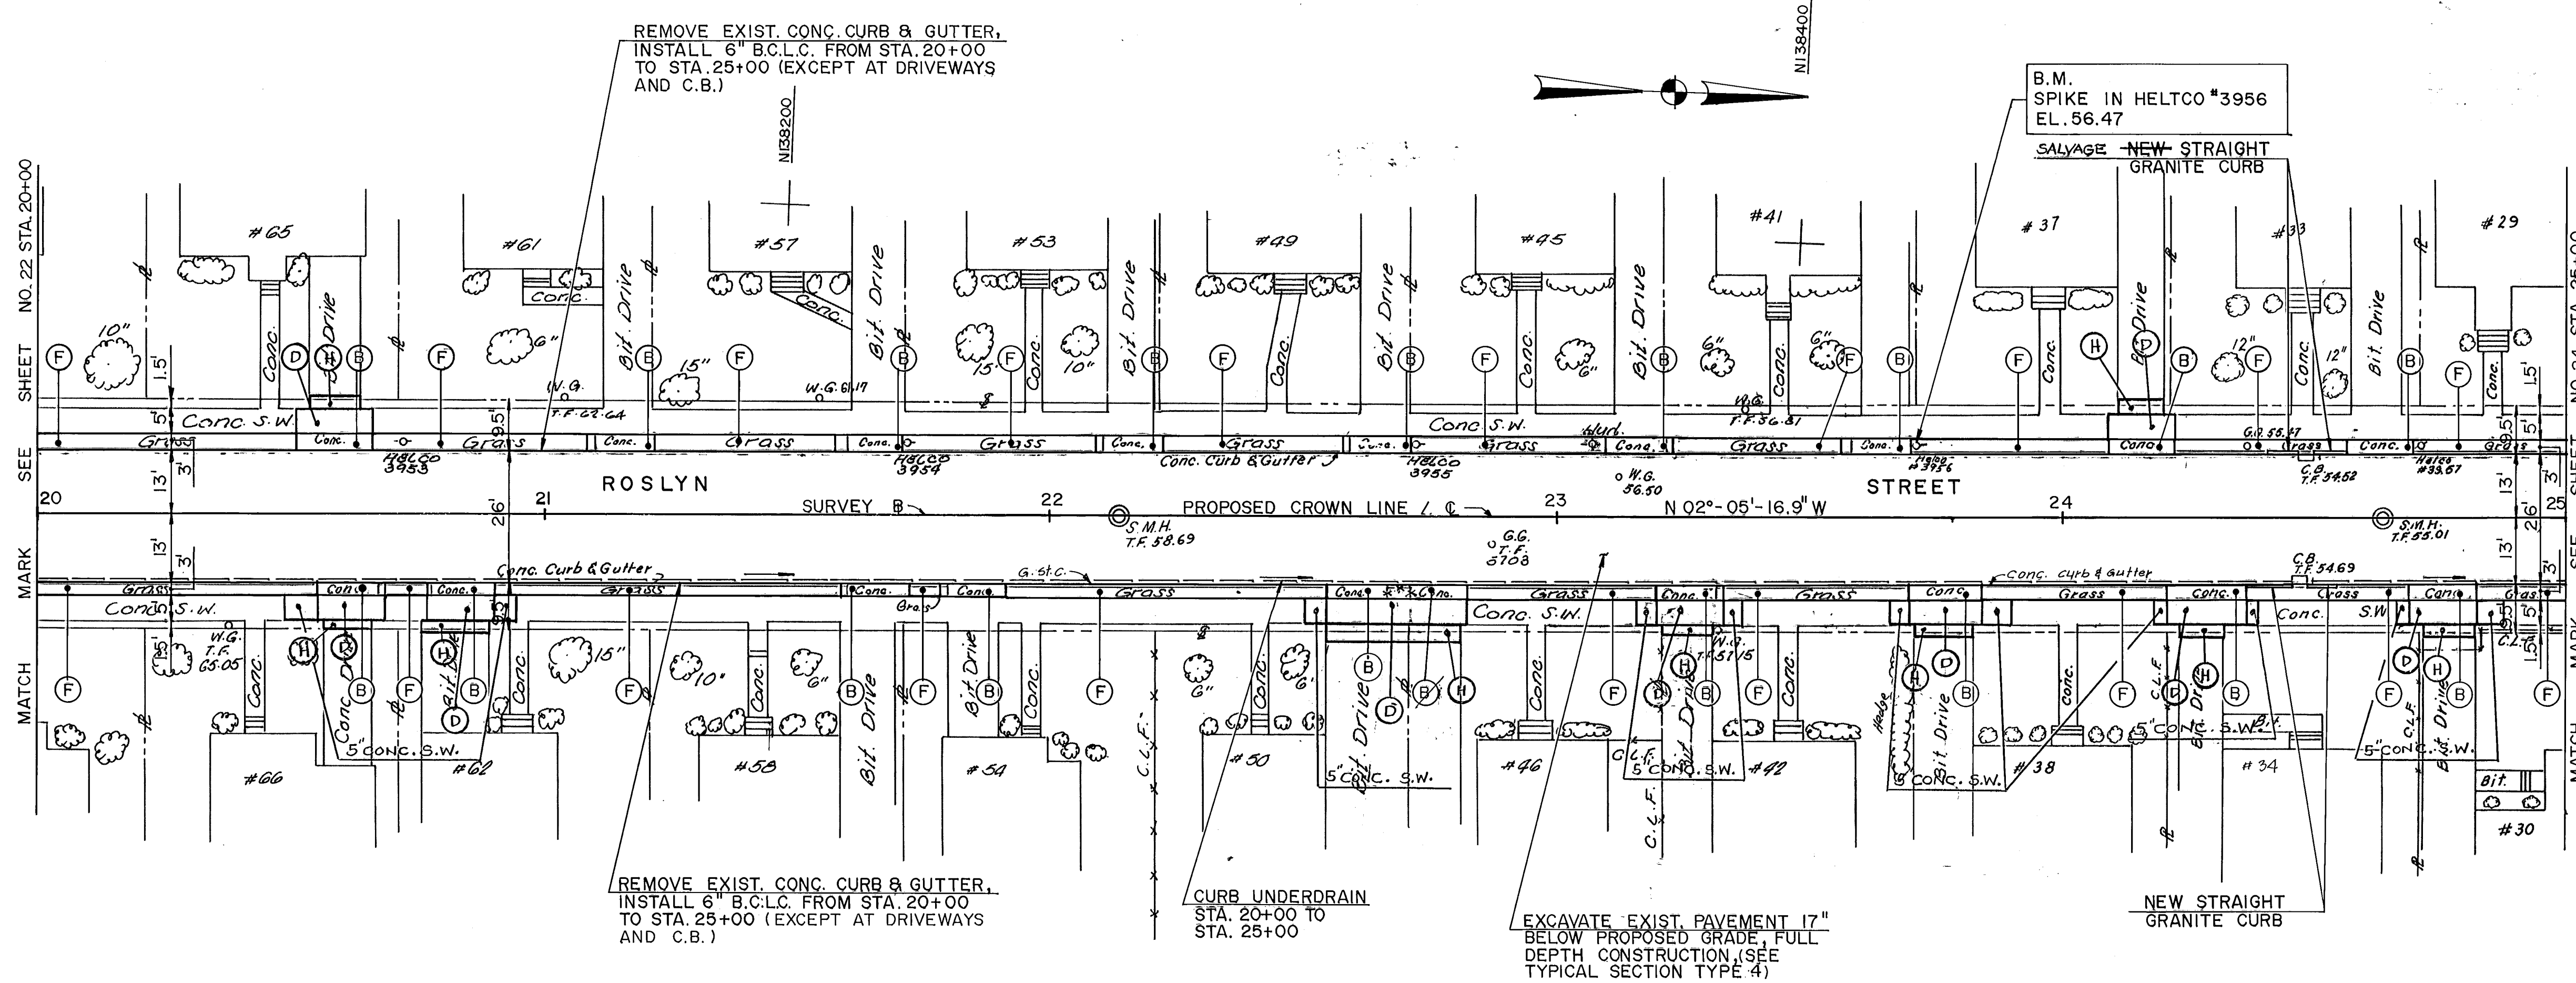

- NOTES**
- (B) SAWCUT BETWEEN EXISTING RAMPED SECTION AND SIDEWALK, AND CONSTRUCT 8" REINFORCED CONC. DRIVEWAY RAMP
 - (F) SEEDING AND MULCHING
 - FOR GENERAL NOTES AND LIST OF ABBREVIATIONS SEE SHEET NO. 2.
 - FOR CONSTRUCTION NOTES SEE SHEET NO. 8.
 - SURVEY-BASELINE IS LOCATED 13.00 FT. EAST FROM FACE OF WEST CURB.
 - (D) CONSTRUCT 8" REINFORCED CONC. SIDEWALK
 - (H) CONSTRUCT BIT. CONC. DRIVEWAY

PLAN
SCALE: 1" = 20'

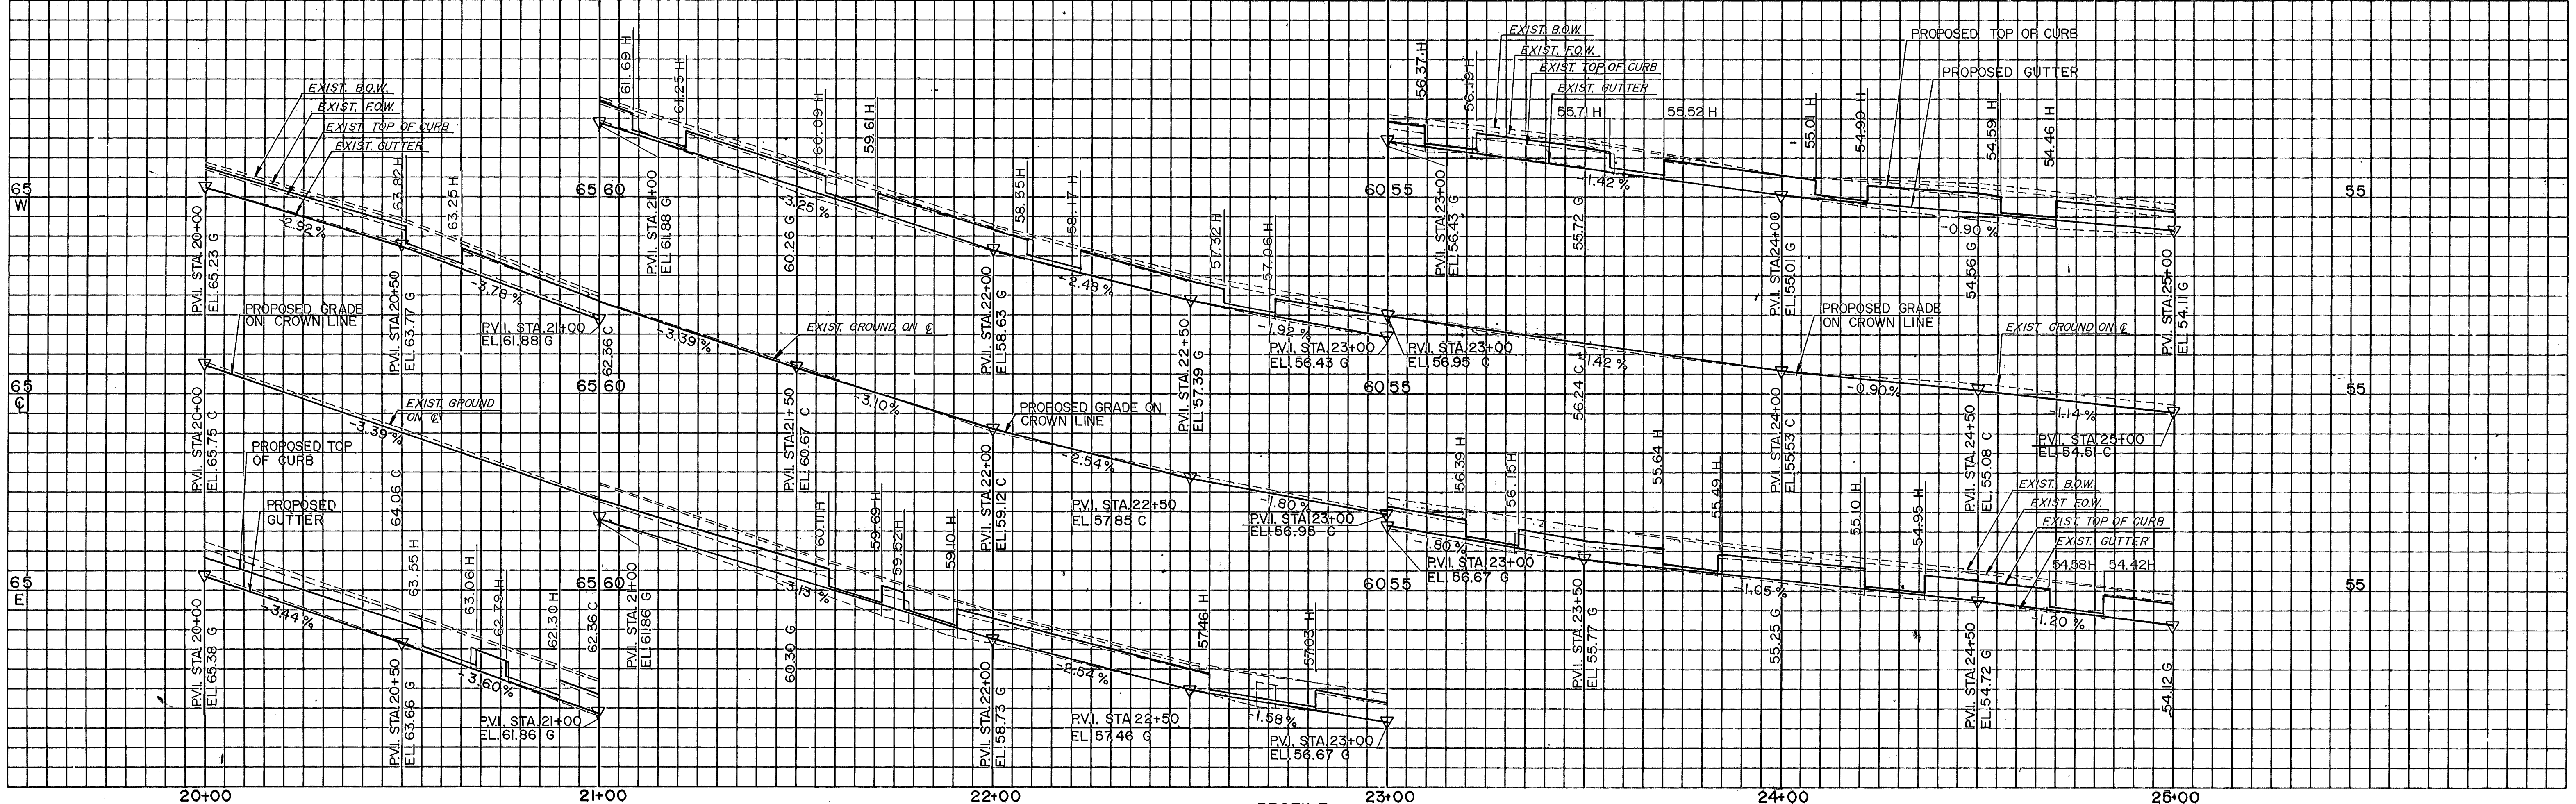

PROFILE
SCALE: VERT. 1" = 2', HORIZ. 1" = 20'

ROSLYN STREET			
PLAN AND PROFILE			
THE CITY OF HARTFORD, CONNECTICUT			
DESIGNED: P.L.		DATE: MARCH 23, 1988	
DRAWN: M.J.F.		SCALE: AS NOTED	
CHECKED: A.M.		SHEET NO. 23 OF 48	
APPROVED: R.C.G.		DAYBOOK NO. 011113C	

PURCELL
ASSOCIATES