


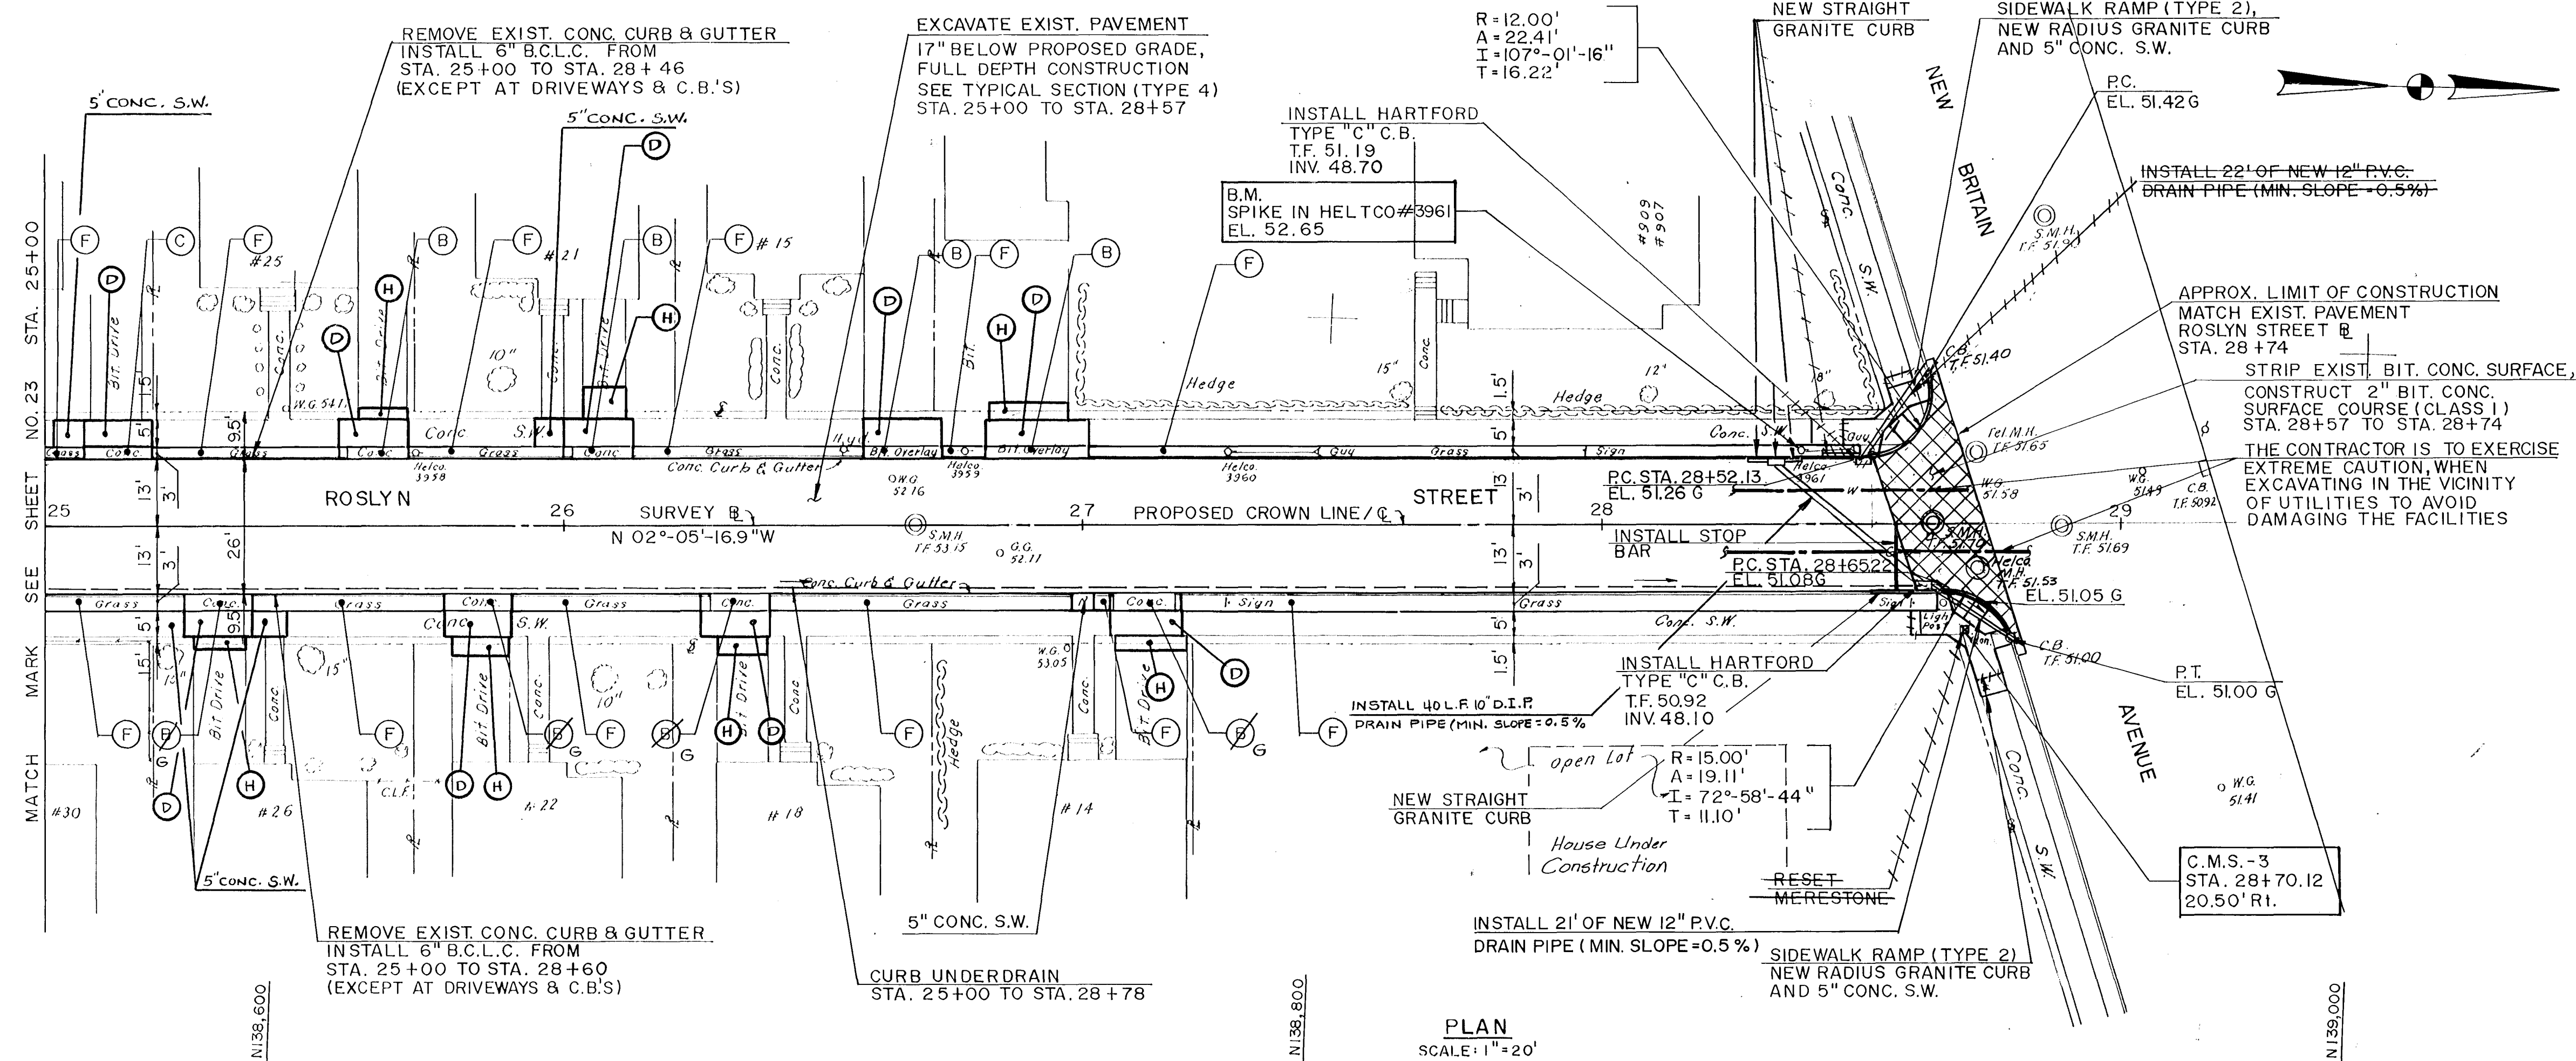


# NOTES

- (B) SAWCUT BETWEEN EXISTING RAMPED SECTION AND SIDEWALK, AND CONSTRUCT 8" REINFORCED CONC. DRIVEWAY RAMP.

(C) EXISTING DRIVEWAY RAMP TO REMAIN

(F) SEEDING AND MULCHING
  - FOR GENERAL NOTES AND LIST OF ABBREVIATIONS SEE SHEET NO. 2
  - FOR CONSTRUCTION NOTES SEE SHEET NO. 8
  - SURVEY BASELINE IS LOCATED 20.50 FT. WEST OF C.M.S.-3.
- (D) CONSTRUCT 8" REINF. CONC. SIDEWALK
- (H) CONSTRUCT BIT. CONC. DRIVEWAY
- (G) CONSTRUCT 8" REINF. DRIVEWAY RAMP

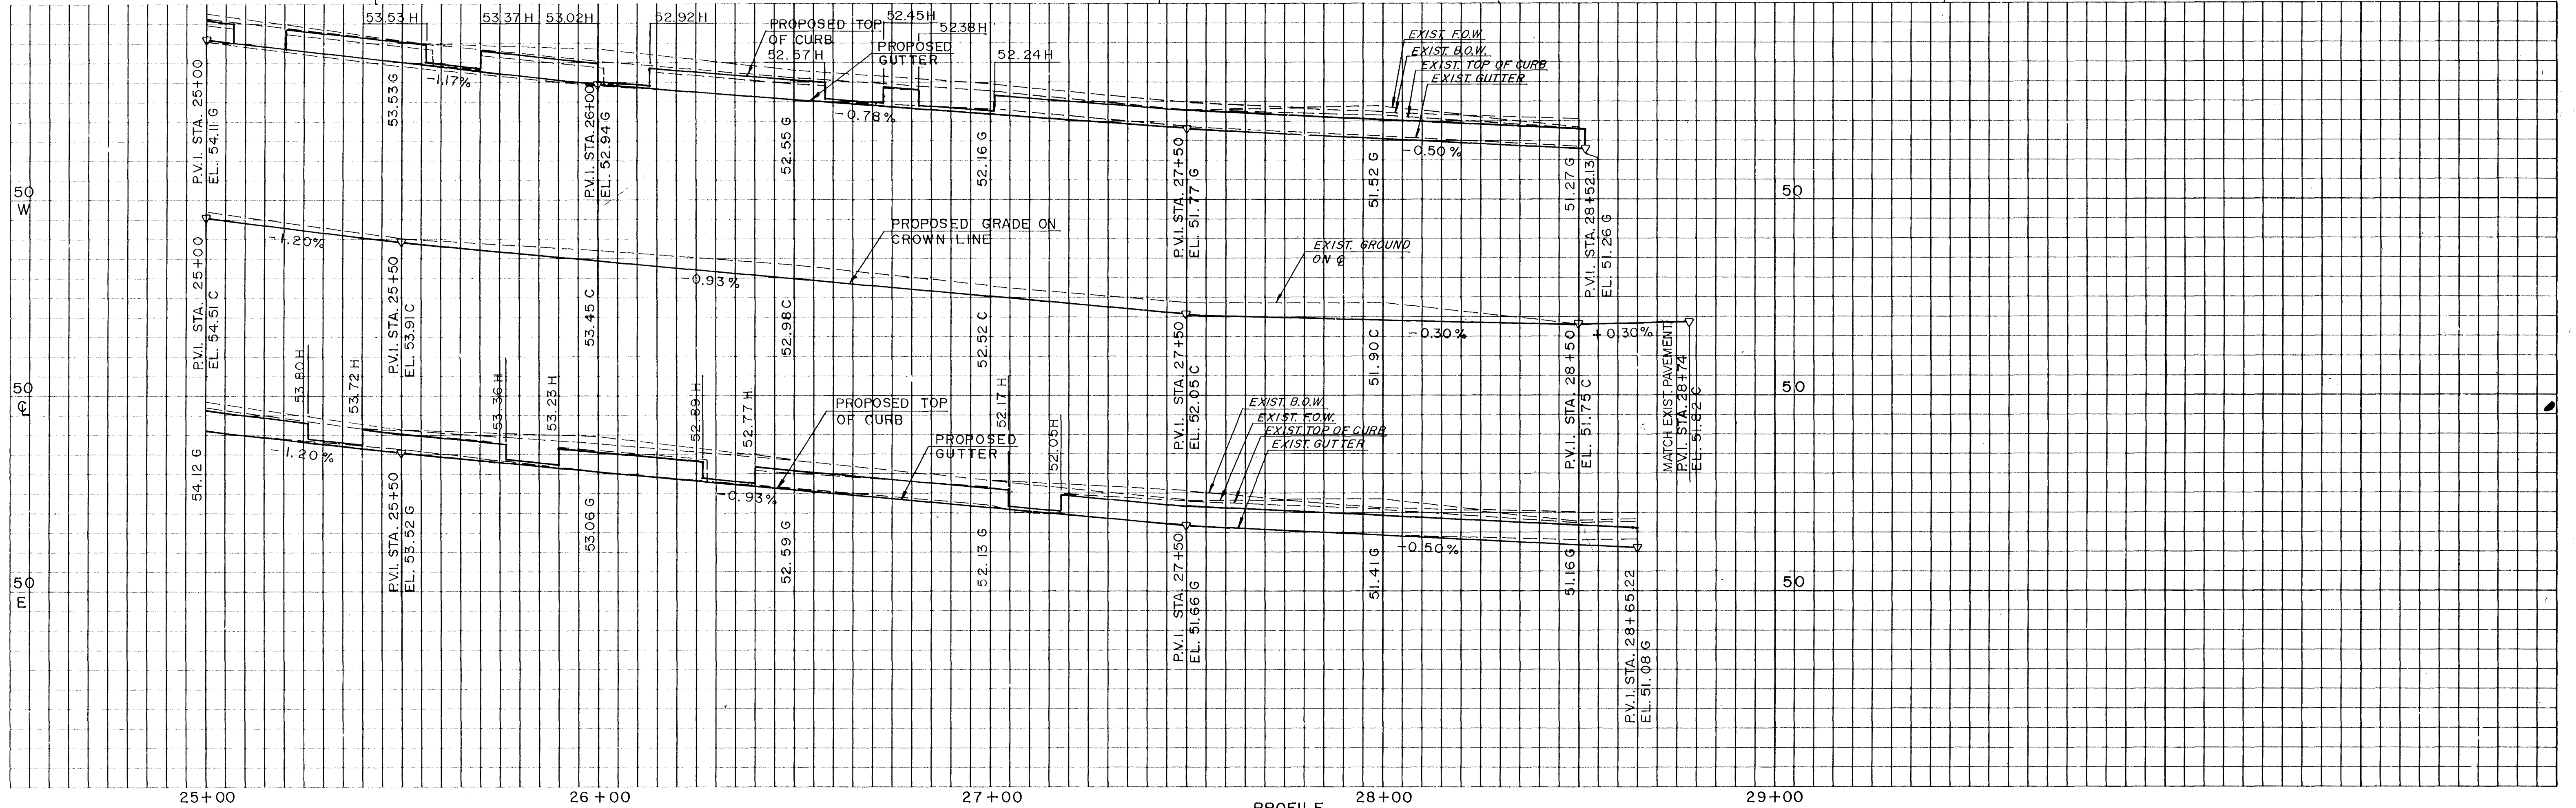

| ROSLYN STREET                     |                      |                                                                               |  |
|-----------------------------------|----------------------|-------------------------------------------------------------------------------|--|
| PLAN AND PROFILE                  |                      |                                                                               |  |
| THE CITY OF HARTFORD, CONNECTICUT |                      |                                                                               |  |
| DESIGNED: P.L.                    | DATE: MARCH 23, 1988 | <div> <div> SHEET NO. 24 OF 48 </div> <div> DAYBOOK NO. 01113 C </div> </div> |  |
| DRAWN: T.N.S.                     | SCALE: AS NOTED      |                                                                               |  |
| CHECKED: A.M.                     |                      |                                                                               |  |
| APPROVED: R.C.G.                  |                      |                                                                               |  |

**PURCELL**  
ASSOCIATES