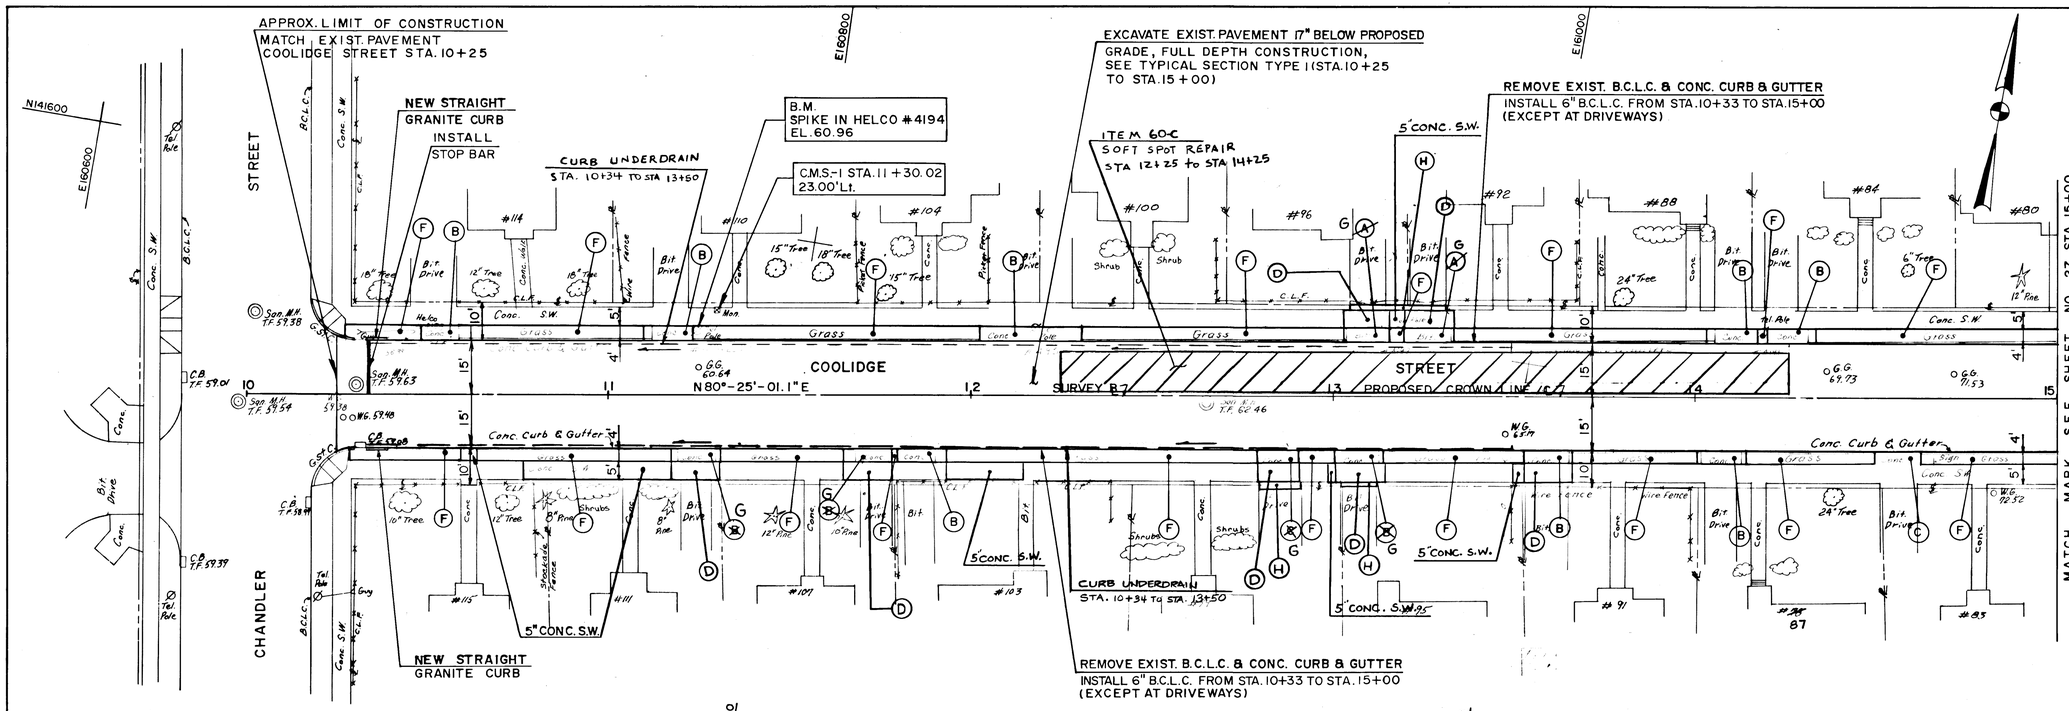

PLAN
SCALE: 1" = 20'

NOTES

1. (A) CONSTRUCT BIT. CONC. DRIVEWAY RAMP.
   (B) SAWCUT BETWEEN EXISTING RAMPED SECTION AND SIDEWALK, AND CONSTRUCT 8" REINFORCED CONC. DRIVEWAY RAMP.
   (C) EXISTING DRIVEWAY RAMP TO REMAIN.
   (F) SEEDING & MULCHING.
2. FOR GENERAL NOTES AND LIST OF ABBREVIATIONS SEE SHEET NO. 2
3. FOR CONSTRUCTION NOTES SEE SHEET NO. 8
4. SURVEY BASELINE IS LOCATED 23.00 FT. SOUTH OF C.M.S.-1.

(D) CONSTRUCT 8" REINF. CONC. SIDEWALK
(G) CONSTRUCT 8" REINF. CONC. DRIVEWAY RAMP.

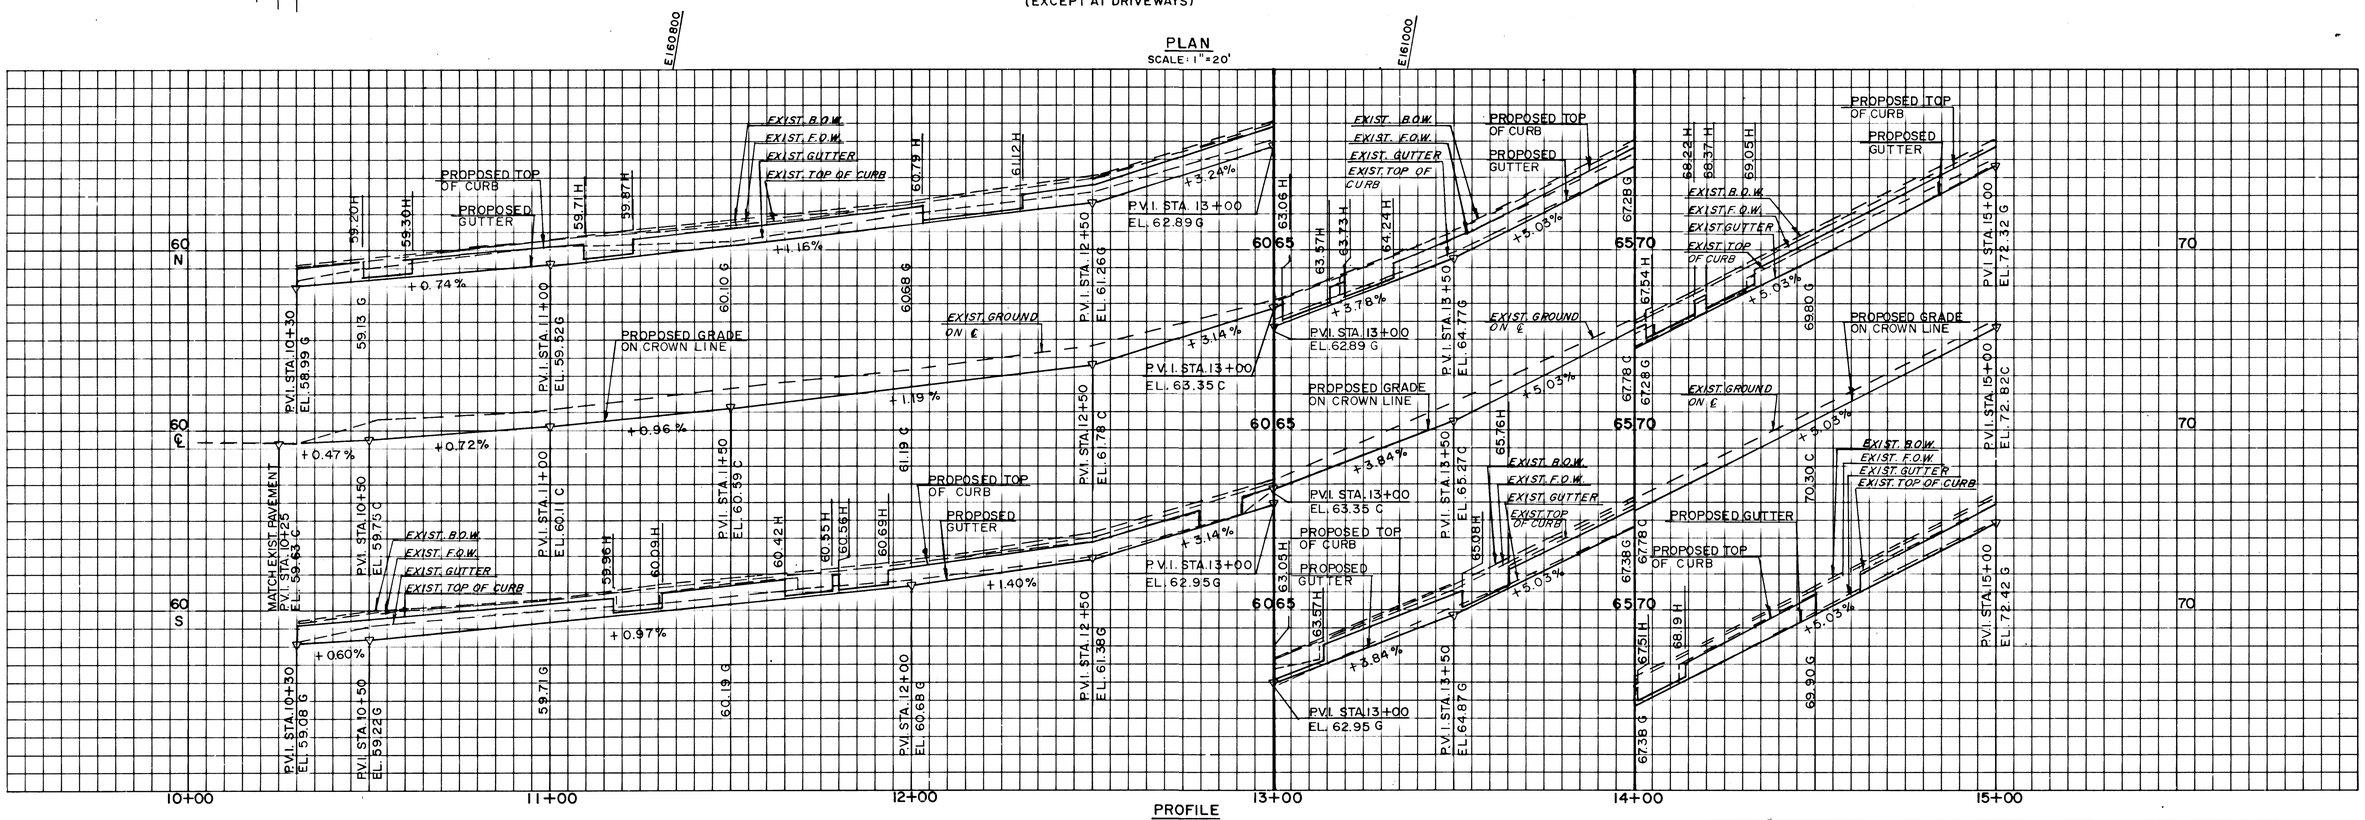

PROFILE
SCALE:
VERT. 1" = 2'
HORIZ. 1" = 20'

NO.	DATE	REVISION
	JAN 90	AS BUILT

DESIGNED: D.M.
DRAWN: C.L.P.
CHECKED: A.M.
APPROVED: R.C.G.

DATE MARCH 23, 1988
SCALE AS NOTED

COOLIDGE STREET
PLAN AND PROFILE
THE CITY OF
HARTFORD, CONNECTICUT

PURCELL ASSOCIATES

SHEET NO. 26 OF 48
DAYBOOK NO. 01113E

577/27