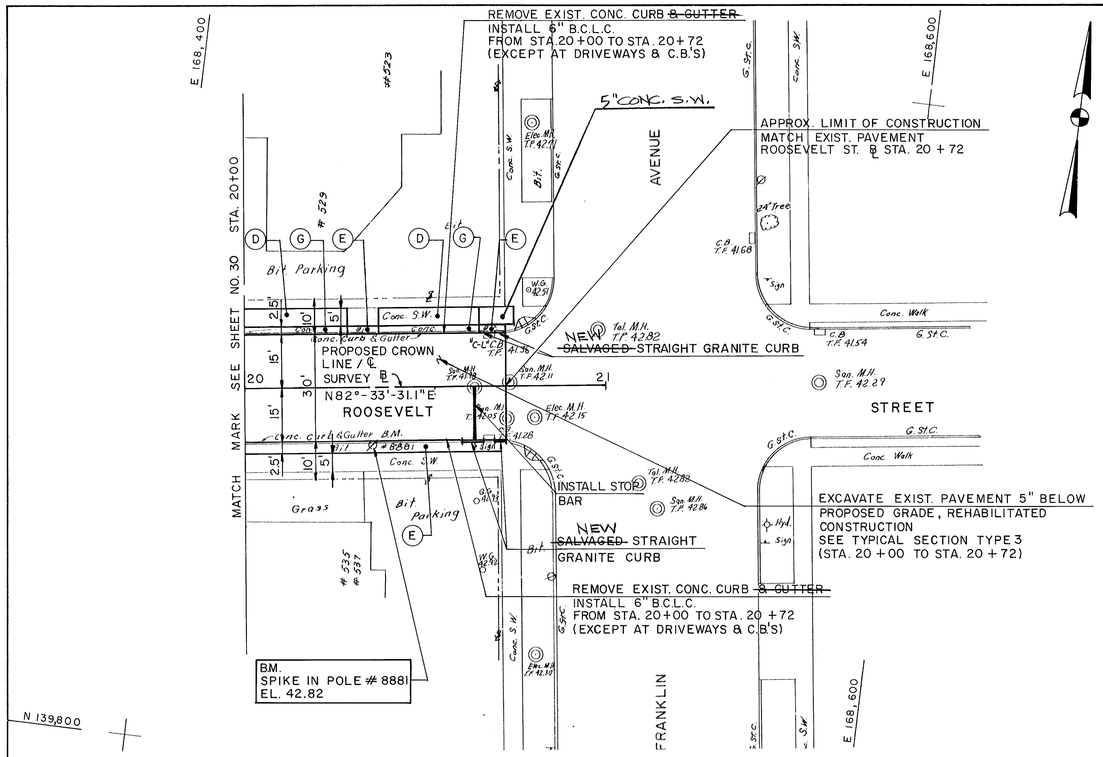

NOTES

1. (D) CONSTRUCT 8" REINFORCED CONC. SIDEWALK.
   (E) CONSTRUCT 2" BIT. CONC. SURFACE ON NEW FOUNDATION, EXCEPT AT DRIVEWAYS AND RAMPS.
   (G) CONSTRUCT 8" REINFORCED CONC. DRIVEWAY RAMP.
2. FOR GENERAL NOTES AND LIST OF ABBREVIATIONS SEE SHEET NO. 2.
3. FOR CONSTRUCTION NOTES SEE SHEET NO. 8.
4. SURVEY BASELINE IS LOCATED 15.00 FT. NORTH FROM FACE OF SOUTH CURB.
   (H) CONSTRUCT BIT. CONC. DRIVEWAY.

PLAN
SCALE: 1" = 20'

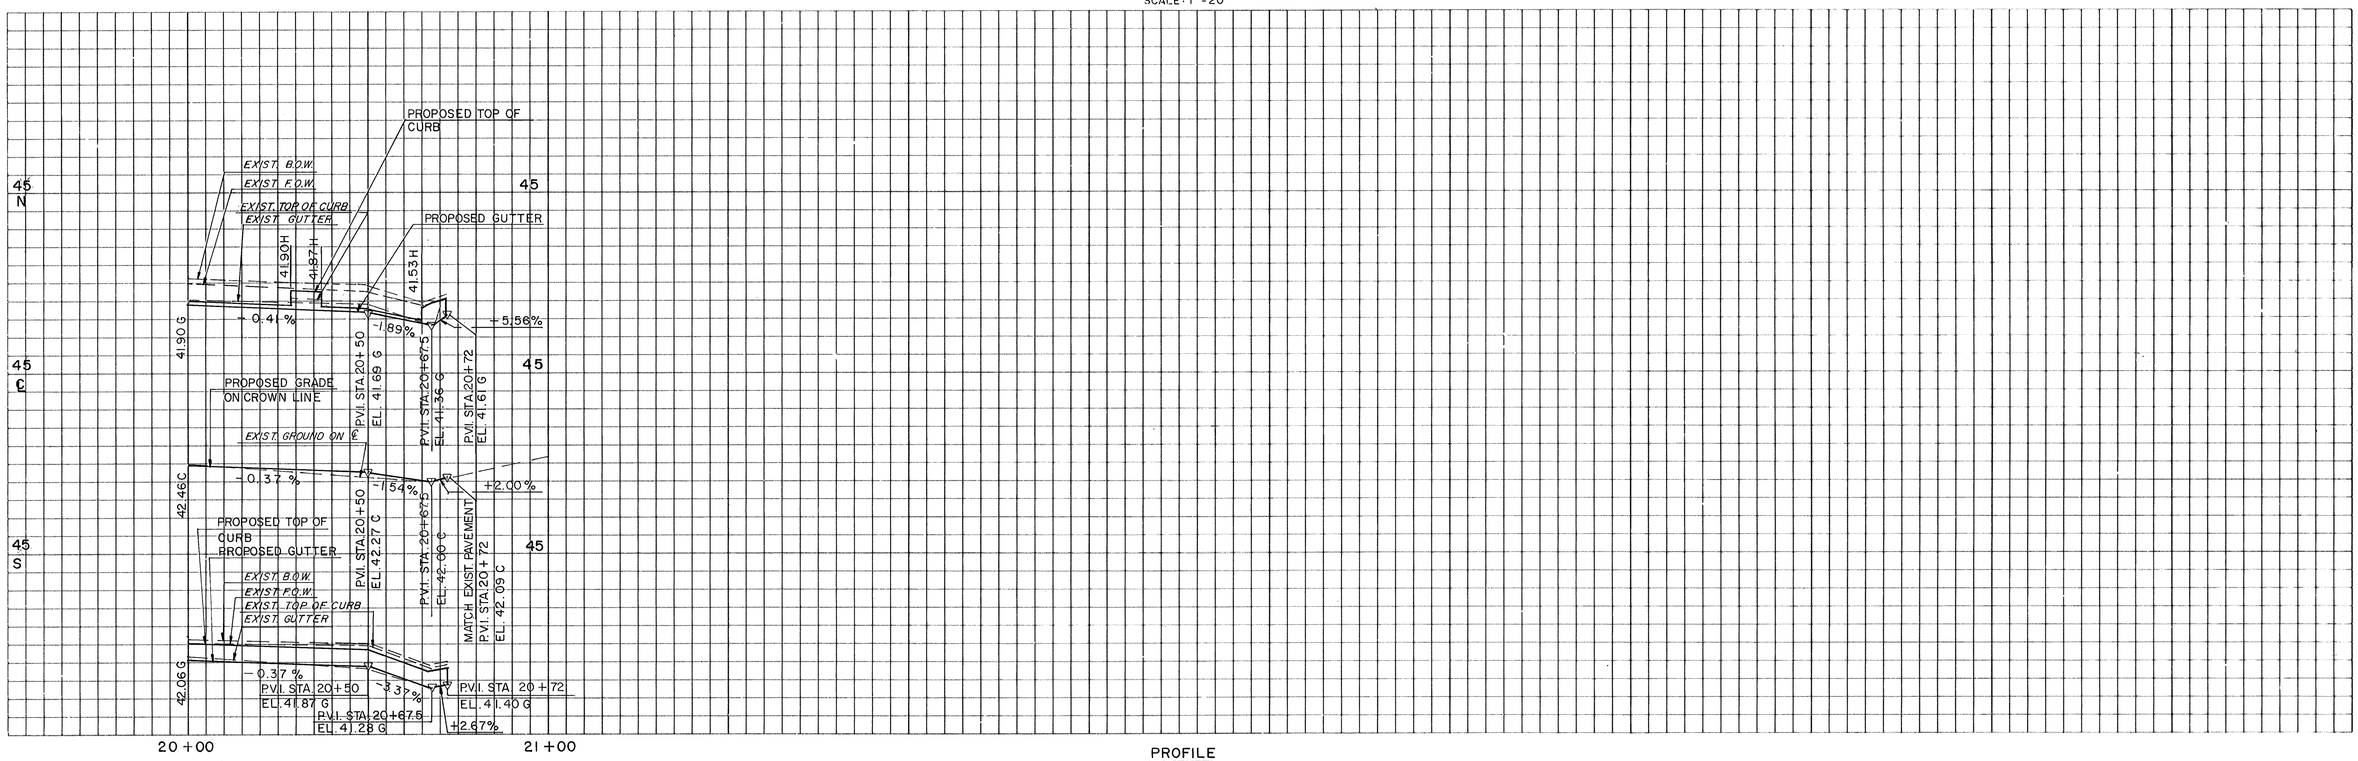

PROFILE
SCALE:
VERT. 1" = 2'
HORIZ. 1" = 20'

NO.	DATE	REVISION
	Jan 90	As Built

DESIGNED: I.R.
DRAWN: C.B.
CHECKED: A.M.
APPROVED: R.C.G.

DATE MARCH 23, 1988
SCALE AS NOTED

ROOSEVELT STREET
PLAN AND PROFILE
THE CITY OF HARTFORD, CONNECTICUT

PURCELL ASSOCIATES

SHEET NO. 31 OF 48
DAYBOOK NO. 011113 F

577/27