



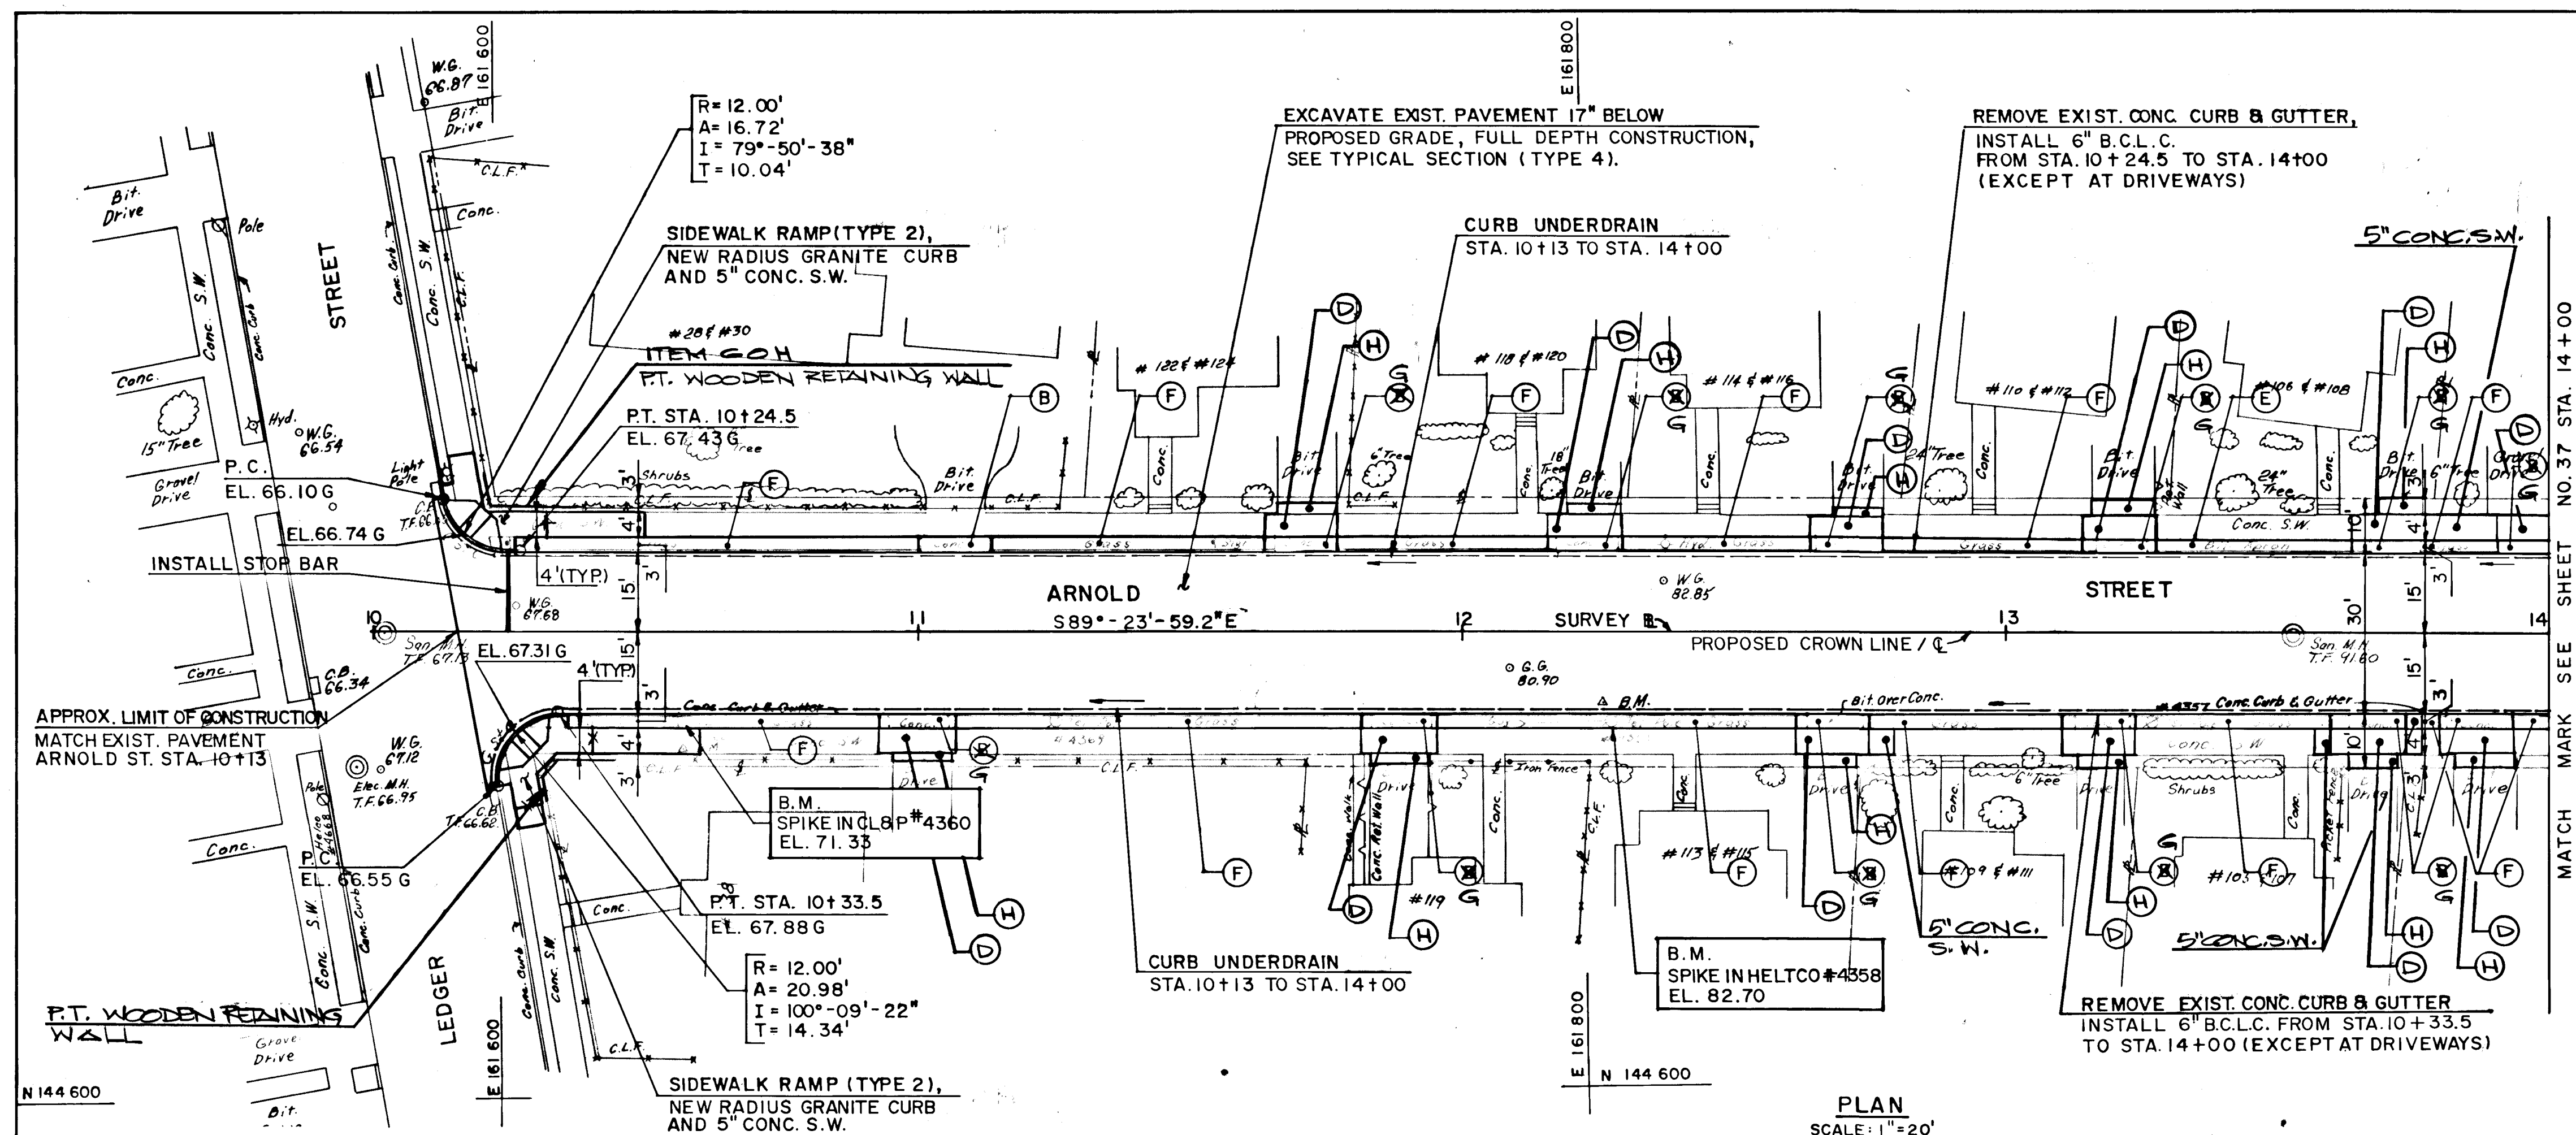

NOTES

1. (B) SAWCUT BETWEEN EXISTING RAMPED SECTION AND SIDEWALK, AND CONSTRUCT 8" REINFORCED CONC. DRIVEWAY RAMP.
 - (E) CONSTRUCT 2" BIT. CONC. SURFACE ON NEW FOUNDATION, EXCEPT AT DRIVEWAYS AND RAMPS.
 - (D) ~~CONSTRUCT 8" REINFORCED CONC. SIDEWALK.~~
 - (F) SEEDING AND MULCHING.
2. FOR GENERAL NOTES AND LIST OF ABBREVIATIONS SEE SHEET NO. 2
 3. FOR CONSTRUCTION NOTES SEE SHEET NO. 8
 4. SURVEY BASELINE IS LOCATED 15.00 FT. SOUTH FROM FACE OF SOUTH CURB.
- (G) CONSTRUCT 8" REINFORCED DRIVEWAY RAMP
 - (H) CONSTRUCT BIT. CONC. DRIVEWAY.

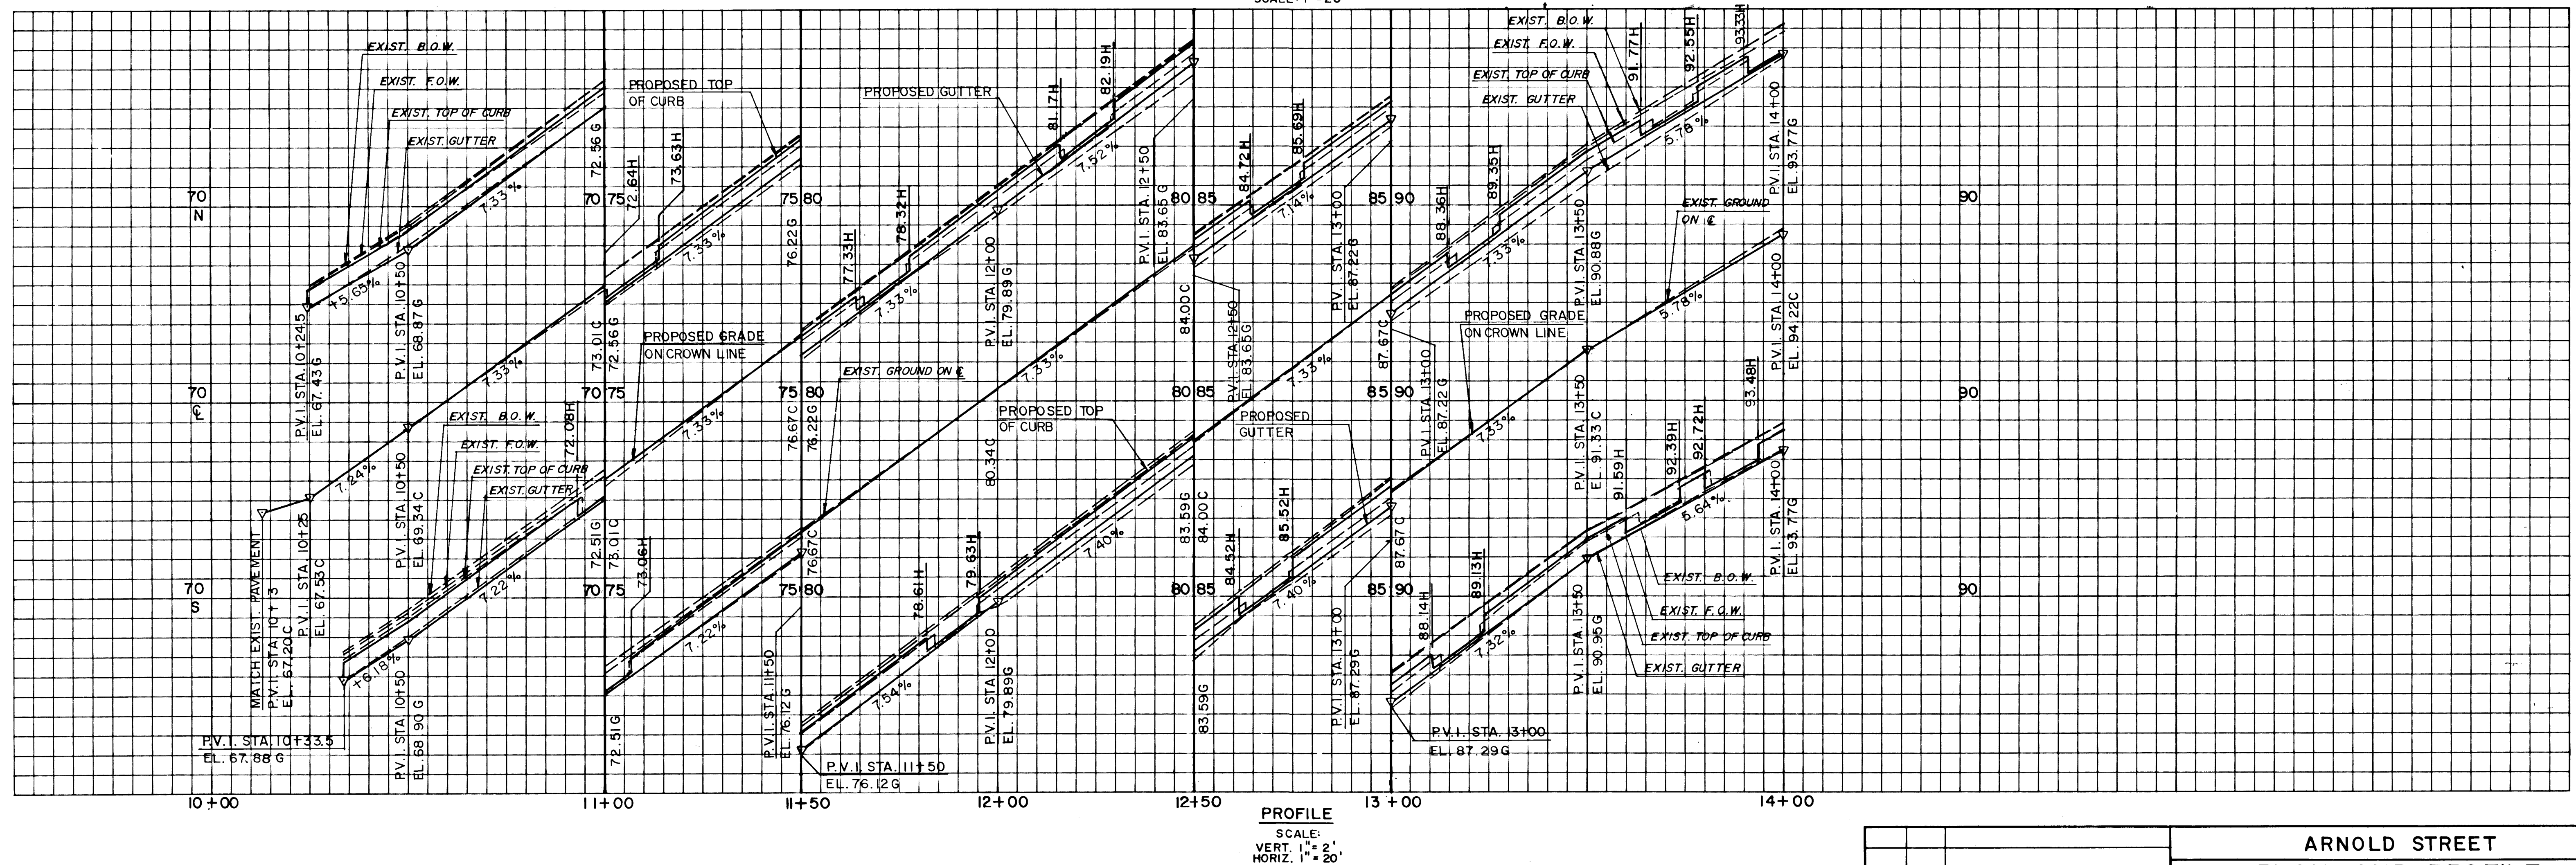

		ARNOLD STREET	
		PLAN AND PROFILE	
		THE CITY OF	
		HARTFORD, CONNECTICUT	
NO.	DATE	REVISION	
DESIGNED: F.C.B.			
DRAWN: D.J.R.	DATE	MARCH 23, 1988.	
CHECKED: A.M.			
APPROVED: R.C.G.	SCALE	AS NOTED	
			SHEET NO. 36 OF 48
			DAYBOOK NO. 011113 H.