


## NOTES

1. (B) SAWCUT BETWEEN EXISTING RAMPED SECTION AND SIDEWALK, AND CONSTRUCT 8" REINFORCED CONC. DRIVEWAY RAMP
   (F) SEEDING AND MULCHING
2. FOR GENERAL NOTES AND LIST OF ABBREVIATIONS SEE SHEET NO. 2
3. FOR CONSTRUCTION NOTES SEE SHEET NO. 8
4. SURVEY BASELINE IS LOCATED 23.00 FT. SOUTH OF C.M.S.-1.

(D) CONSTRUCT 5" REINFORCED SIDEWALK.
(G) CONSTRUCT 8" REINFORCED DRIVEWAY RAMP.
(H) CONSTRUCT BIT. CONC. DRIVEWAY.

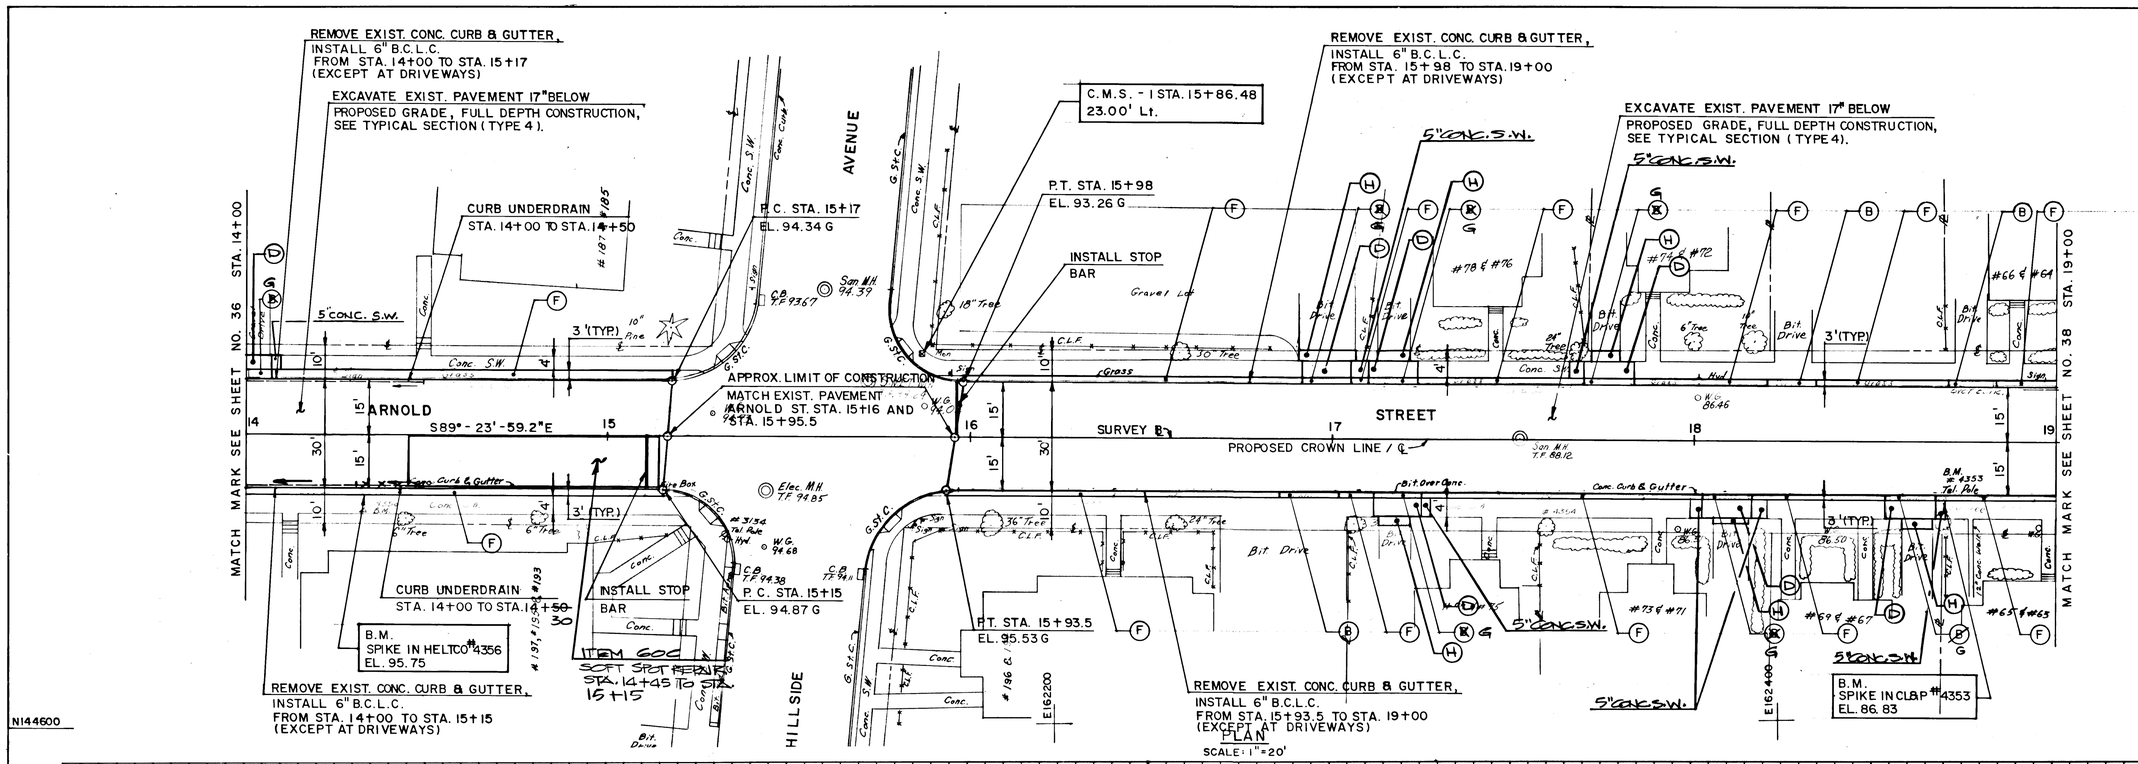


PROFILE
SCALE:
VERT. 1" = 2'
HORIZ. 1" = 20'

| NO. | DATE | REVISION |
|---|---|---|
| | Jan 90 | AS-BUILT |

DESIGNED: F.C.B.
DRAWN: D.J.R.
CHECKED: A.M.
APPROVED: R.C.G.

DATE MARCH 23, 1988.
SCALE AS NOTED
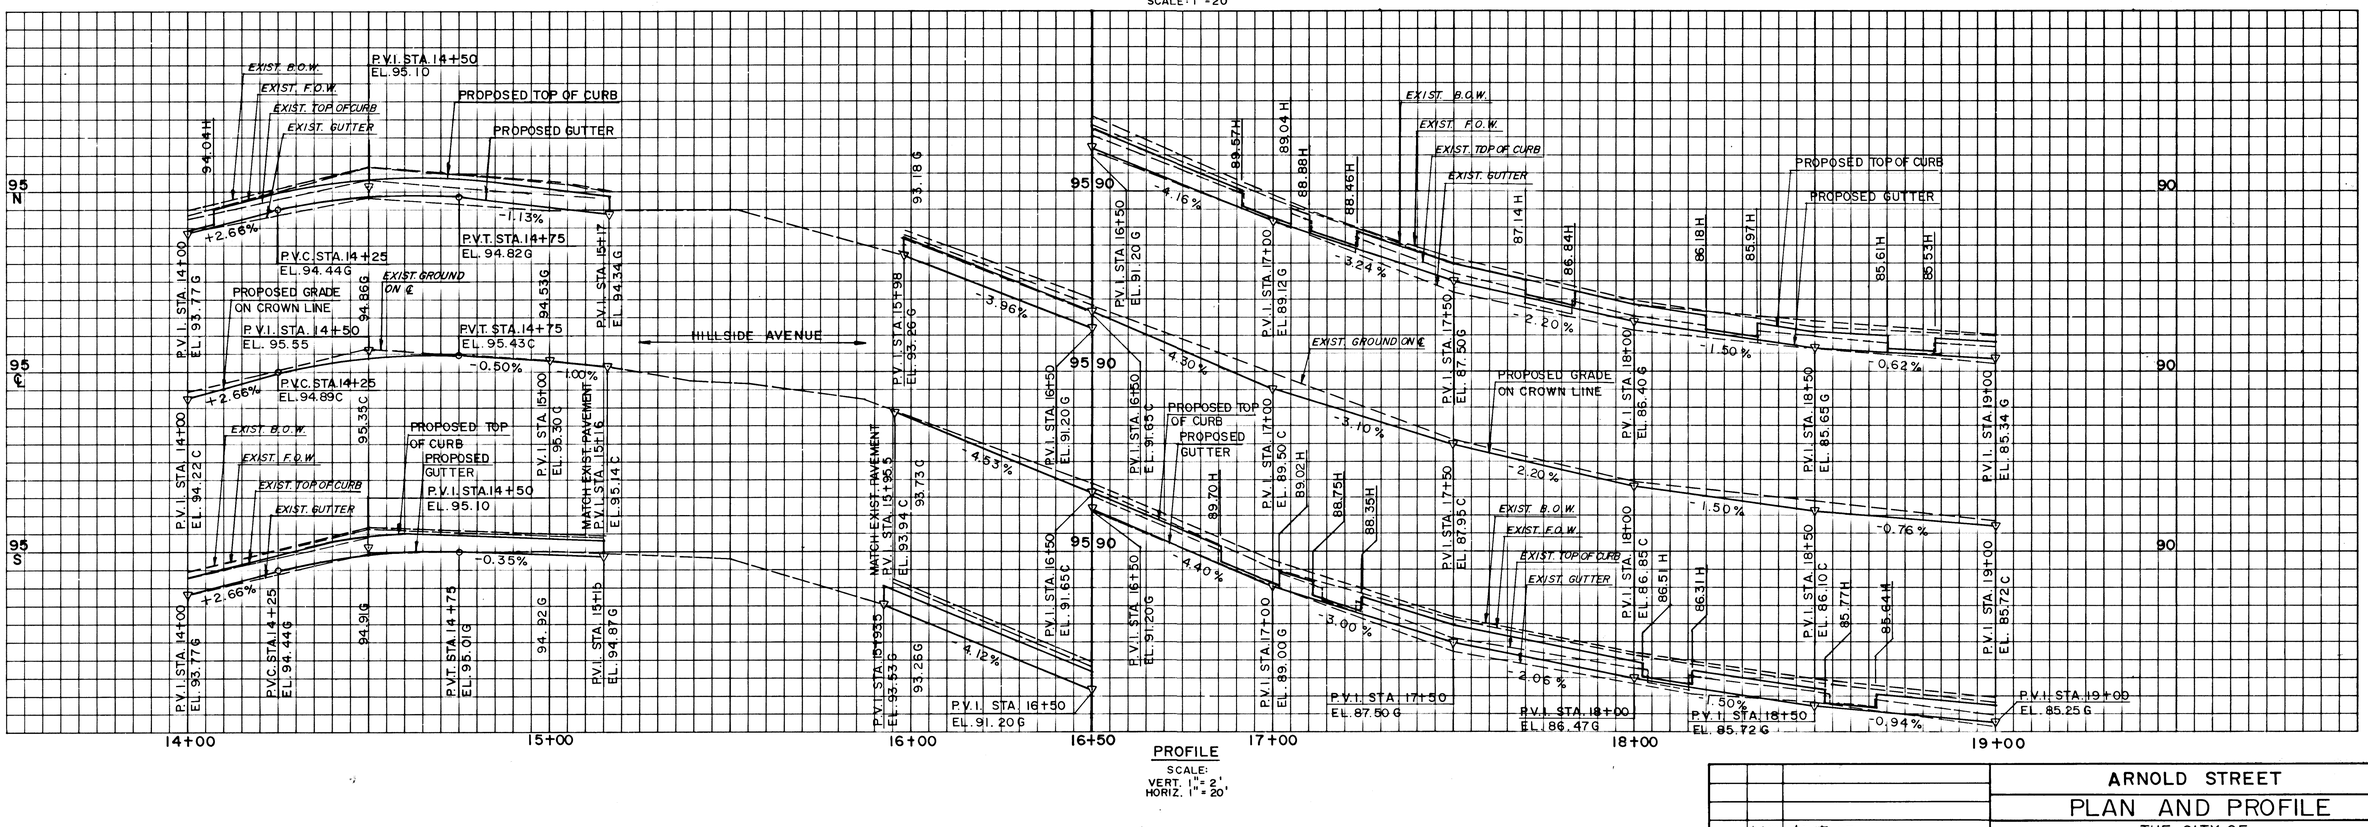
# ARNOLD STREET
## PLAN AND PROFILE
THE CITY OF HARTFORD, CONNECTICUT

PURCELL ASSOCIATES

SHEET NO. 37 OF 48
DAYBOOK NO. 01113 H