


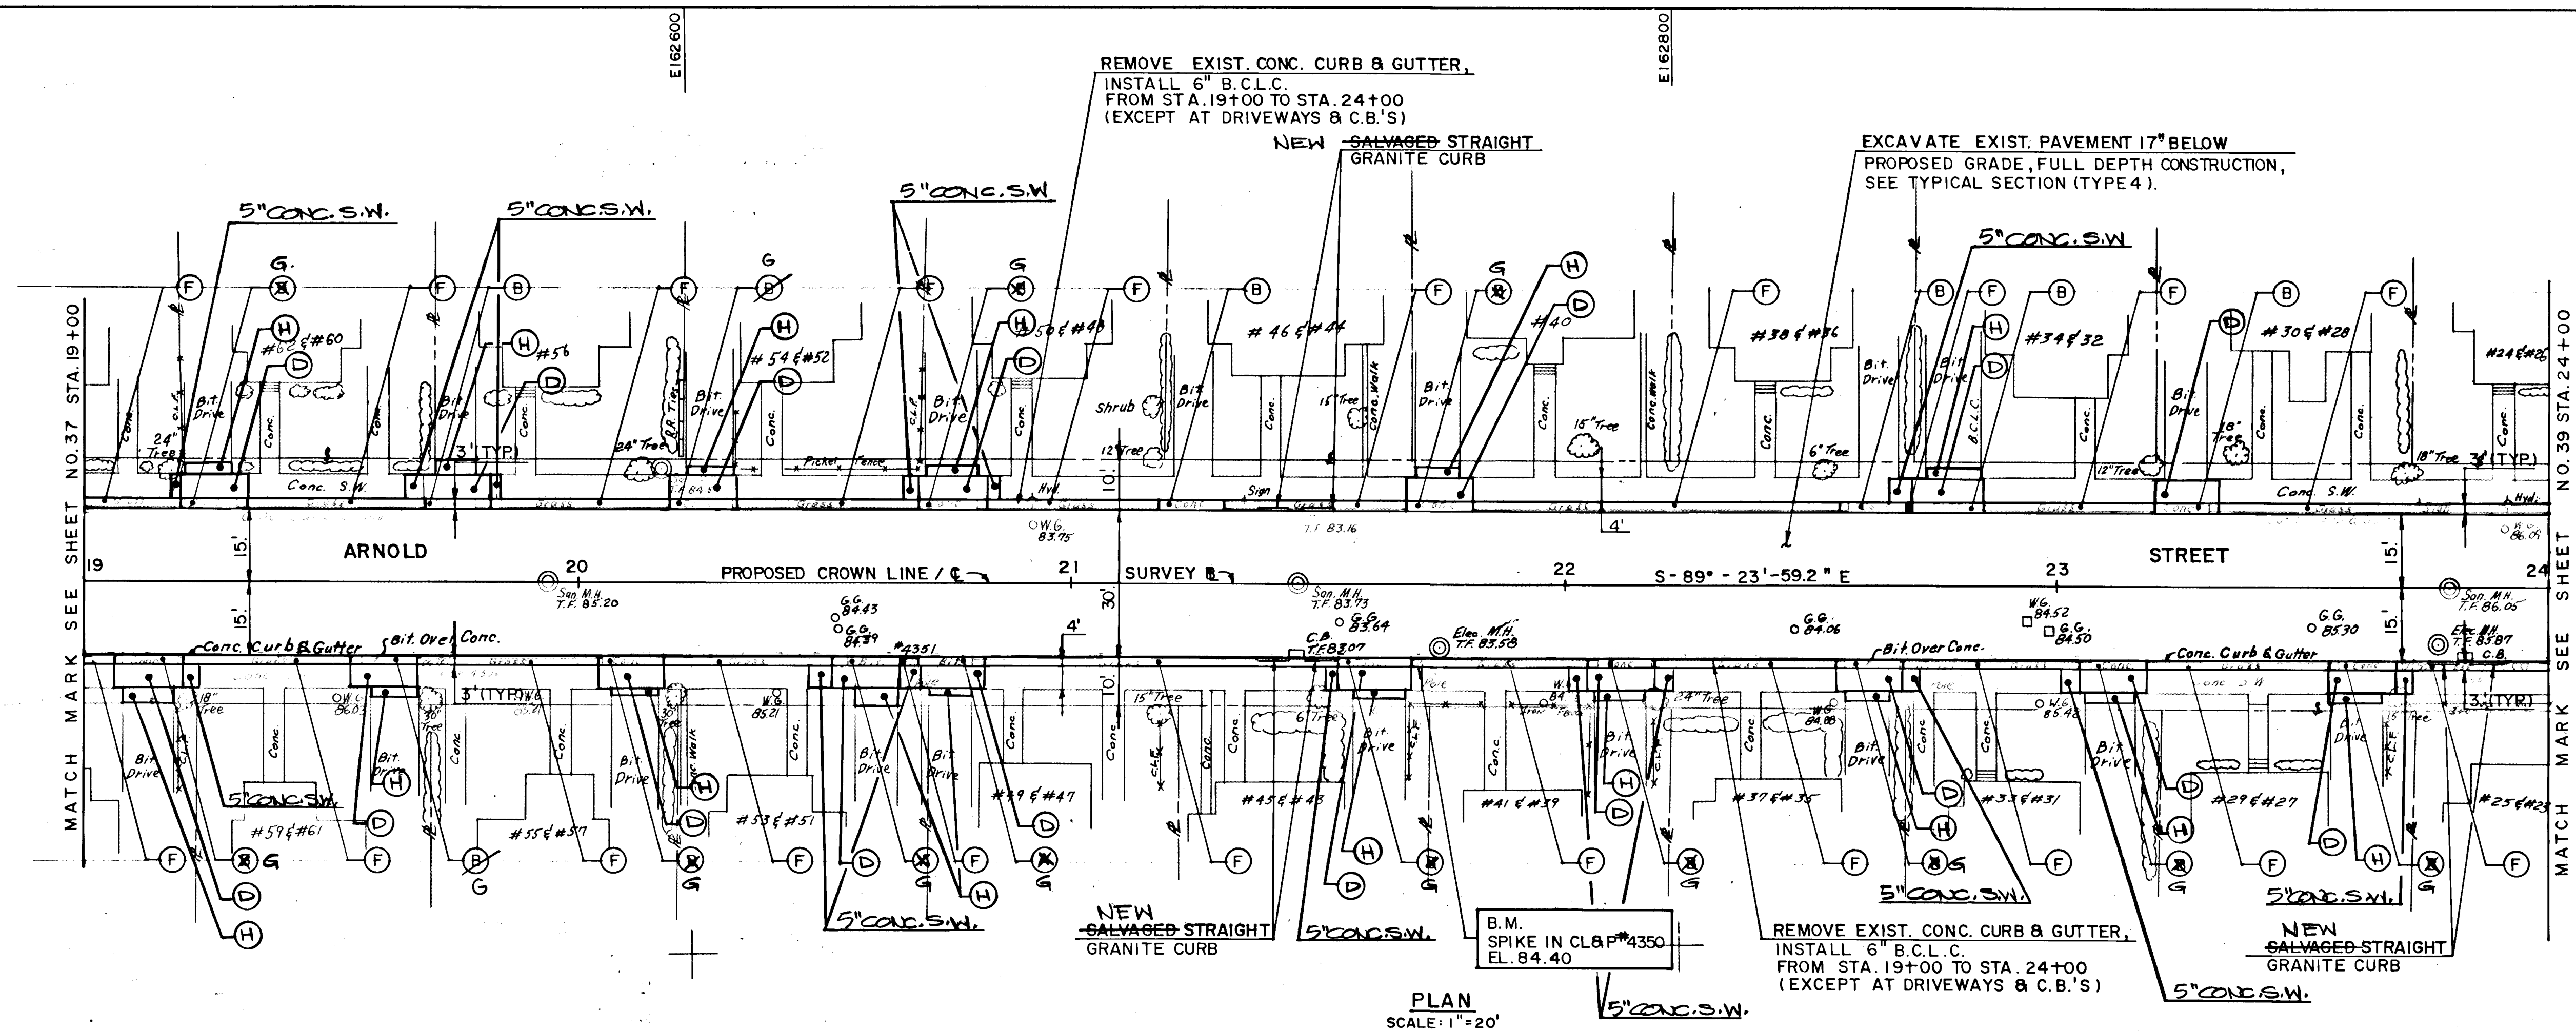

NOTES:


- (A) CONSTRUCT BIT. CONC. DRIVEWAY RAMP

(B) SAWCUT BETWEEN EXIST. RAMPED SECTION AND SIDEWALK, AND CONSTRUCT 8\"/>
- FOR GENERAL NOTES AND LIST OF ABBREVIATIONS SEE SHEET NO. 2
- FOR CONSTRUCTION NOTES SEE SHEET NO. 8
- SURVEY BASELINE IS LOCATED 15.00 FT. SOUTH FROM FACE OF SOUTH CURB.

(C) CONSTRUCT 8\"/>

(D) CONSTRUCT 8\"/>

(H) CONSTRUCT BIT. CONC. DRIVEWAY.

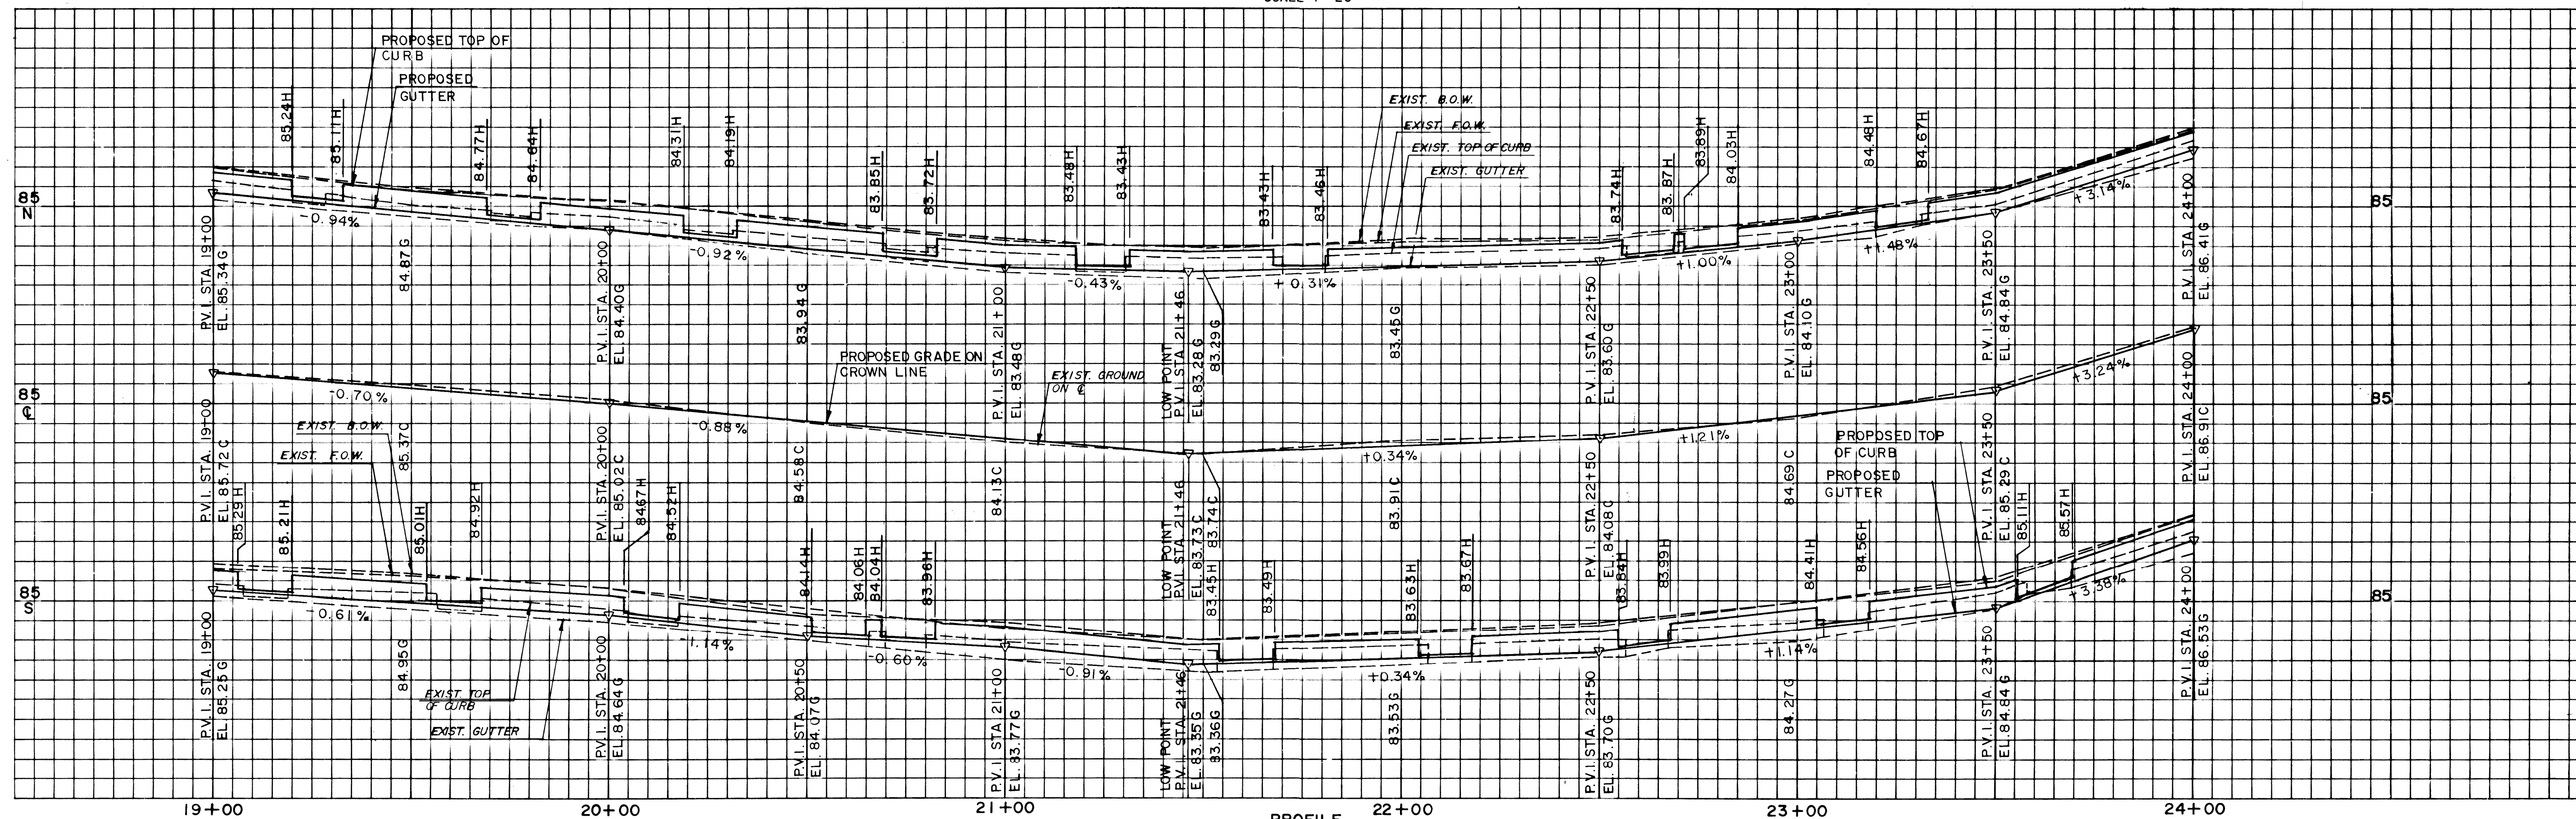

PROFILE

SCALE:
VERT. 1" = 2'
HORIZ. 1" = 20'

ARNOLD STREET PLAN AND PROFILE

THE CITY OF
HARTFORD, CONNECTICUT

DESIGNED: F.C.B.
DRAWN: D.J.R.
CHECKED: A.M.
APPROVED: R.C.G.

DATE: MARCH 23, 1988

SCALE: AS NOTED

PURCELL
ASSOCIATES

SHEET NO.
38 OF 48
DAYBOOK NO.
011113 H