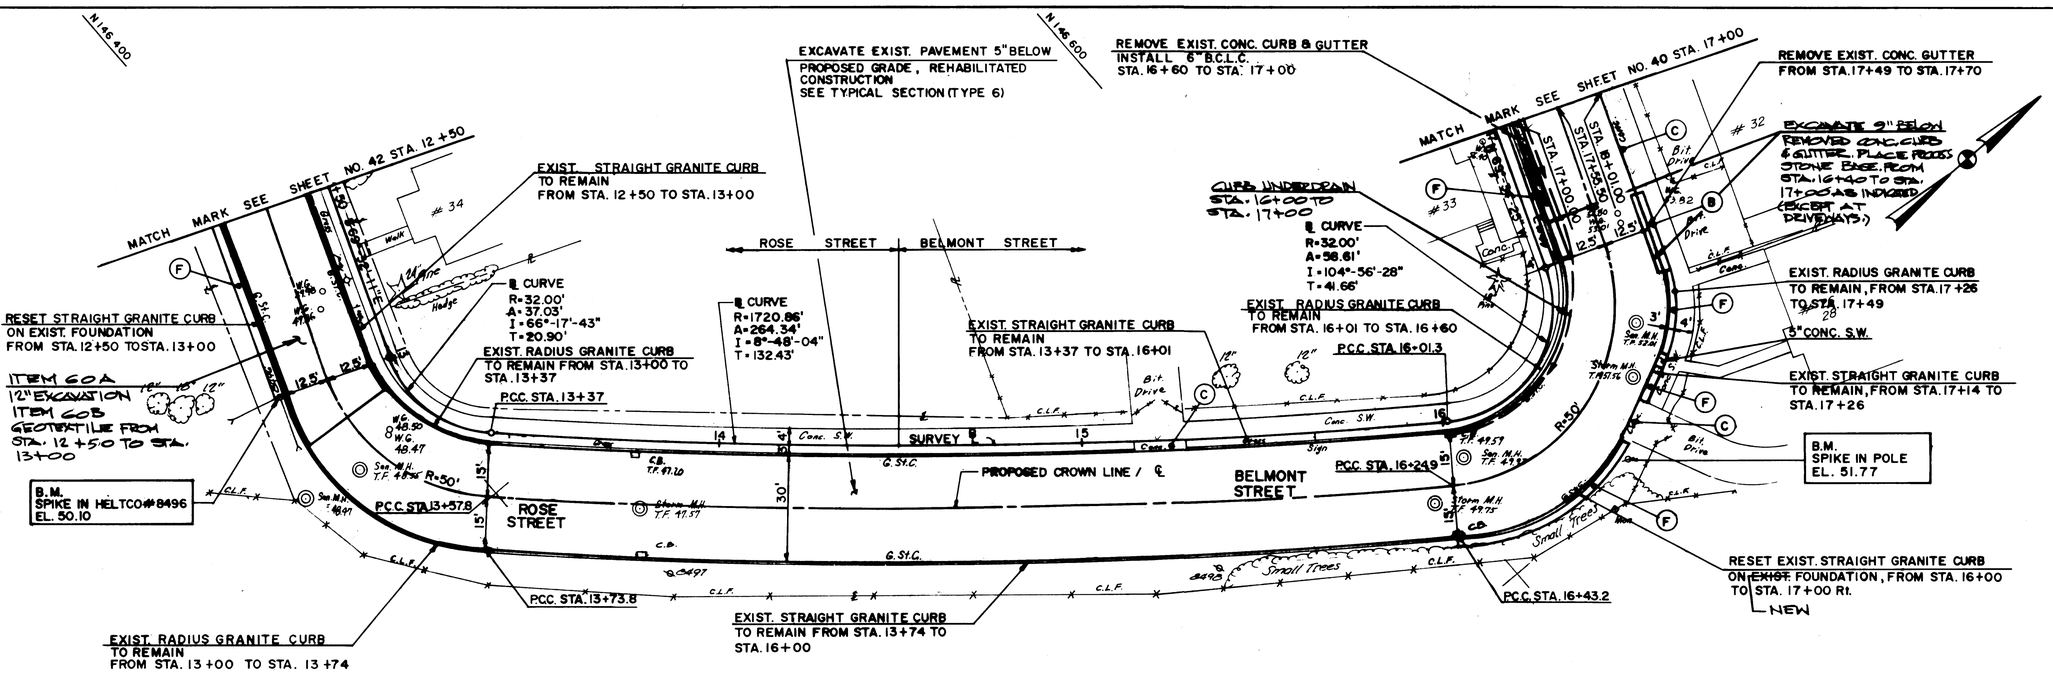

NOTES

1. (B) SAWCUT BETWEEN EXISTING RAMPED SECTION AND SIDEWALK, AND CONSTRUCT 8" REINFORCED CONC. DRIVEWAY RAMP
   (C) EXISTING DRIVEWAY RAMP TO REMAIN.
   (F) SEEDING AND MULCHING
2. FOR GENERAL NOTES AND LIST OF ABBREVIATIONS SEE SHEET NO. 2
3. FOR CONSTRUCTION NOTES SEE SHEET NO. 8
4. SURVEY BASELINE LOCATED 3.00 FT. WEST FROM FACE OF WEST CURB.

PLAN
SCALE: 1" = 20'

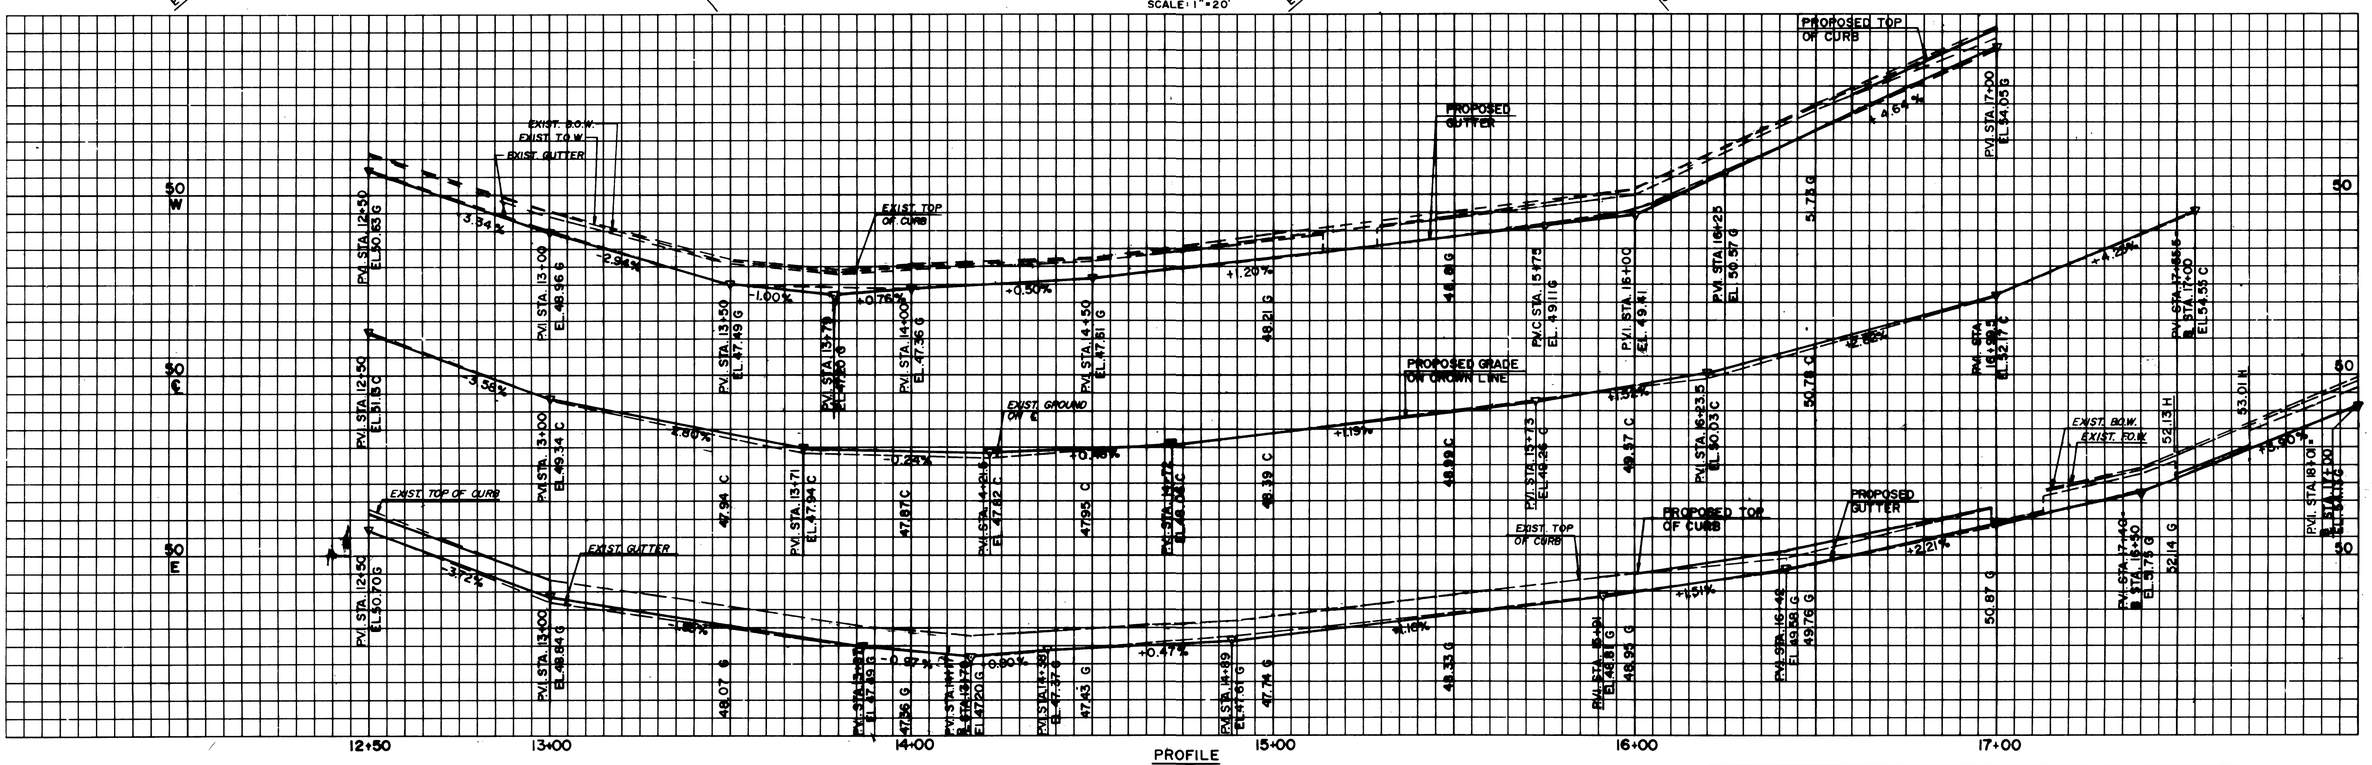

PROFILE
SCALE:
VERT. 1" = 2'
HORIZ. 1" = 20'

NO.	DATE	REVISION
	Jan 90	As Built

DESIGNED: D.M.
DRAWN: R.J.W.
CHECKED: P.L.
APPROVED: R.C.G.

DATE MARCH 23, 1988
SCALE AS NOTED

ROSE STREET / BELMONT STREET
PLAN AND PROFILE
THE CITY OF HARTFORD, CONNECTICUT

PURCELL ASSOCIATES

SHEET NO. 41 OF 48

DAYBOOK NO. 01113 4