



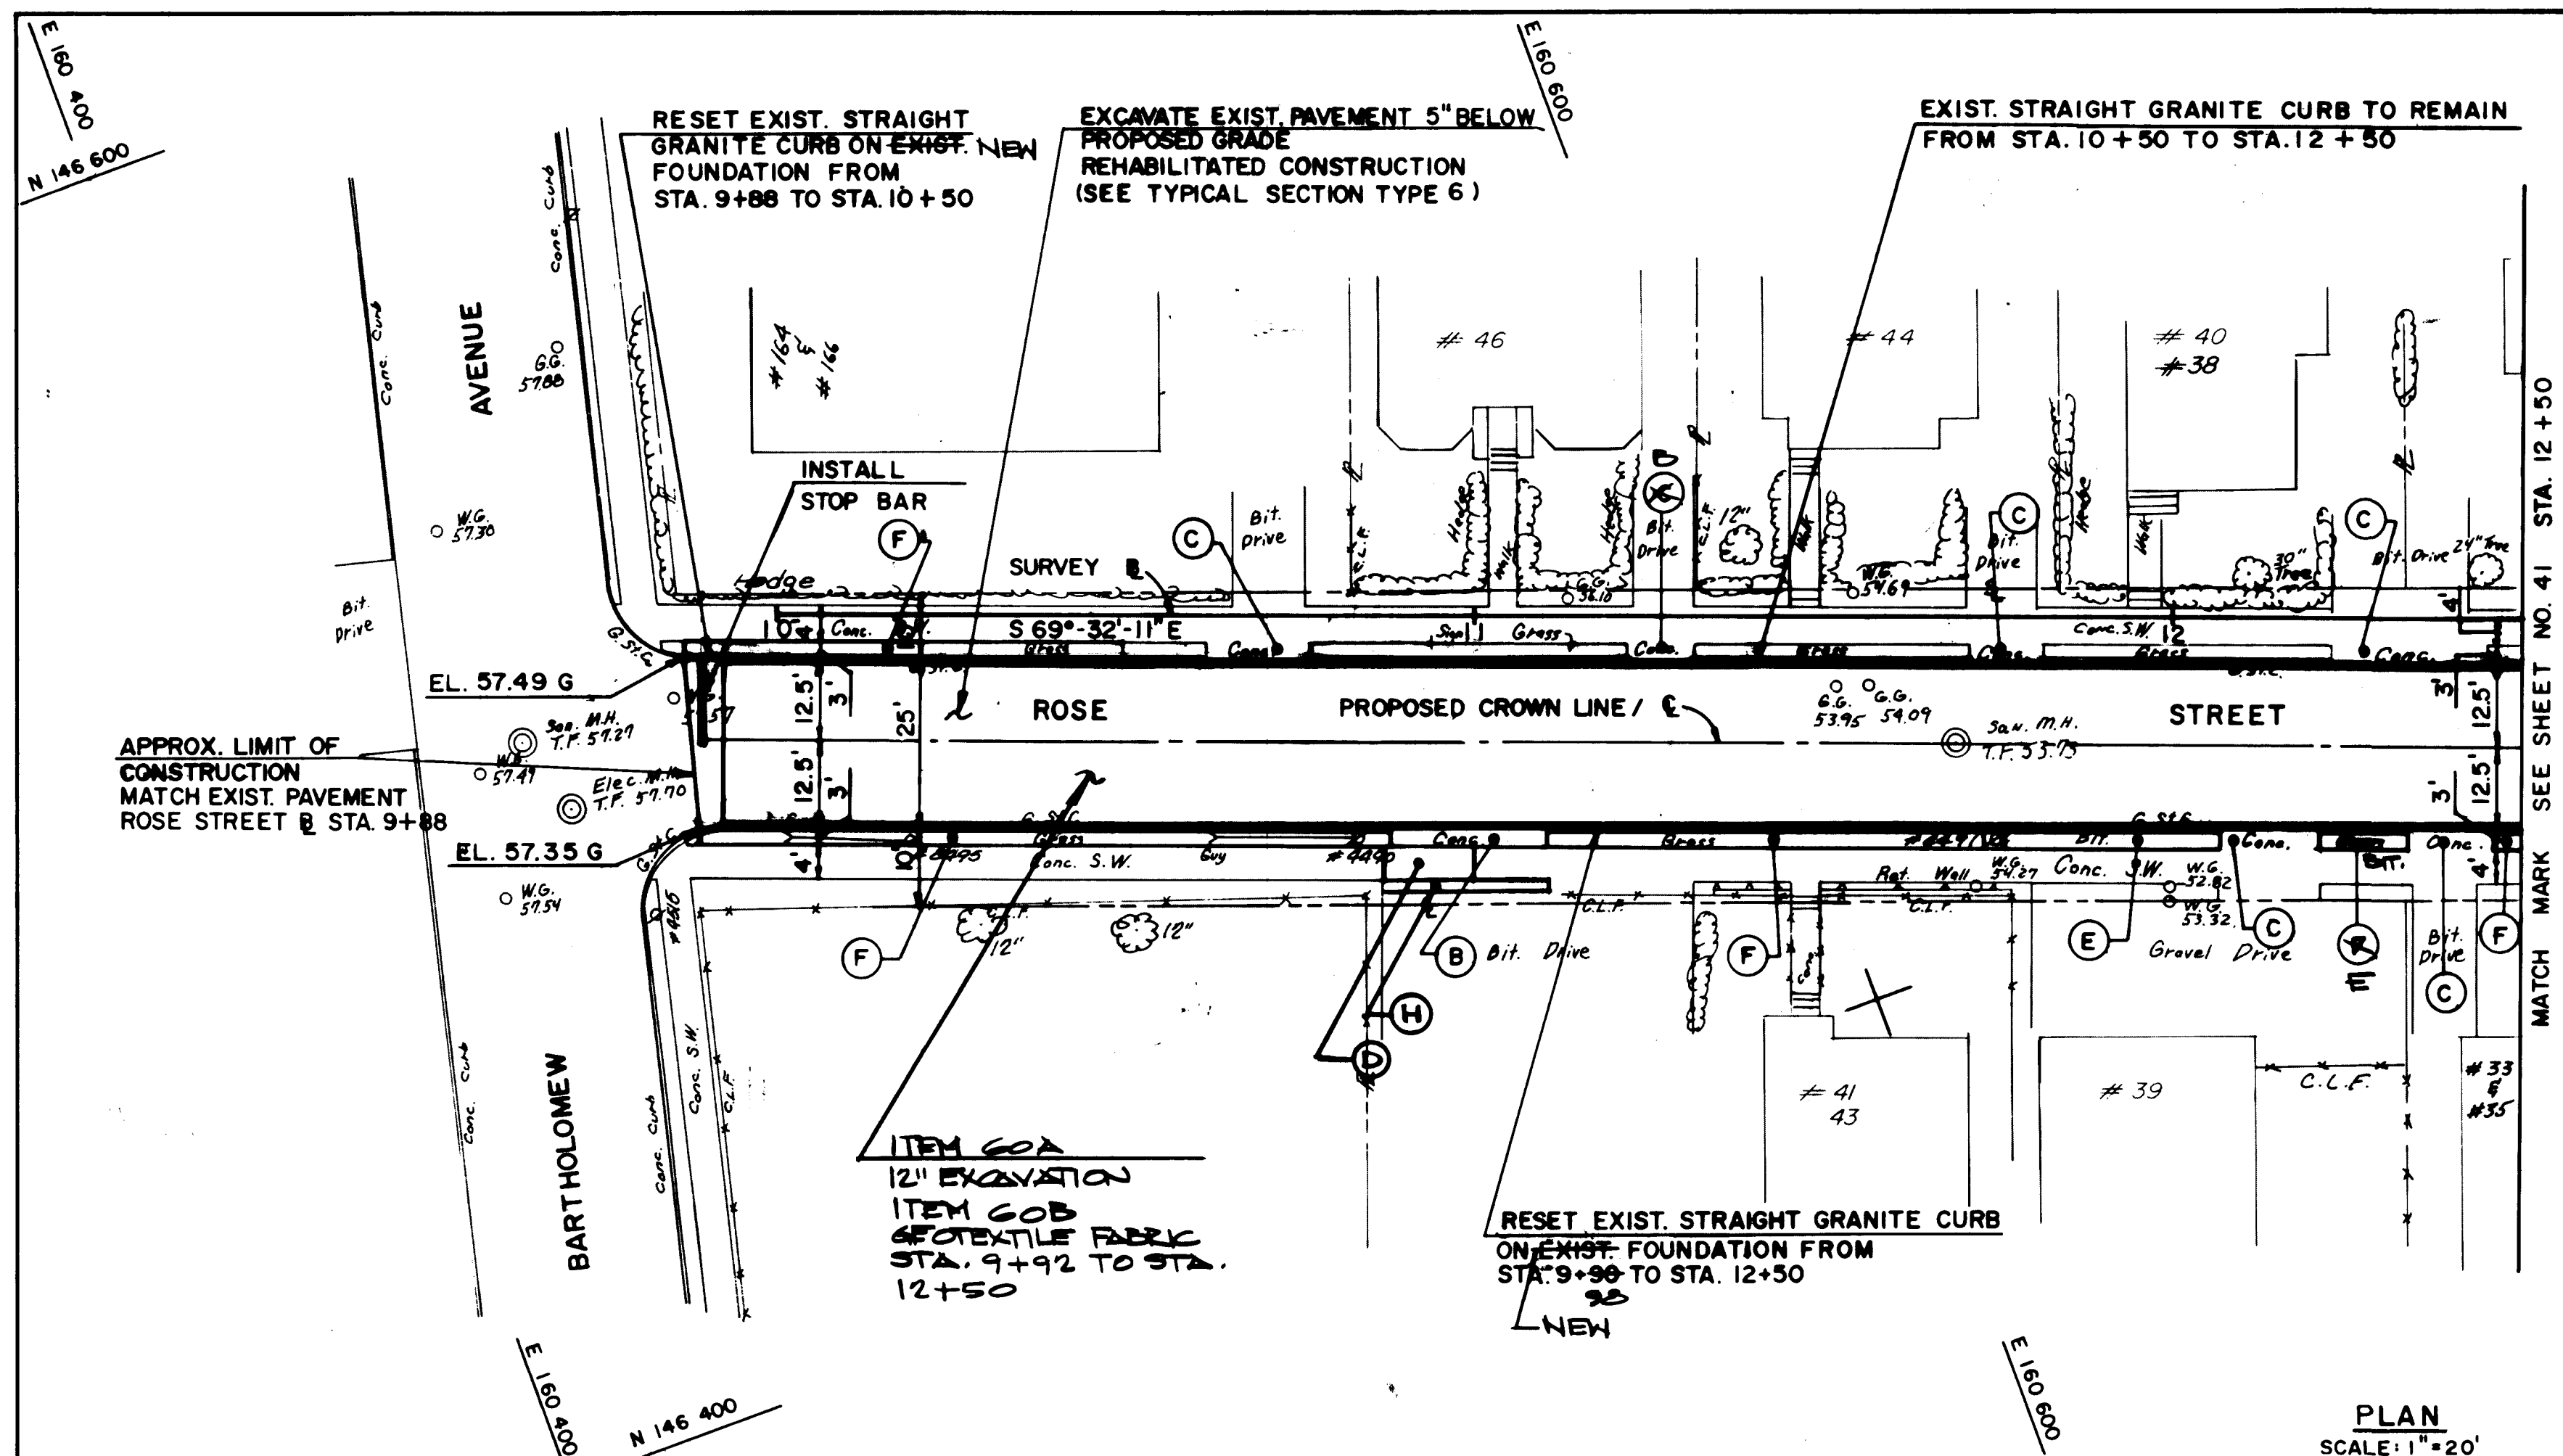

NOTES

- (B) SAWCUT BETWEEN EXISTING RAMPED SECTION AND SIDEWALK, AND CONSTRUCT 8\"/>
- (C) EXISTING DRIVEWAY RAMP TO REMAIN.
- (E) CONSTRUCT 2\"/>
- (F) SEEDING AND MULCHING
- FOR GENERAL NOTES AND LIST OF ABBREVIATIONS SEE SHEET NO. 2
- FOR CONSTRUCTION NOTES SEE SHEET NO. 8
- SURVEY BASELINE IS LOCATED 6.50 FT. NORTH FROM FACE OF NORTH CURB.
- (D) CONSTRUCT 6\"/>
- (G) CONSTRUCT 8\"/>
- (H) CONSTRUCT BIT. CONC. DRIVEWAY.

PLAN
SCALE: 1\"/>

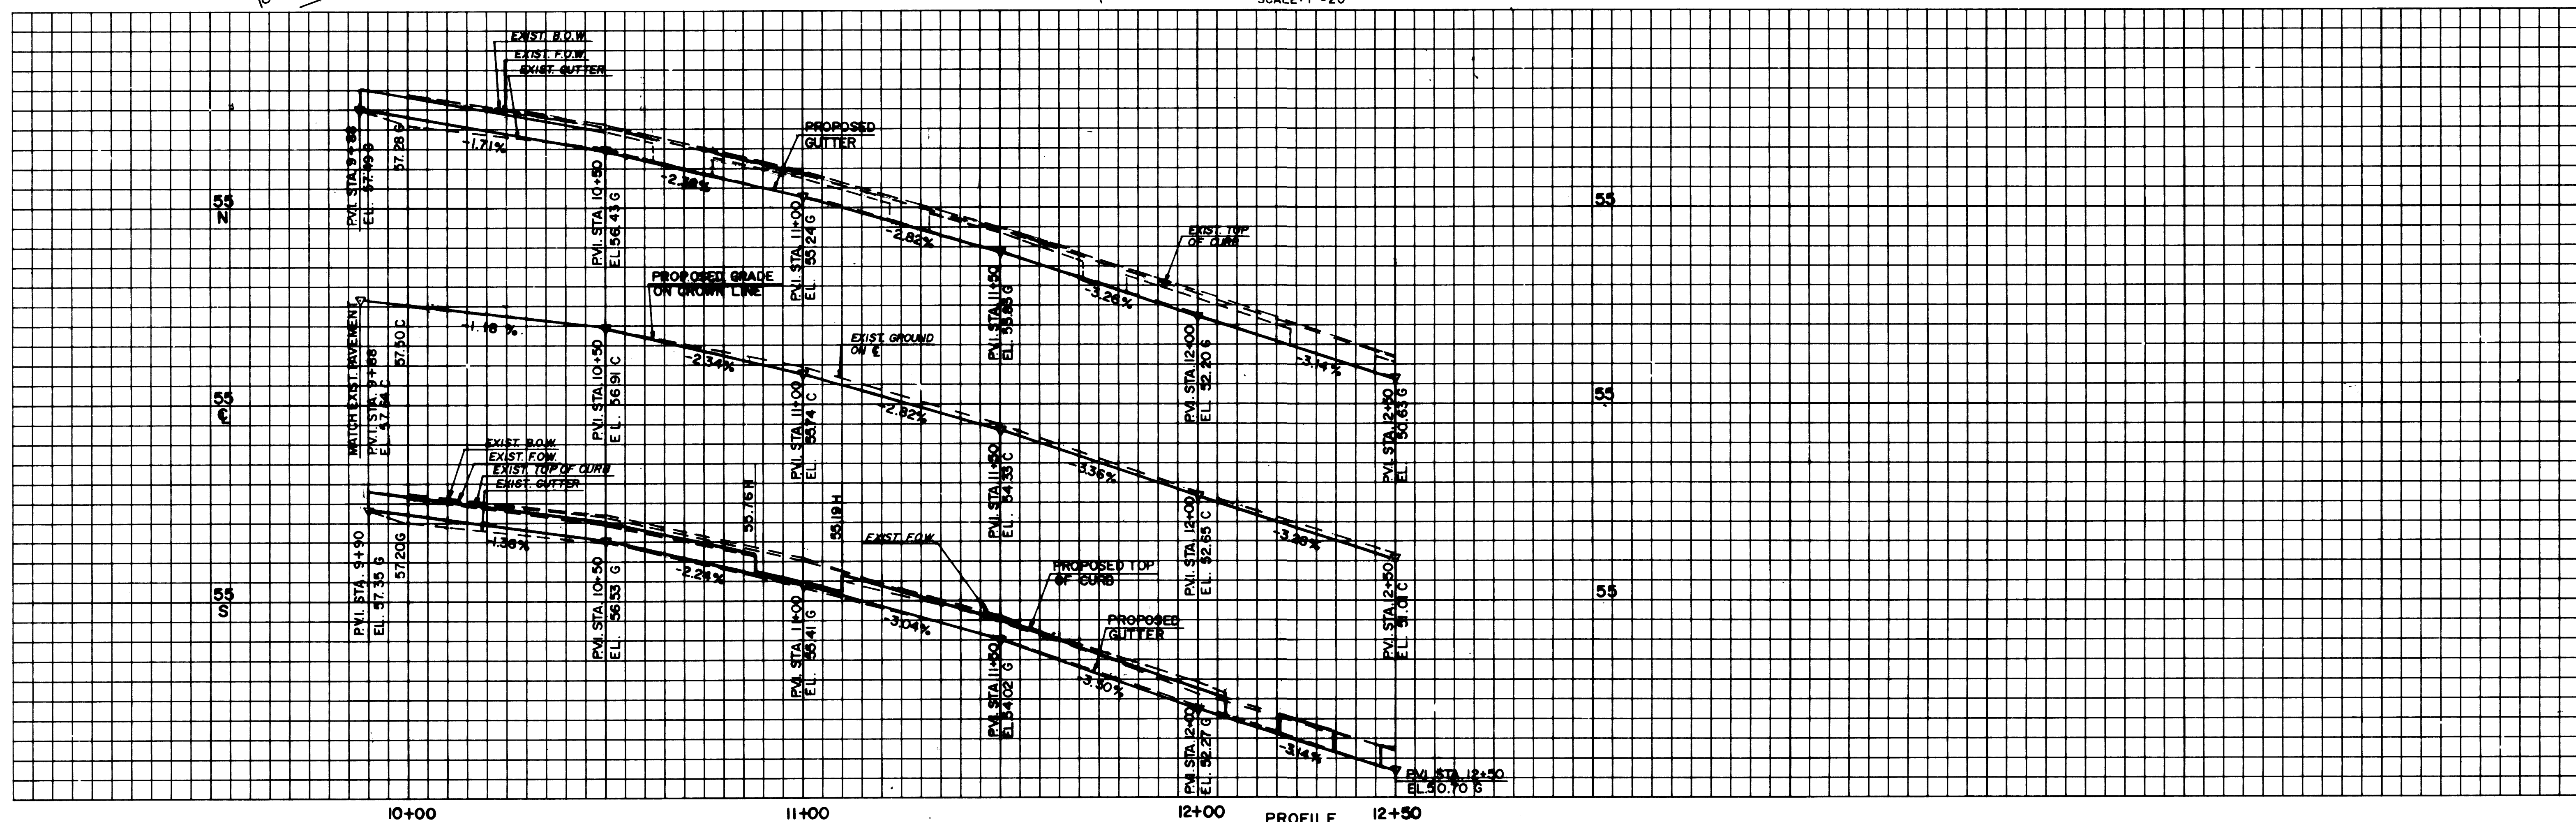

PROFILE
SCALE:
VERT. 1\"/>

ROSE STREET			
PLAN AND PROFILE			
THE CITY OF HARTFORD, CONNECTICUT			
NO.	DATE	REVISION	
DESIGNED: D.M.		DATE: MARCH 23, 1988	
DRAWN: R.J.W.			
CHECKED: P.L.		SCALE: AS NOTED	
APPROVED: R.C.G.			
PURCELL ASSOCIATES			SHEET NO. 42 OF 48 DAYBOOK NO. 01113J