



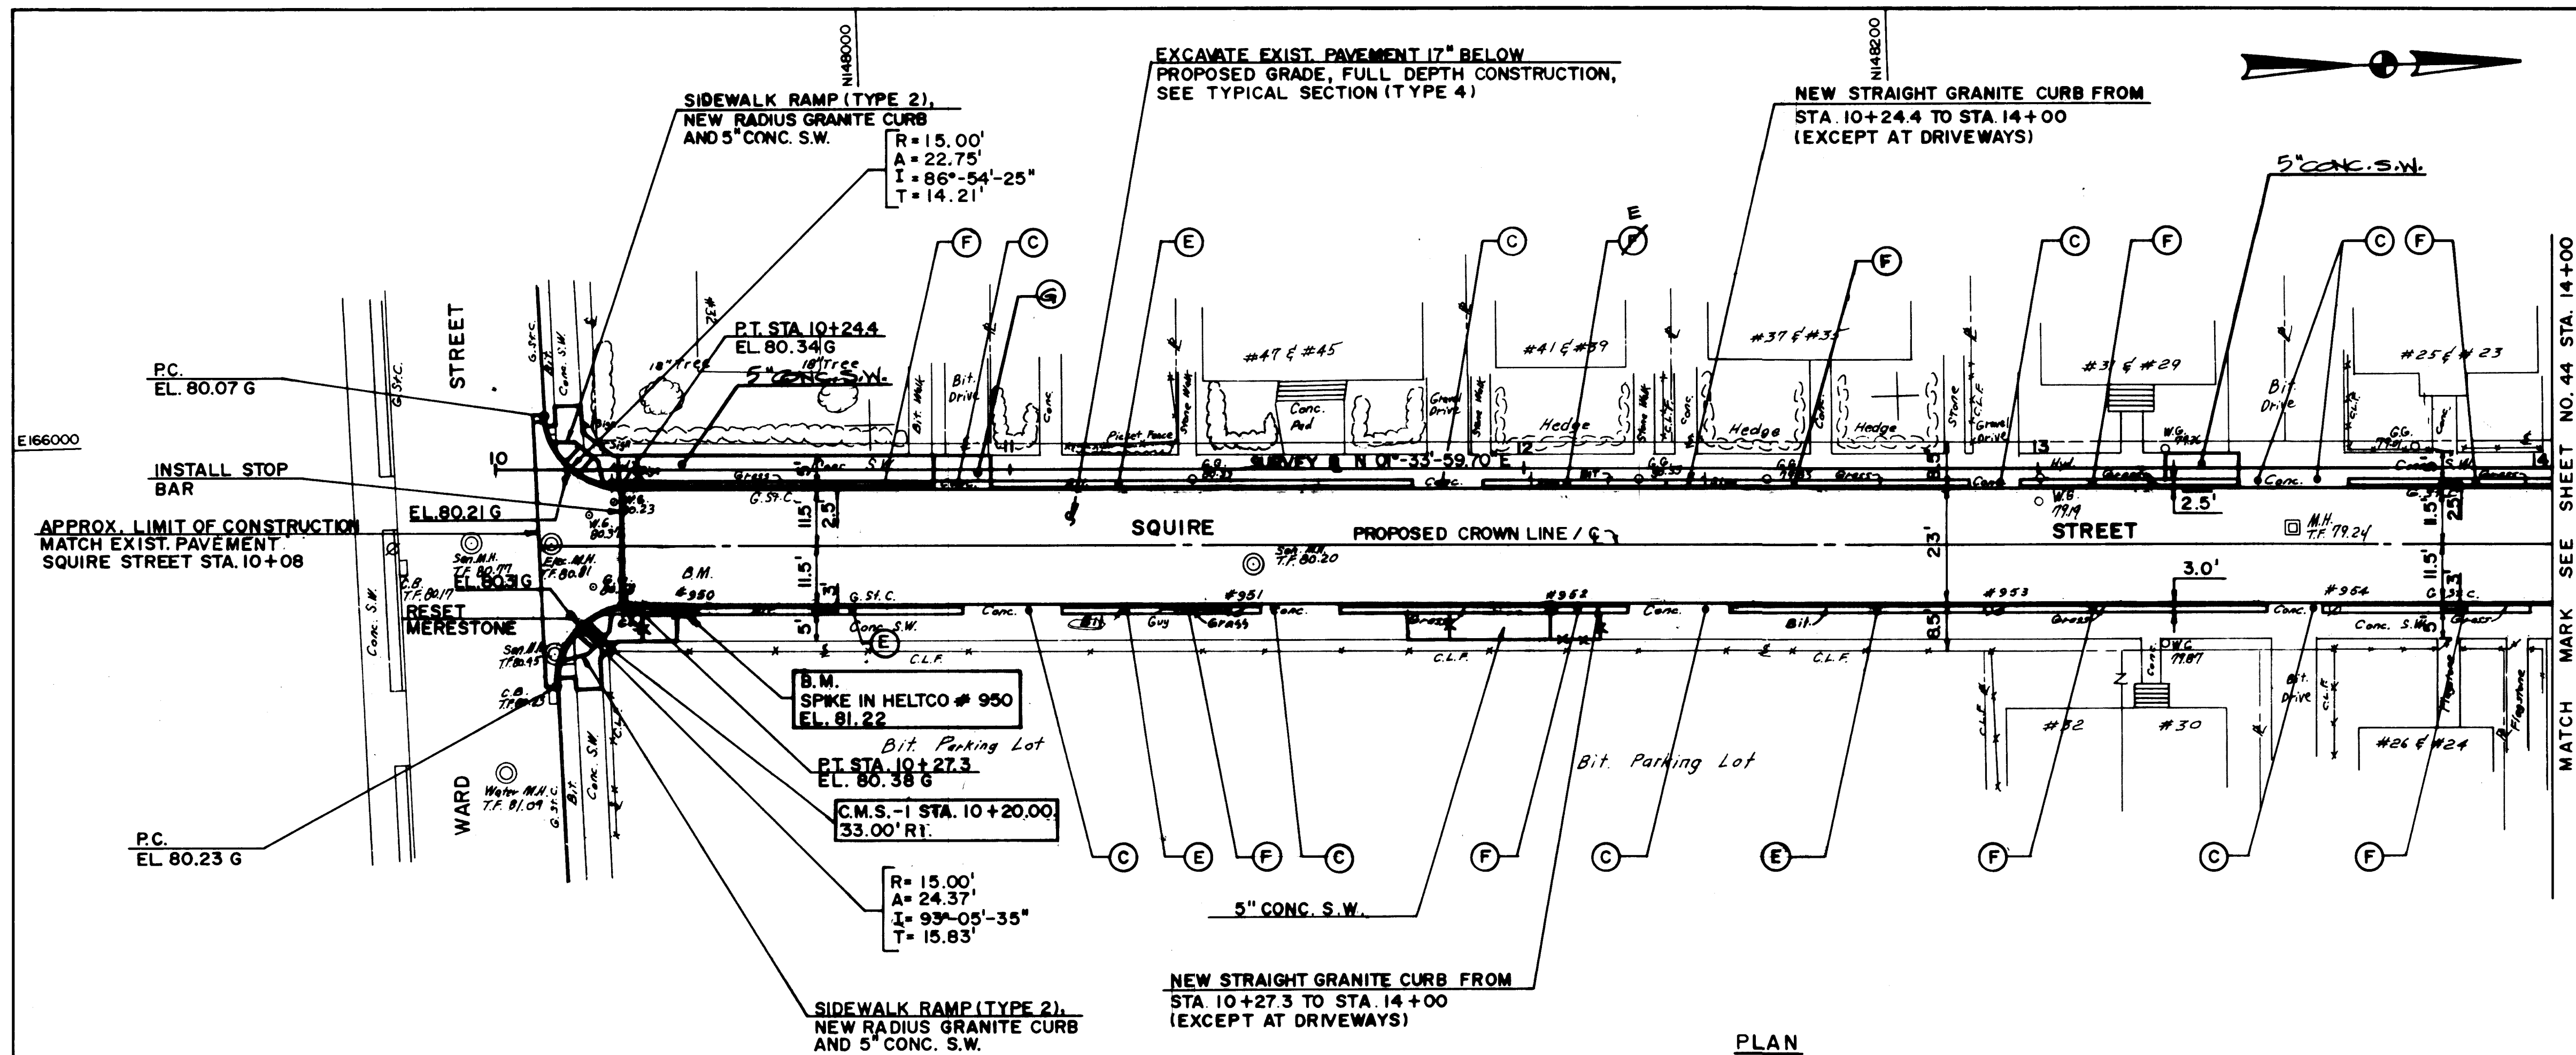

NOTES:

- EXISTING DRIVEWAY RAMP TO REMAIN.
- CONSTRUCT 2" BIT. CONC. SURFACE ON NEW FOUNDATION, EXCEPT AT DRIVEWAYS AND RAMPS.
- SEEDING AND MULCHING
- FOR GENERAL NOTES AND LIST OF ABBREVIATIONS SEE SHEET NO. 2
- FOR CONSTRUCTION NOTES SEE SHEET NO. 8
- SURVEY BASELINE IS LOCATED 33.00 FT. WEST OF C.M.S.-1
- CONSTRUCT 2" REINFORCED DRIVEWAY RAMP.

PLAN
SCALE: 1"=20'

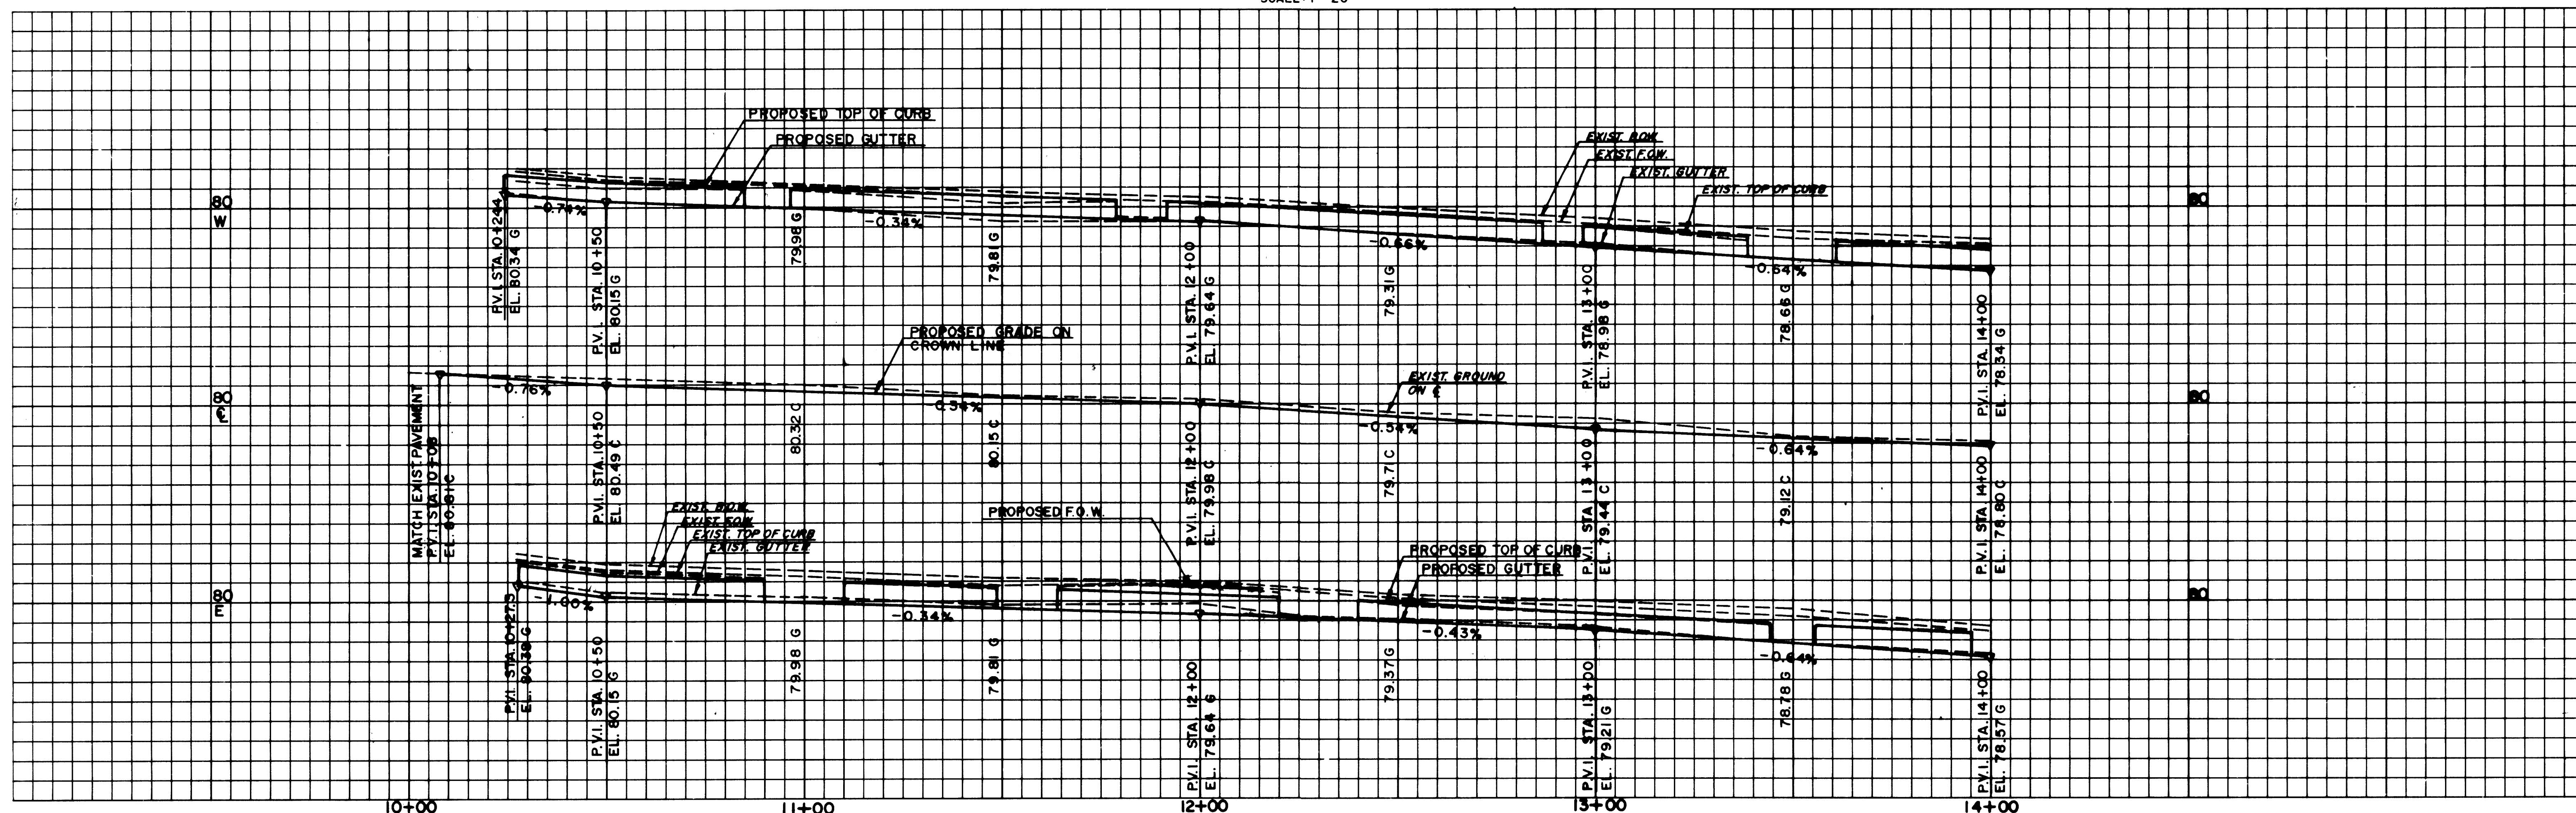

PROFILE
SCALE:
VERT. 1"=2'
HORIZ. 1"=20'

SQUIRE STREET			
PLAN AND PROFILE			
THE CITY OF HARTFORD, CONNECTICUT			
DESIGNED: A.M.	DATE: MARCH 23, 1988	SHEET NO. 43 OF 48 DAYBOOK NO. 0113K	
DRAWN: T.N.S.	SCALE: AS NOTED		
CHECKED: P.L.			
APPROVED: R.C.G.			