



E166000

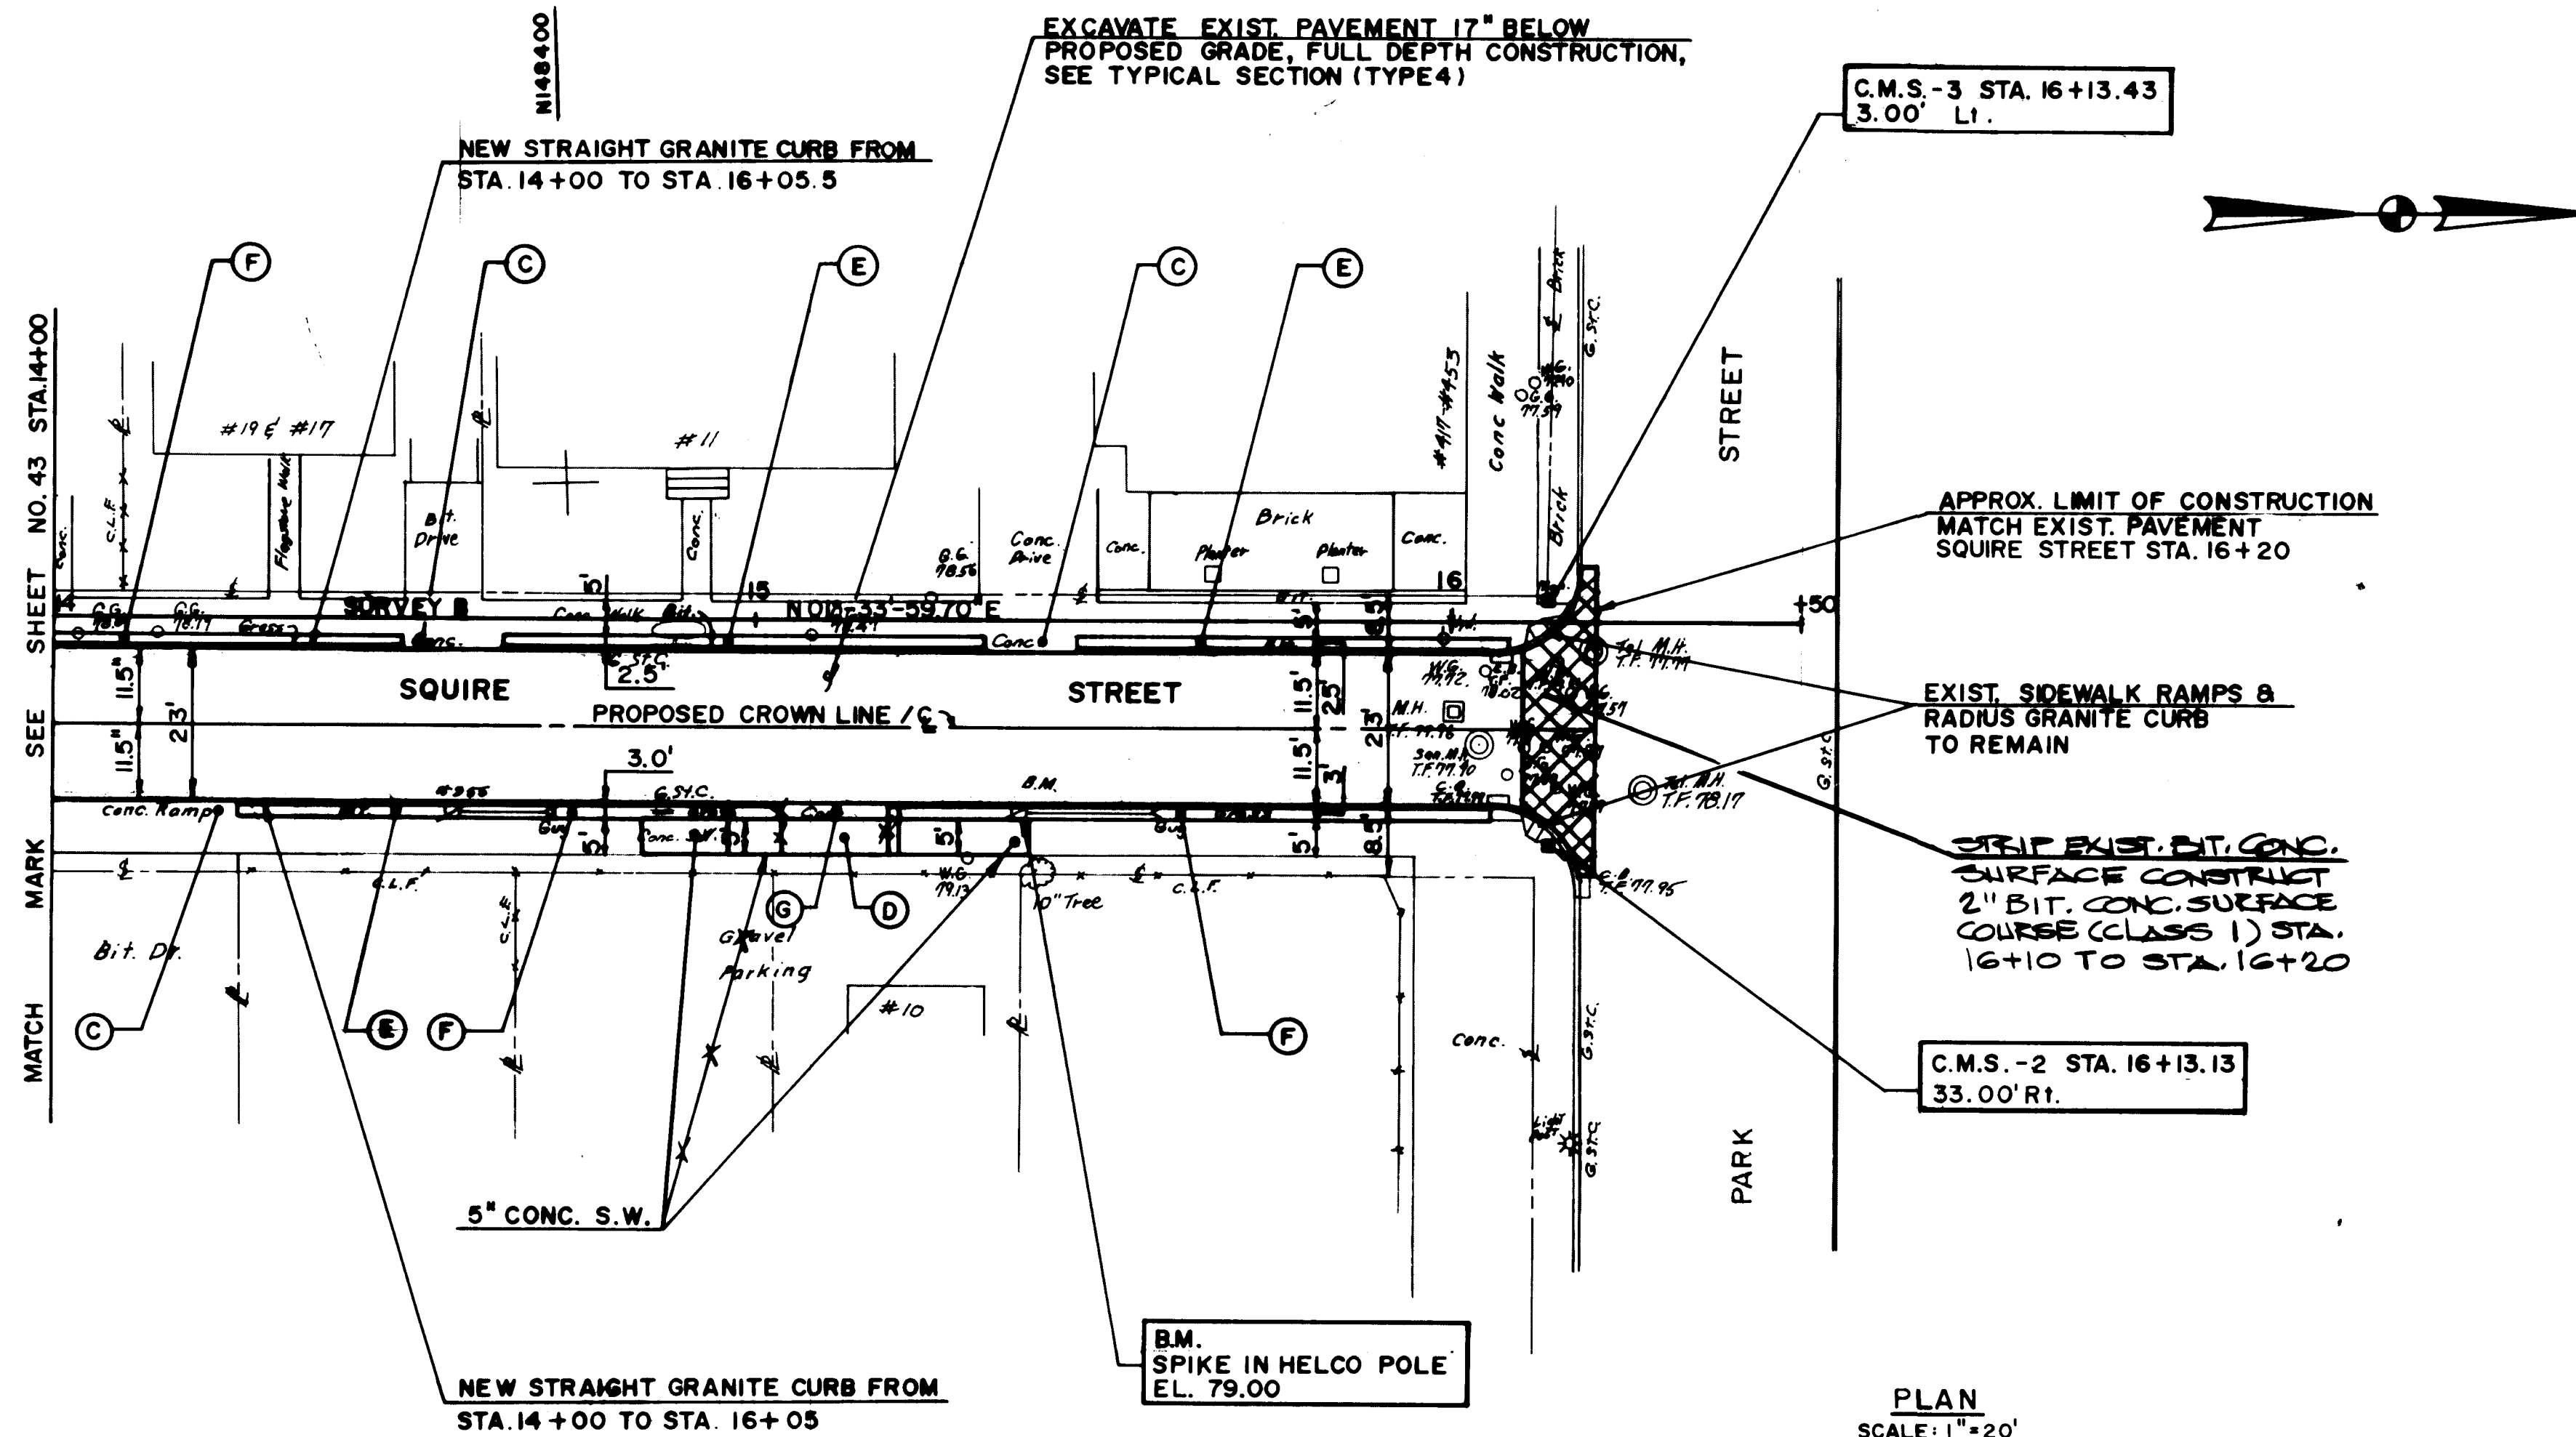

PLAN
SCALE: 1"=20'

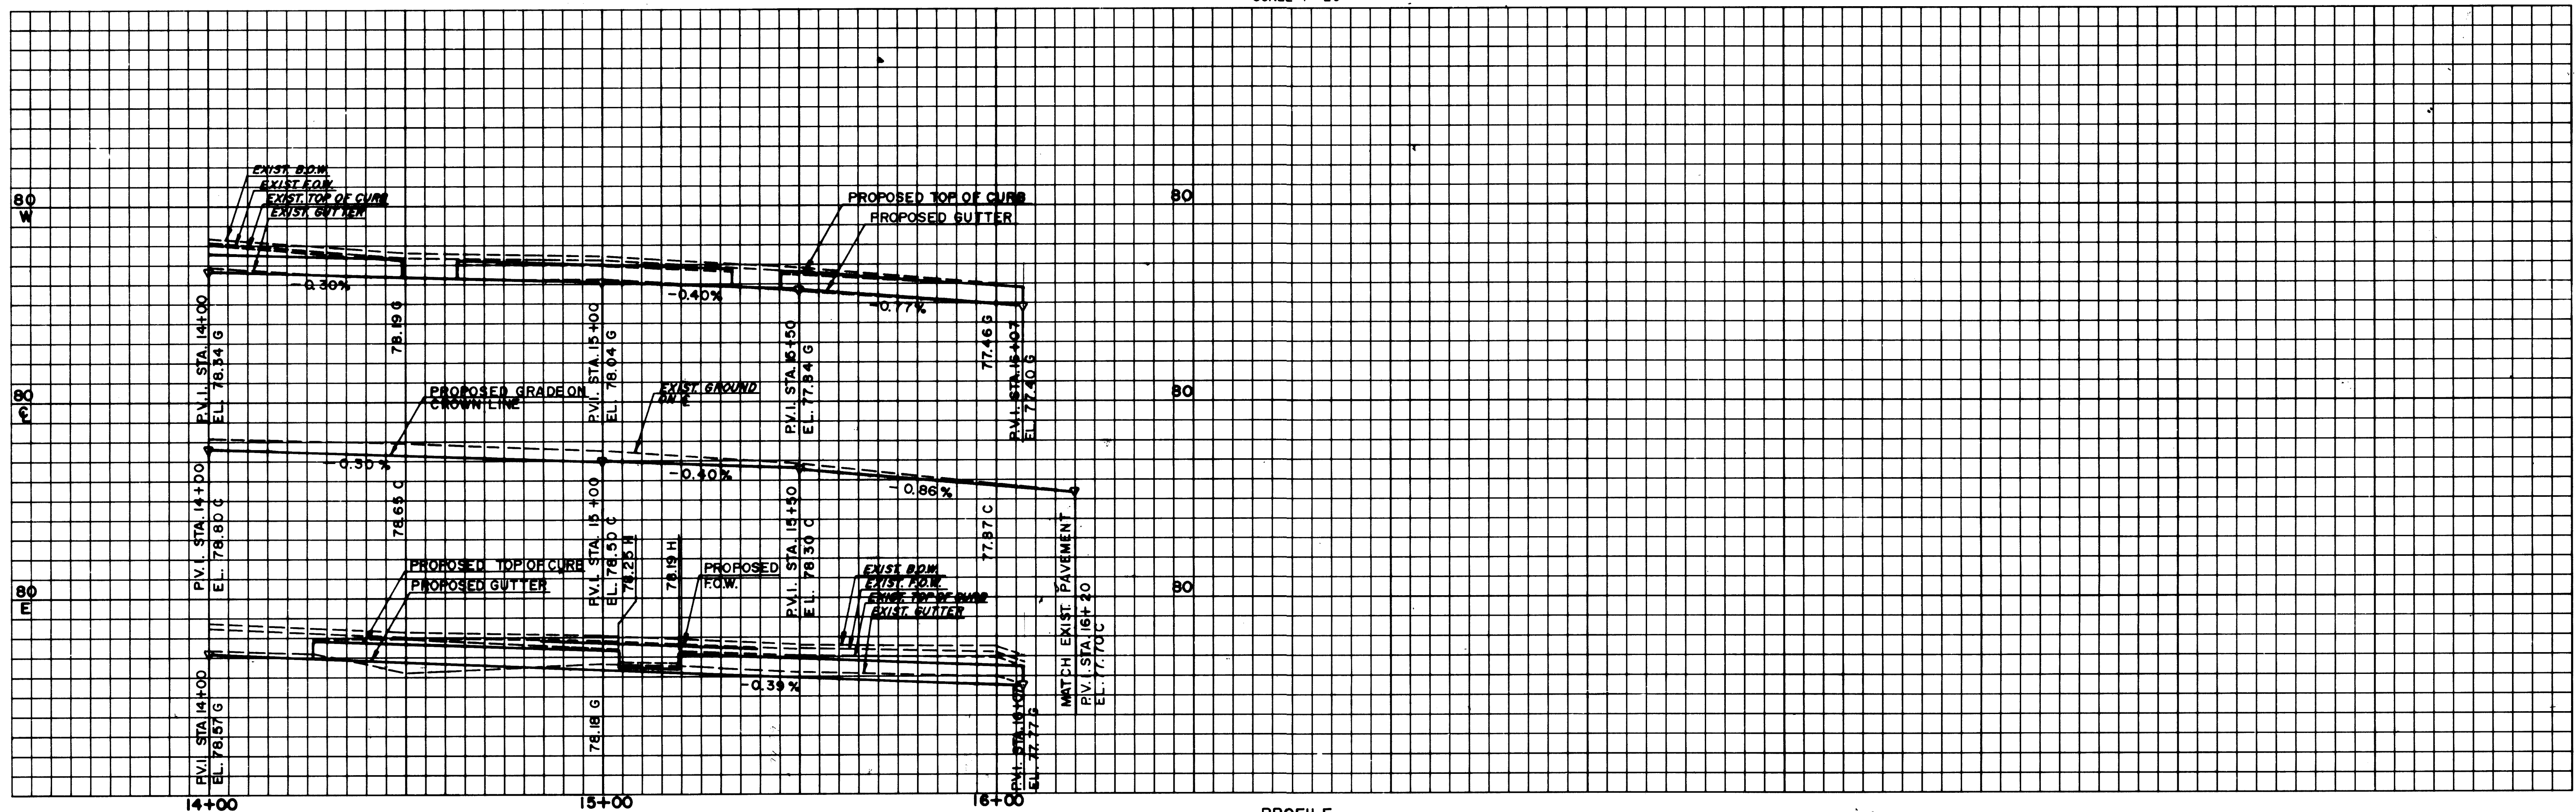

PROFILE
SCALE:
VERT. 1"=2'
HORIZ. 1"=20'

NOTES:

1. (C) EXISTING DRIVEWAY RAMP TO REMAIN
- (D) CONSTRUCT 8" REINFORCED CONC. SIDEWALK
- (E) CONSTRUCT 2" BIT. CONC. SURFACE ON NEW FOUNDATION, EXCEPT AT DRIVEWAYS AND RAMPS.
- (F) SEEDING AND MULCHING
- (G) CONSTRUCT 8" REINFORCED CONC. DRIVEWAY RAMP.
2. FOR GENERAL NOTES AND LIST OF ABBREVIATIONS SEE SHEET NO. 2
3. FOR CONSTRUCTION NOTES SEE SHEET NO. 8
4. SURVEY BASELINE IS LOCATED 33.00 FT. WEST OF C.M.S.-2

SQUIRE STREET			
PLAN AND PROFILE			
THE CITY OF HARTFORD, CONNECTICUT			
DESIGNED: A.M.	DATE: MARCH 23, 1988	PURCELL ASSOCIATES	
DRAWN: T.N.S.	SCALE: AS NOTED		
CHECKED: P.L.			
APPROVED: R.C.G.		SHEET NO. 44 OF 48 DAYBOOK NO. 01113 K	