



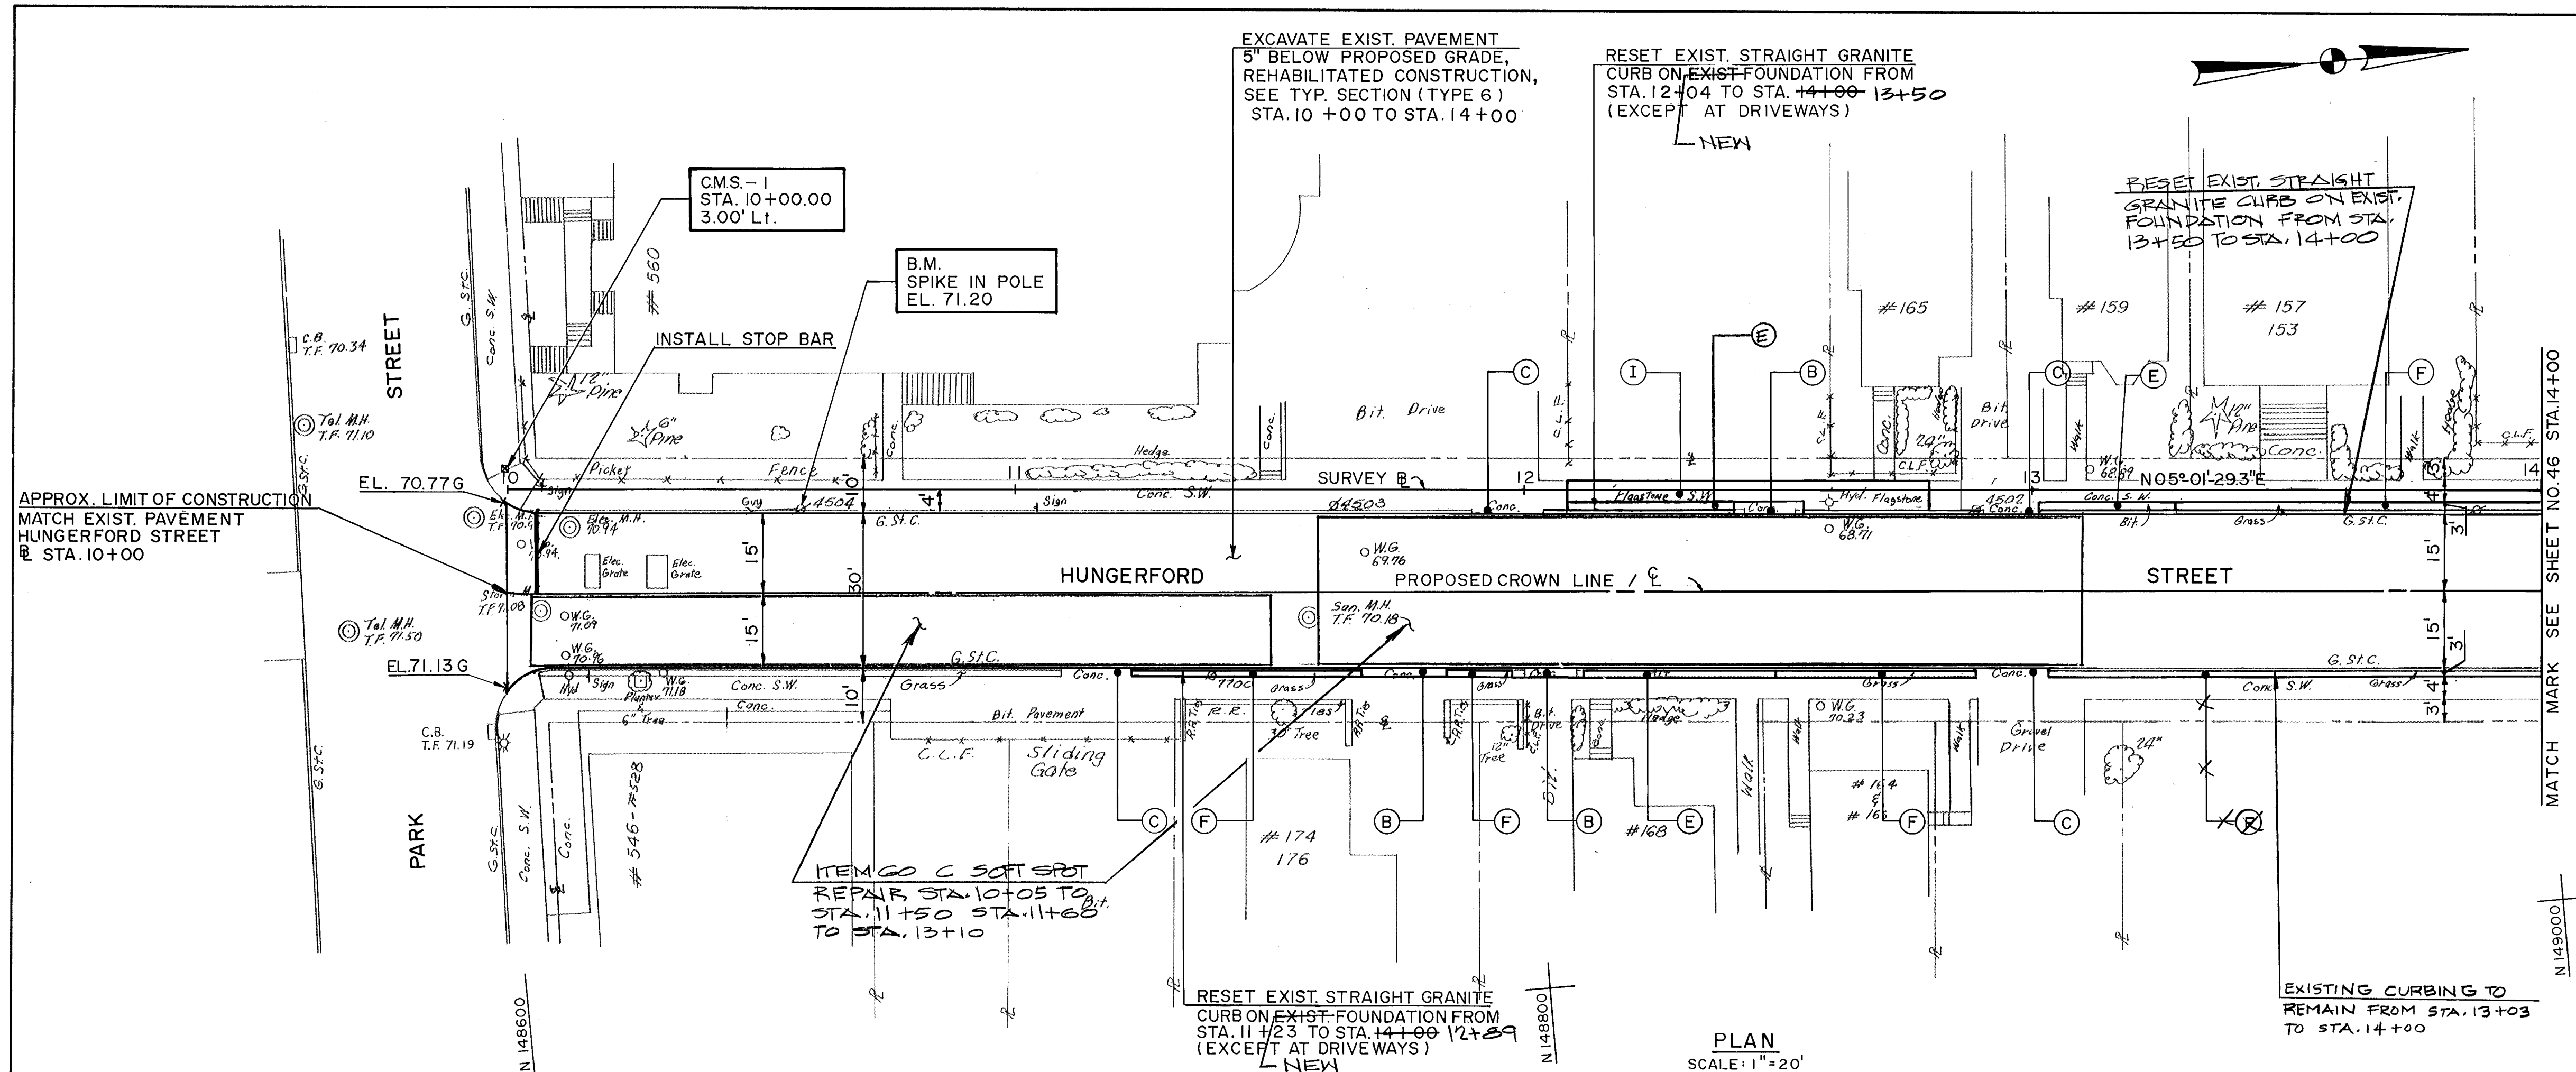

- NOTES**
- (B) SAWCUT BETWEEN EXISTING RAMPED SECTION AND SIDEWALK, AND CONSTRUCT 8" REINFORCED CONC. DRIVEWAY RAMP.
 - (C) EXISTING DRIVEWAY RAMP TO REMAIN.
 - (E) CONSTRUCT 2" BIT. CONC. SURFACE ON NEW FOUNDATION, EXCEPT AT DRIVEWAYS AND RAMPS.
 - (F) SEEDING AND MULCHING.
 - (I) RELAY FLAGSTONE WALK.
- FOR GENERAL NOTES AND LIST OF ABBREVIATIONS SEE SHEET NO.
 - FOR CONSTRUCTION NOTES SEE SHEET NO. 8.
 - SURVEY BASELINE IS LOCATED 3.00 FT. EAST OF C.M.S.- 1.

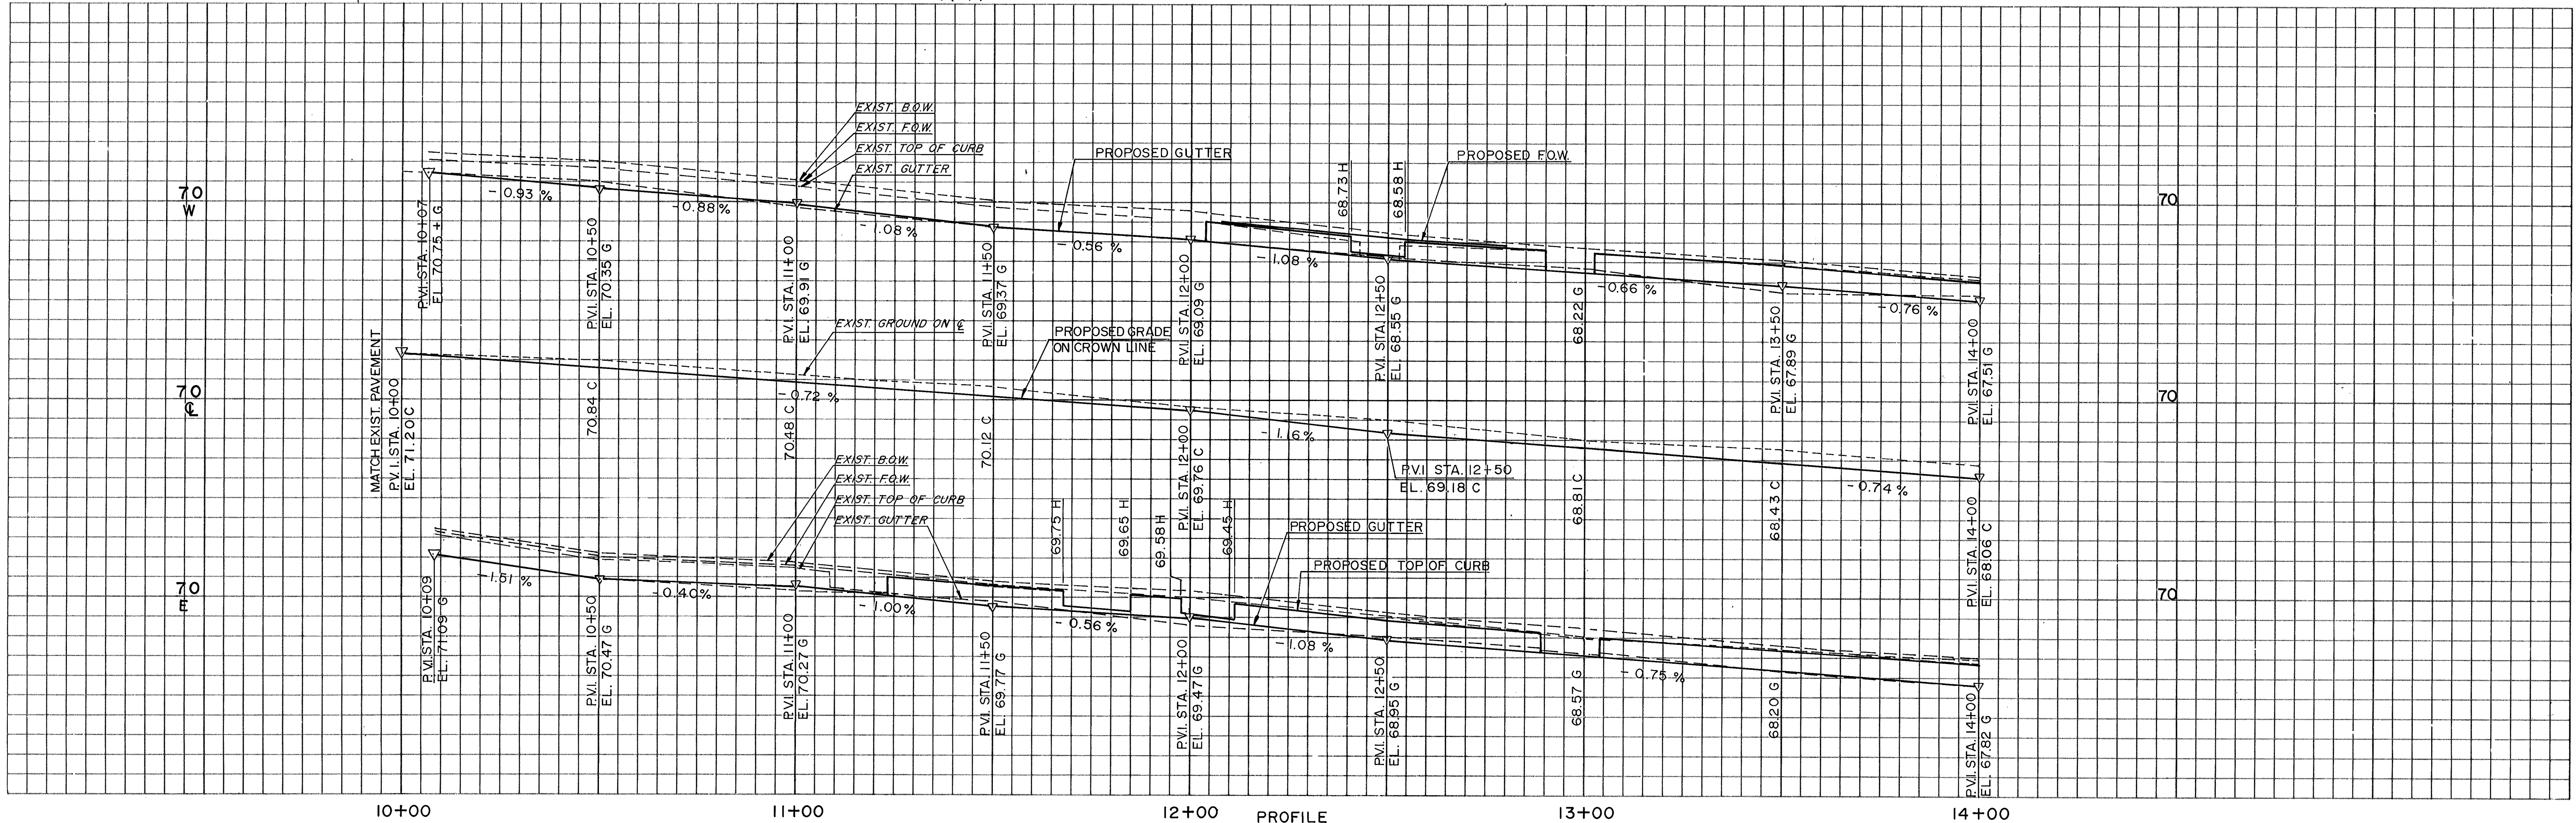

HUNGERFORD STREET		PLAN AND PROFILE	
THE CITY OF HARTFORD, CONNECTICUT		SHEET NO. 45 OF 48	
DESIGNED: A.M.		DATE MARCH 23, 1988	
DRAWN: M.P.G.		SCALE AS NOTED	
CHECKED: P.L.		DAYBOOK NO. 01113 L	
APPROVED: R.C.G.		PURCELL ASSOCIATES	