



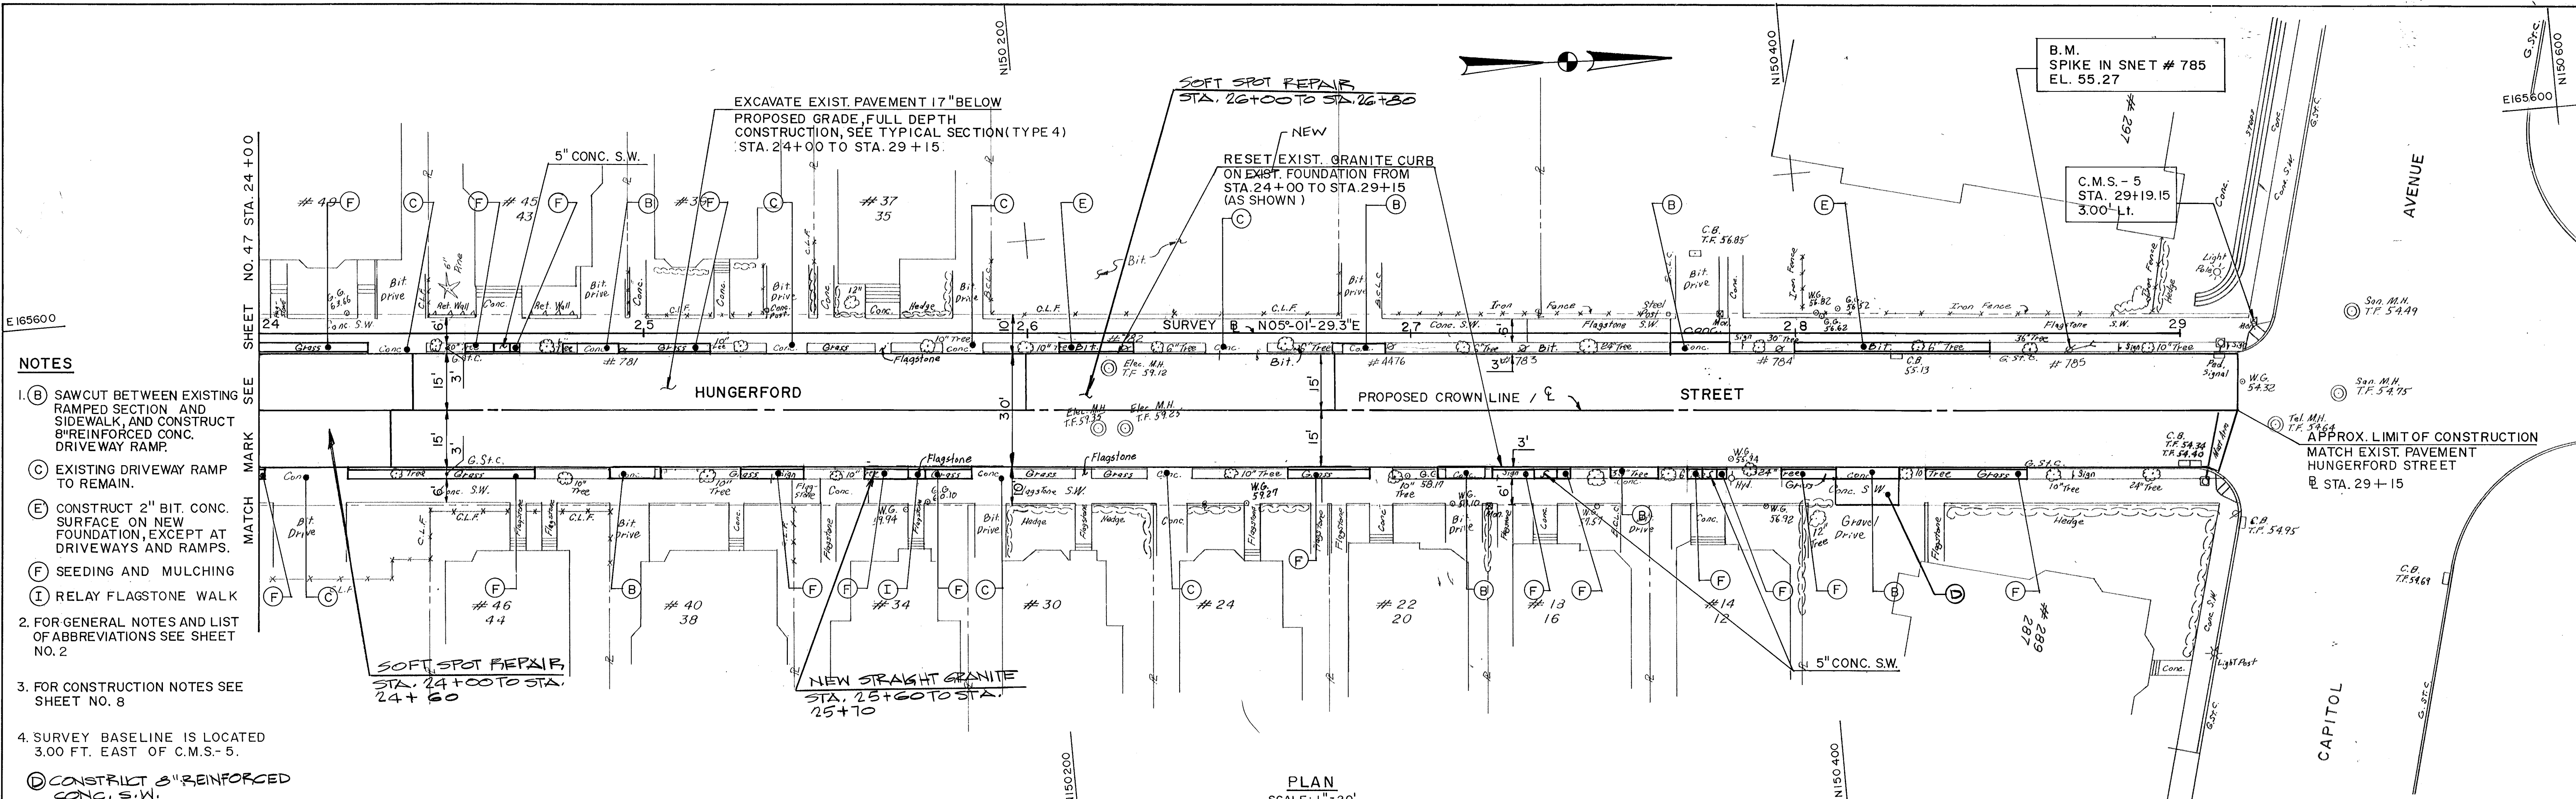

- NOTES**
- 1. (B) SAWCUT BETWEEN EXISTING RAMPED SECTION AND SIDEWALK, AND CONSTRUCT 8\"/>
 - (C) EXISTING DRIVEWAY RAMP TO REMAIN.
 - (E) CONSTRUCT 2\"/>
 - (F) SEEDING AND MULCHING
 - (I) RELAY FLAGSTONE WALK
 - 2. FOR GENERAL NOTES AND LIST OF ABBREVIATIONS SEE SHEET NO. 2
 - 3. FOR CONSTRUCTION NOTES SEE SHEET NO. 8
 - 4. SURVEY BASELINE IS LOCATED 3.00 FT. EAST OF C.M.S.-5.
 - (D) CONSTRUCT 8\"/>

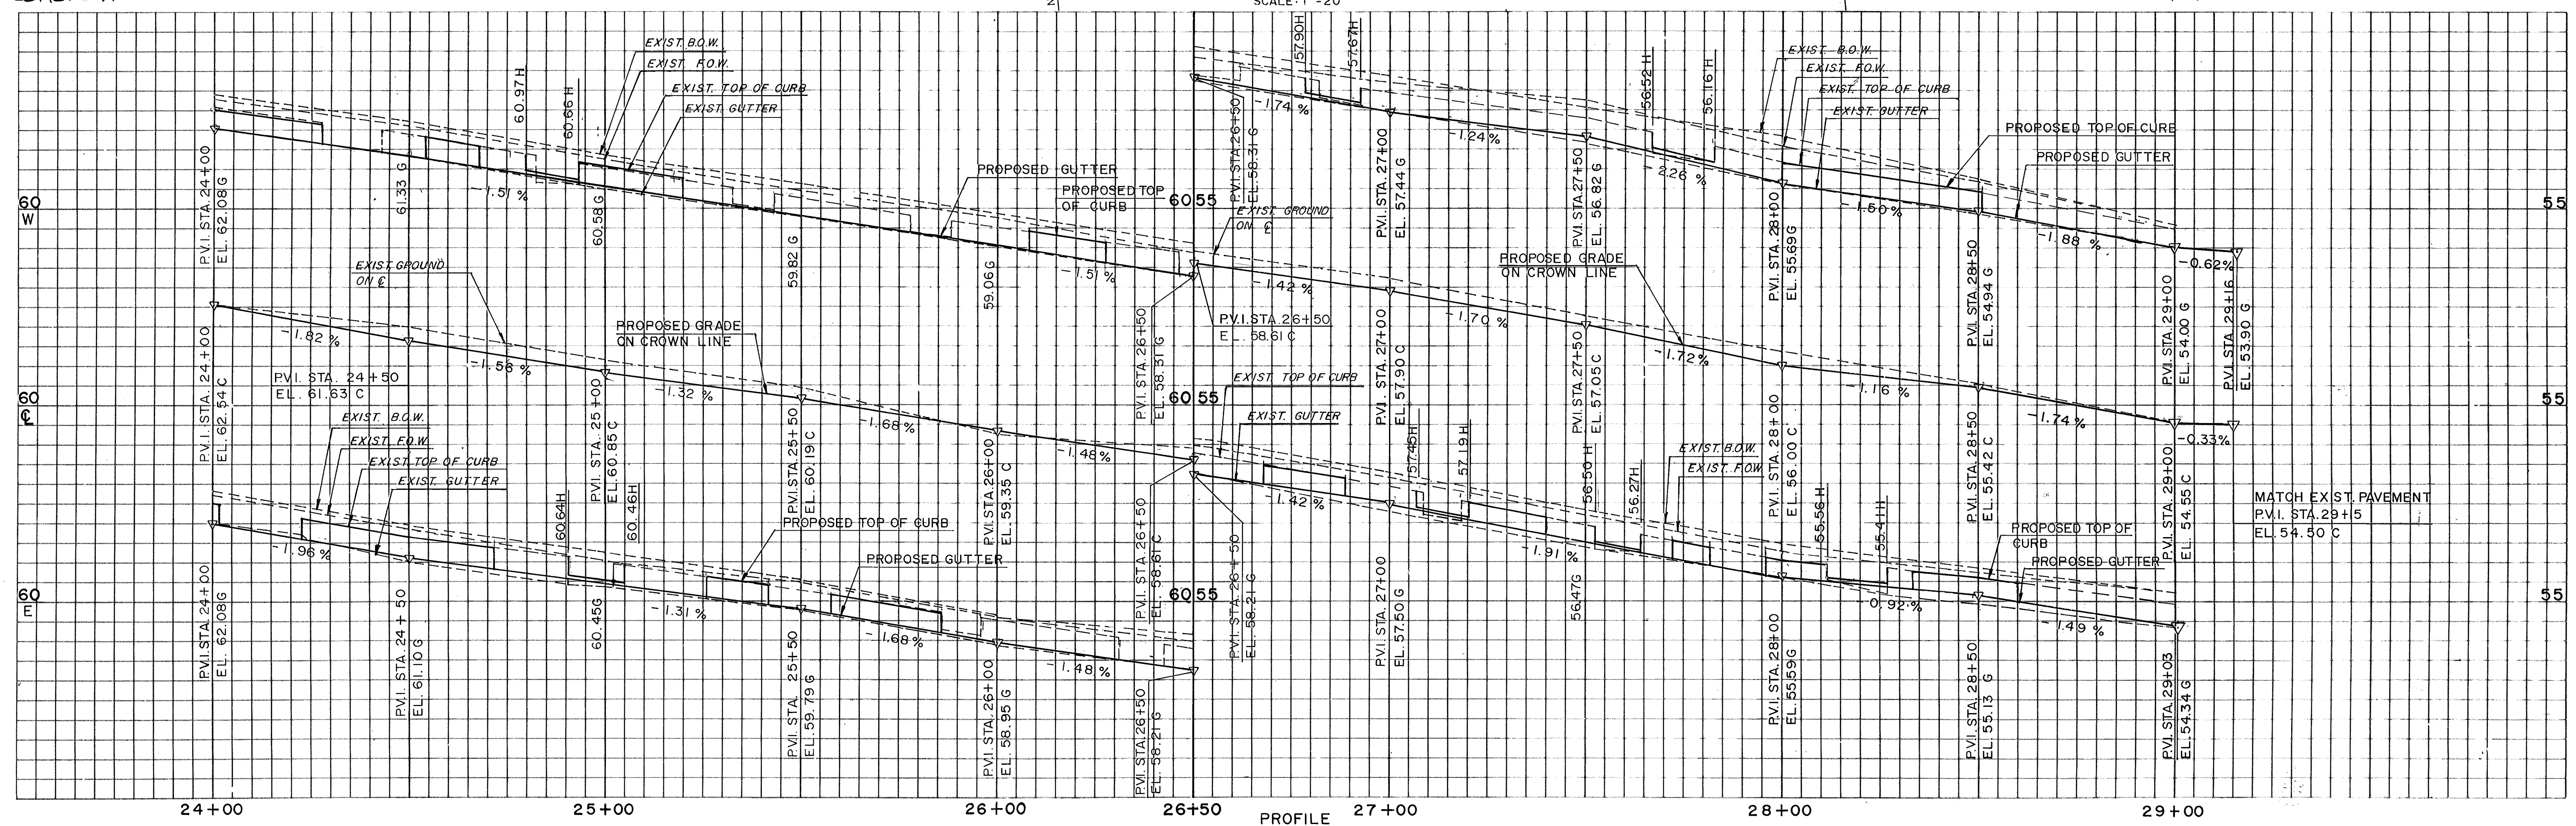

HUNGERFORD STREET		SHEET NO. 48 OF 48							
PLAN AND PROFILE									
THE CITY OF HARTFORD, CONNECTICUT		DAYBOOK NO. 01113 L							
<table border="1"> <tr> <td>DESIGNED: D.M.</td> <td>DATE: MARCH 23, 1988</td> </tr> <tr> <td>DRAWN: R.C.</td> <td>SCALE: AS NOTED</td> </tr> <tr> <td>CHECKED: P.L.</td> <td></td> </tr> <tr> <td>APPROVED: R.C.G.</td> <td></td> </tr> </table>			DESIGNED: D.M.	DATE: MARCH 23, 1988	DRAWN: R.C.	SCALE: AS NOTED	CHECKED: P.L.		APPROVED: R.C.G.
DESIGNED: D.M.	DATE: MARCH 23, 1988								
DRAWN: R.C.	SCALE: AS NOTED								
CHECKED: P.L.									
APPROVED: R.C.G.									