
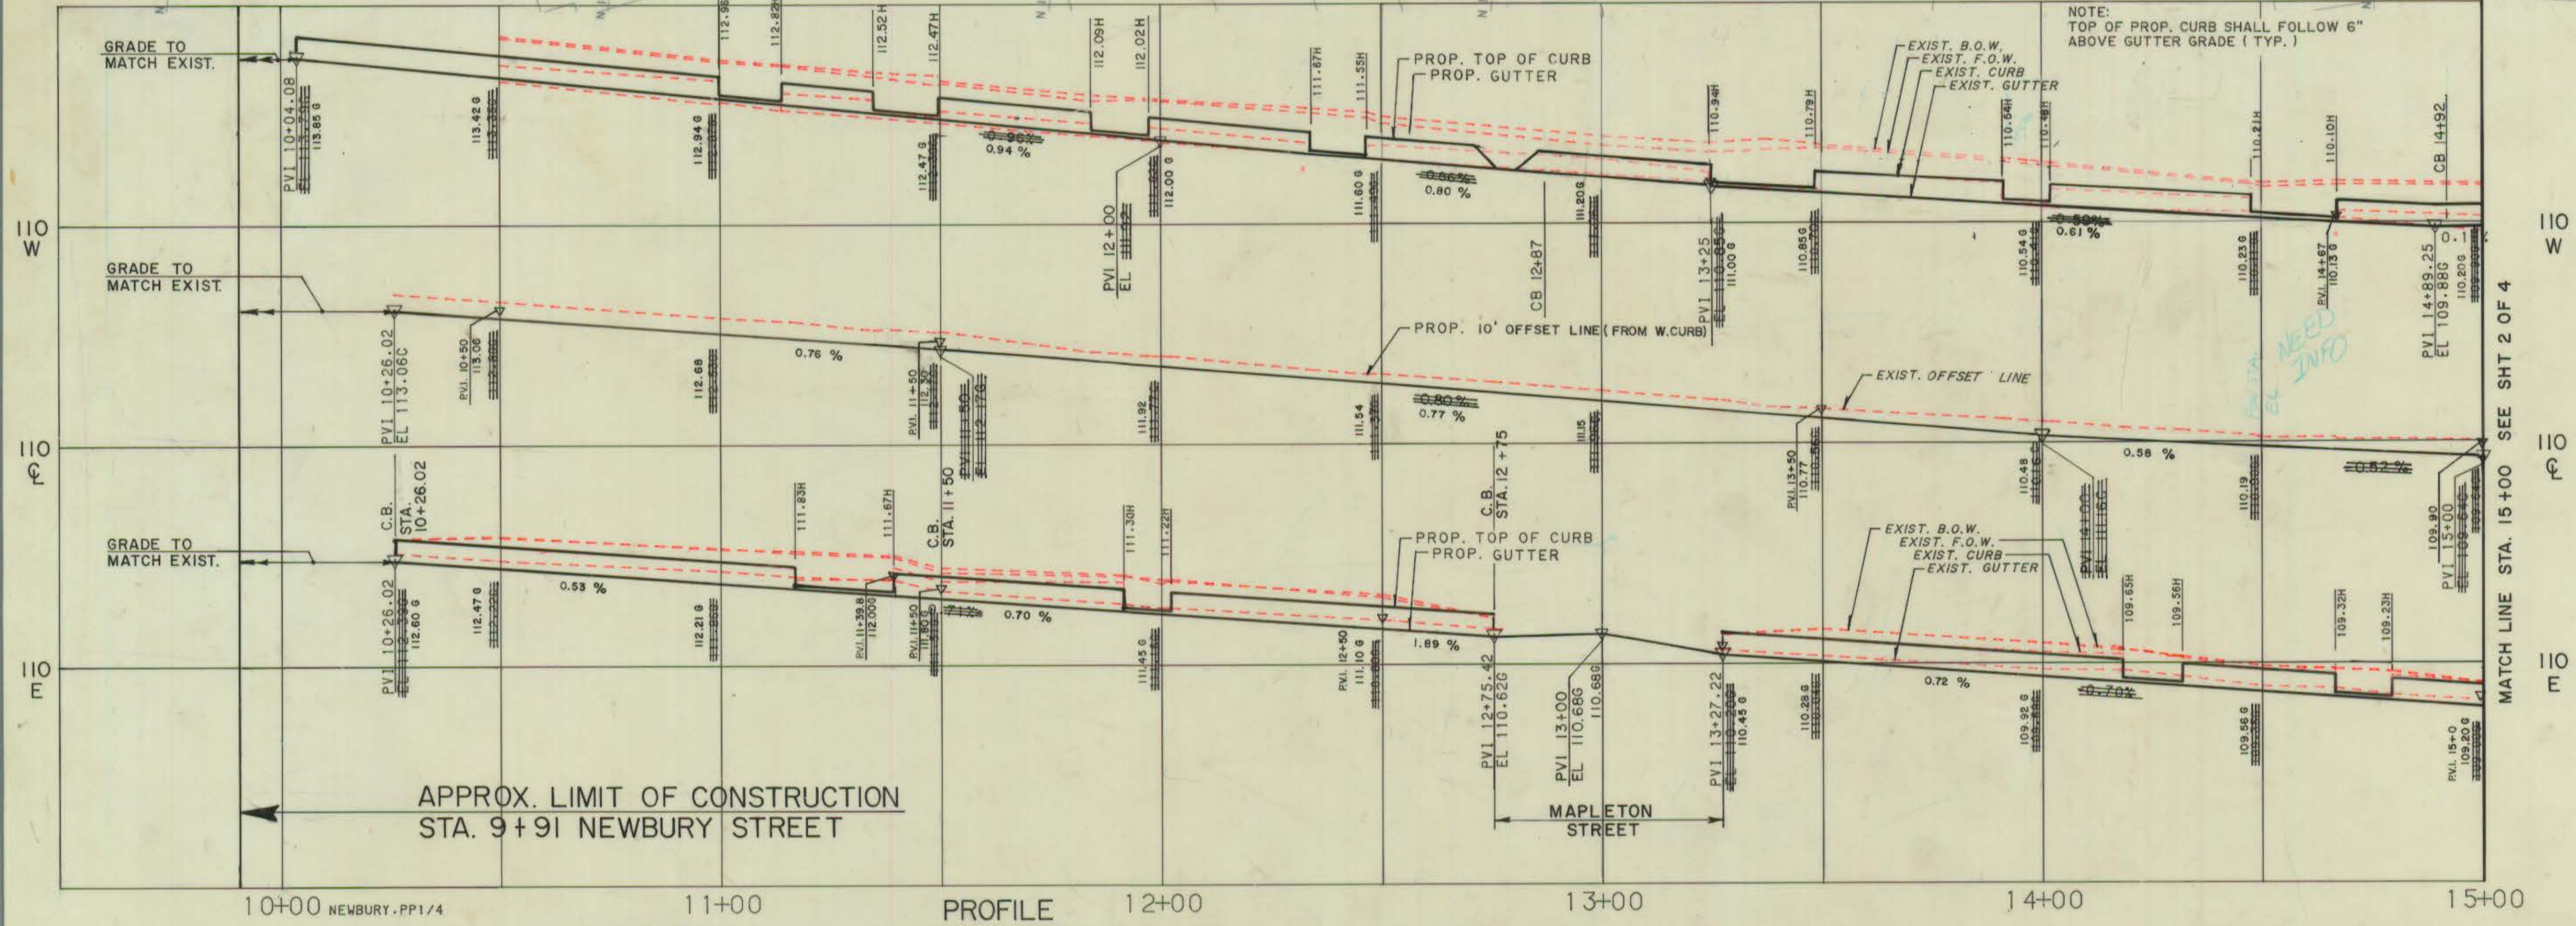


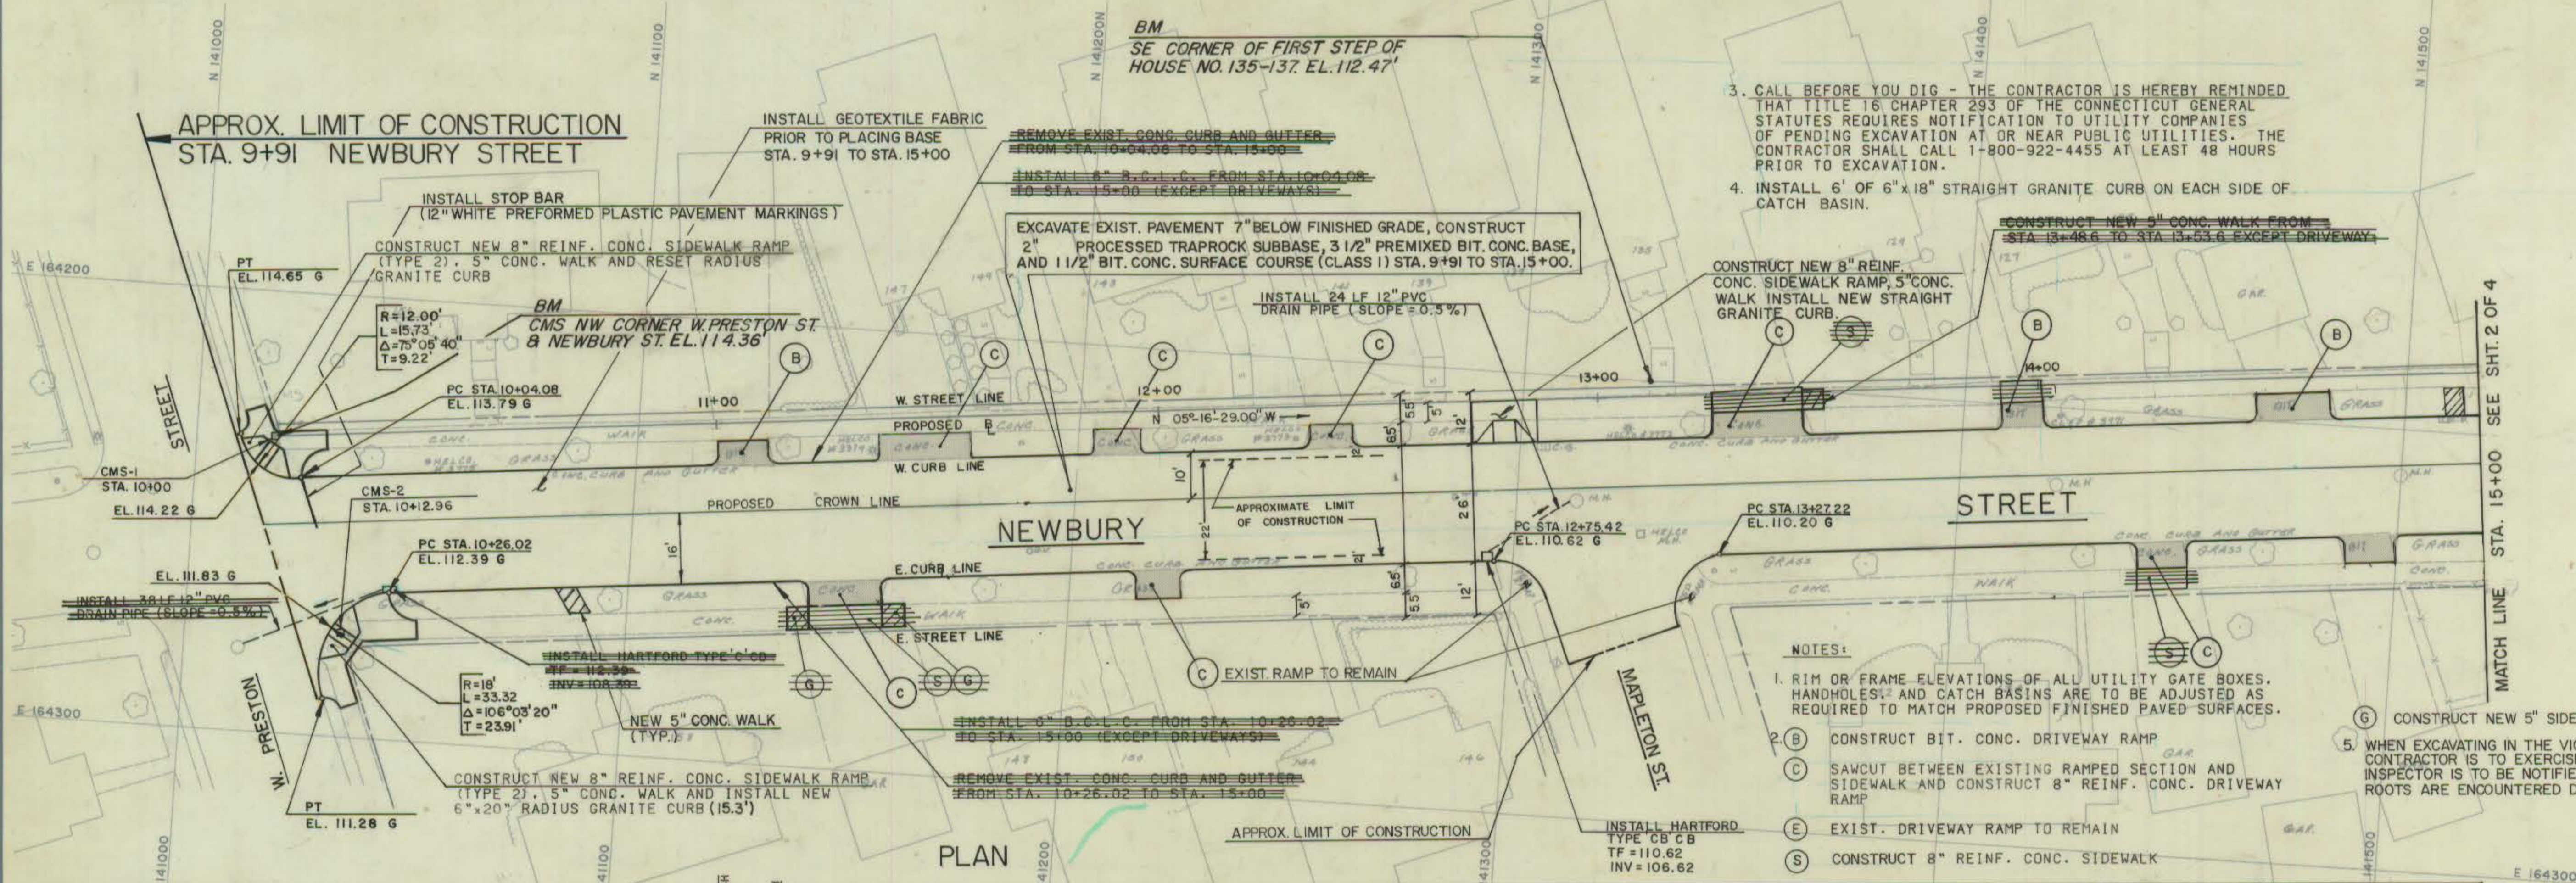

REVISIONS 01 02/23/87 ENGINEERING CHANGES DRAFTED BY M.J.N. NO. DATE DESCRIPTION		SUPV. JAC DESIGN MDH/AEC DRAWN N.D.FORTIN CHECKED FTD/JAC DATE 01-30-86	GRAPHIC SCALES HORIZ. 1"=20' VERT. 1"=2'	ROADWAY RECONSTRUCTION HARTFORD, CONNECTICUT		Hayden Wegman Consulting Engineers WEST HARTFORD NEW YORK • BOSTON • BUFFALO ATLANTA • MEMPHIS	CITY OF HARTFORD, CONNECTICUT DEPARTMENT OF PUBLIC WORKS BUREAU OF ENGINEERING SERVICES DAYBOOK NO. 011008H DATE 5-20-87	NEWBURY STREET STA. 10+00 TO STA. 15+00 PLAN AND PROFILE Contract No. E87-25 Job No. - 86390	SHEET 1 OF 4
---	--	---	--	---	---	---	--	--	-----------------

601/31

601/31