
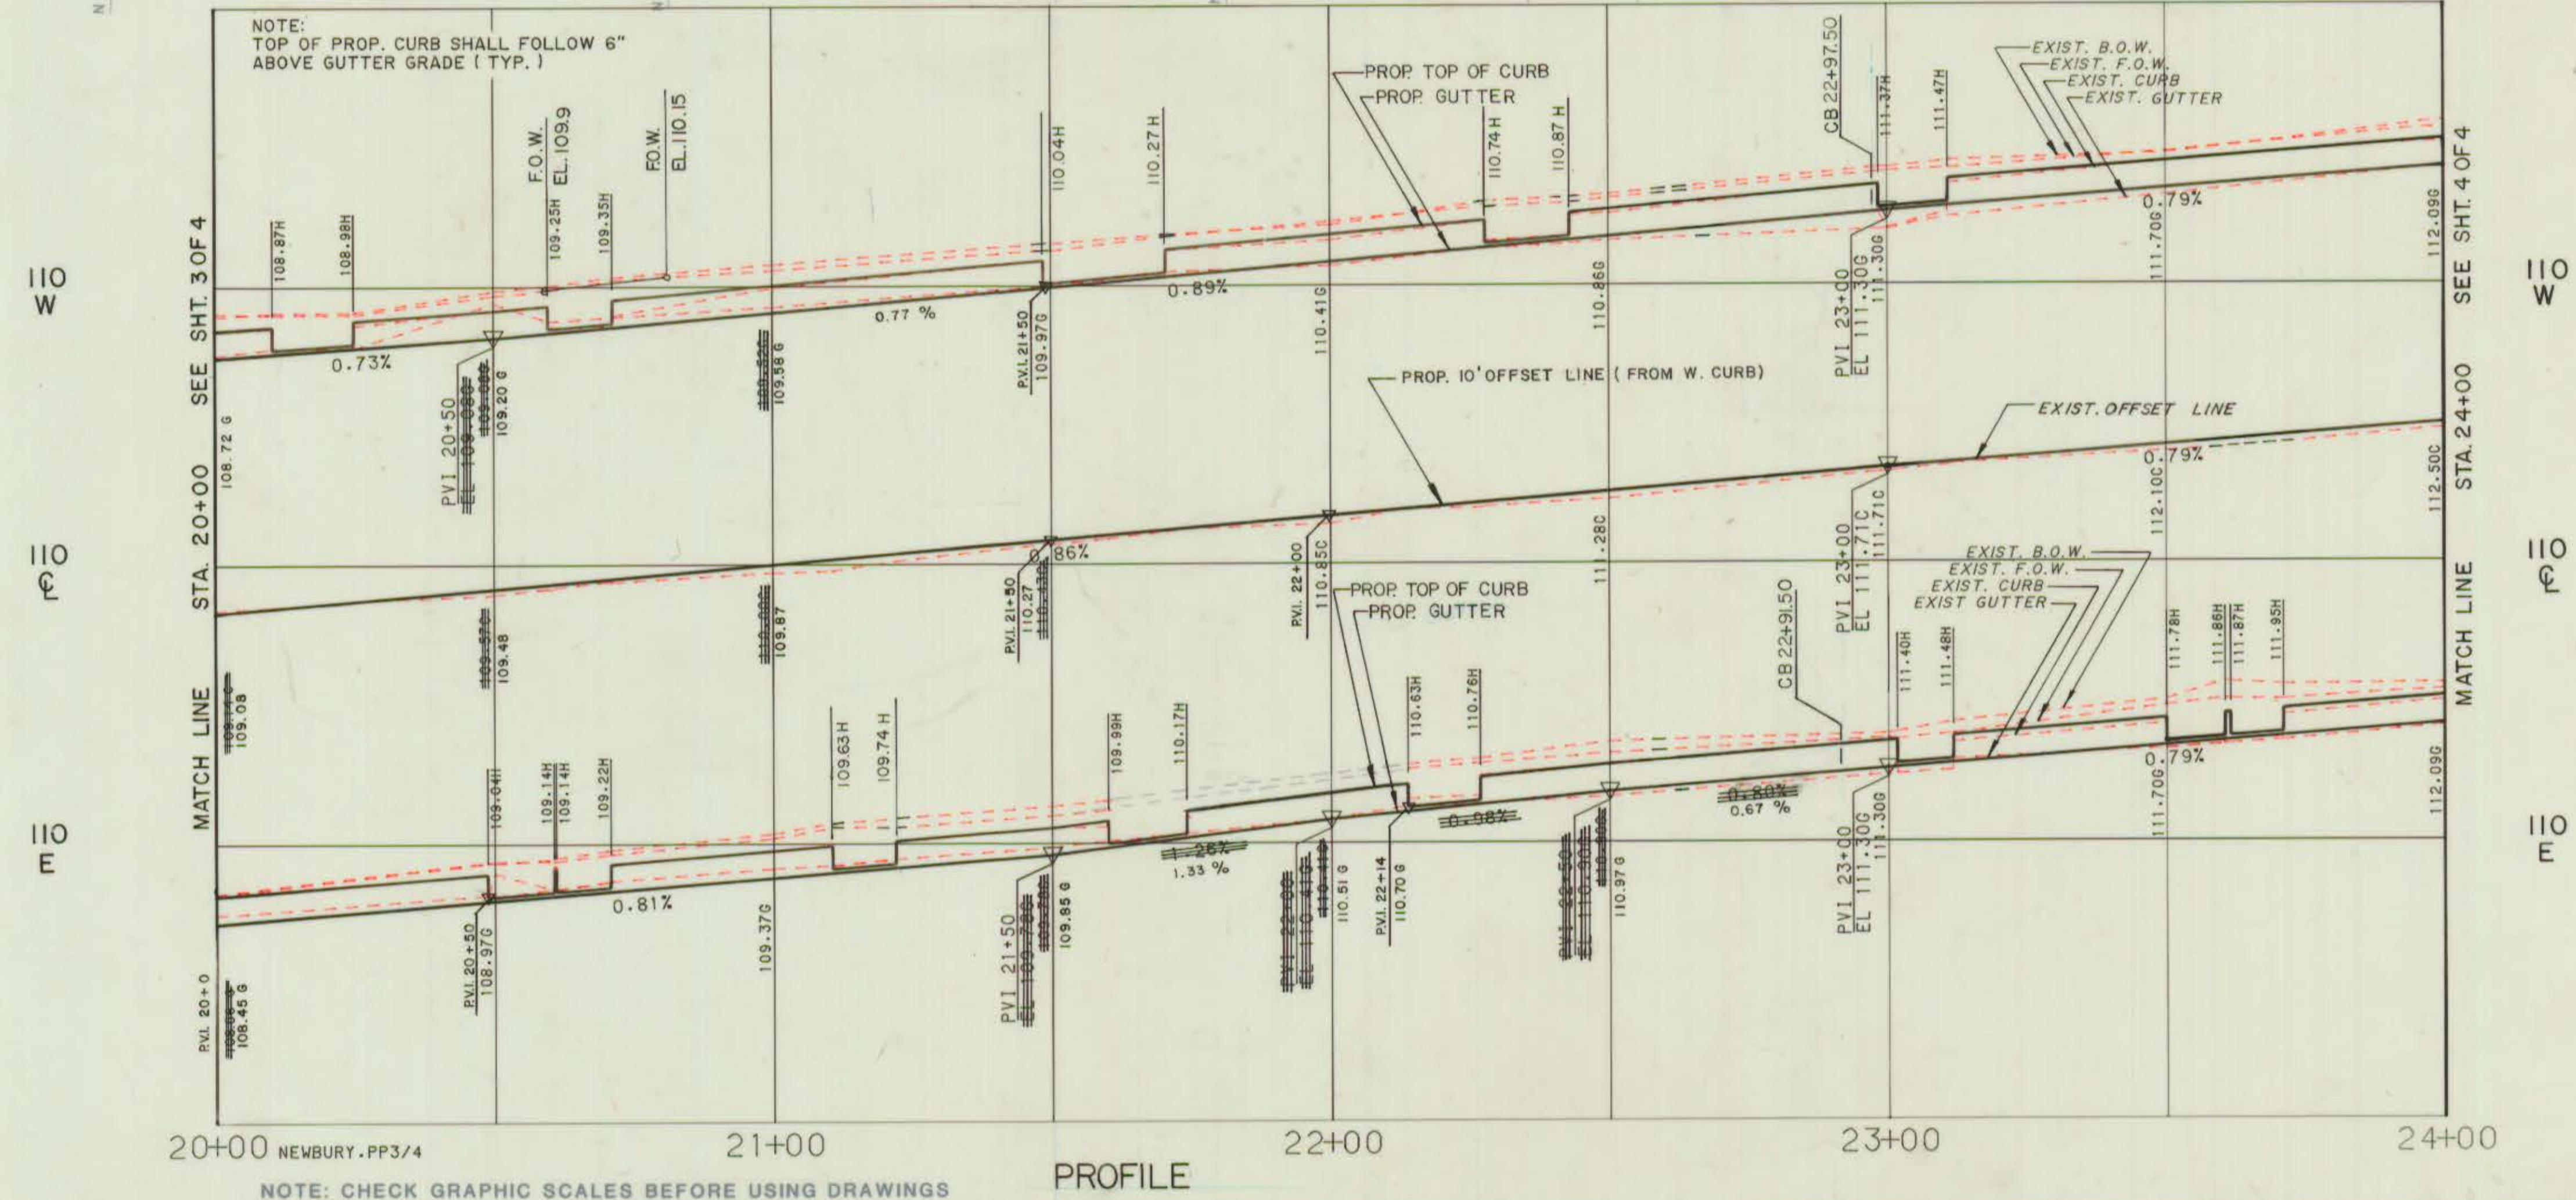


109

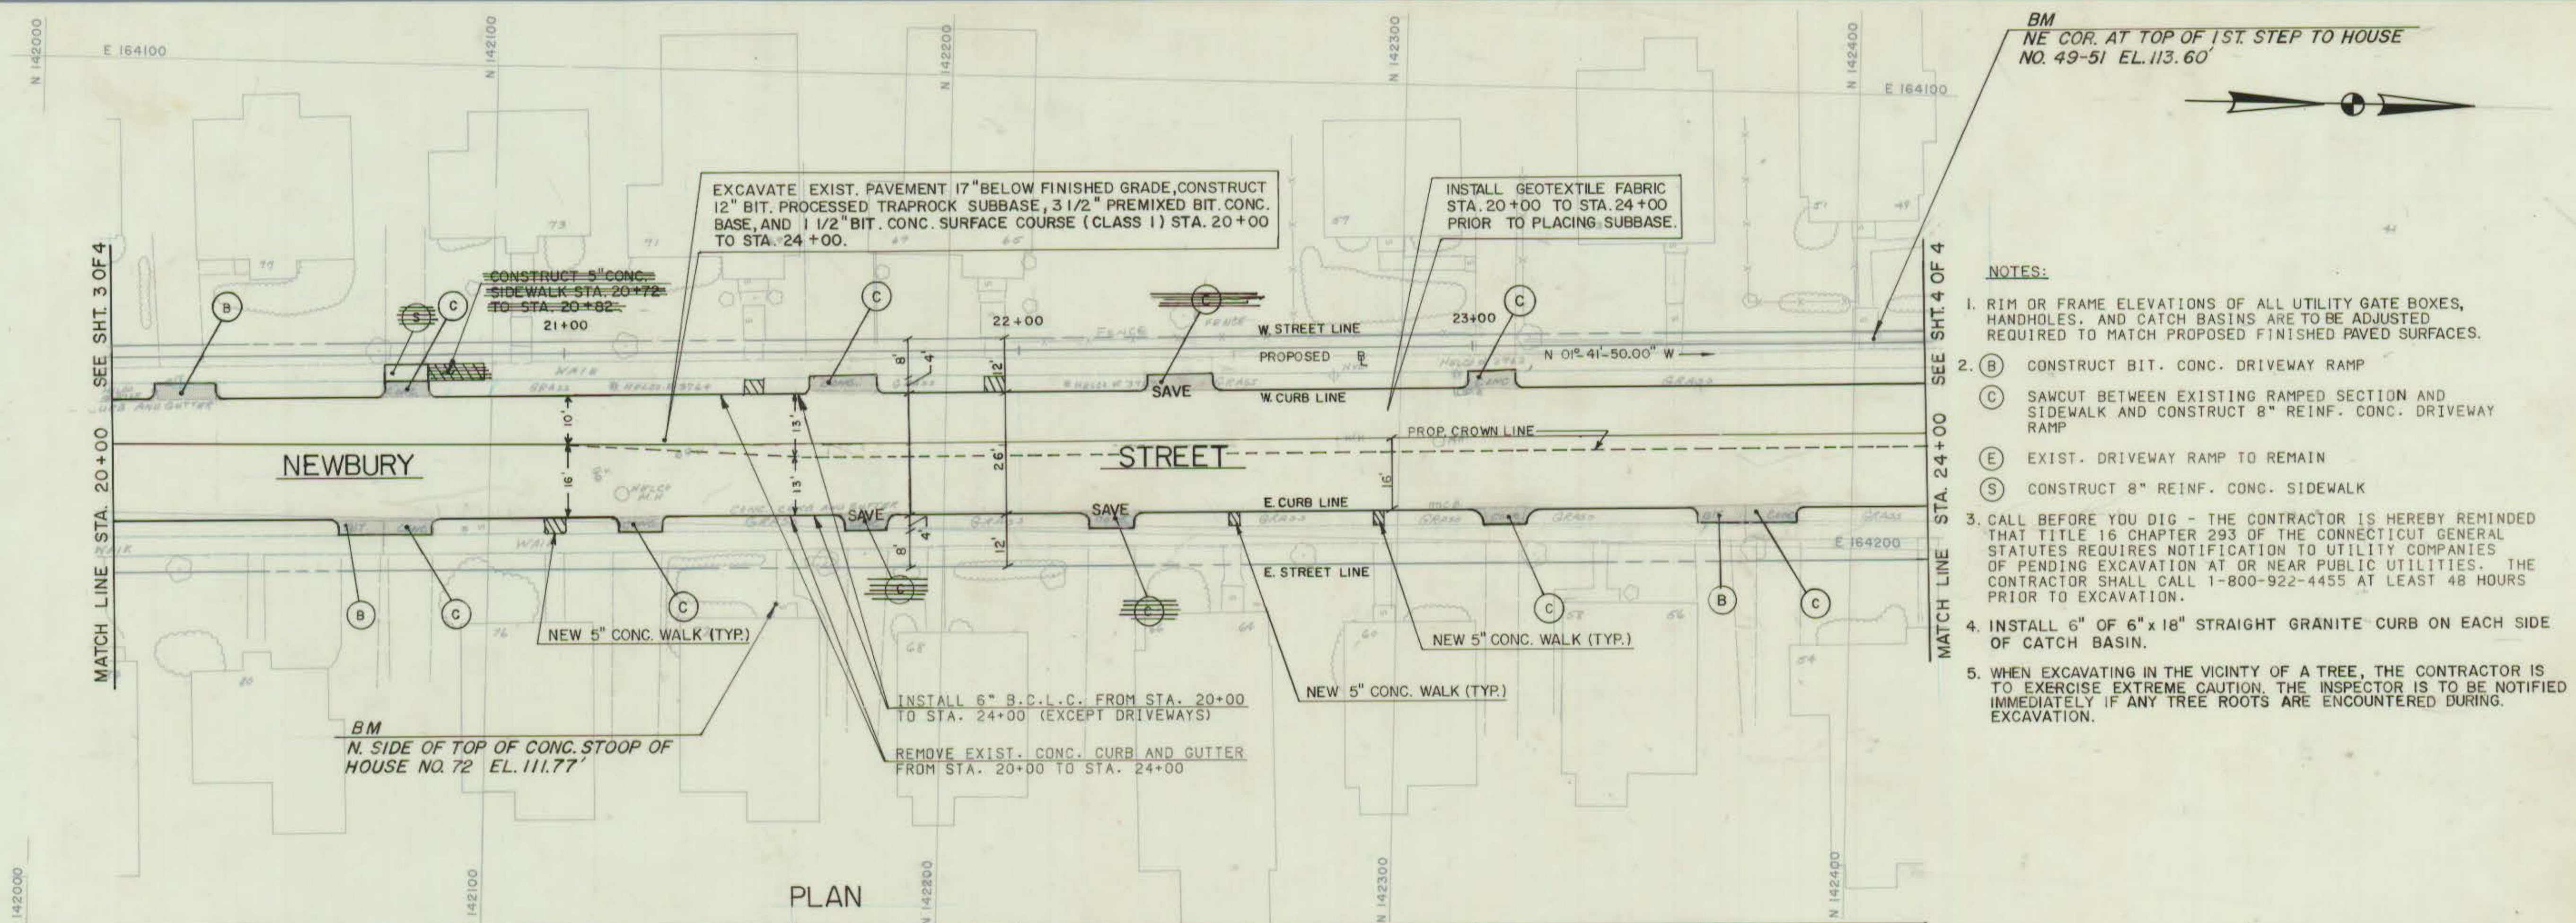

REVISIONS	
01	02/23/87 ENGINEERING CHANGES - DRAFTED BY NJN
NO.	DATE

SUPV.	JAC
DESIGN	MDH/AEC
DRAWN	N.D. FORTIN
CHECKED	JAC/FTD
DATE	01-30-86

GRAPHIC SCALES
HORIZ. 1"=20'
VERT. 1"=2'

ROADWAY RECONSTRUCTION
HARTFORD, CONNECTICUT



Hayden | Wegman
Consulting Engineers
WEST HARTFORD
NEW YORK • BOSTON • BUFFALO
ATLANTA • MEMPHIS

CITY OF HARTFORD, CONNECTICUT
DEPARTMENT OF PUBLIC WORKS
BUREAU OF ENGINEERING SERVICES
DAYBOOK NO. 011008 J
DATE 5-20-87

NEWBURY STREET STA 20+00 TO STA 24+00	
PLAN AND PROFILE	
Contract No. E87-25	Job No. 86390
SHEET 3	OF 4

601/3K

601/3K