


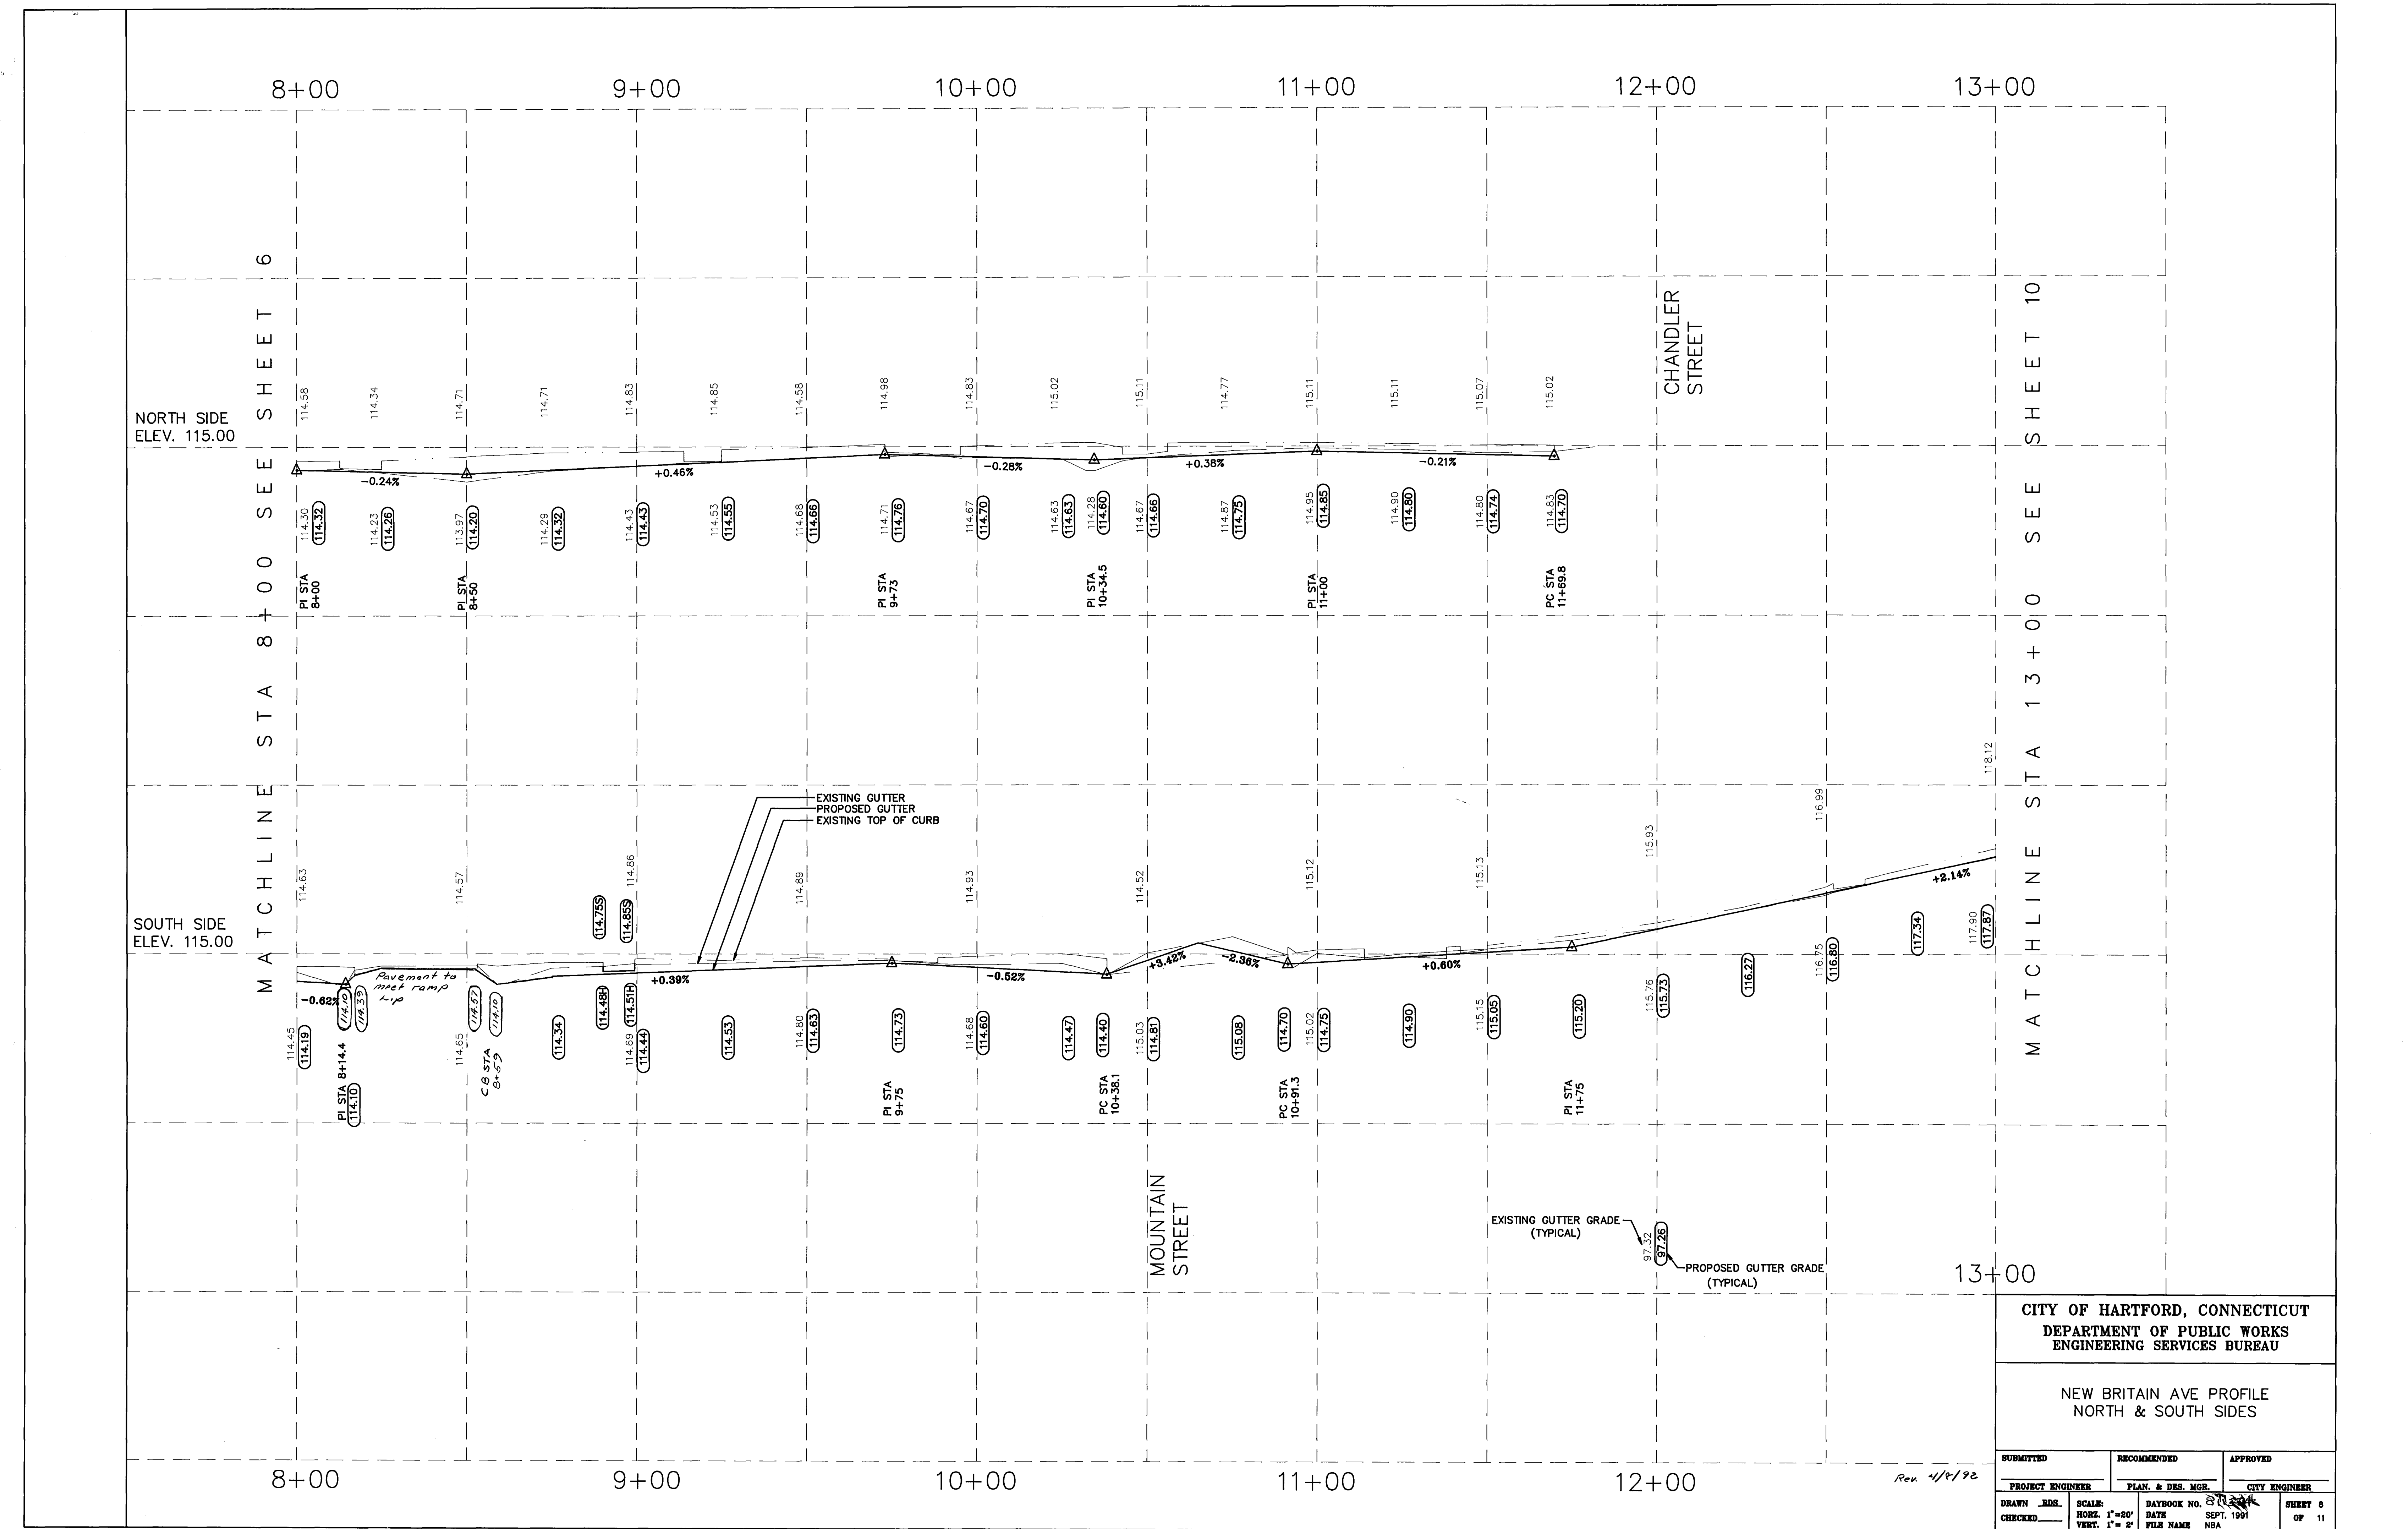

CITY OF HARTFORD, CONNECTICUT DEPARTMENT OF PUBLIC WORKS ENGINEERING SERVICES BUREAU			
NEW BRITAIN AVE PROFILE NORTH & SOUTH SIDES			
SUBMITTED		RECOMMENDED	
PROJECT ENGINEER		PLAN. & DES. MGR.	
APPROVED		CITY ENGINEER	
DRAWN RDS.		DAYBOOK NO. 81224	
CHECKED		DATE SEPT. 1991	
		FILE NAME NBA	
		SHEET 8 OF 11	

Rev. 4/8/92