



FILE NAME: SUNSTP.DWG 01/03/92 09:20 TNS

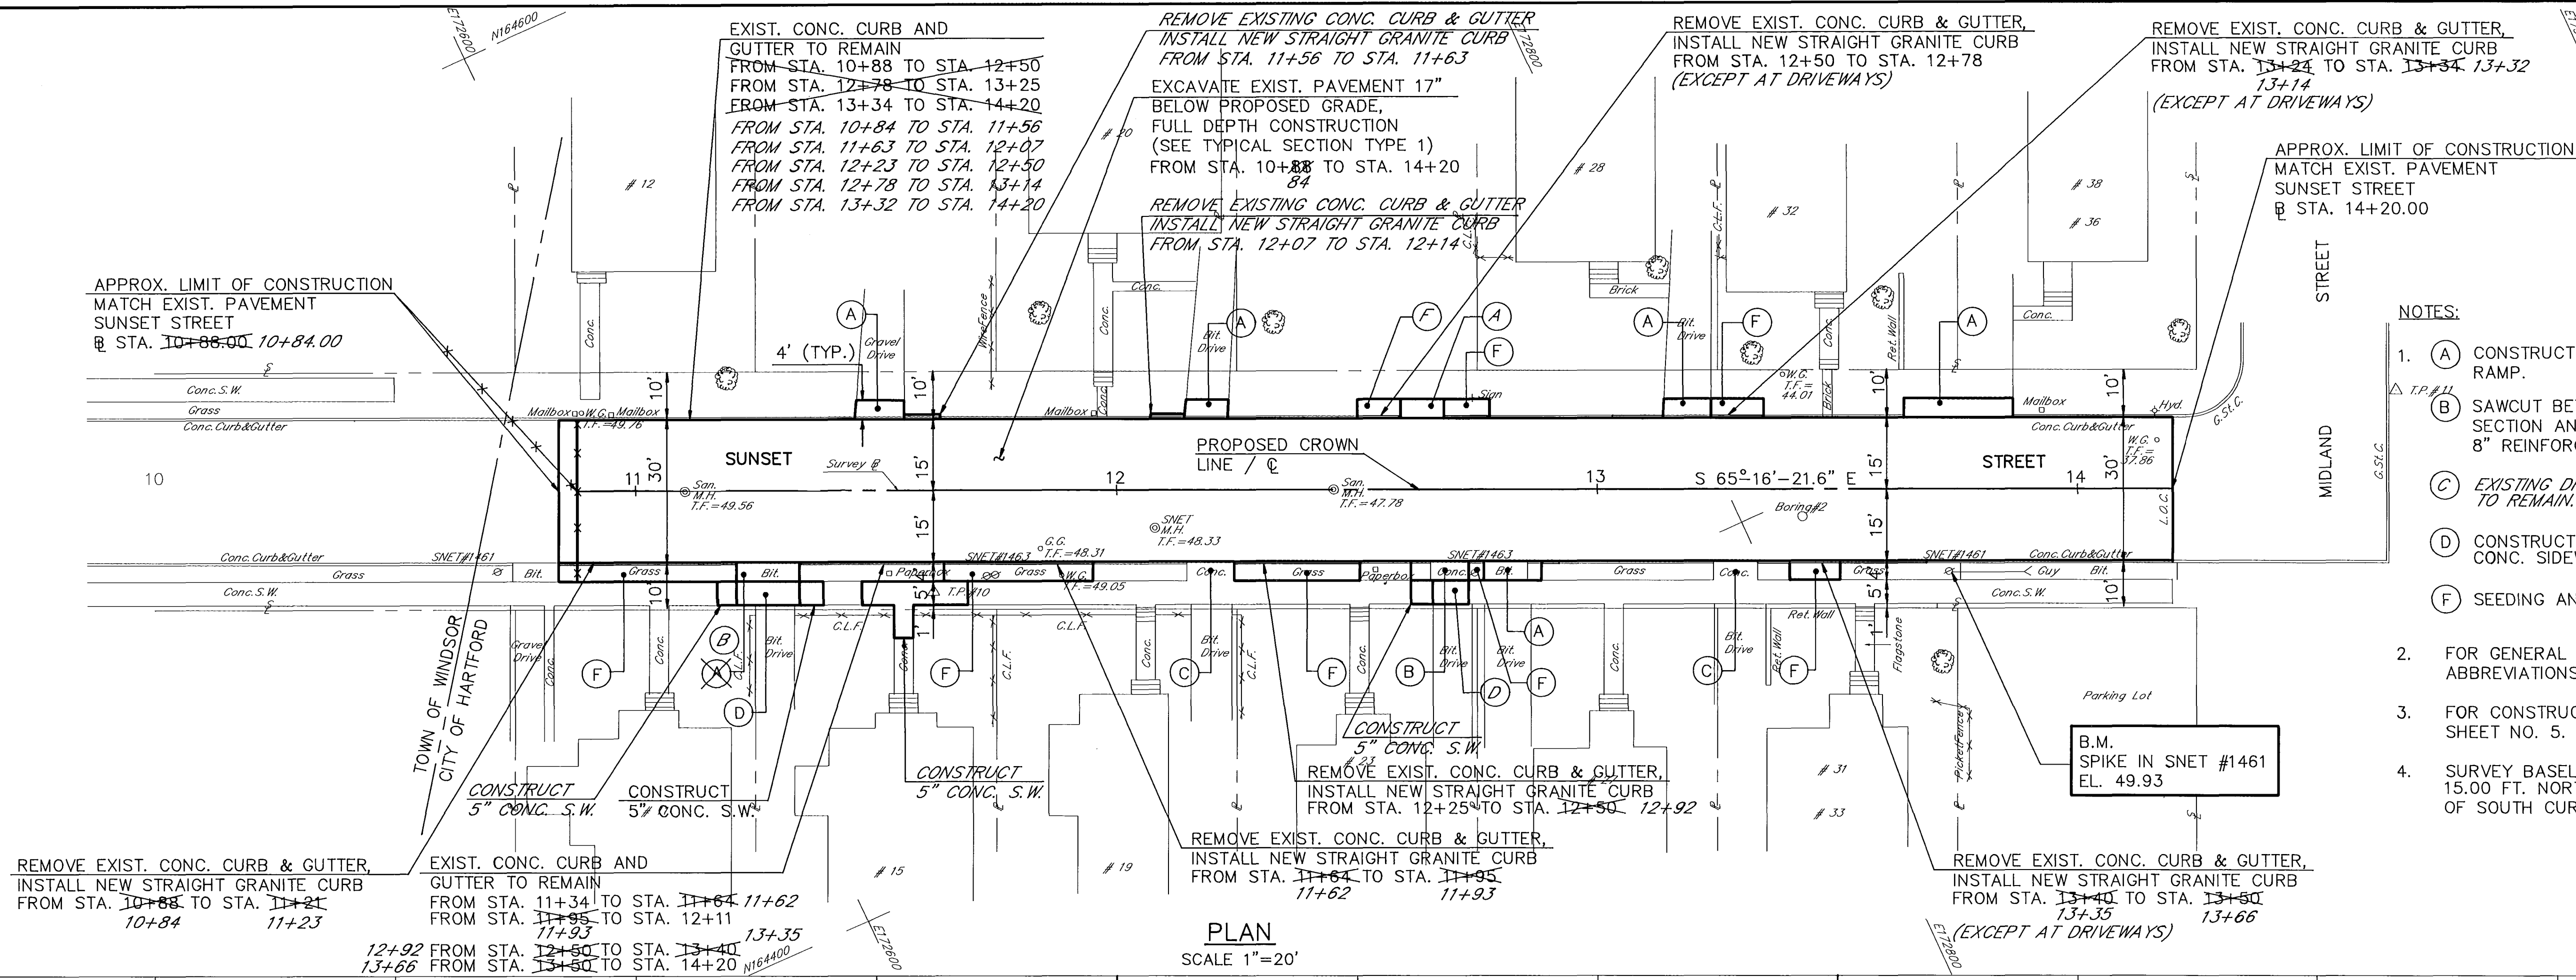

- NOTES:
- (A) CONSTRUCT BIT. CONC. DRIVEWAY RAMP.
 - (B) SAWCUT BETWEEN EXISTING RAMPED SECTION AND SIDEWALK, AND CONSTRUCT 8" REINFORCED CONC. DRIVEWAY RAMP.
 - (C) EXISTING DRIVEWAY RAMP TO REMAIN.
 - (D) CONSTRUCT 8" REINFORCED CONC. SIDEWALK
 - (F) SEEDING AND MULCHING.
2. FOR GENERAL NOTES AND LIST OF ABBREVIATIONS, SEE SHEET NO. 2.
3. FOR CONSTRUCTION NOTES SEE SHEET NO. 5.
4. SURVEY BASELINE IS LOCATED 15.00 FT. NORTH FROM FACE OF SOUTH CURB.

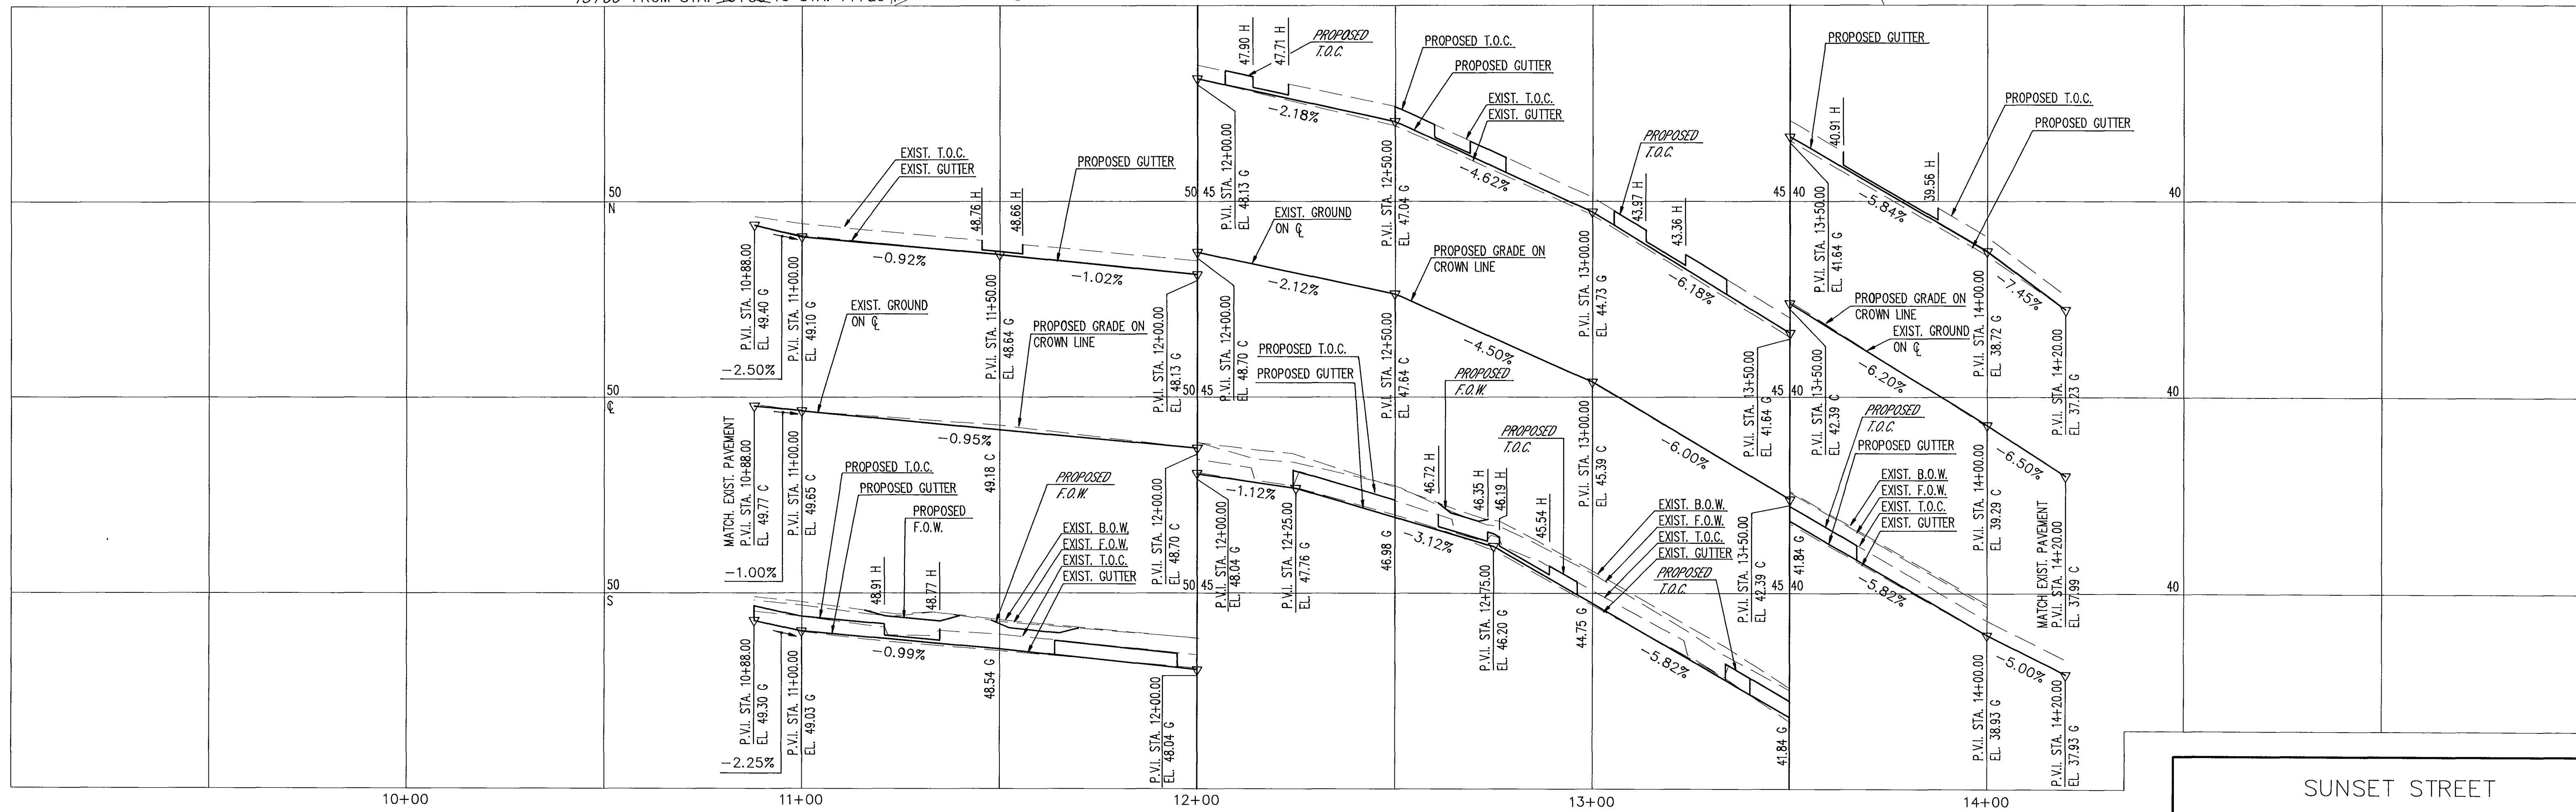

PROFILE
SCALE
VERT. 1"=2'
HORIZ. 1"=20'

SUNSET STREET
PLAN AND PROFILE
THE CITY OF
HARTFORD, CONNECTICUT

NO.	DATE	REVISION
DESIGNED:	M.R.A.	DATE: JULY 6, 1990
DRAWN:	K.R.	CHECKED: P.L.
APPROVED:	R.C.G.	SCALE: AS NOTED

PURCELL
ASSOCIATES

SHEET NO.
8 OF 11
DAYBOOK NO.
011212A