



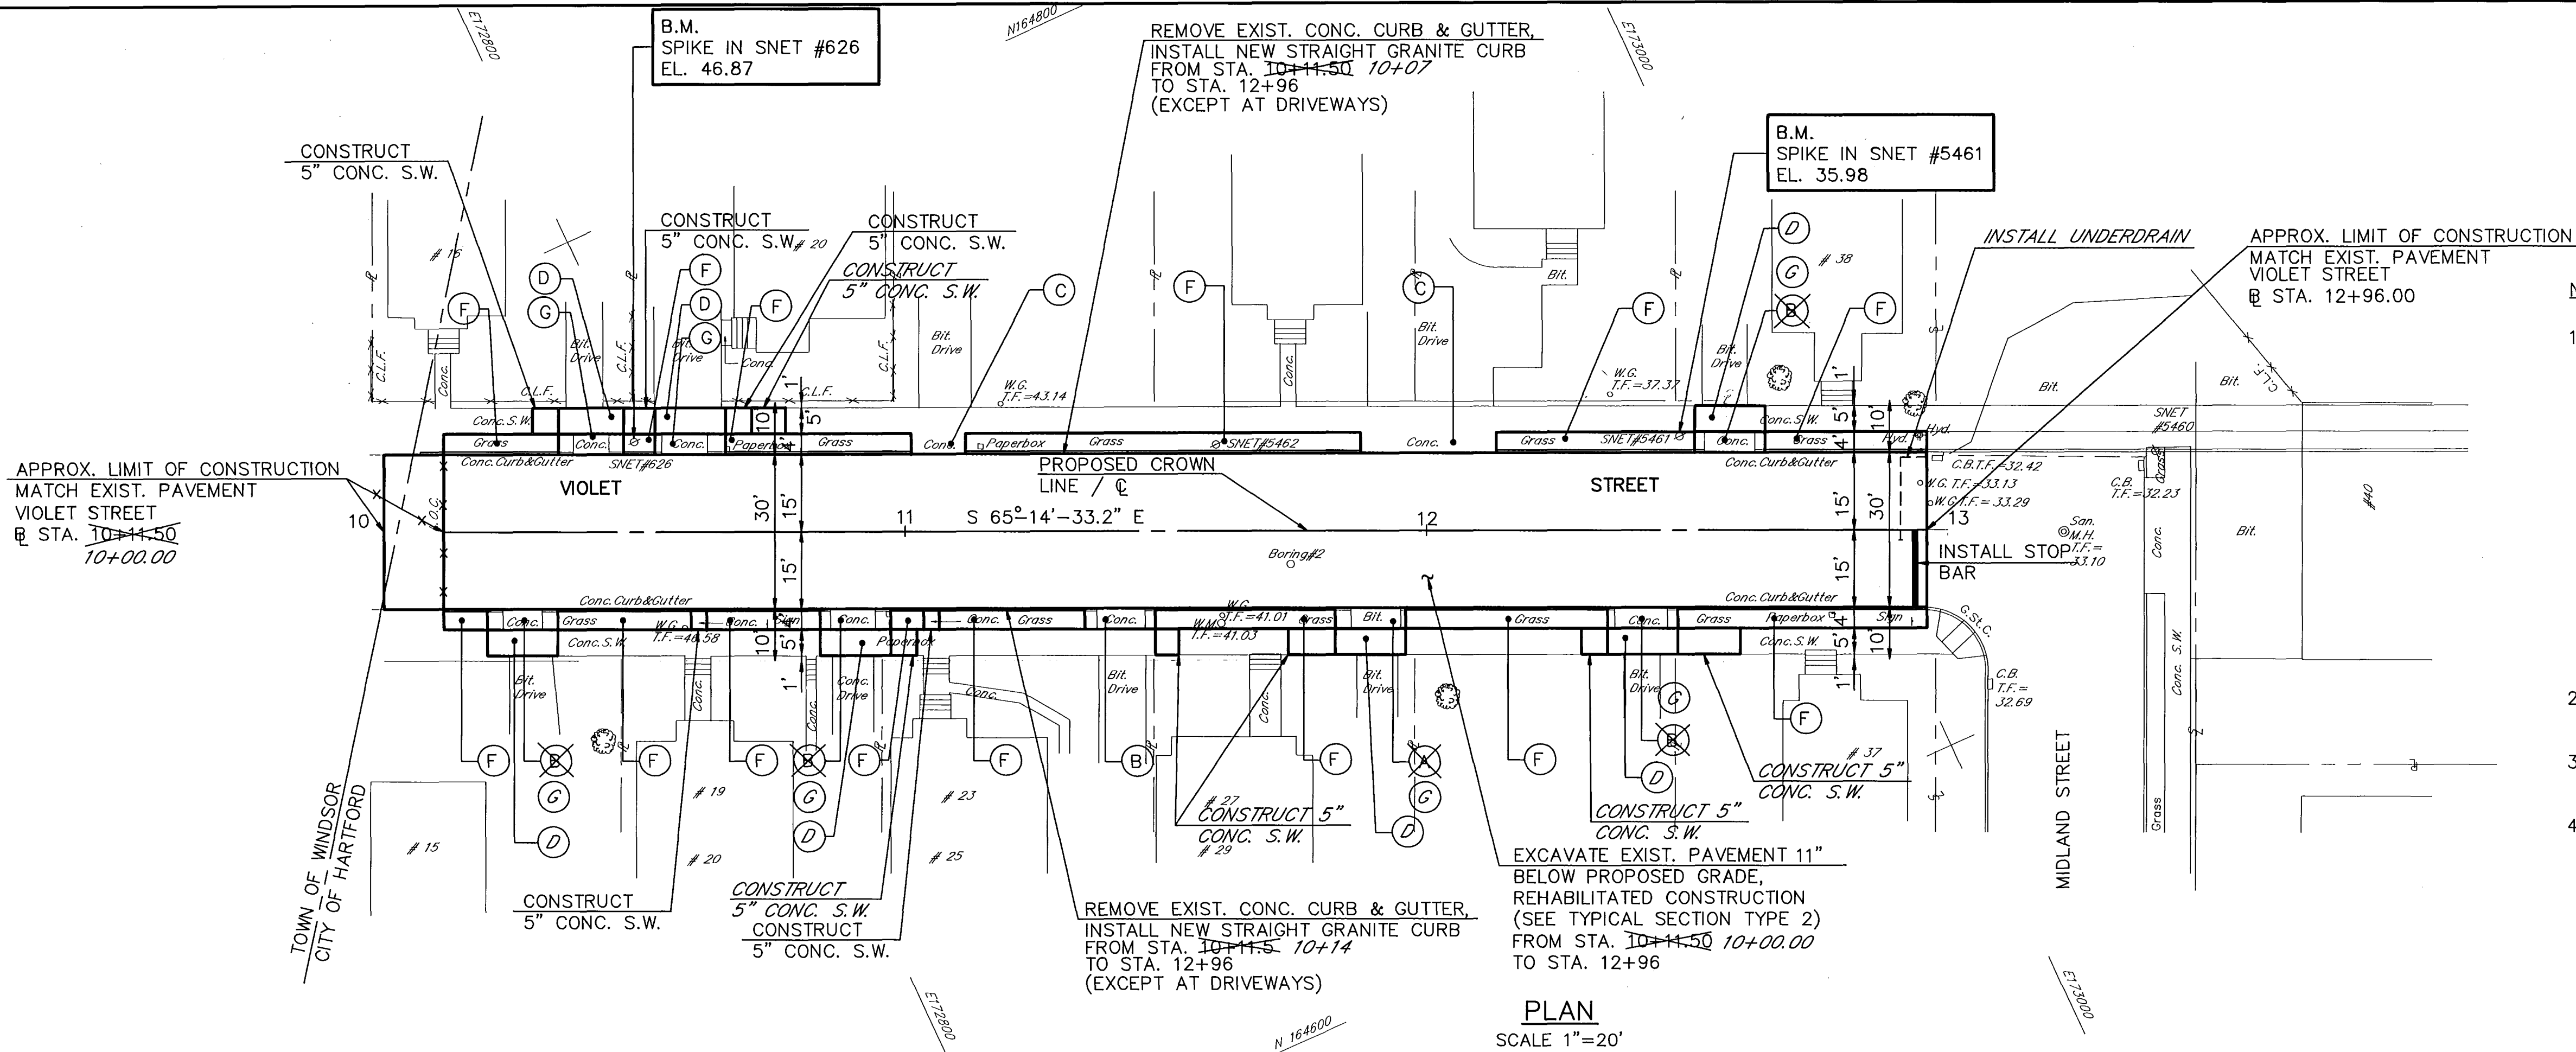

NOTES:

- (A) CONSTRUCT BIT. CONC. DRIVEWAY RAMP.
 - (B) SAWCUT BETWEEN EXISTING RAMPED SECTION AND SIDEWALK, AND CONSTRUCT 8\"/>
 - (C) EXISTING DRIVEWAY RAMP TO REMAIN.
 - (D) CONSTRUCT 8\"/>
 - (F) SEEDING AND MULCHING.
 - (G) CONSTRUCT 8\"/>
2. FOR GENERAL NOTES AND LIST OF ABBREVIATIONS, SEE SHEET NO. 2.
3. FOR CONSTRUCTION NOTES SEE SHEET NO. 5.
4. SURVEY BASELINE IS LOCATED 15.00 FT. NORTH FROM FACE OF SOUTH CURB.

PLAN
SCALE 1"=20'

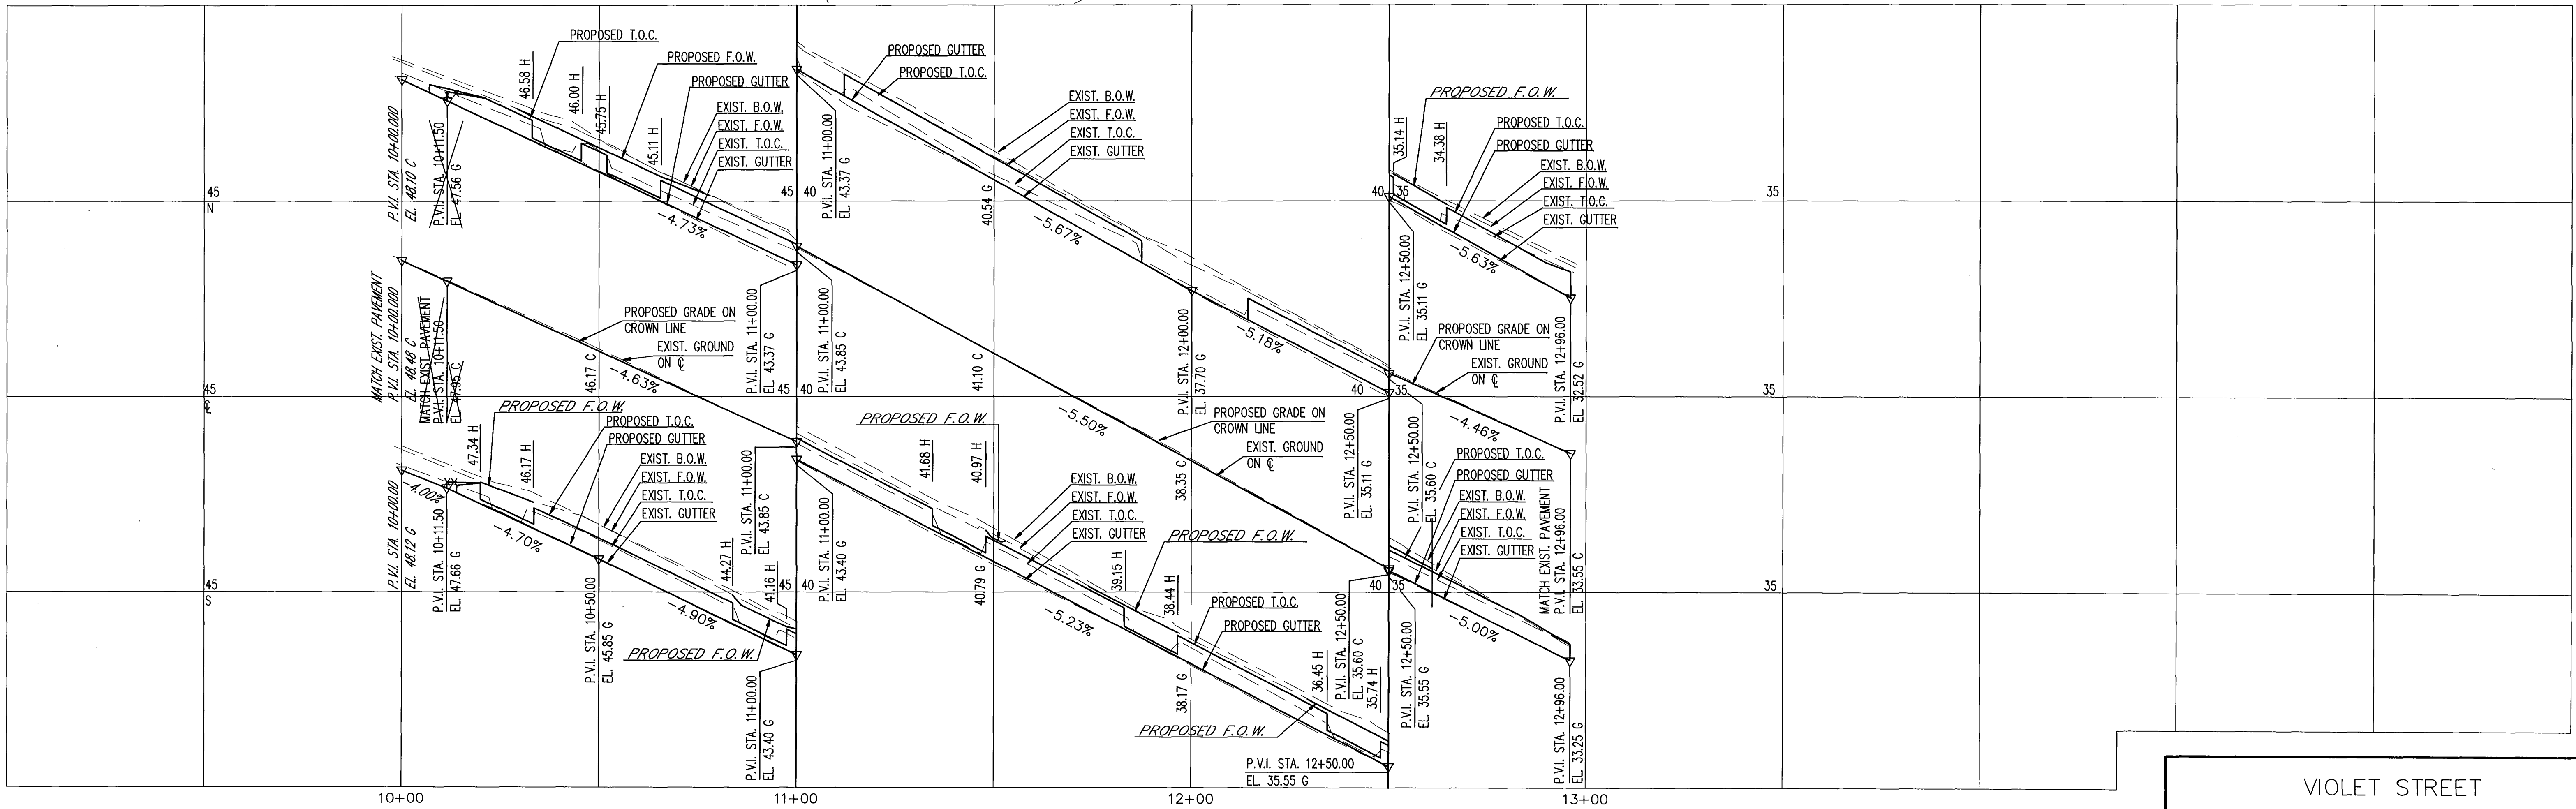

PROFILE
SCALE
VERT. 1"=2'
HORIZ. 1"=20'

VIOLET STREET
PLAN AND PROFILE
THE CITY OF
HARTFORD, CONNECTICUT

NO.	DATE	REVISION
DESIGNED: L.C.	DATE: JULY 6, 1990	
DRAWN: T.N.S.	SCALE: AS NOTED	
CHECKED: P.L.		
APPROVED: R.C.G.		

PURCELL
ATTN: JAMES

SHEET NO.
9 OF 11
DAYBOOK NO.
011212B