

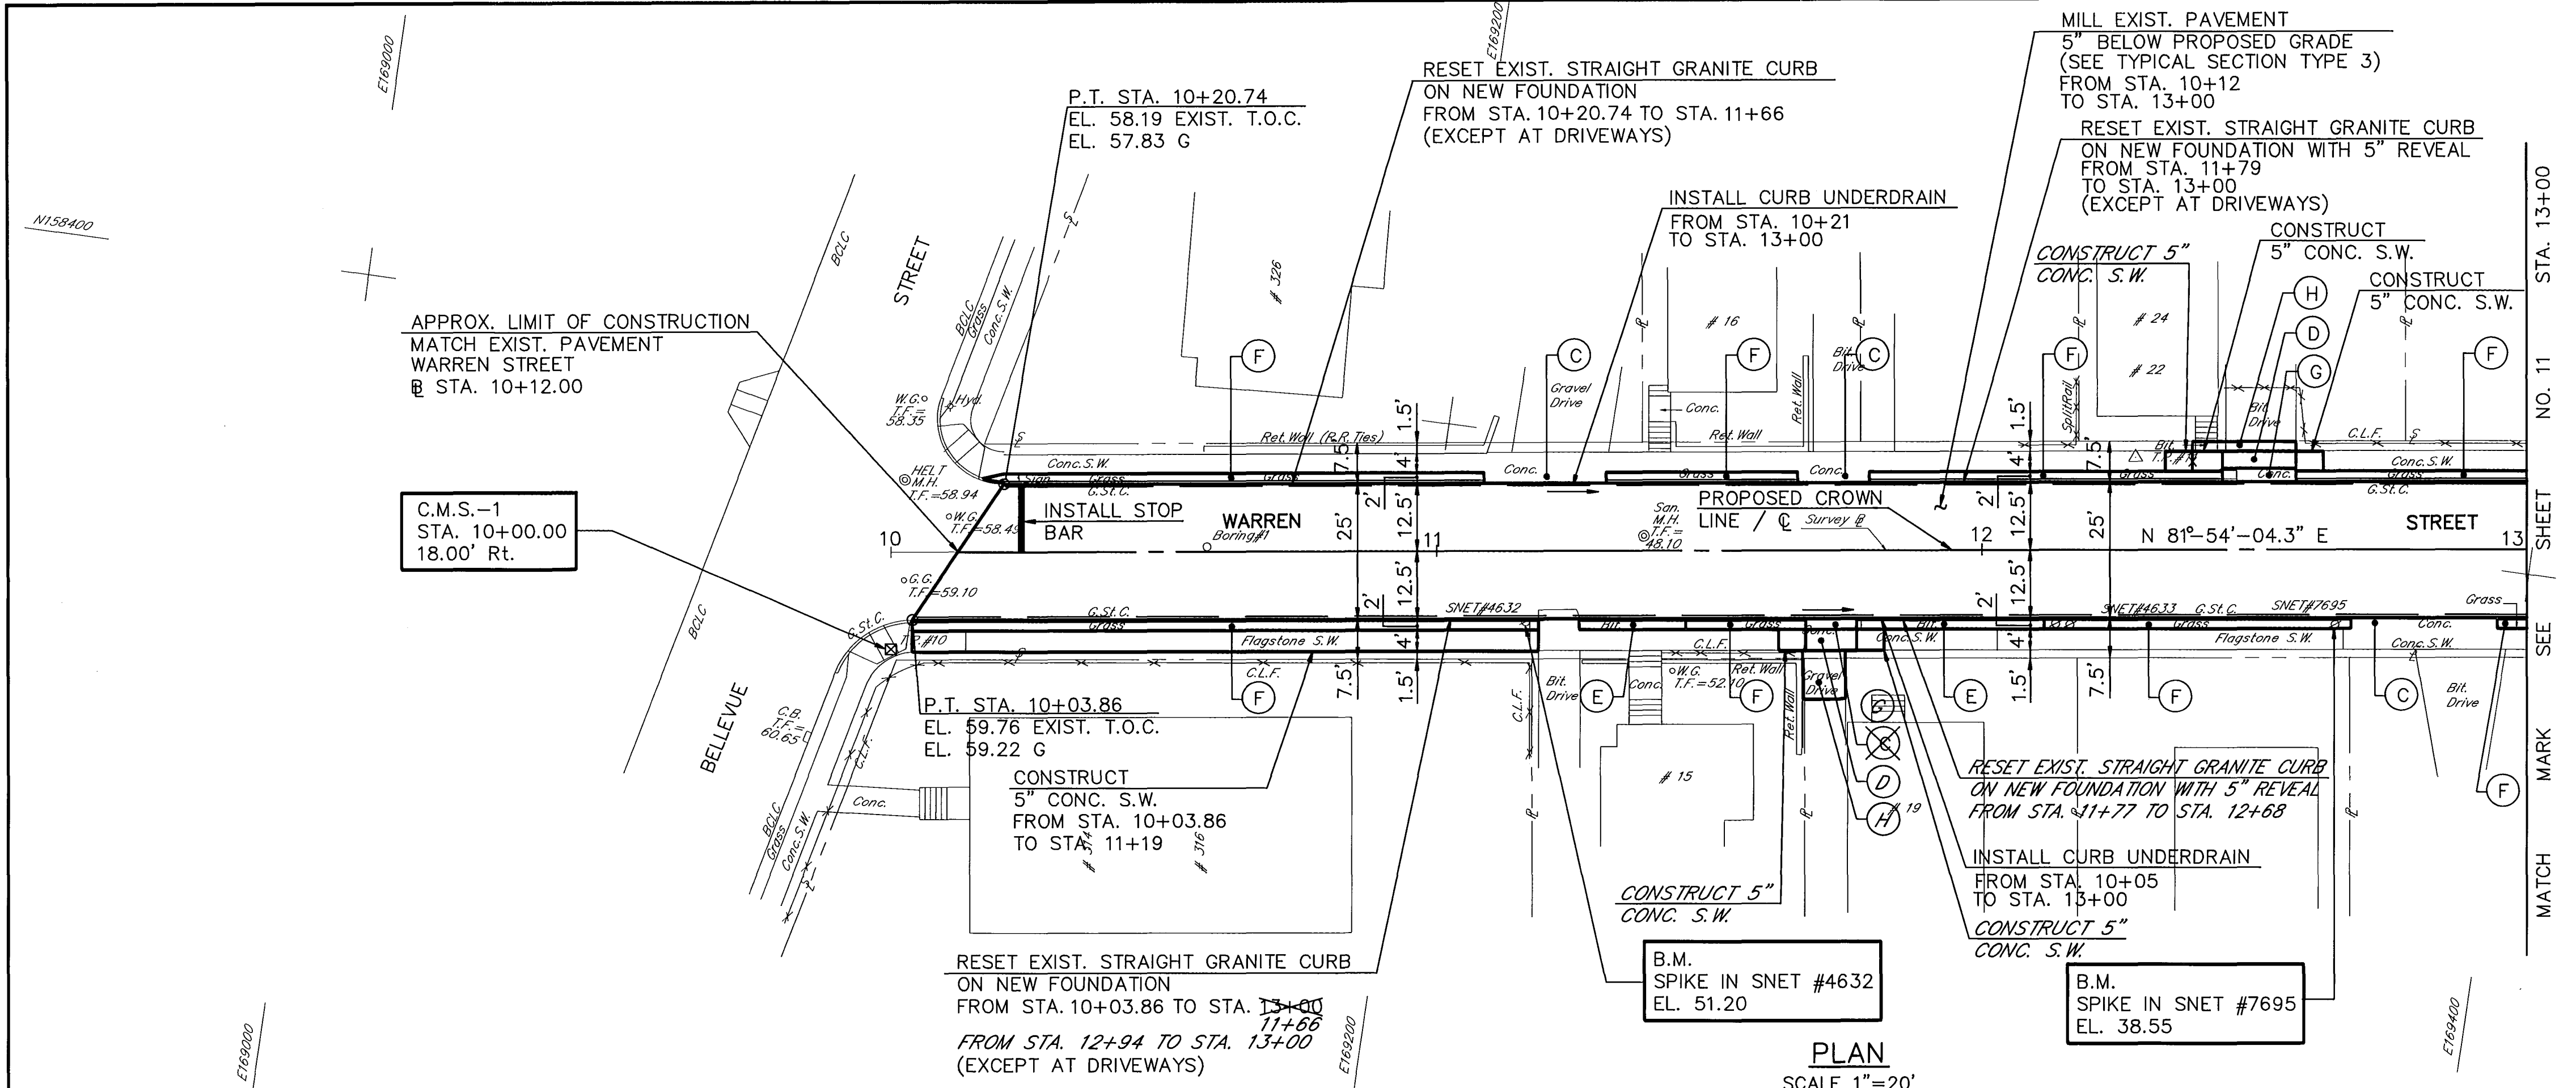


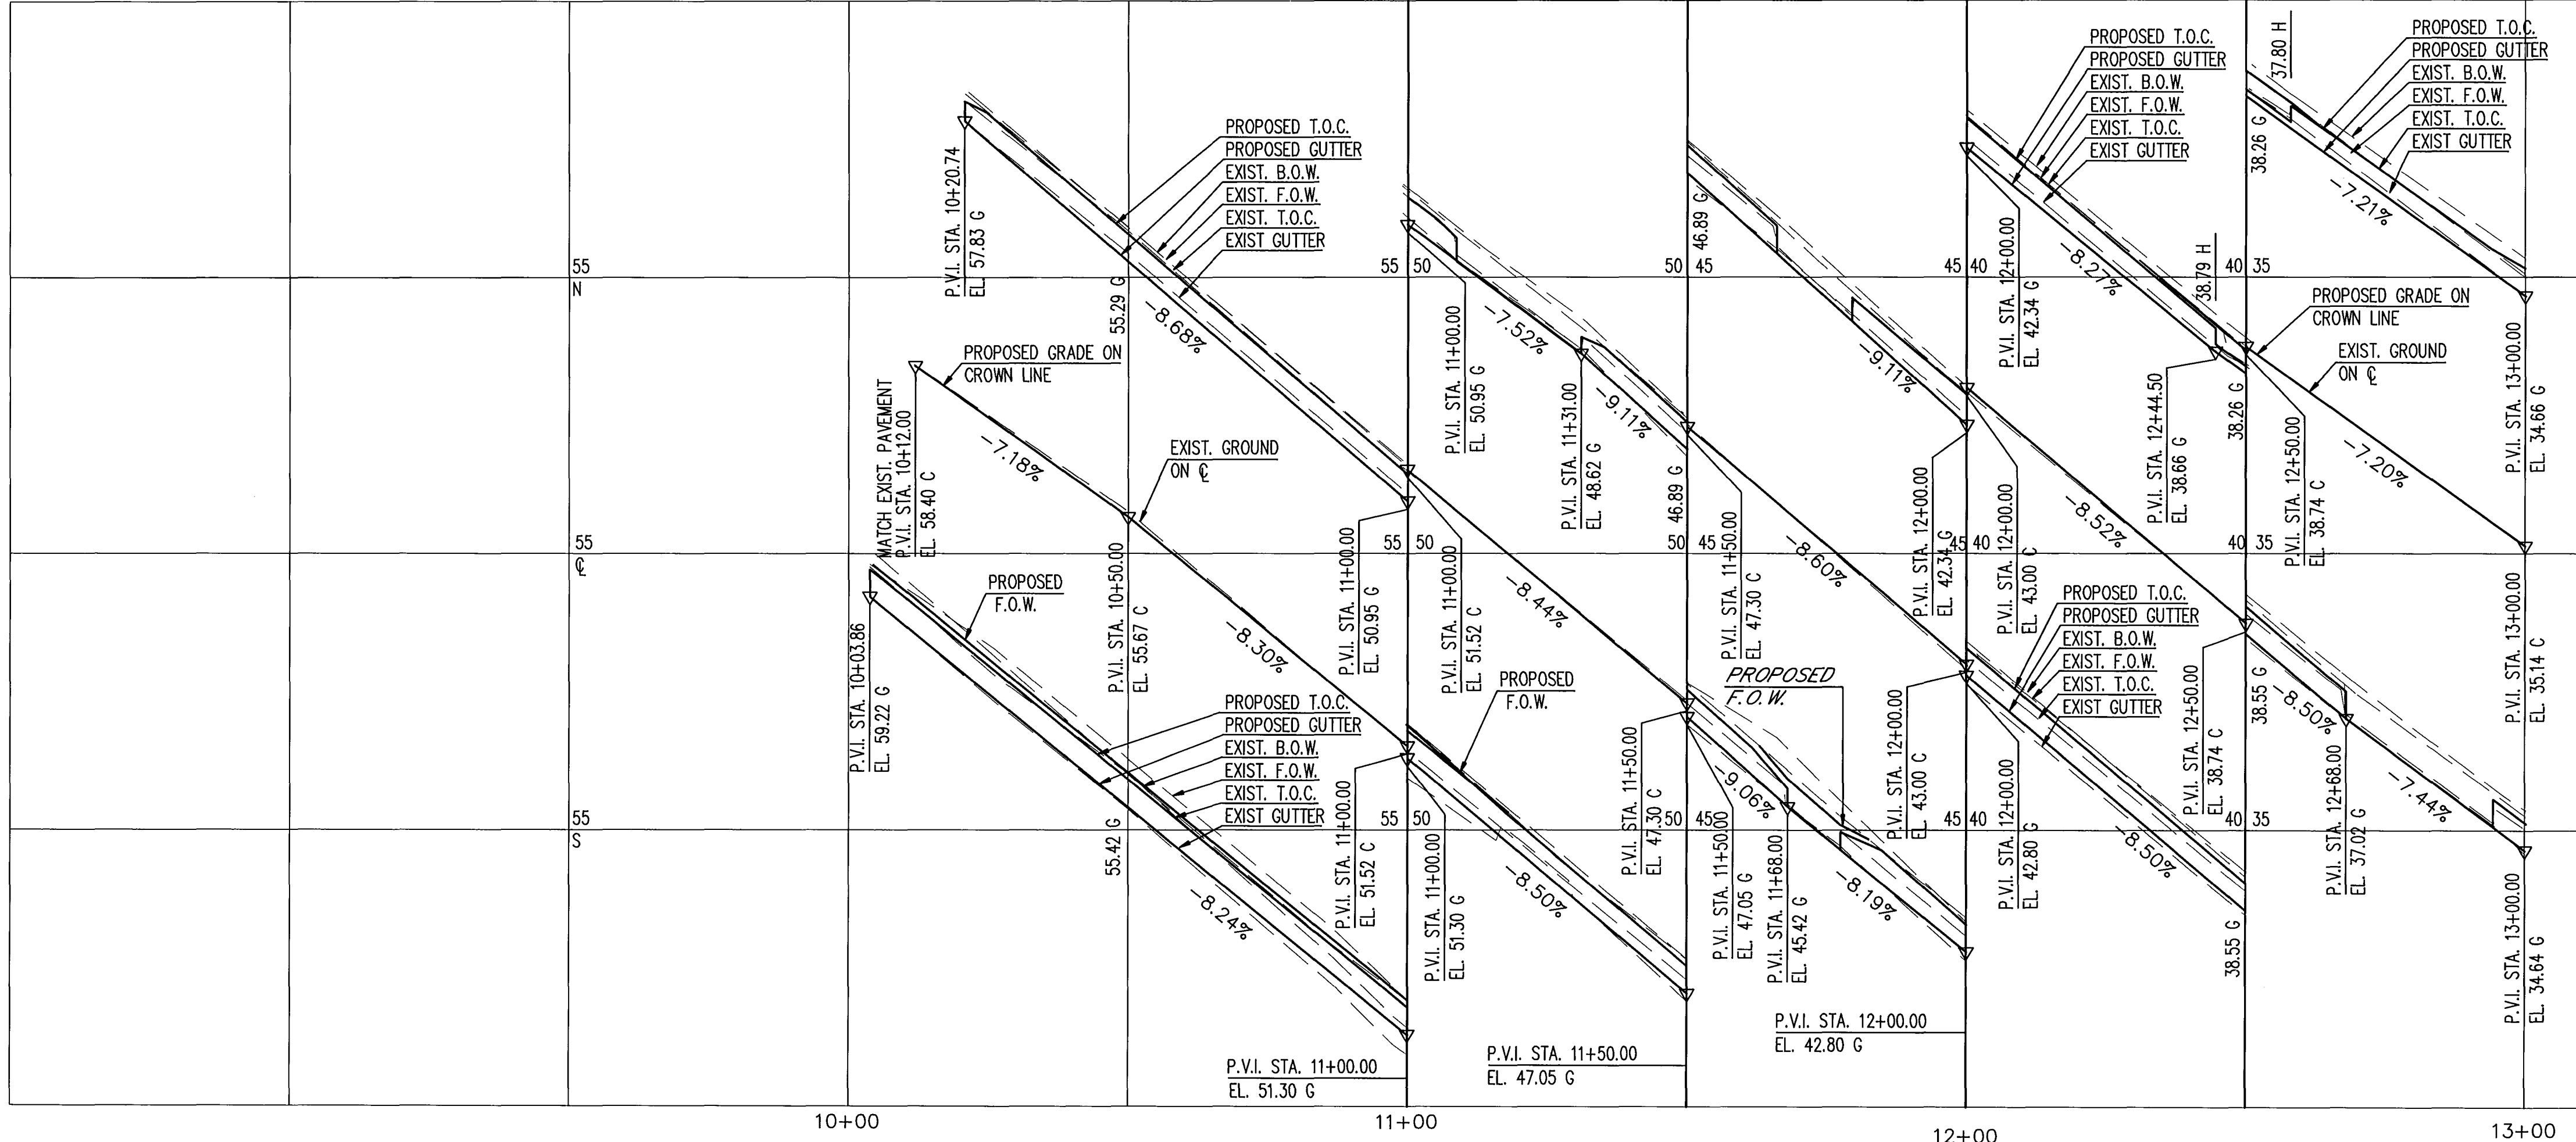

- NOTES:
- (C) EXISTING DRIVEWAY RAMP TO REMAIN.
 - (D) CONSTRUCT 8" REINFORCED CONC. SIDEWALK
 - (E) CONSTRUCT 2" BIT. CONC. SURFACE ON NEW FOUNDATION, EXCEPT AT DRIVEWAYS AND RAMP.
 - (F) SEEDING AND MULCHING.
 - (G) CONSTRUCT 8" REINFORCED CONC. DRIVEWAY RAMP.
 - (H) CONSTRUCT BIT. CONC. DRIVEWAY.
2. FOR GENERAL NOTES AND LIST OF ABBREVIATIONS, SEE SHEET NO. 2.
3. FOR CONSTRUCTION NOTES SEE SHEET NO. 5.
4. SURVEY BASELINE IS LOCATED 18.00 FT. NORTH OF C.M.S.-1.

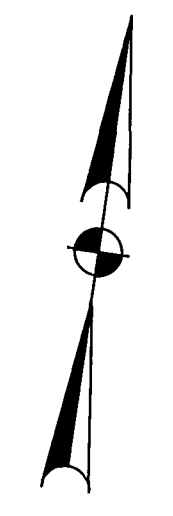

PROFILE
SCALE
VERT. 1"=2'
HORIZ. 1"=20'

WARREN STREET	
PLAN AND PROFILE	
THE CITY OF HARTFORD, CONNECTICUT	
DESIGNED: T.A.S.	DATE: JULY 6, 1990
DRAWN: K.R.	SCALE: AS NOTED
CHECKED: P.L.	
APPROVED: R.C.G.	
SHEET NO. 10 OF 11	
DAYBOOK NO. 011212C	