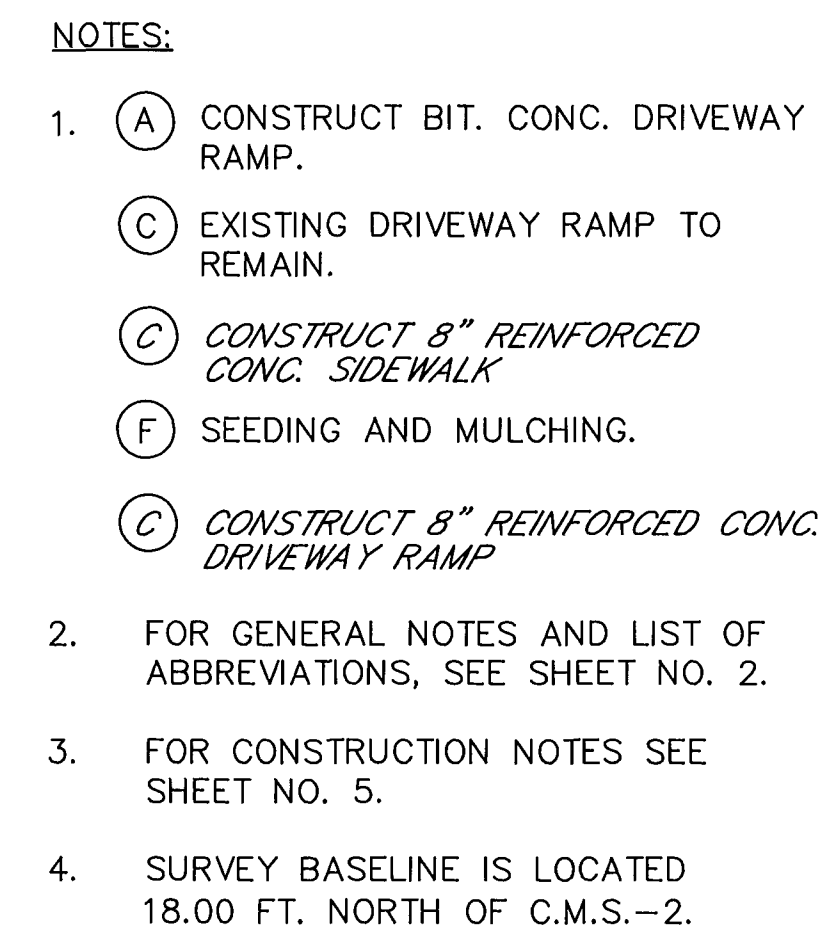


|                  |      |                    |
|------------------|------|--------------------|
|                  |      |                    |
|                  |      |                    |
|                  |      |                    |
|                  |      |                    |
| NO.              | DATE | REVISION           |
| DESIGNED: T.A.S. |      | DATE : JULY 6, 199 |
| DRAWN: K.R.      |      |                    |
| CHECKED: P.L.    |      |                    |
| APPROVED: R.C.G. |      |                    |
|                  |      | SCALE: AS NOTED    |

WARREN STREET

---

PLAN AND PROFILE

---

THE CITY OF  
HARTFORD, CONNECTICUT



**PURCELL**  
ASSOCIATES

|                       |
|-----------------------|
| SHEET NO.<br>11 OF 11 |
| DAYBOOK NO<br>011212C |