




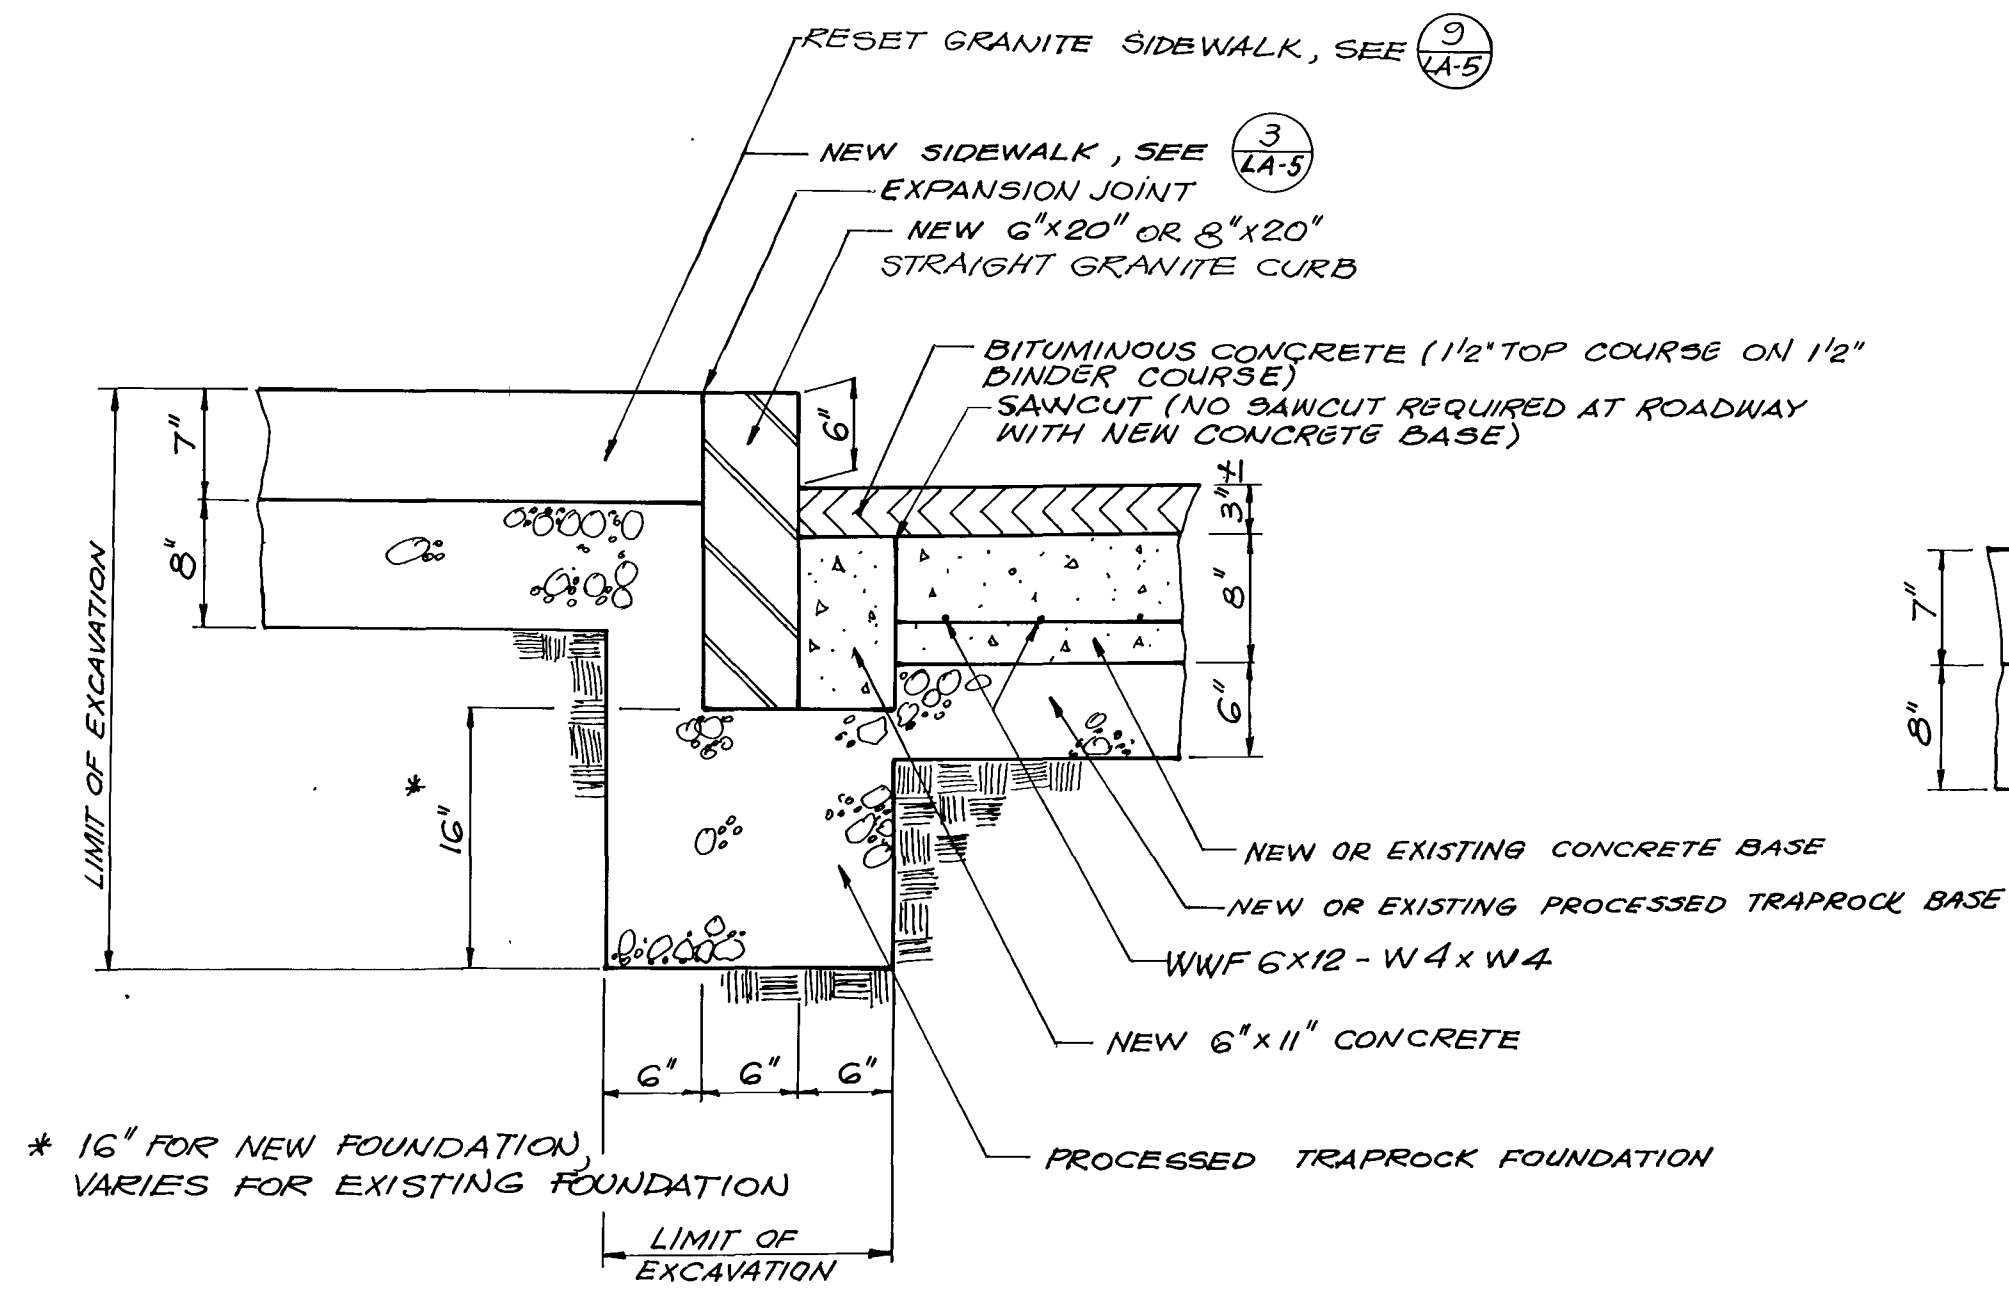


1
C-6 NEW STRAIGHT GRANITE CURB ON EXISTING OR NEW FOUNDATION

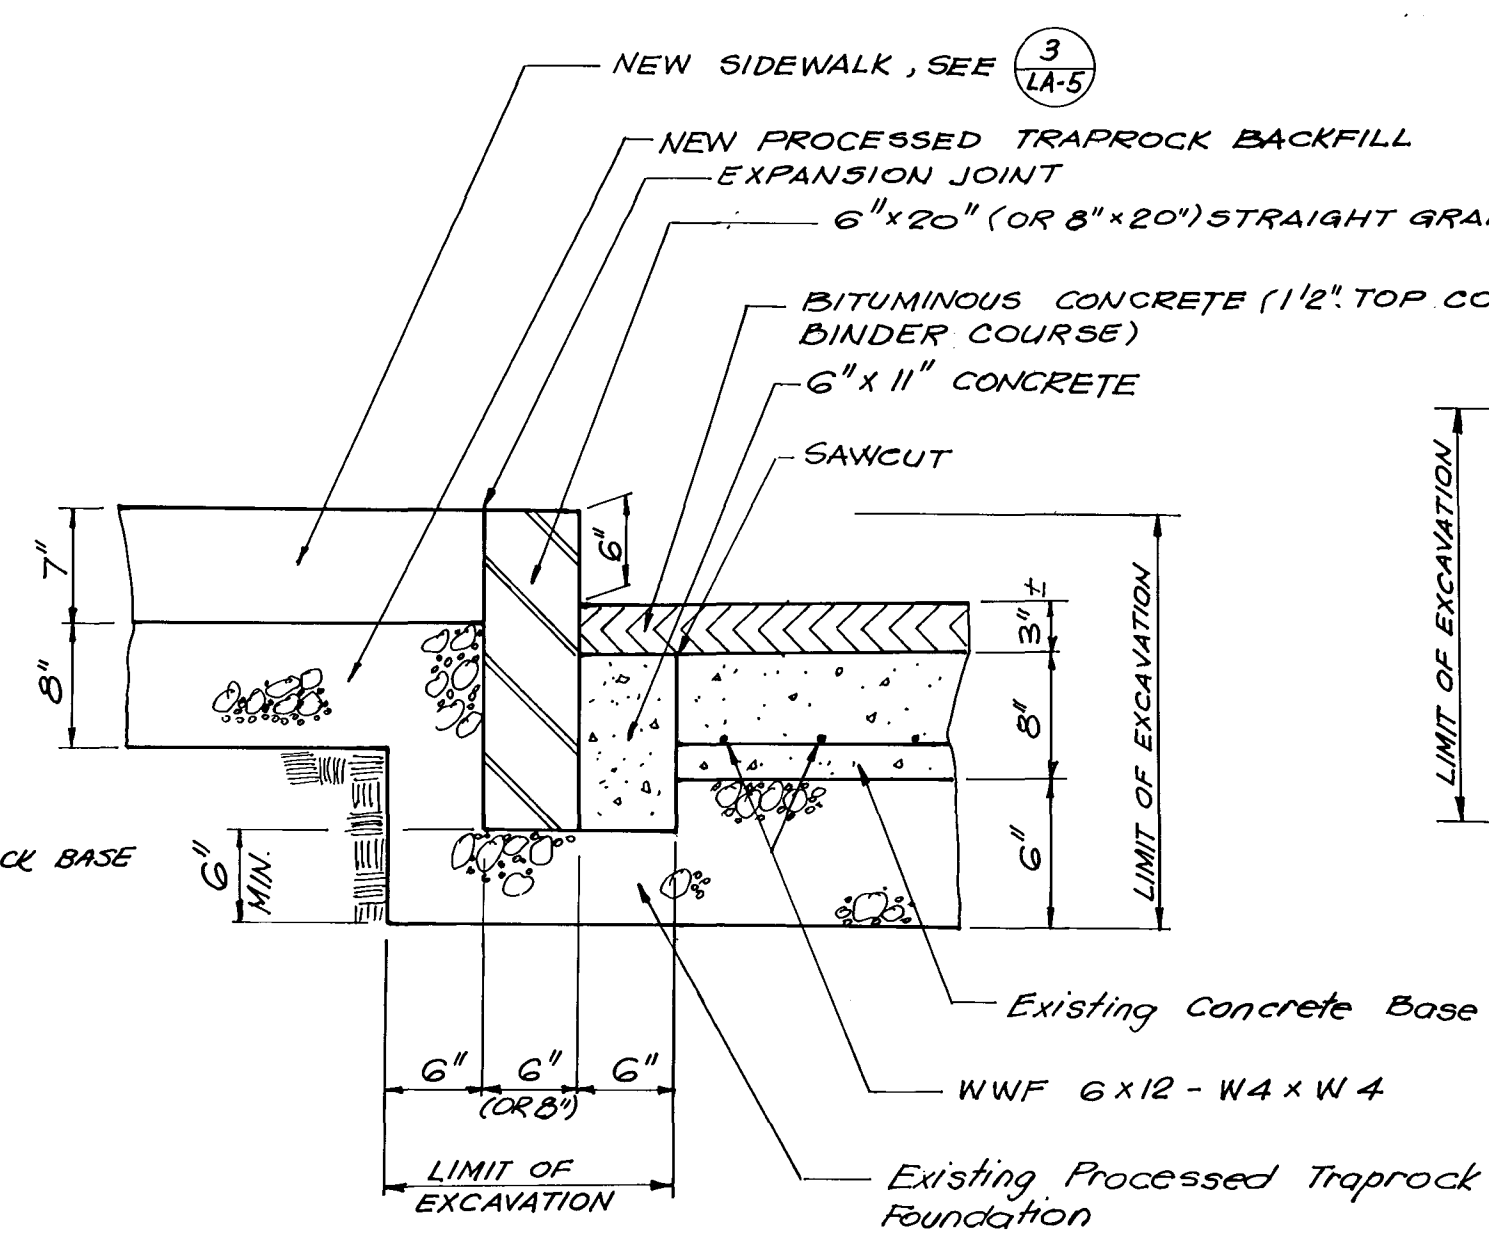

2
C-6 RESET STRAIGHT GRANITE CURB ON EXISTING FOUNDATION

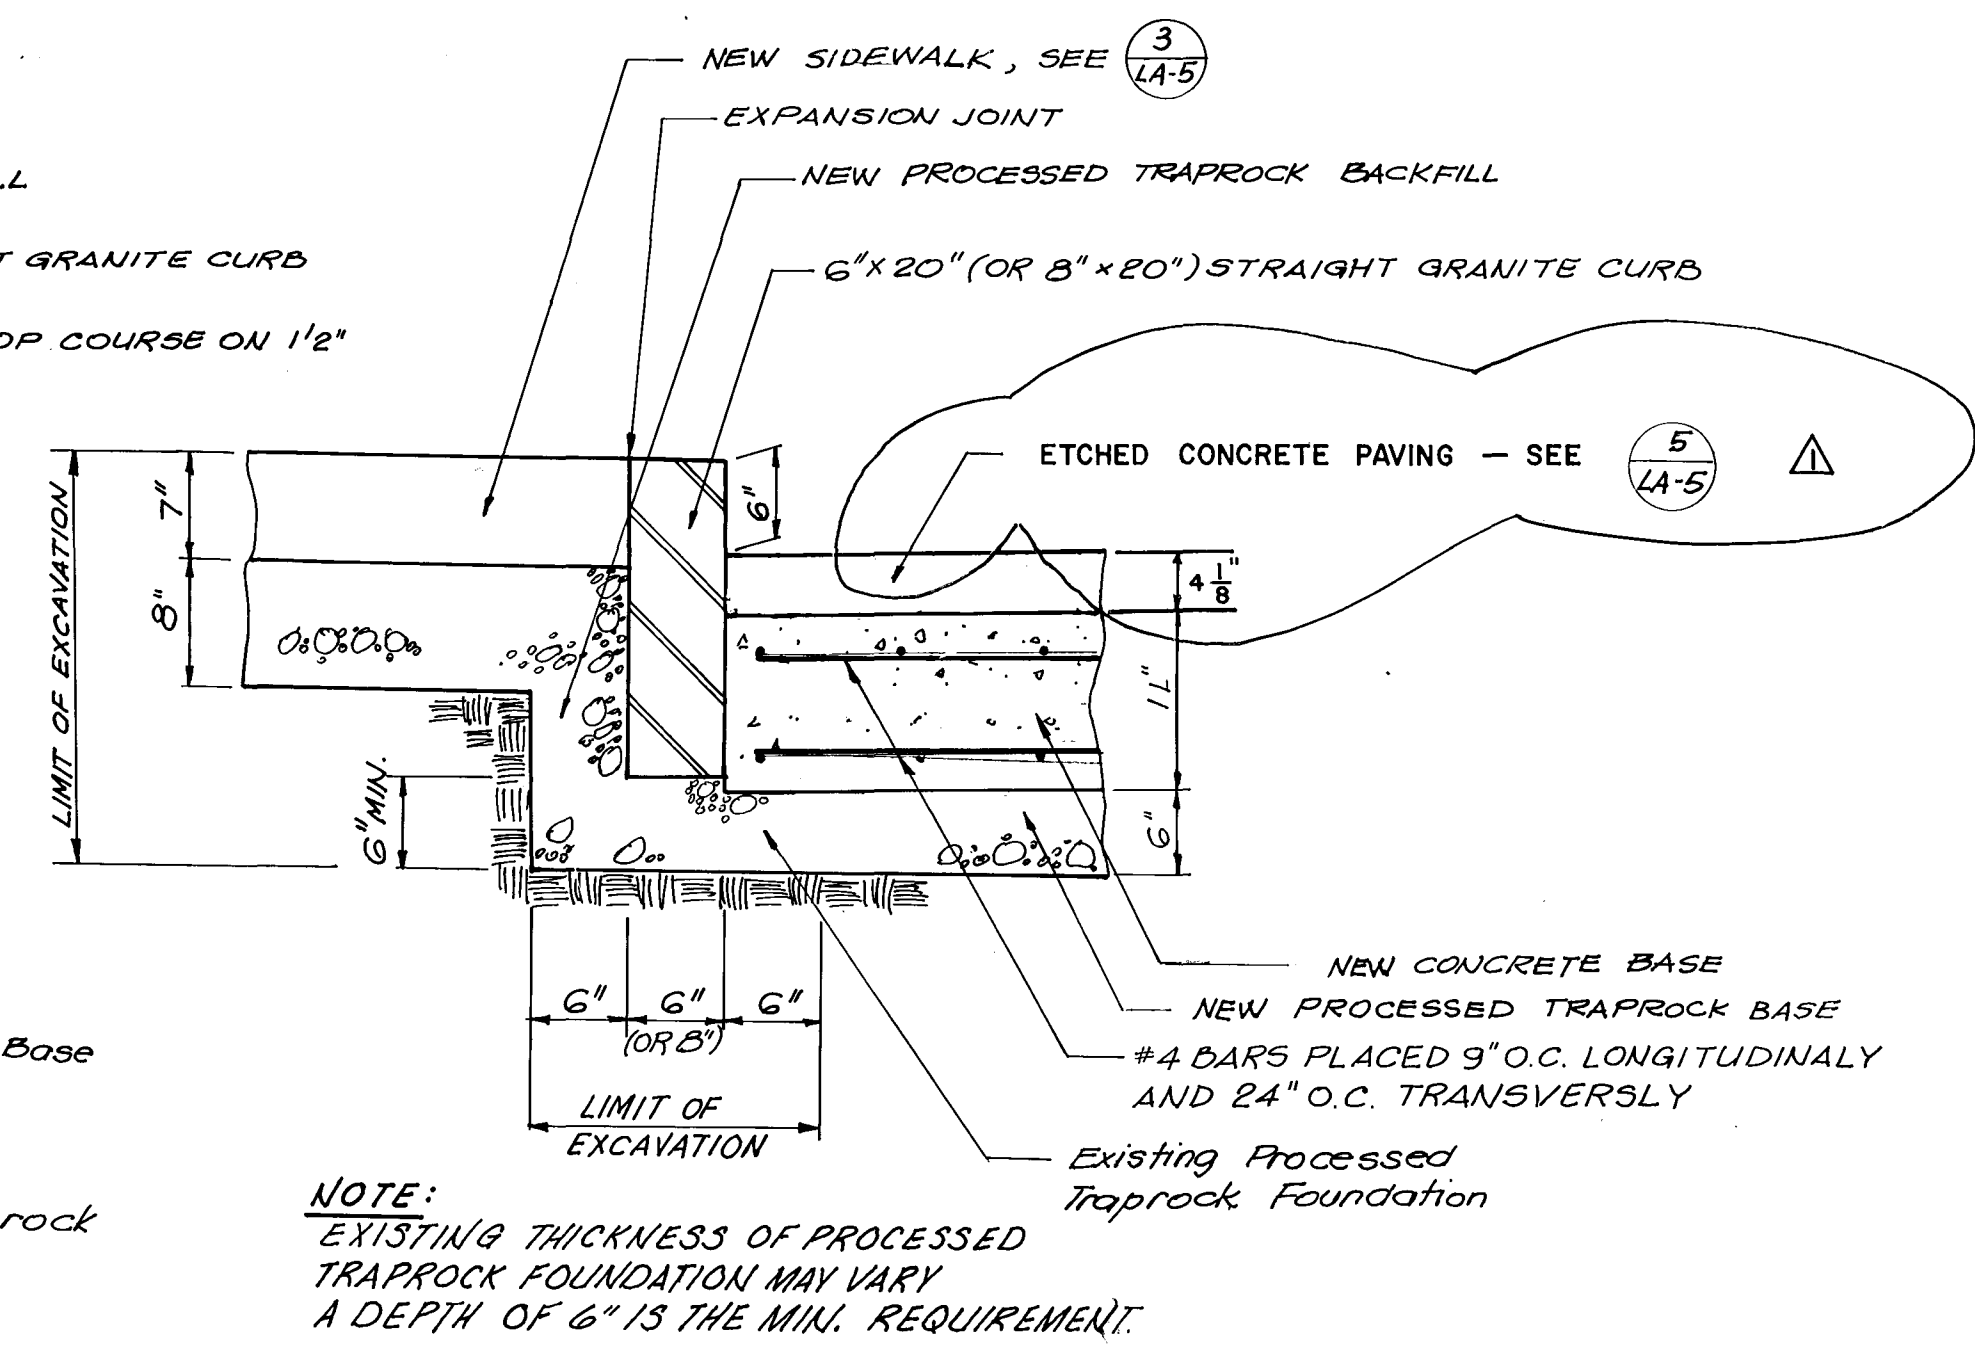


3
C-6 RESETTING OF STRAIGHT GRANITE CURB ON EXISTING FOUNDATION IN FRONT OF BUS LANE

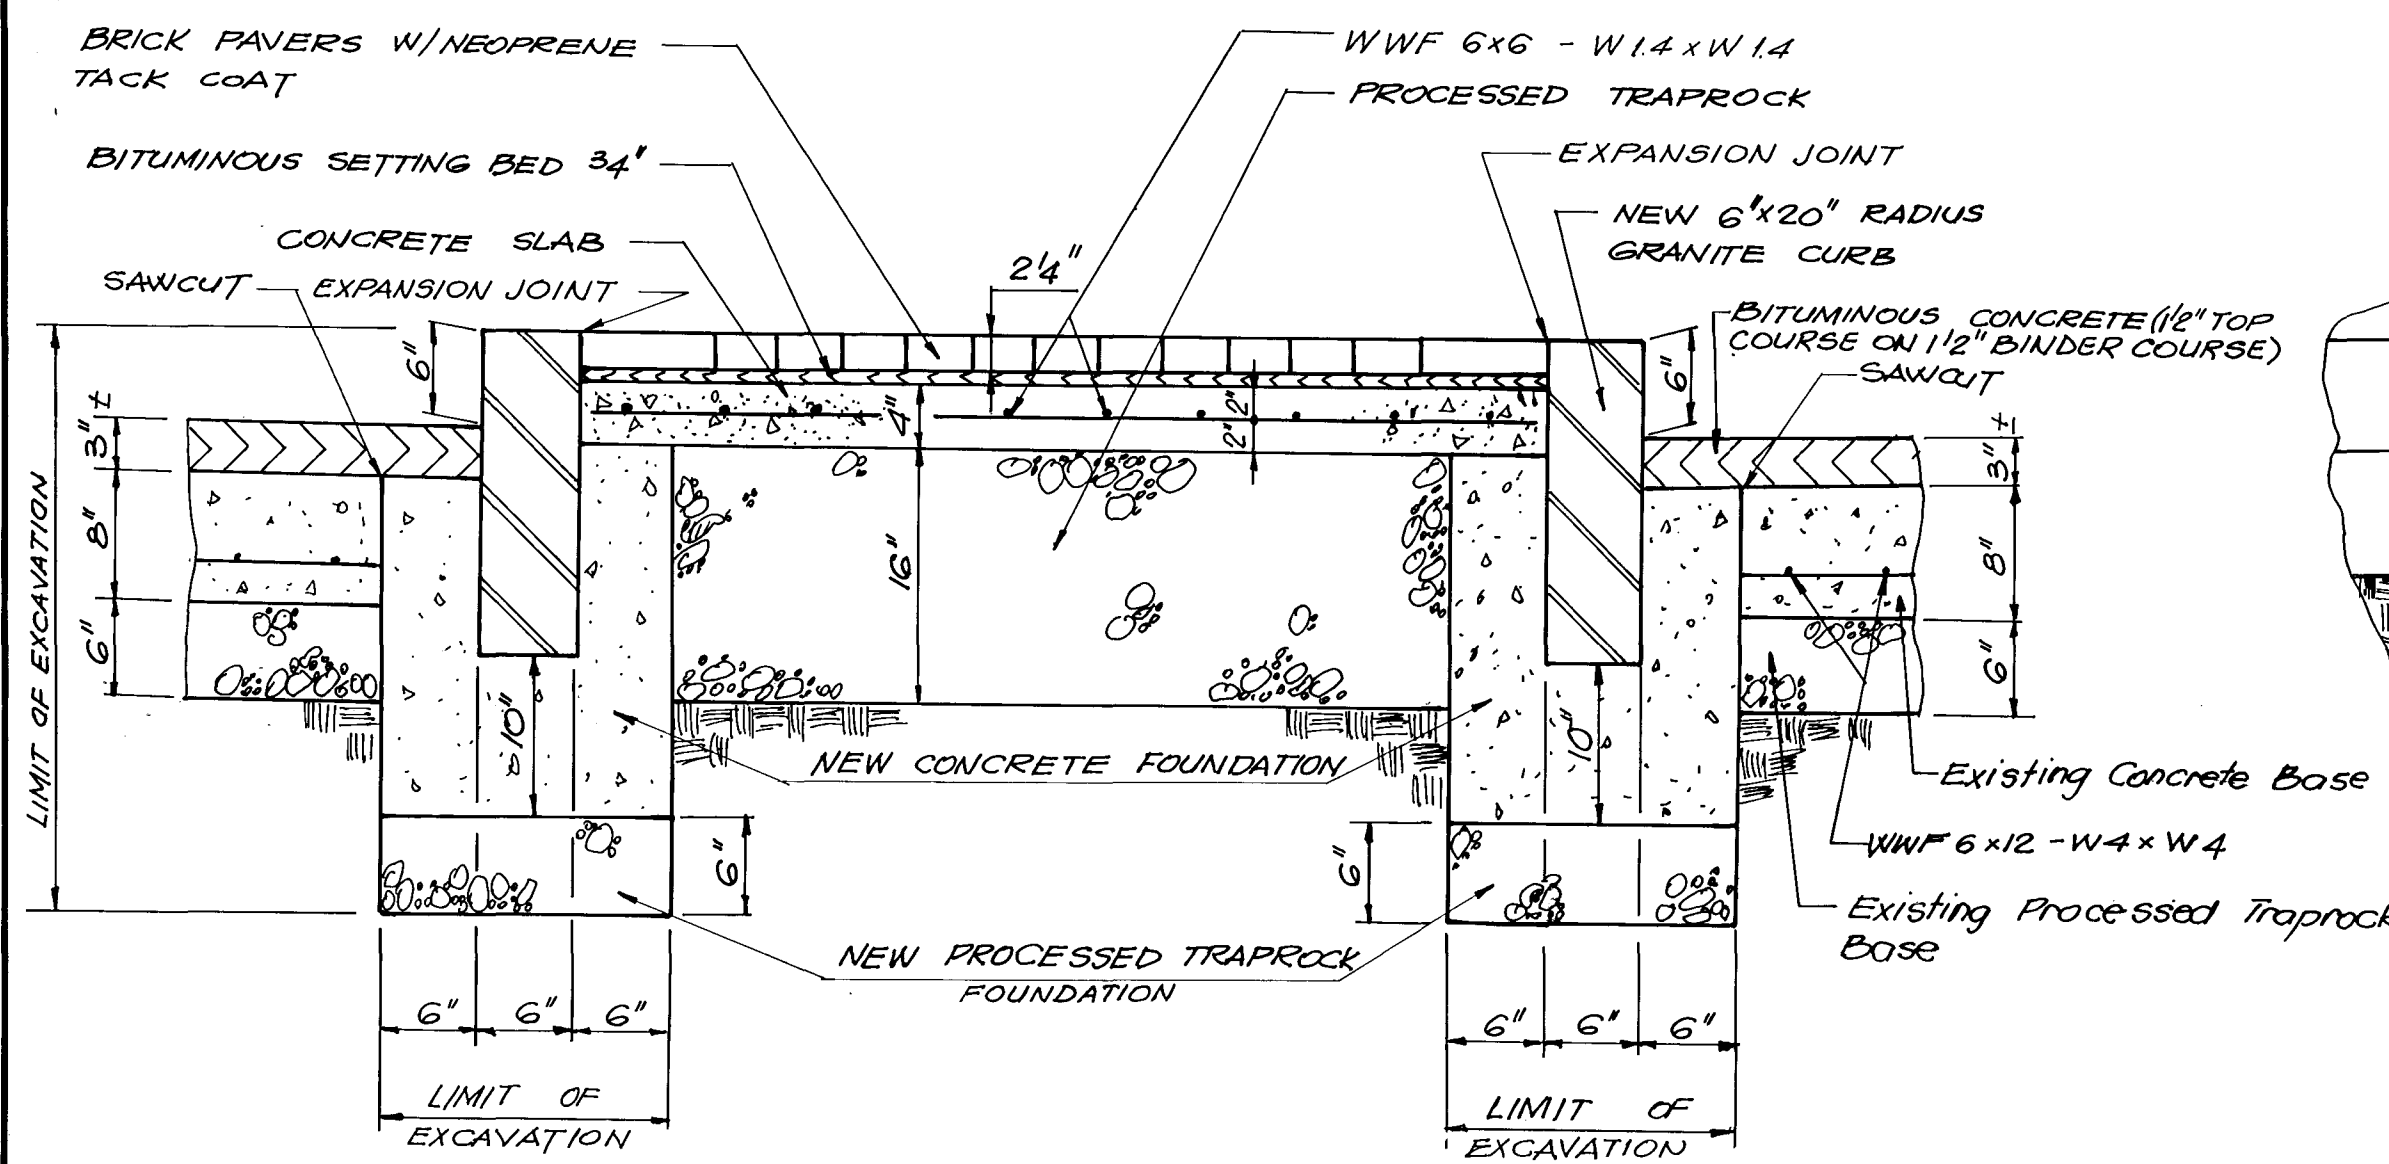


4
C-6 NEW RADIUS GRANITE CURB AT ISLAND ON AMERICAN ROW


NOTE:
TYPICAL FOR BOTH ISLANDS ON AMERICAN ROW.

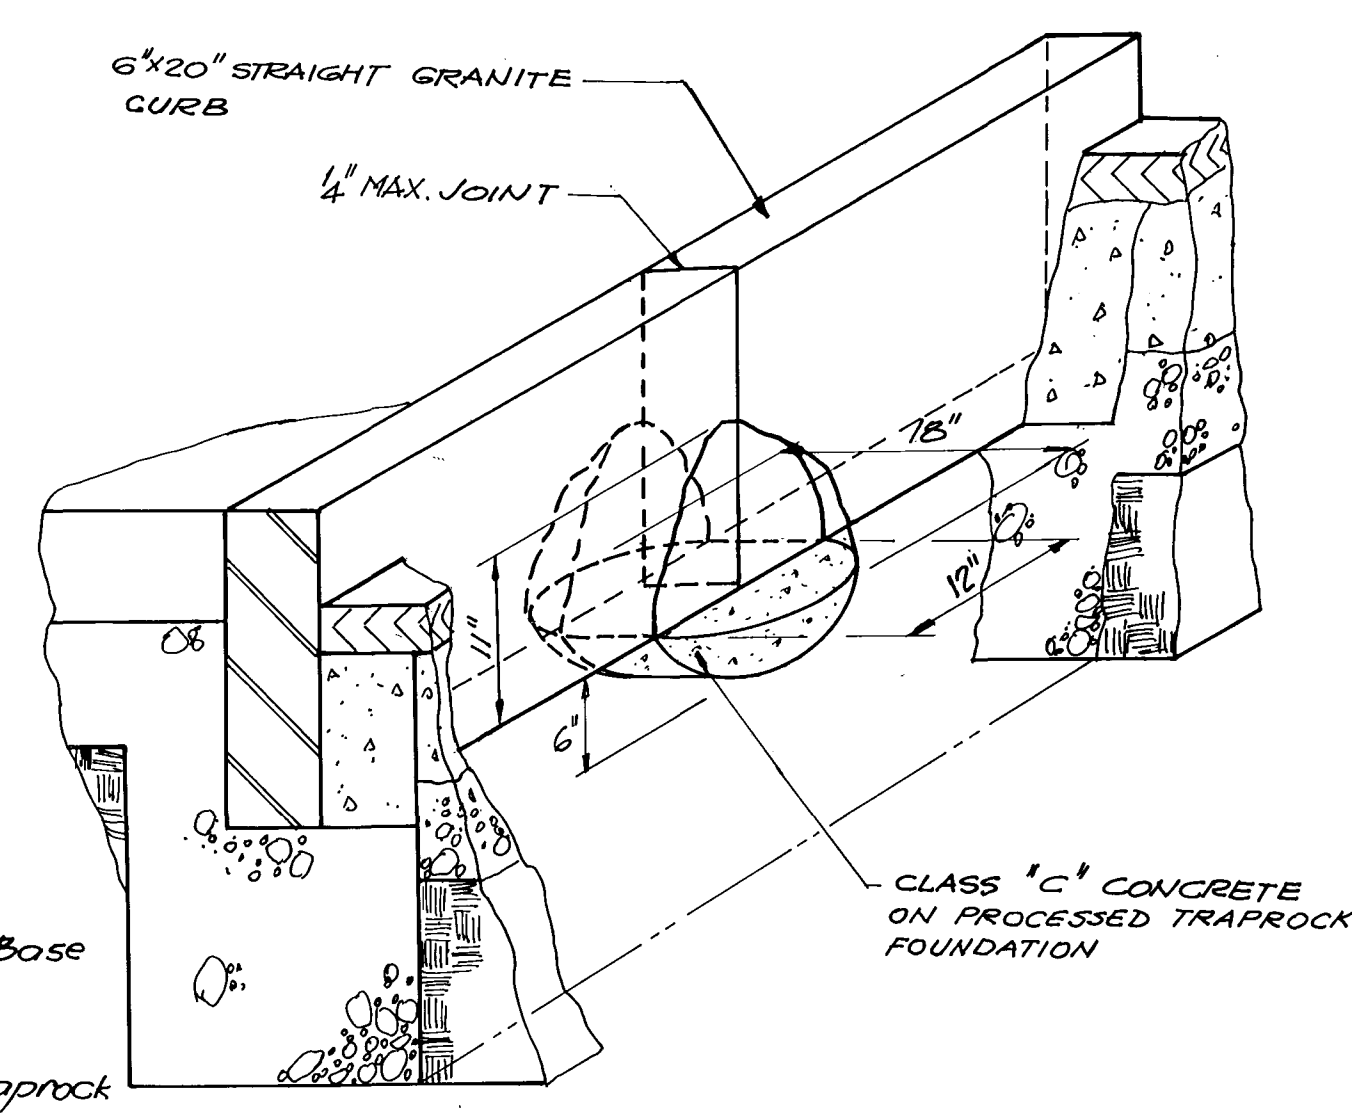

5
C-6 CLASS "C" CONCRETE AT CURB JOINT

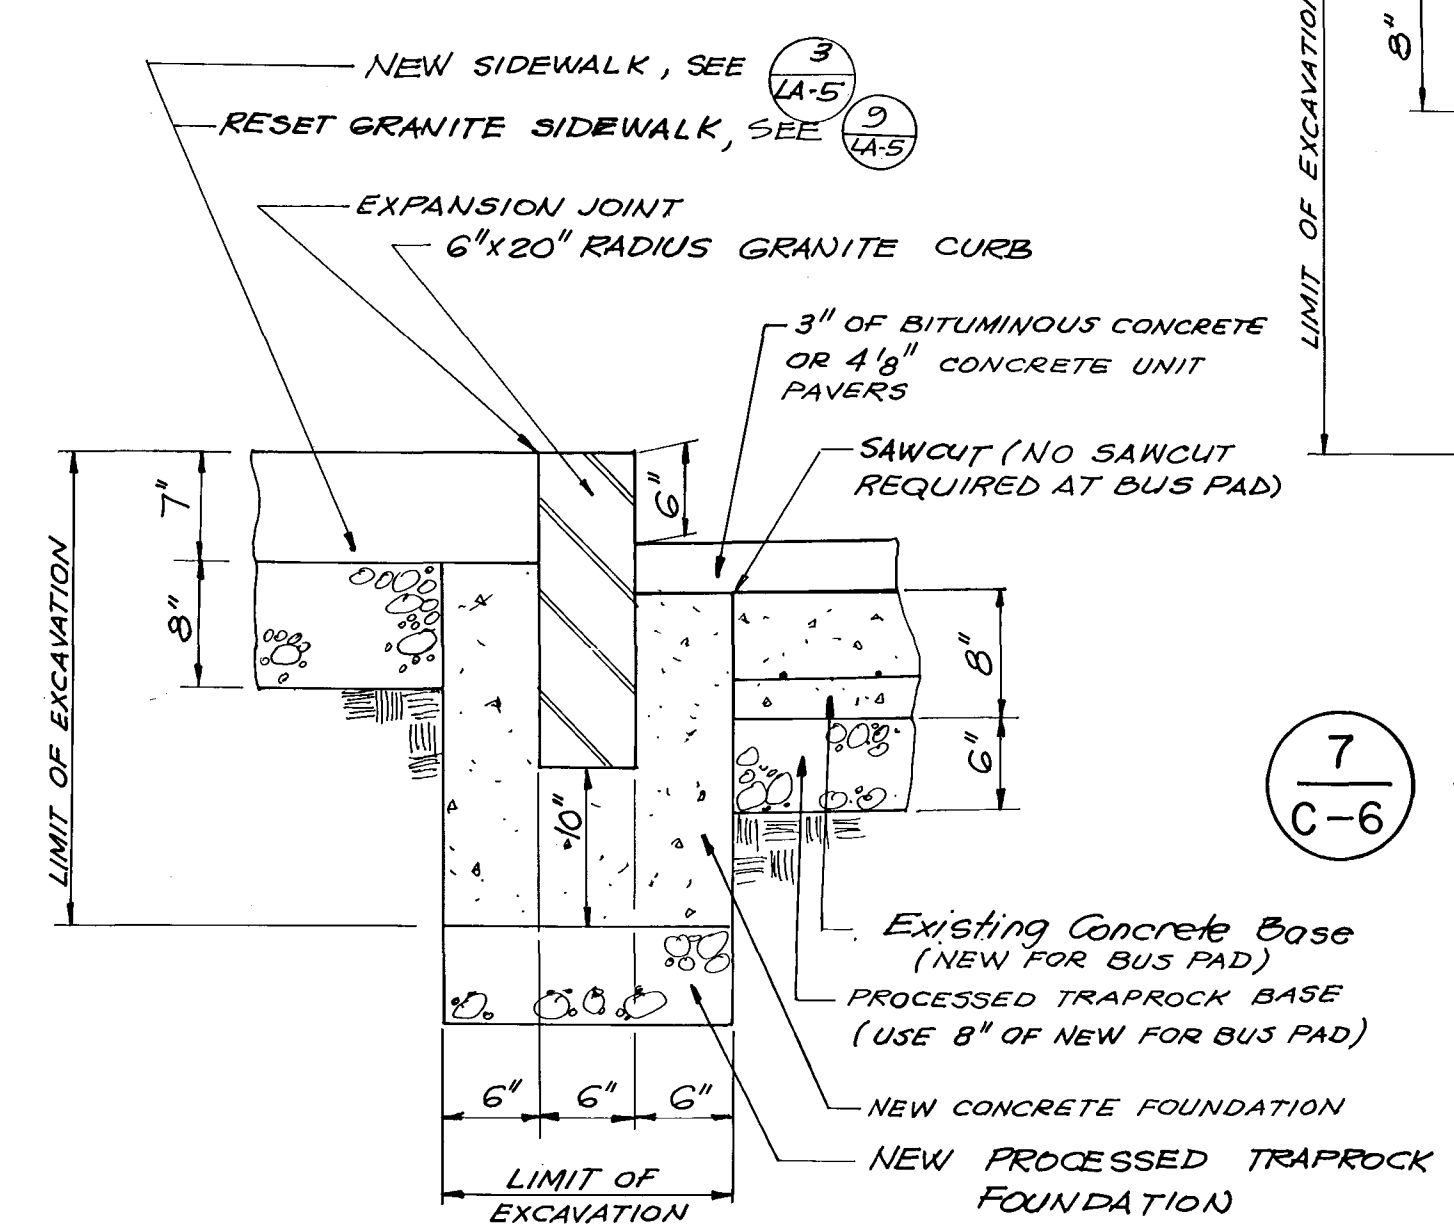

6
C-6 NEW RADIUS GRANITE CURB

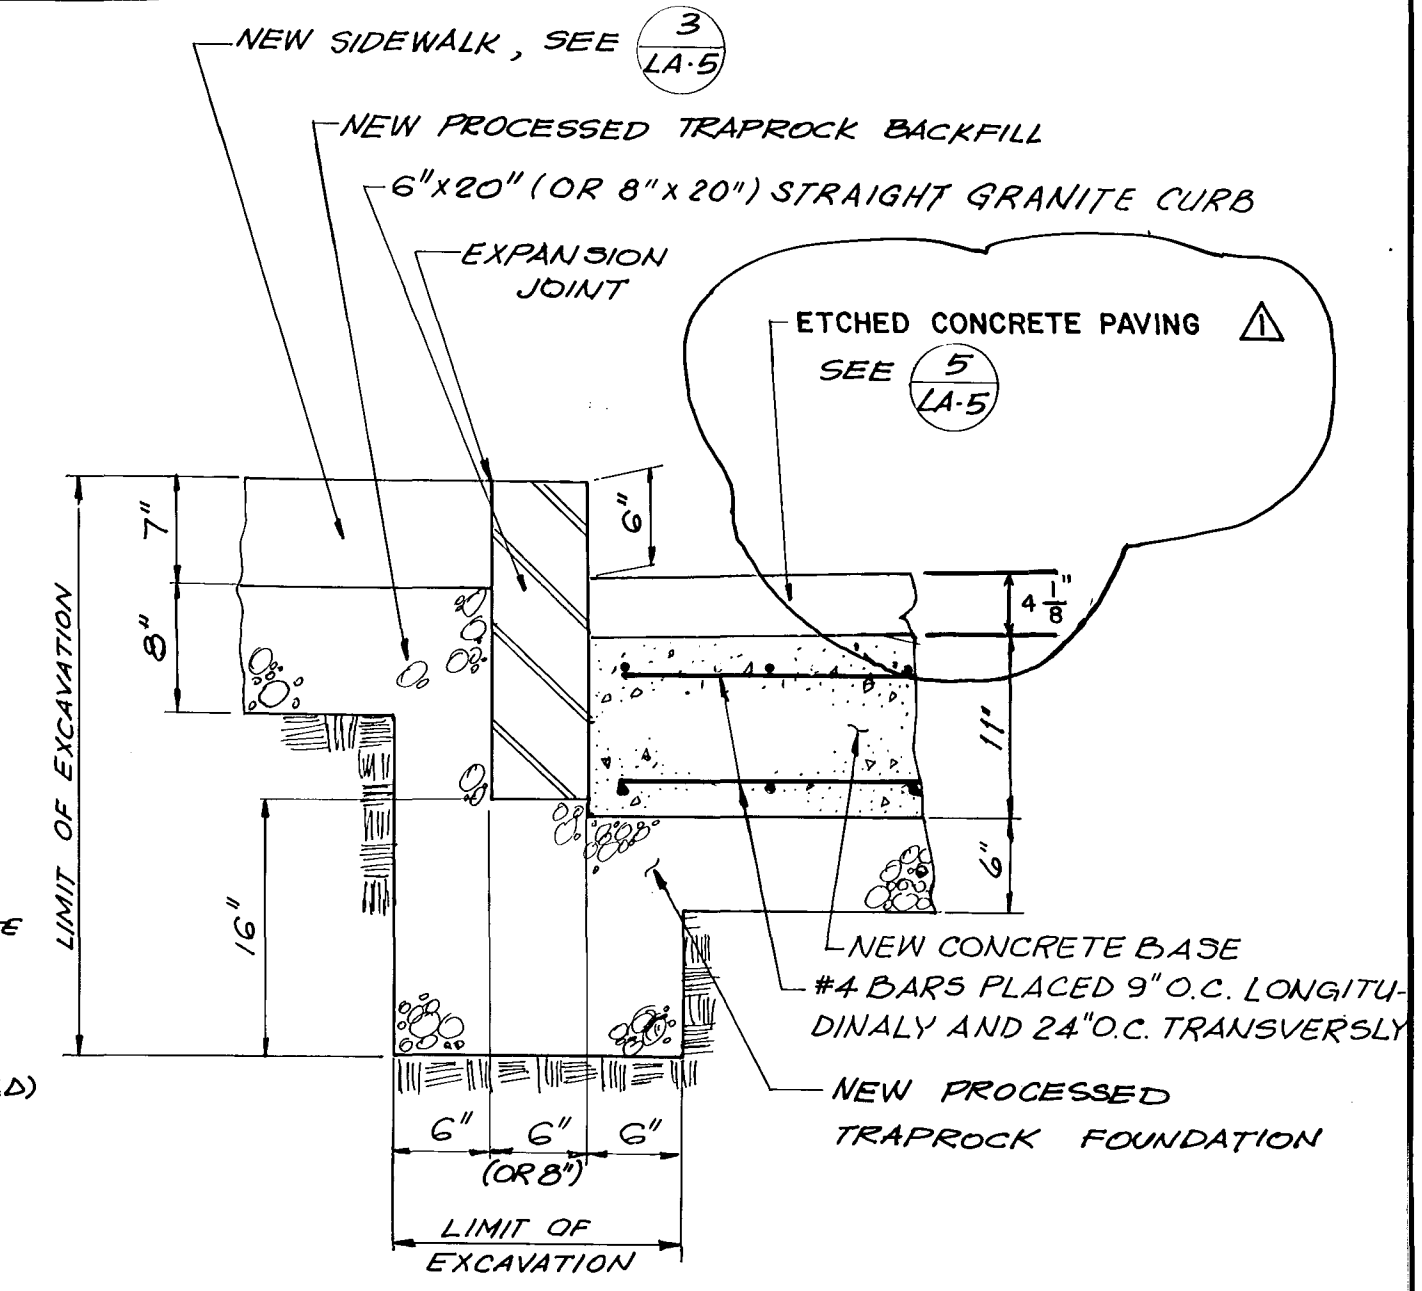

7
C-6 NEW STRAIGHT GRANITE CURB ON NEW FOUNDATION IN FRONT OF BUS LANE

SUPPLEMENTAL INFORMATION		
CITY OF HARTFORD, CONNECTICUT DEPARTMENT OF PUBLIC WORKS BUREAU OF ENGINEERING SERVICES		
HARTFORD PEDESTRIAN TRANSIT PROJECT		
CONSTRUCTION DETAILS		
SUBMITTED	RECOMMENDED	APPROVED
PROJECT ENGINEER	DIVISION MANAGER	CITY ENGINEER, ESB
DRAWN	SCALE	DAYBOOK NO.
CHECKED		DATE

2/28/90			
REVISION	MADE BY	CHECKED BY	DESCRIPTION

SHEET NO. C-6.1

603/56