




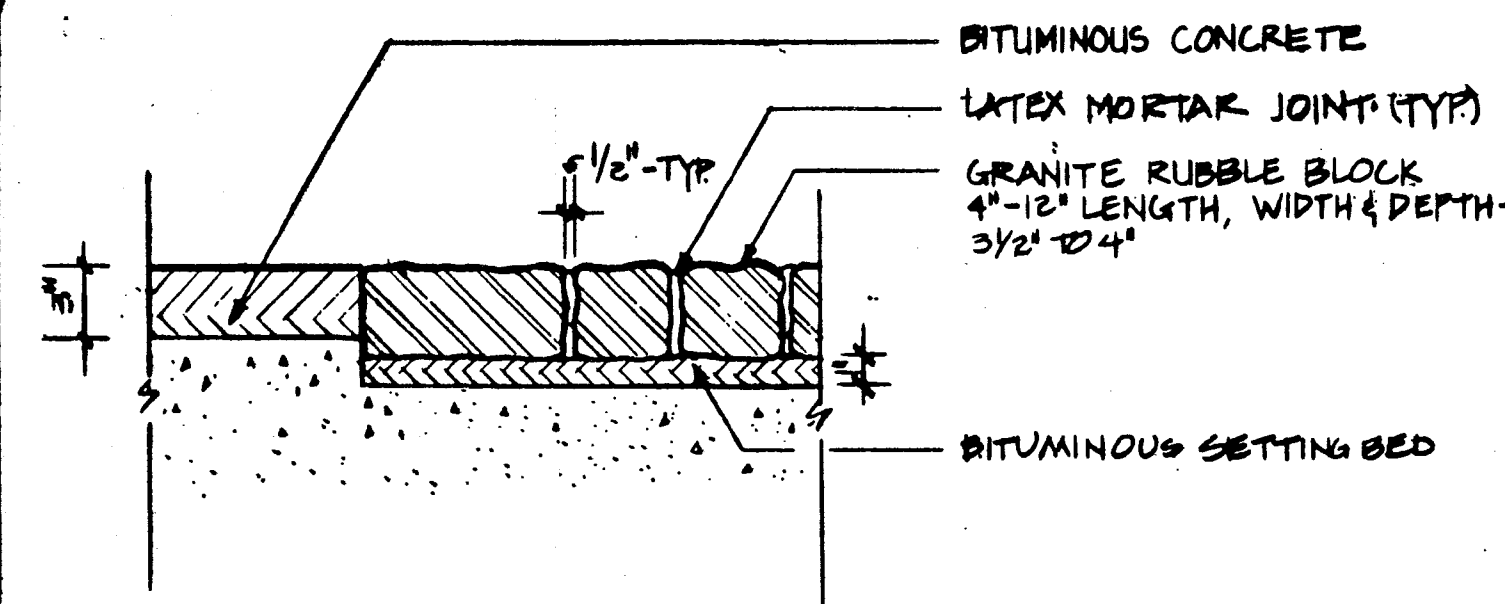

1 GRANITE COBBLE @ FLUSH ROADWAY MEDIAN
SCALE: 1/2" = 1'-0"

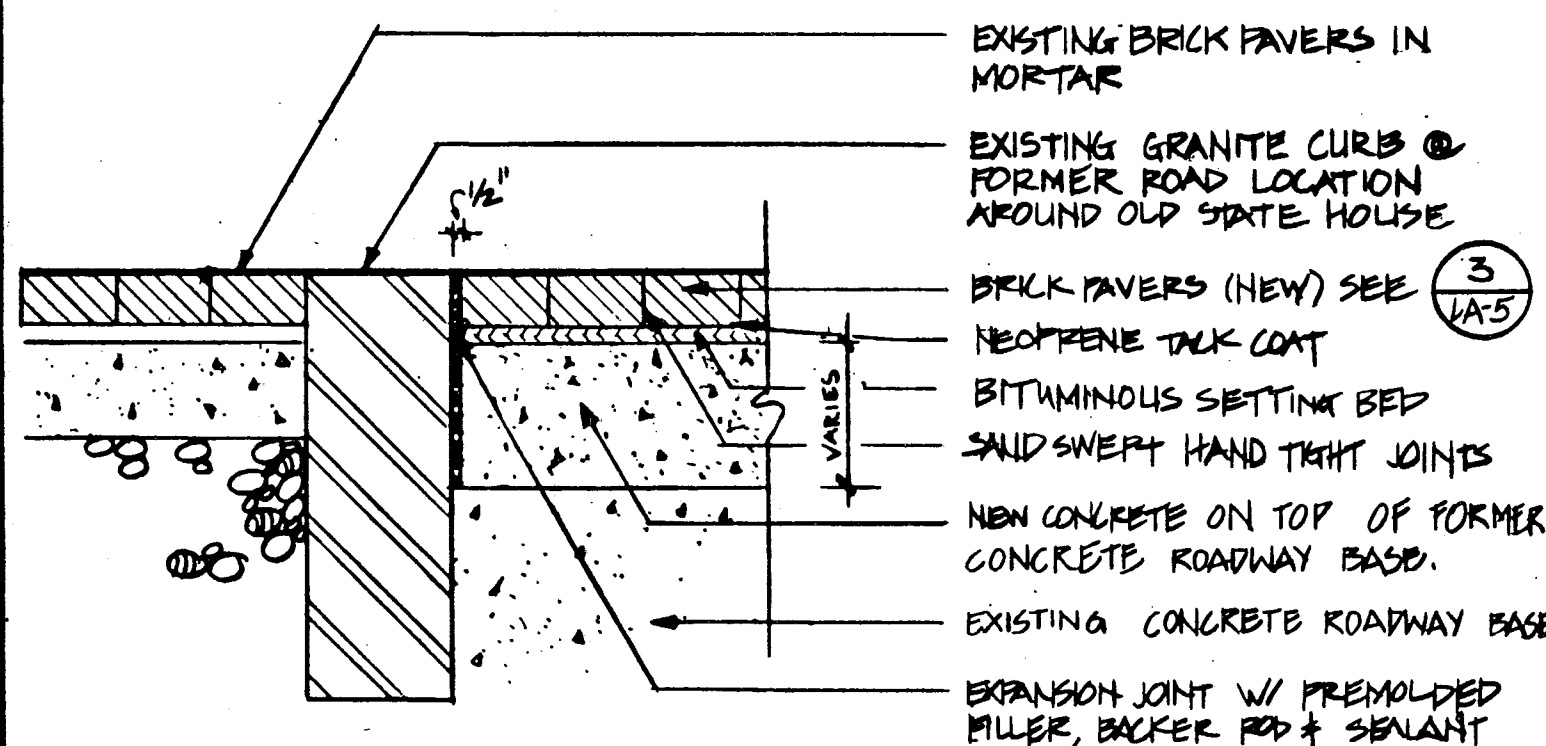


2 FLUSH CURB INTERFACE AROUND BRICK IN MORTAR WALK AT OLD STATE HOUSE
SCALE: 1" = 1'-0"

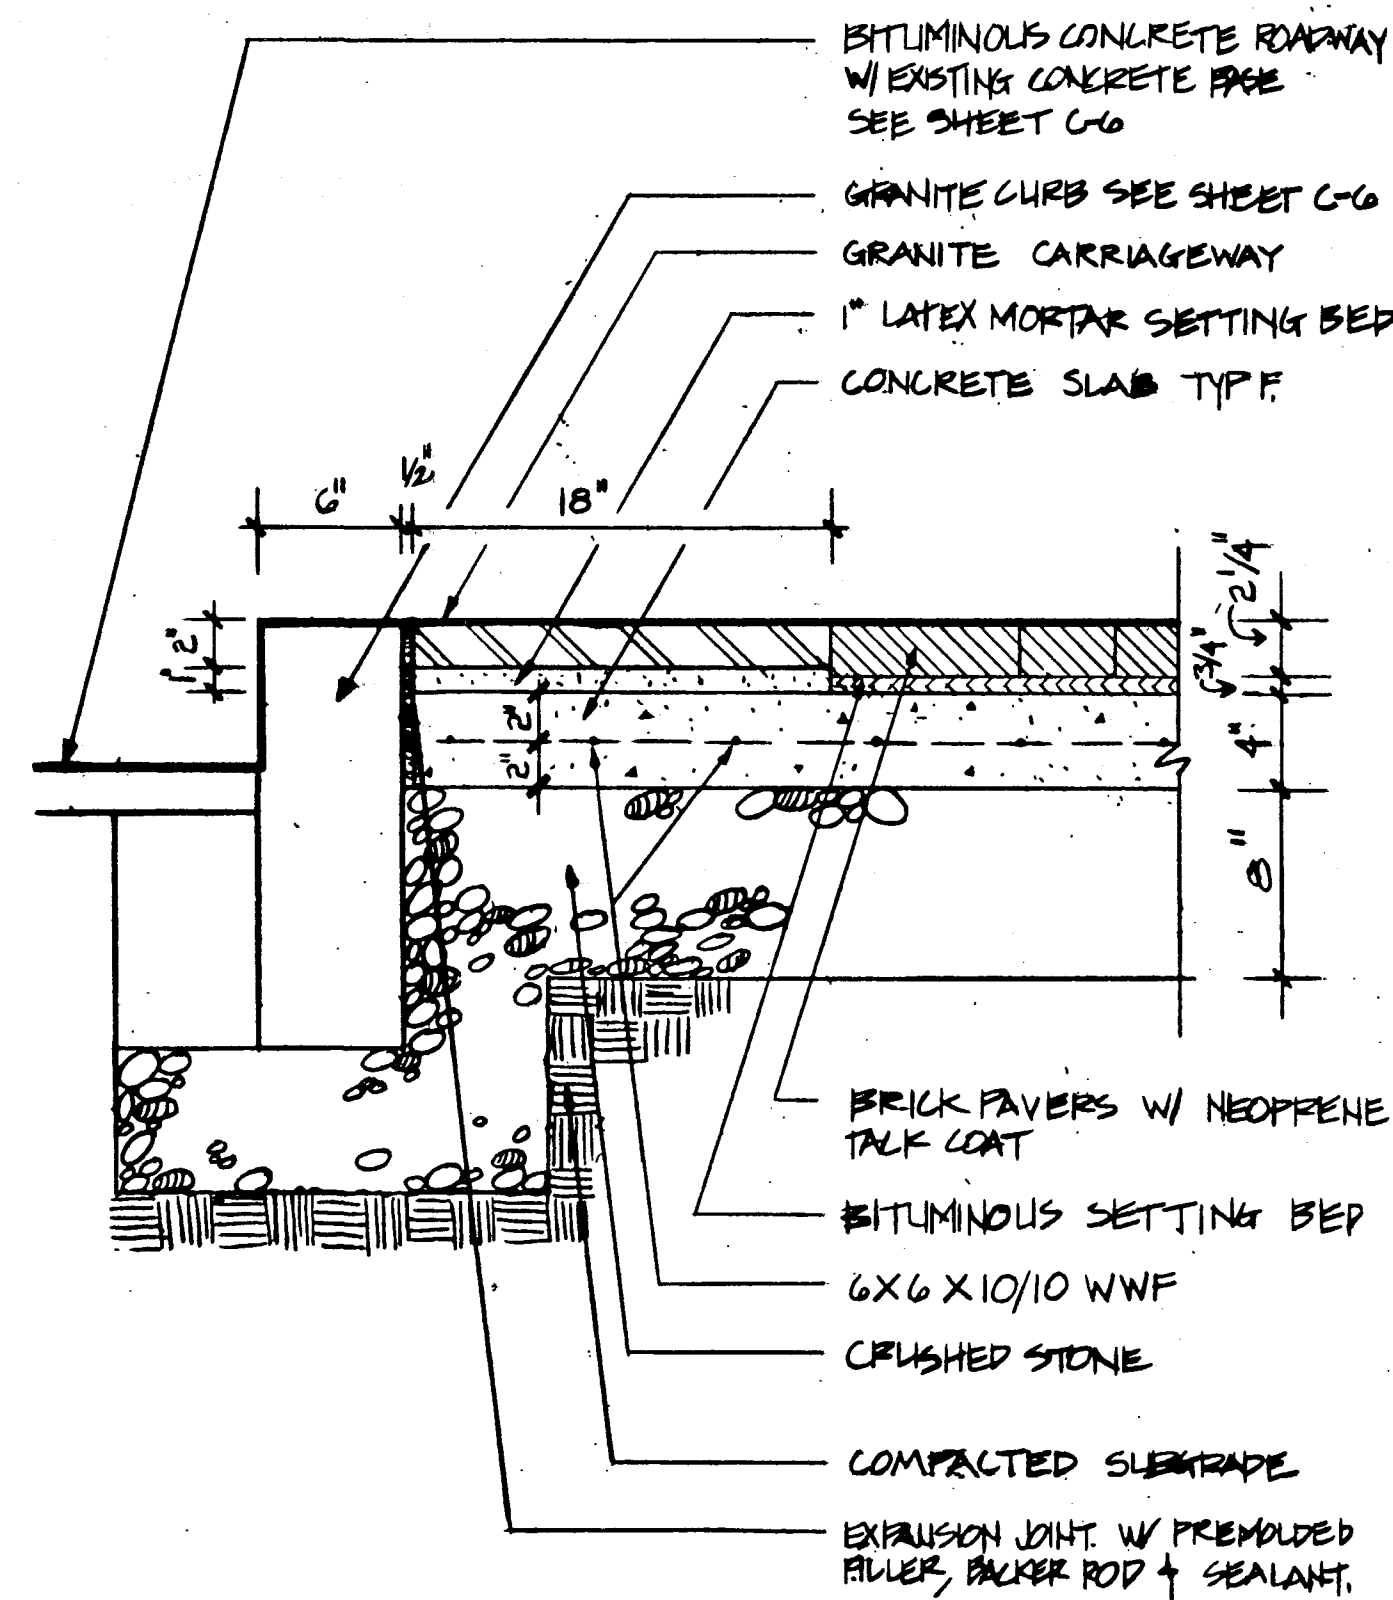


NOTE: SEE SHEET C-6, C-7 FOR LOCATIONS OF UNDERGROUND VAULTS.


3 CARRIAGEWAY & NEW BRICK PAVERS
SCALE: 1/2" = 1'-0"

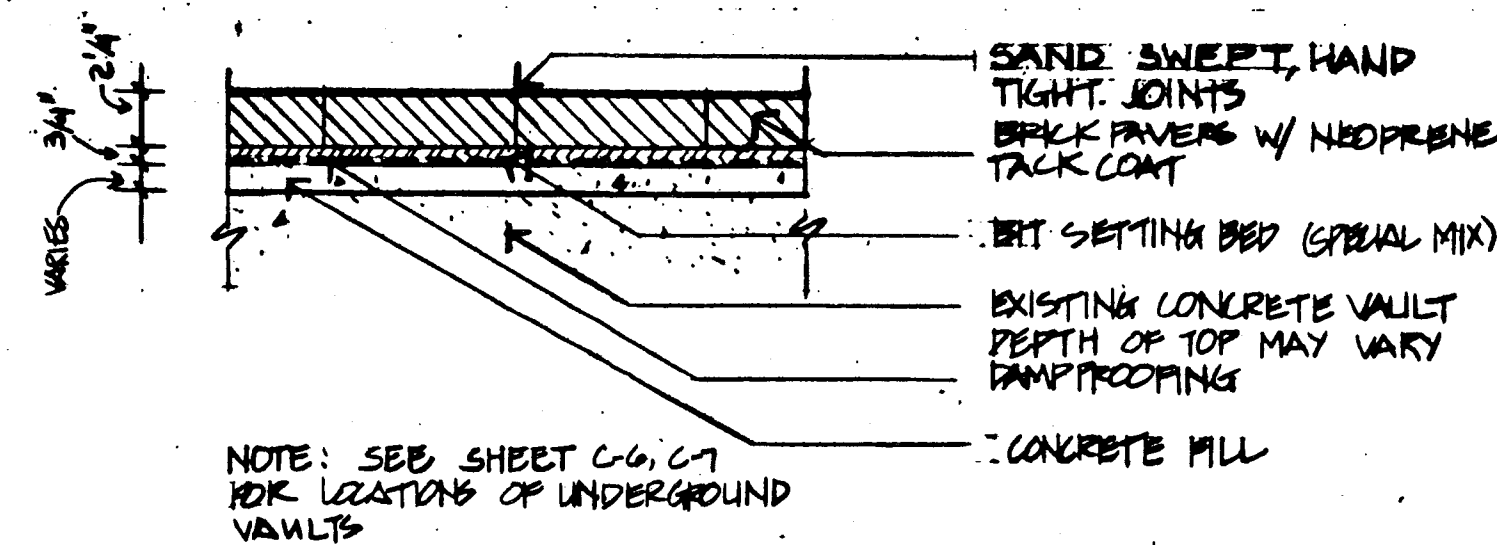


4 BRICK PAVERS OVER EXISTING SIDEWALK VAULTS
SCALE: 1 1/2" = 1'-0"

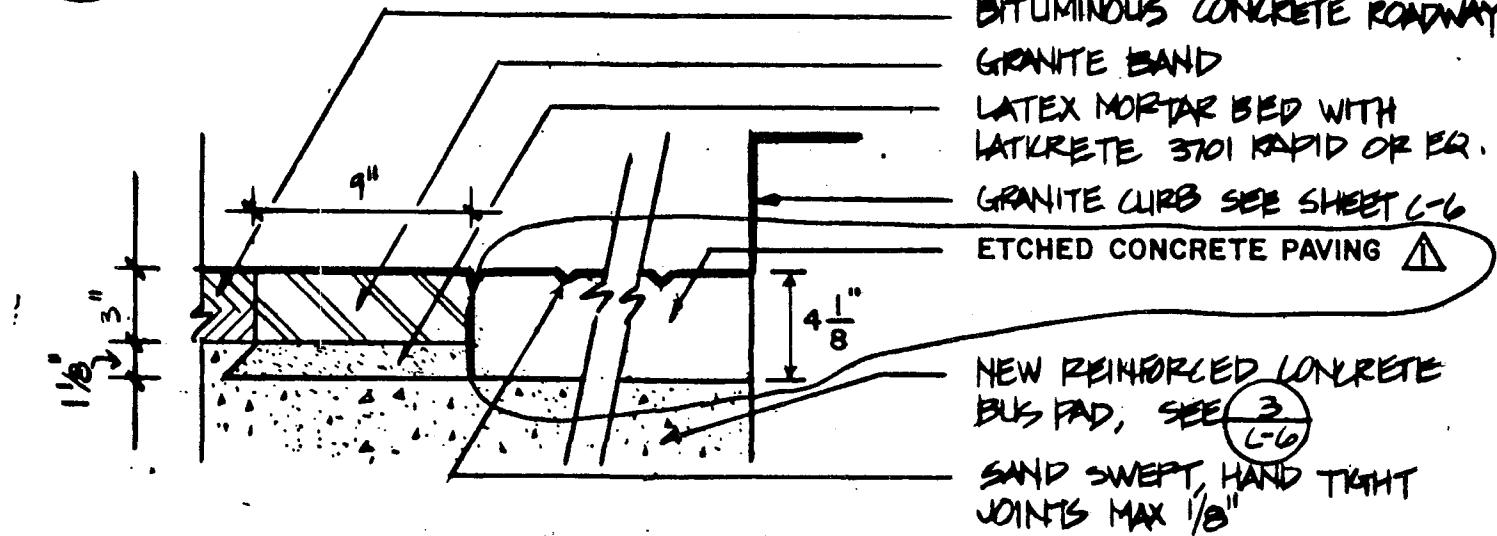


5 CONCRETE UNIT PAVERS @ BUS LANE
SCALE: 1 1/2" = 1'-0"

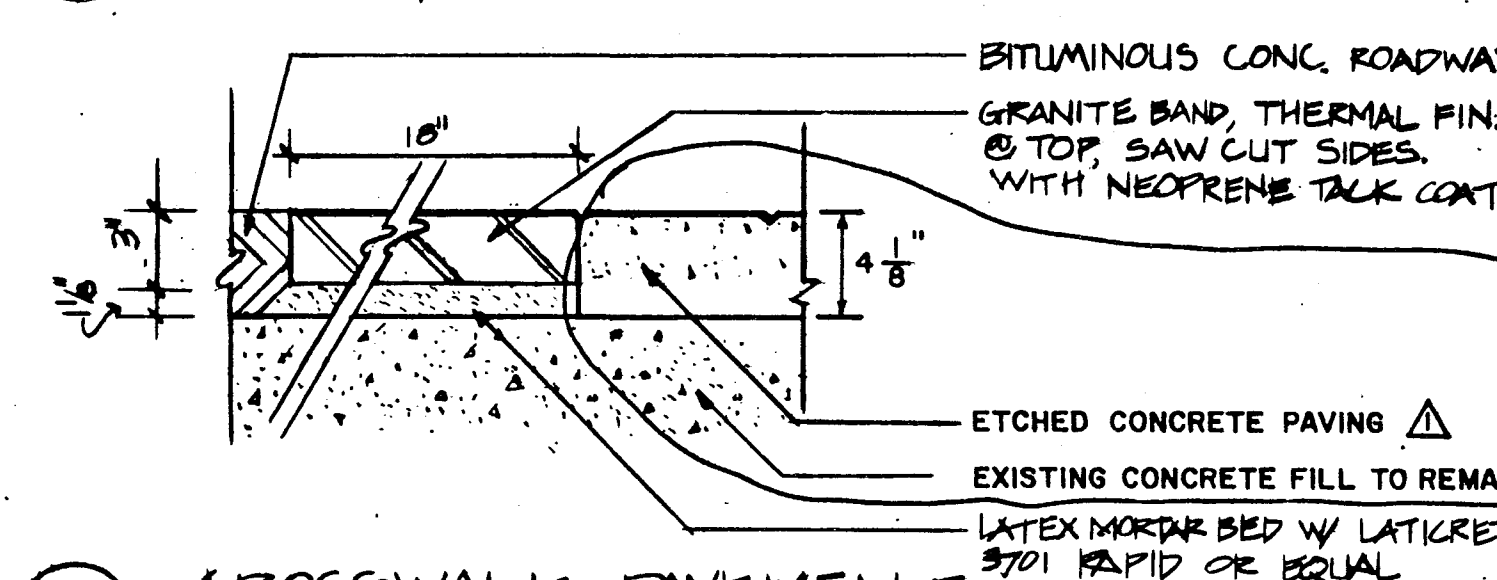


6 CROSSWALK PAVEMENT
SCALE: 1 1/2" = 1'-0"

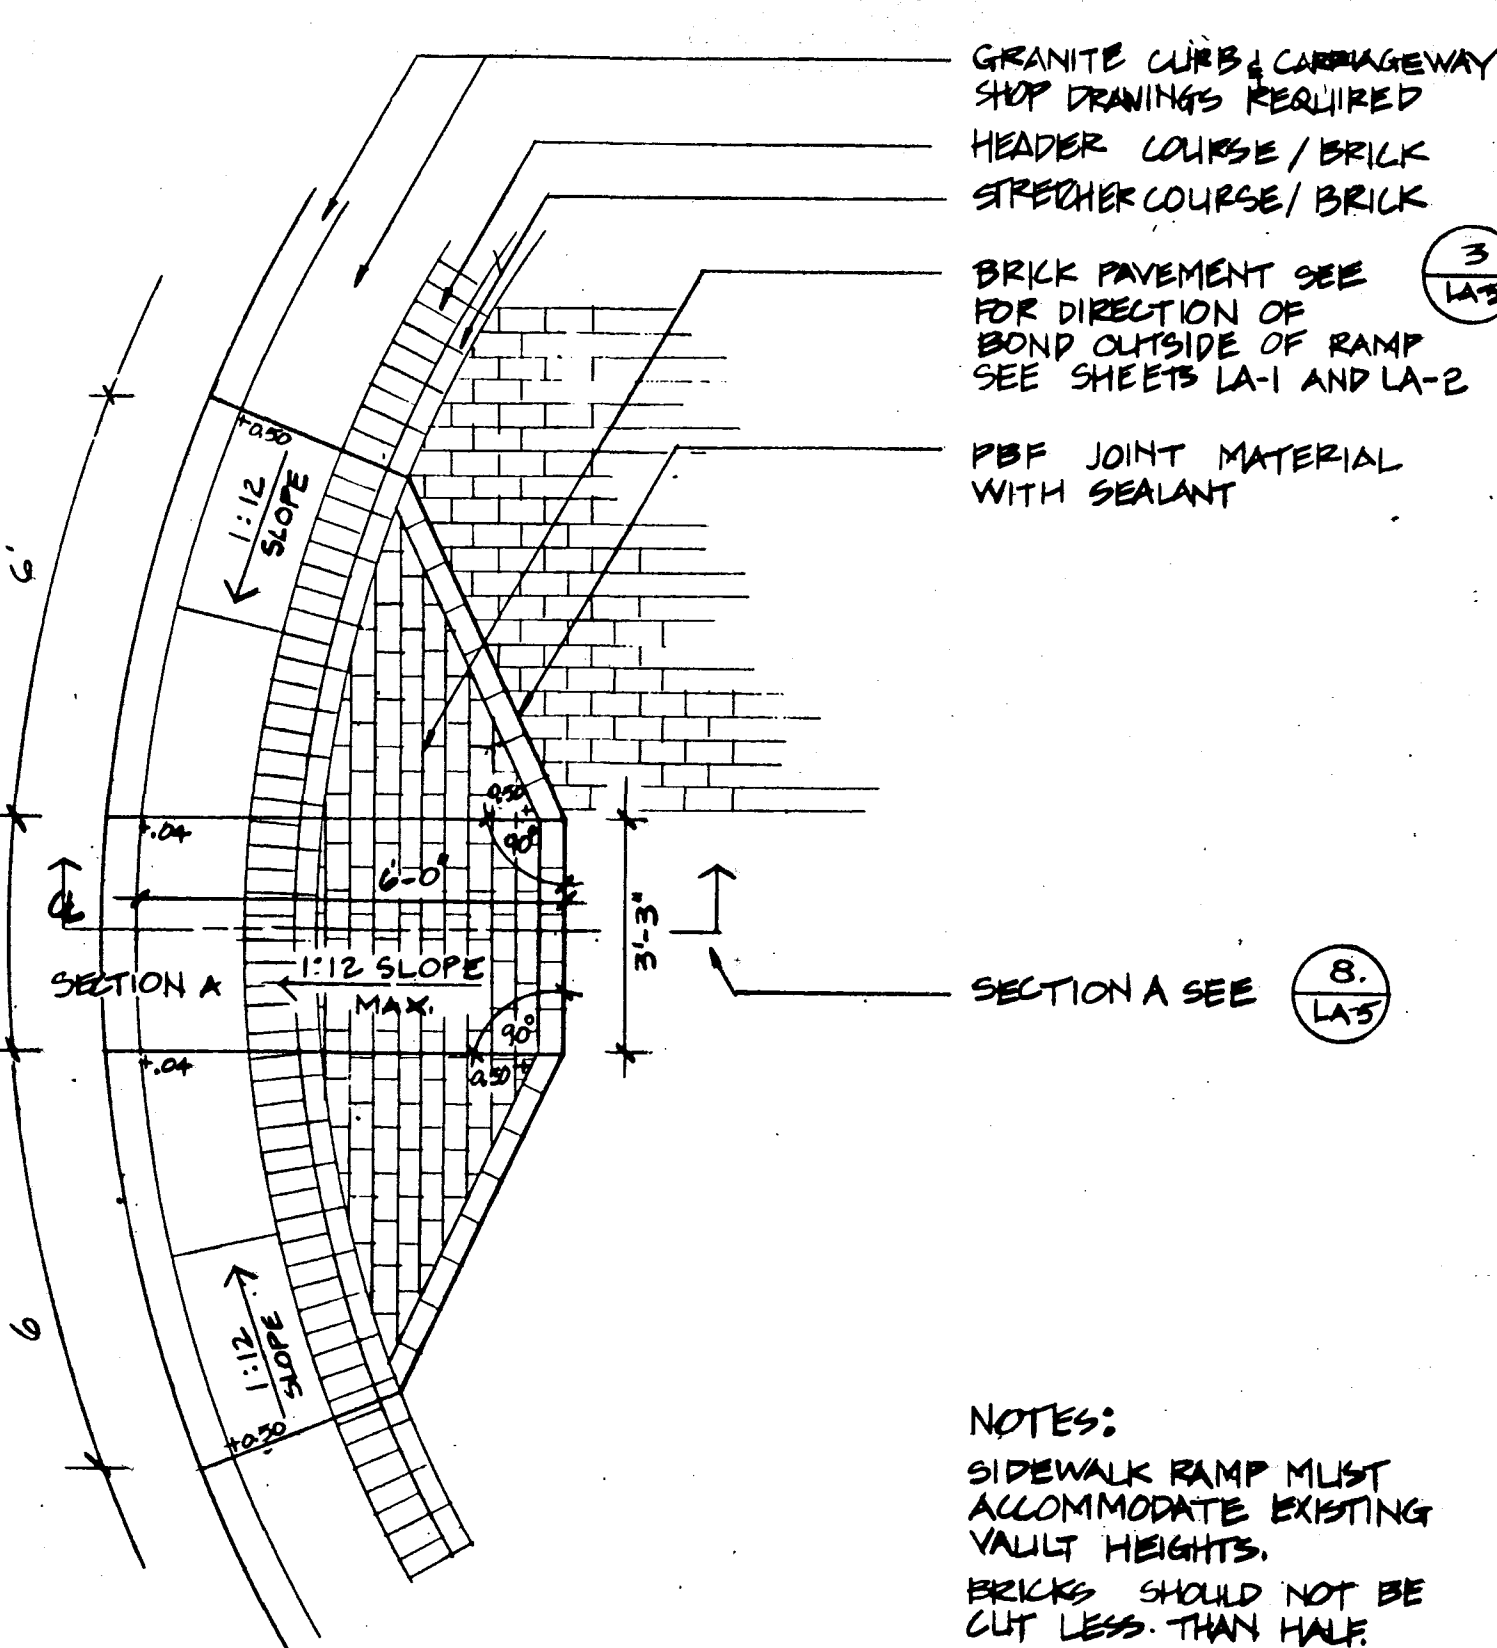


7 SIDEWALK RAMP
SCALE: 3/8" = 1'-0"

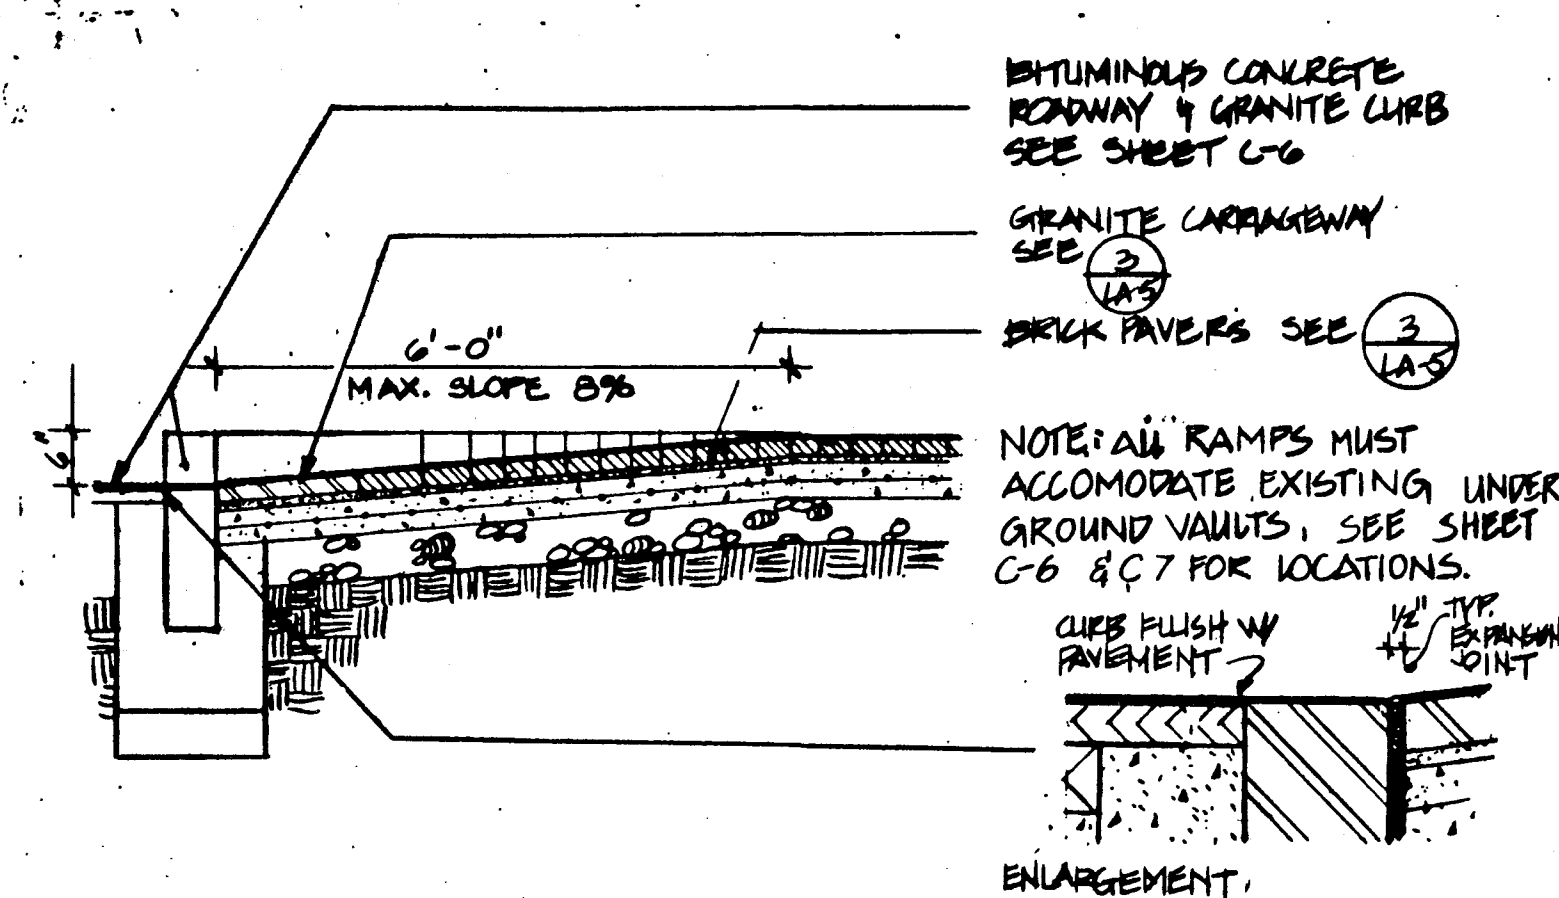


8 SIDEWALK RAMP SECTION A
SCALE: 1/2" = 1'-0"

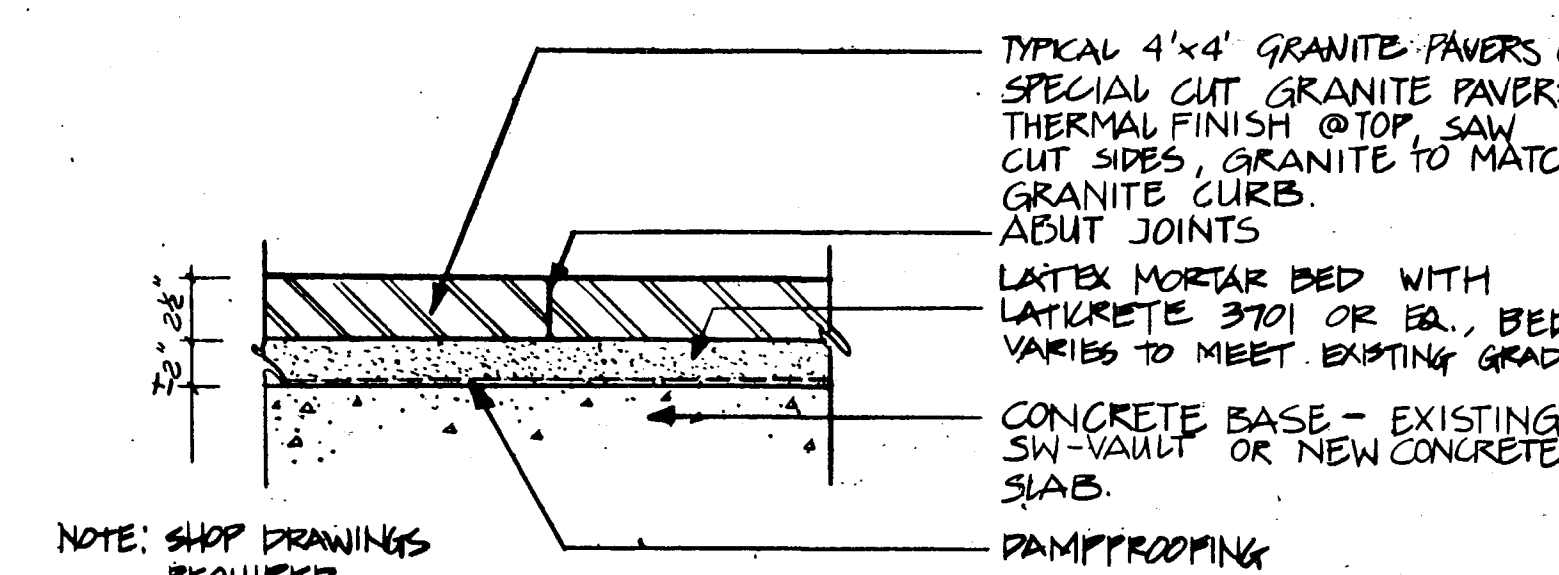


9 GRANITE PAVERS @ SIDEWALK MAIN STREET
SCALE: 1/2" = 1'-0"

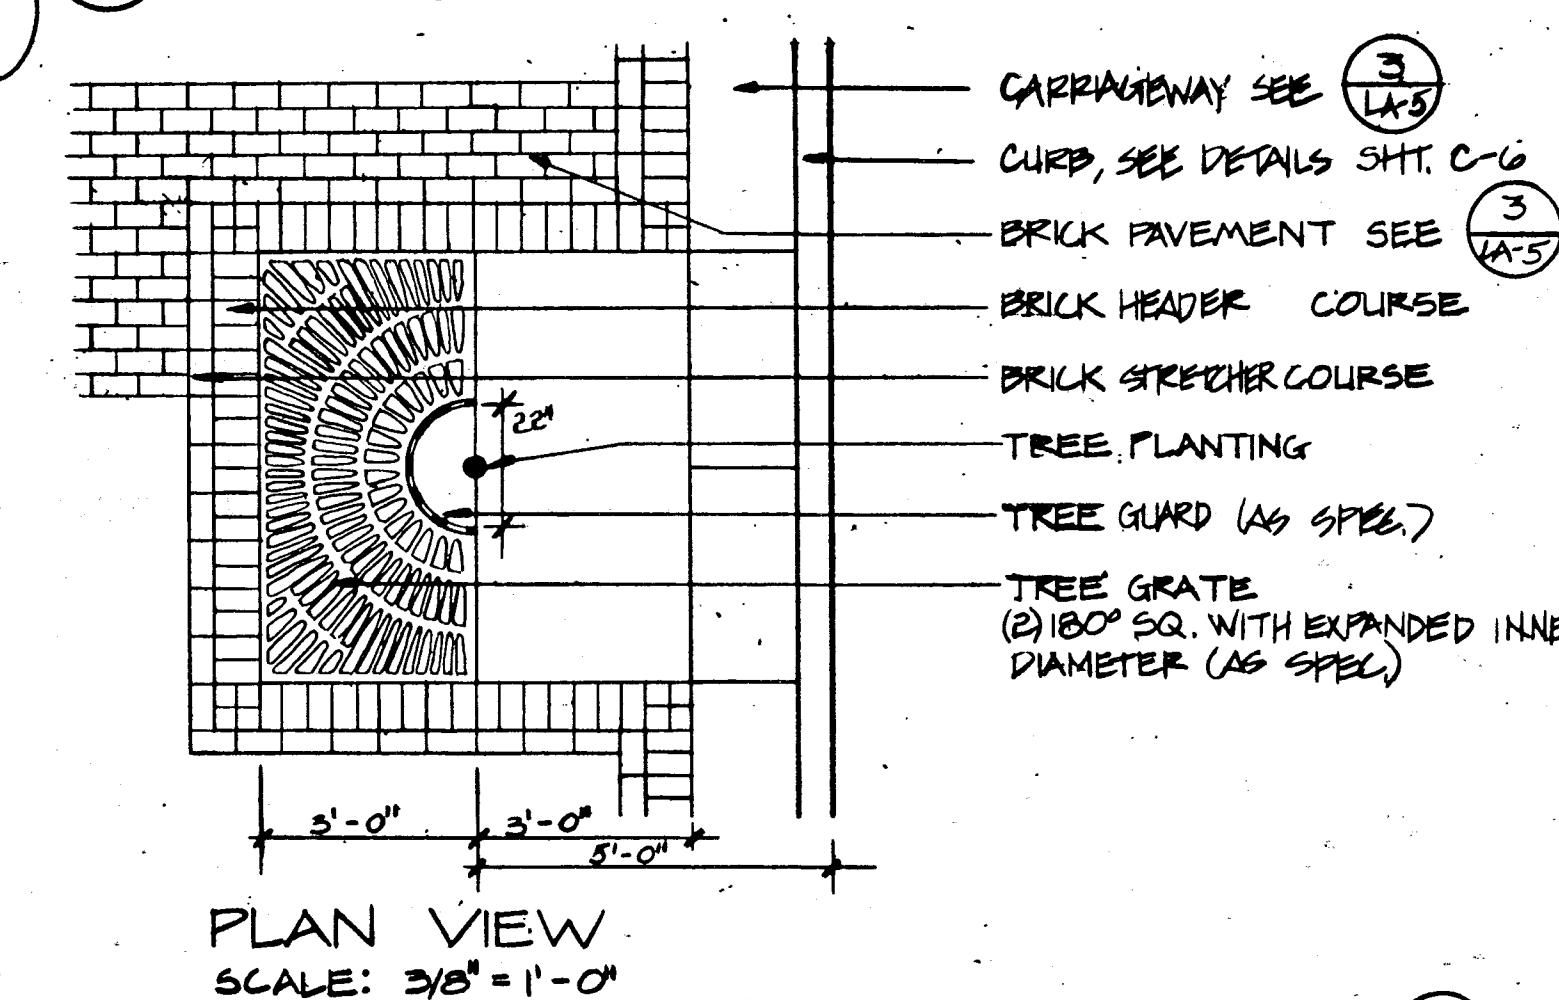


10 TREE IN GRATE PLANTING DETAIL
SCALE: 1" = 1'-0"

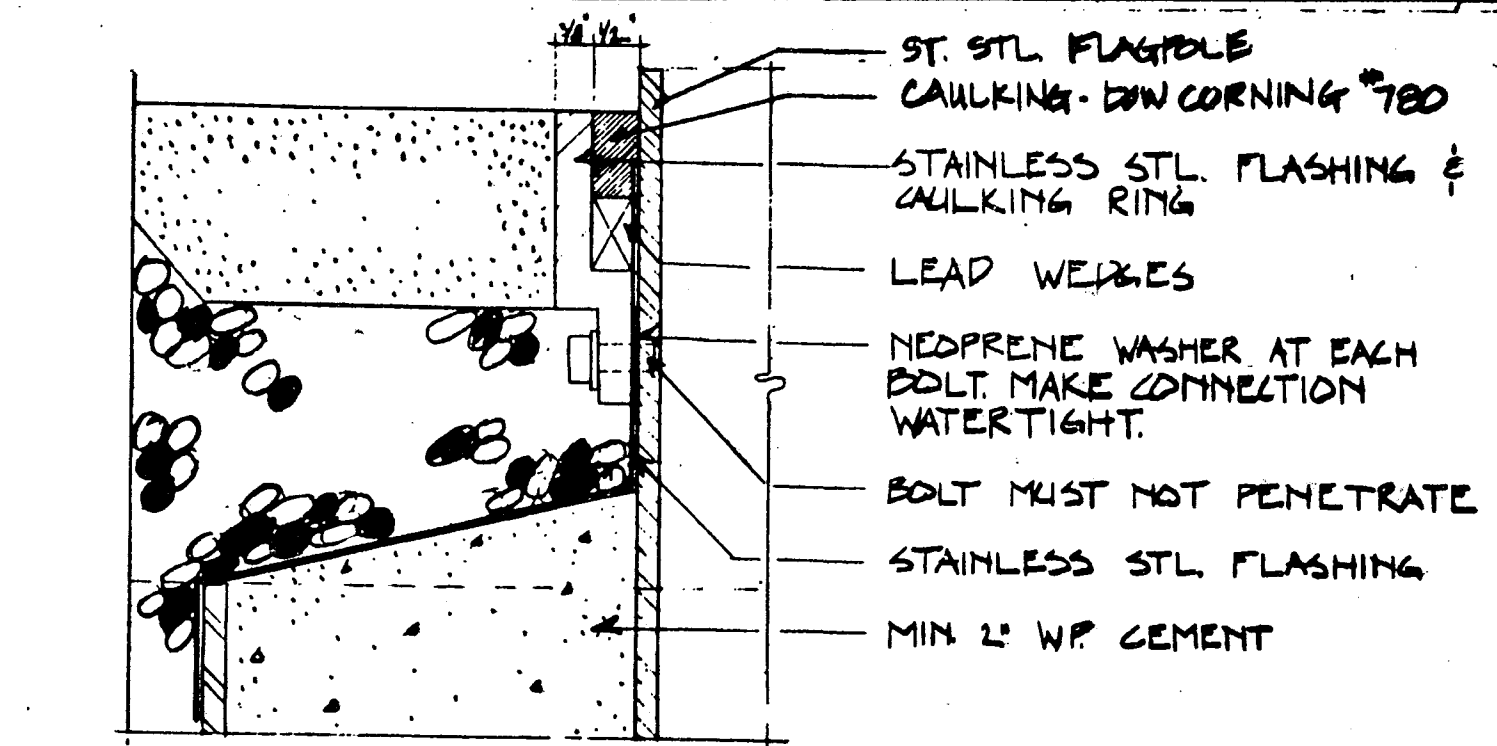

ENLARGEMENT 'A'
SCALE: 1/2" = 1'-0"

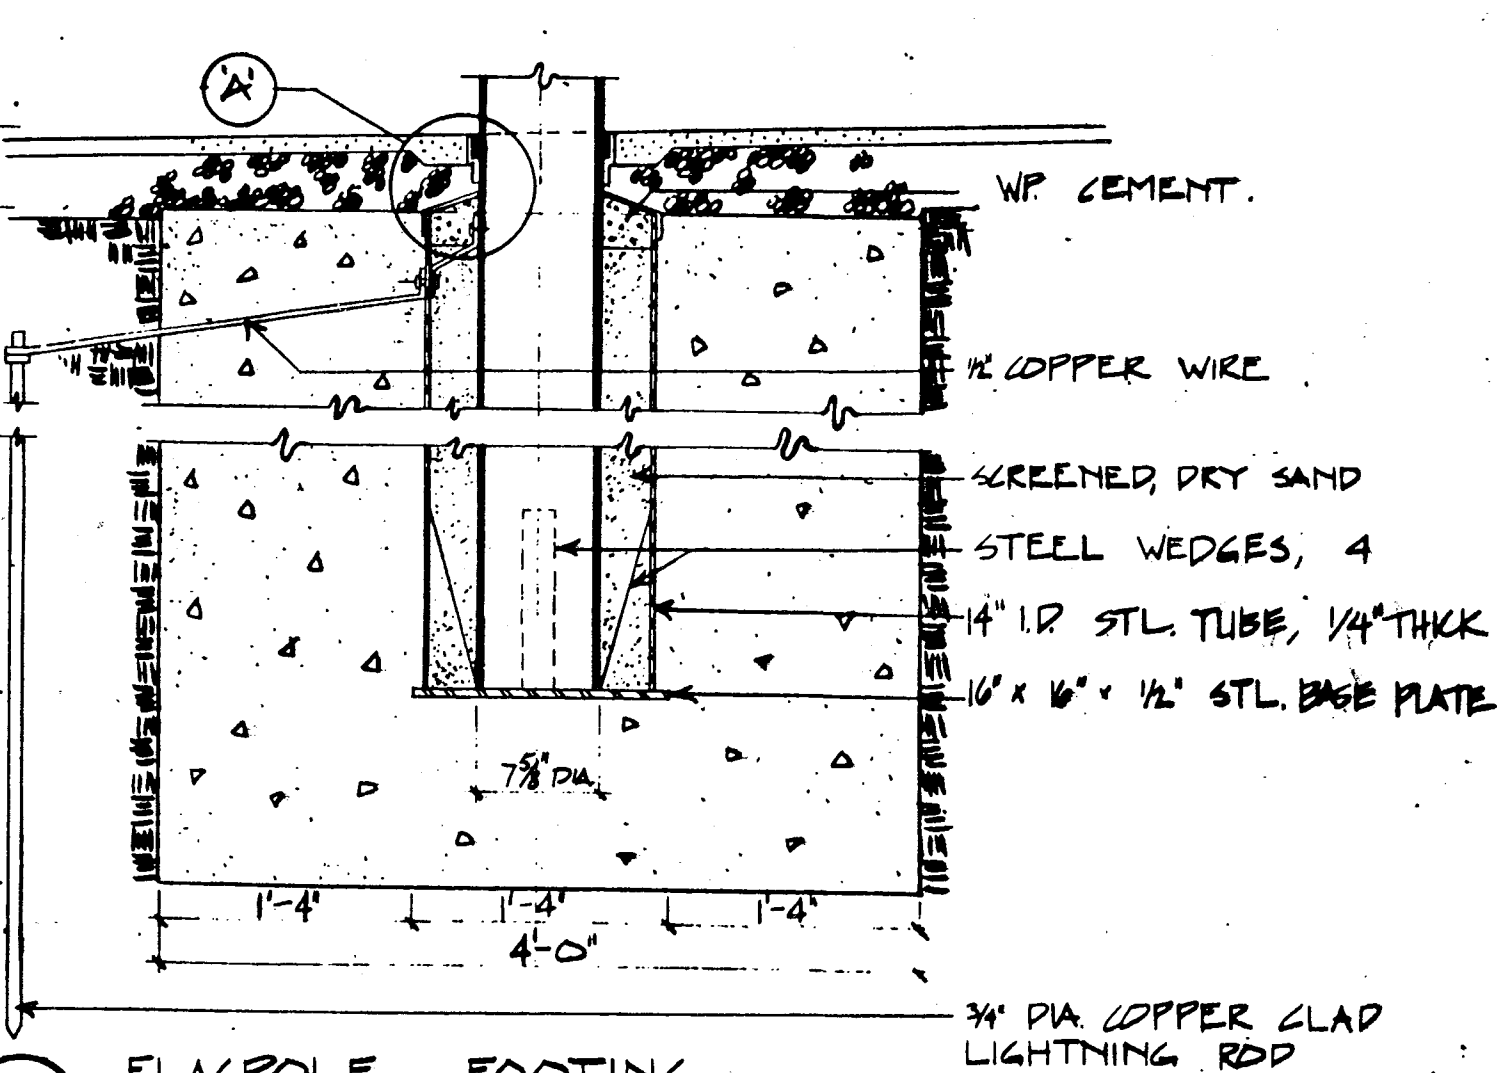

11 FLAGPOLE FOOTING
SCALE: 1" = 1'-0"

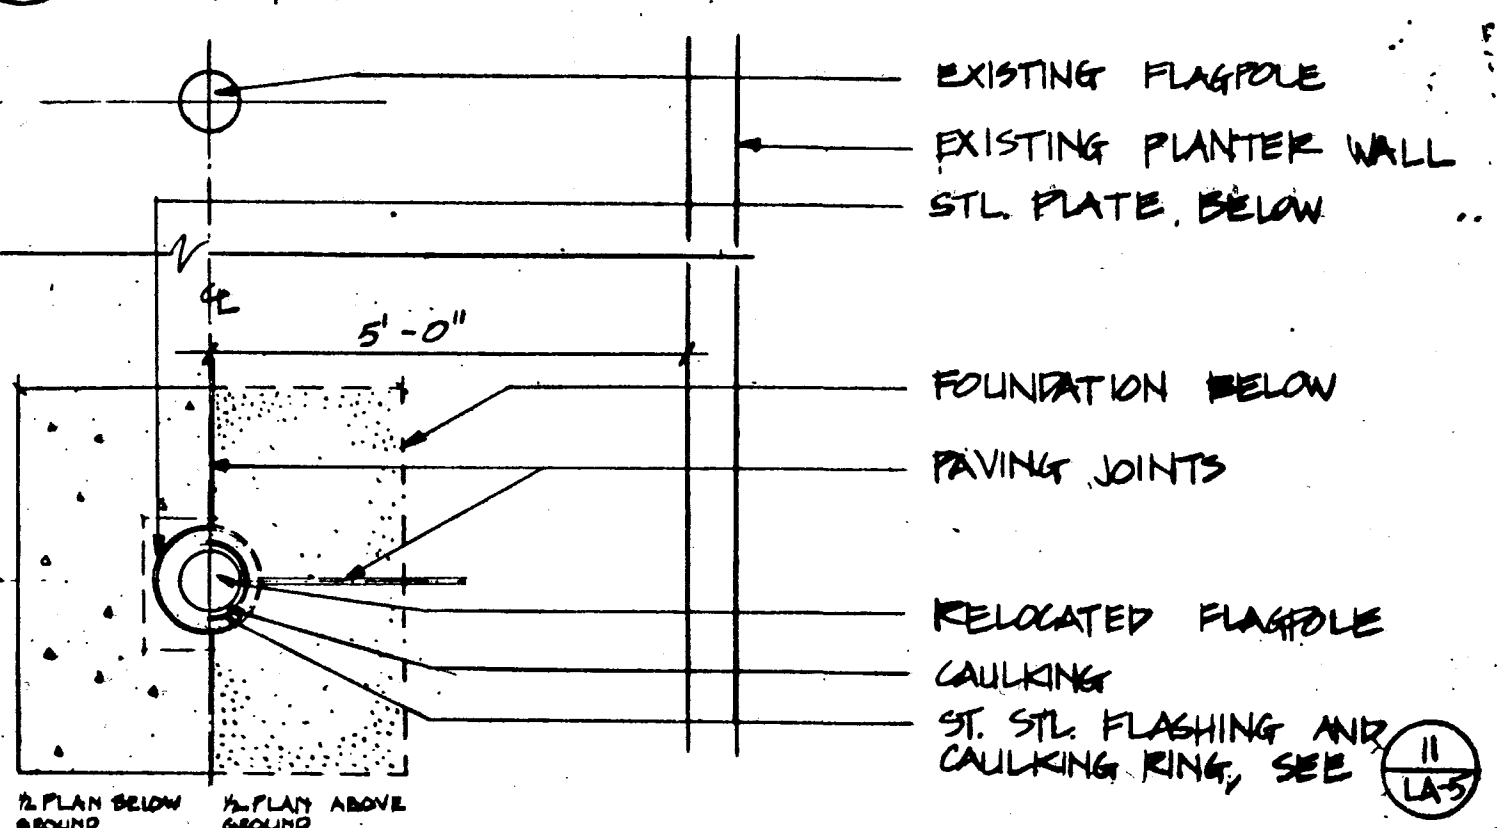

12 FLAGPOLE FOOTING PLAN
SCALE: 1/2" = 1'-0"

SUPPLEMENTAL INFORMATION		
CITY OF HARTFORD, CONNECTICUT DEPARTMENT OF PUBLIC WORKS BUREAU OF ENGINEERING SERVICES		
HARTFORD PEDESTRIAN TRANSIT PROJECT		
LANDSCAPE DETAILS		
SUBMITTED	RECOMMENDED	APPROVED
PROJECT ENGINEER	DIVISION MANAGER	CITY ENGINEER ESB
DRAWN	SCALE	DAYBOOK NO.
CHECKED	DATE	

SHEET NO. LA-5.1

REVISION	MADE BY	CHECKED BY	DESCRIPTION
1	2/28/90		