



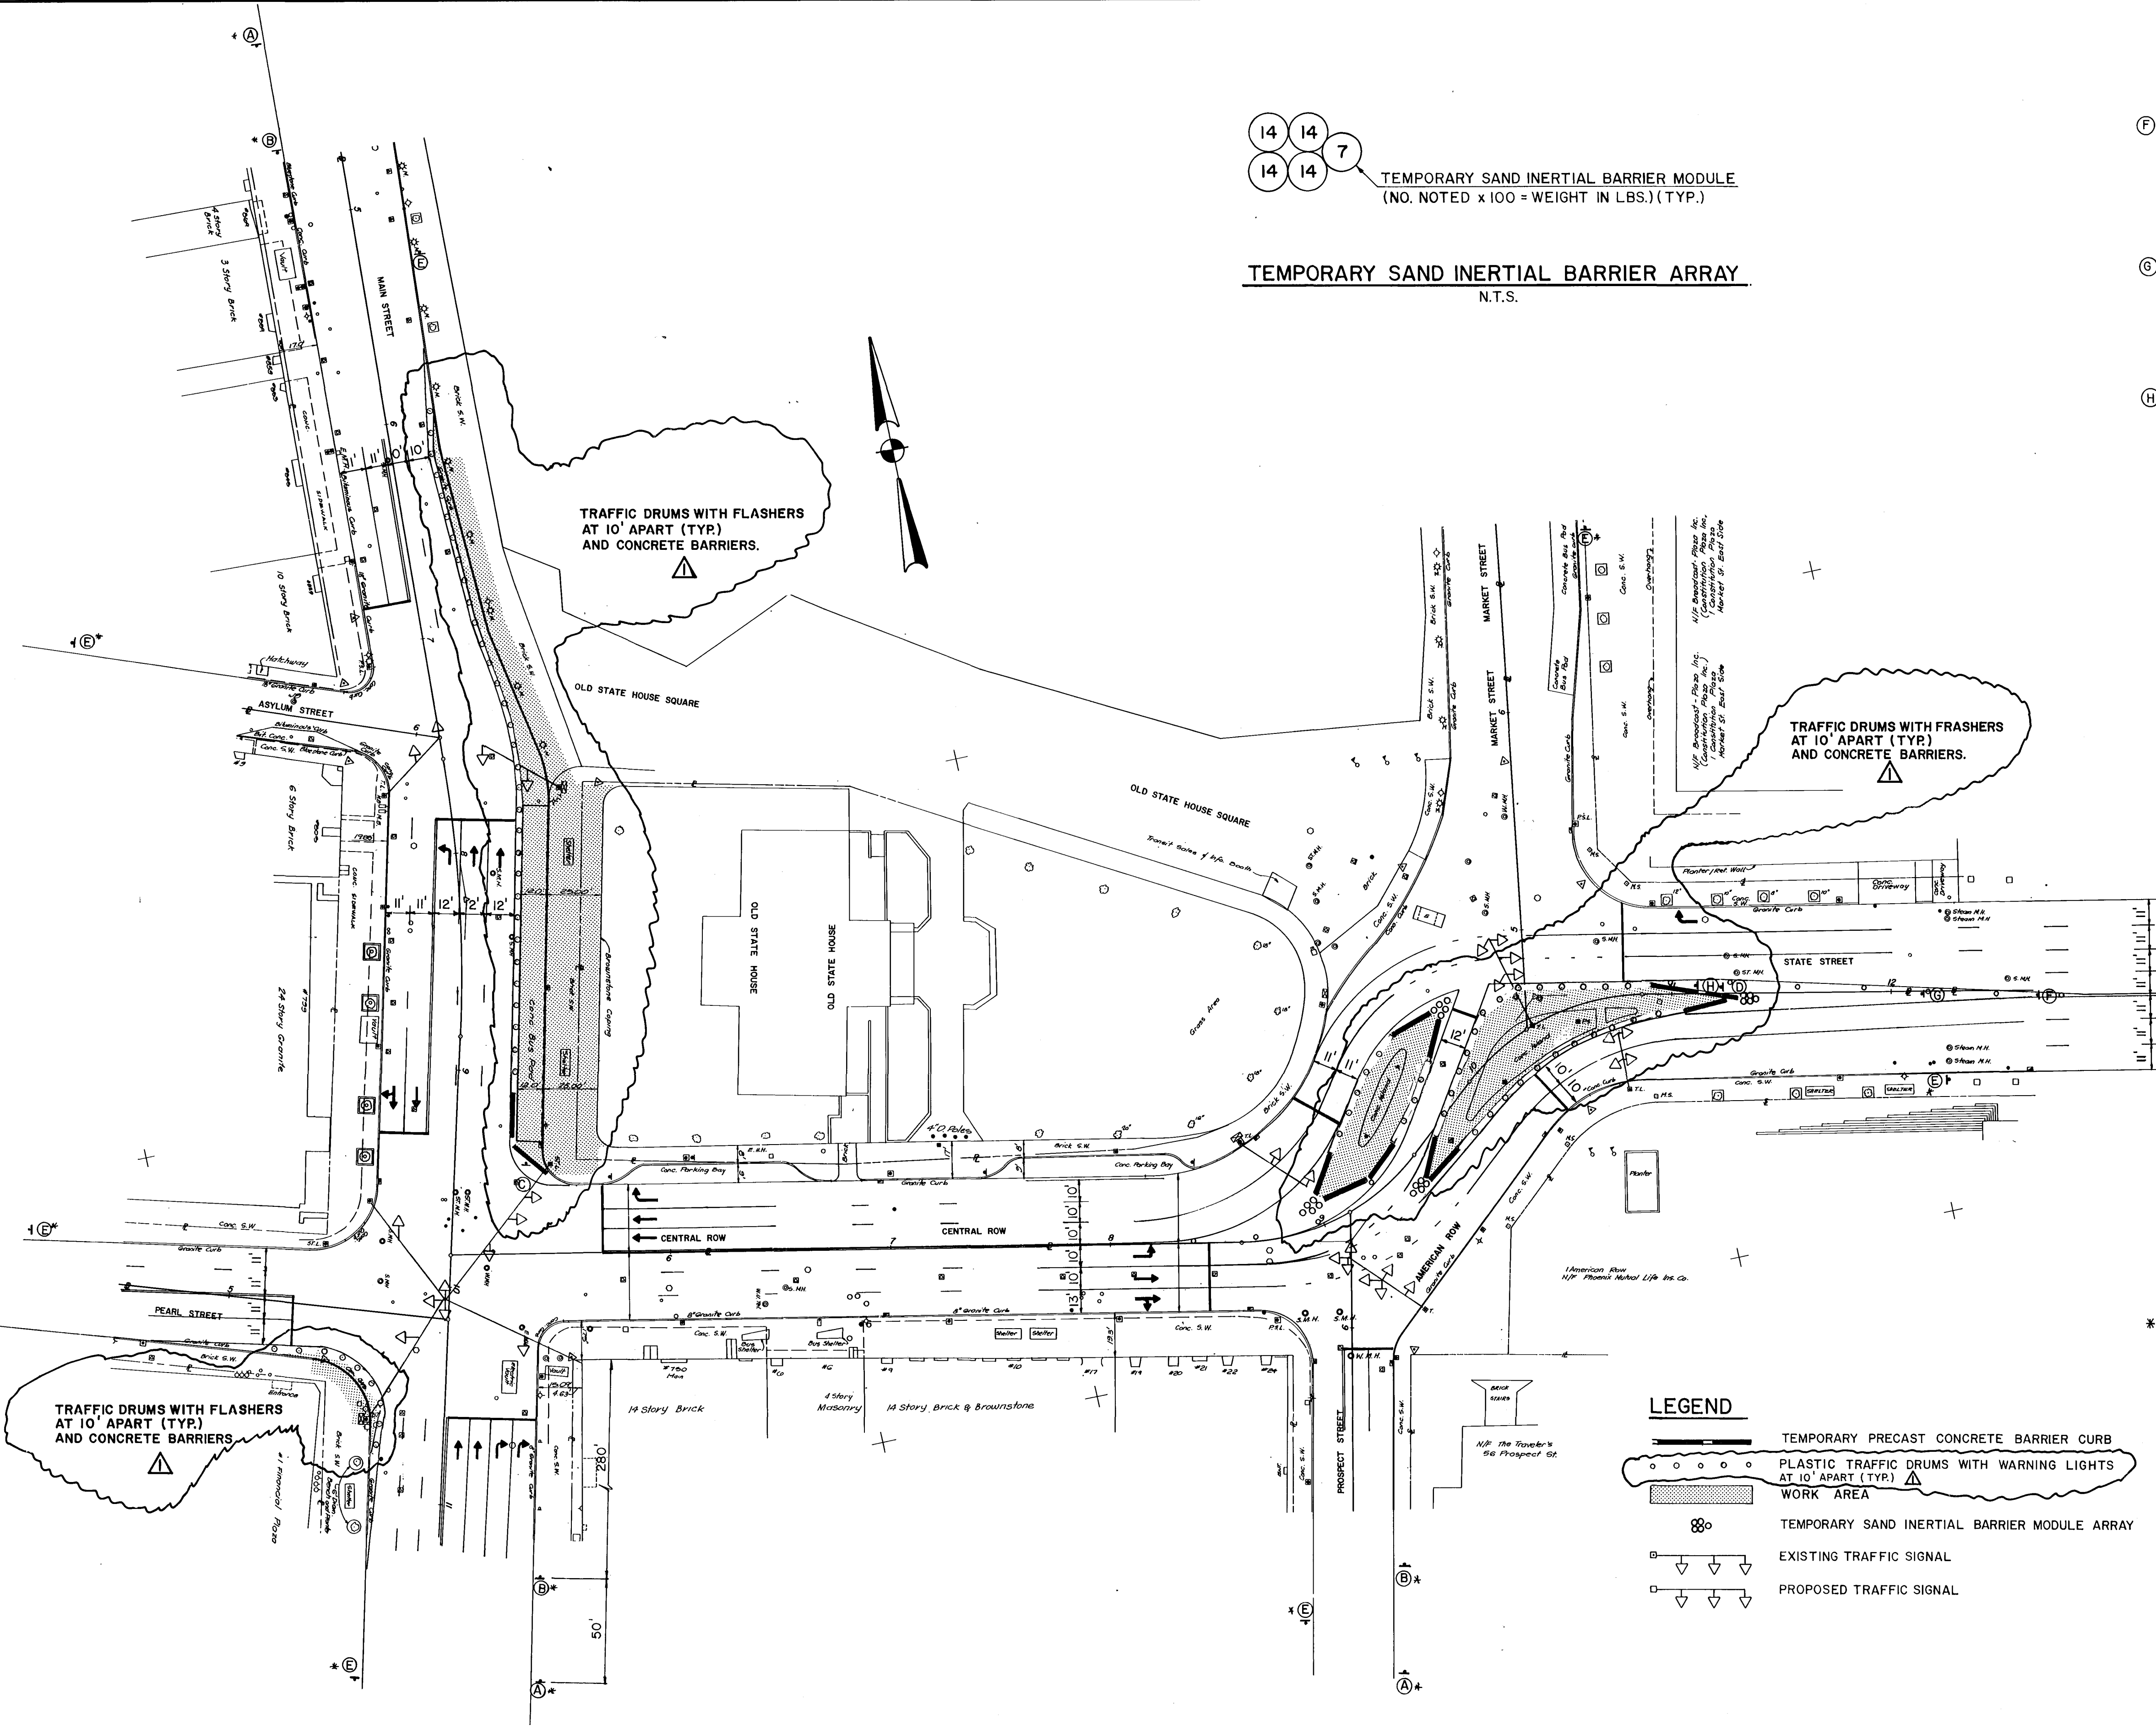


14 14 7
14 14 7
TEMPORARY SAND INERTIAL BARRIER MODULE
(NO. NOTED x 100 = WEIGHT IN LBS.) (TYP.)

TEMPORARY SAND INERTIAL BARRIER ARRAY
N.T.S.

SIGN LEGEND

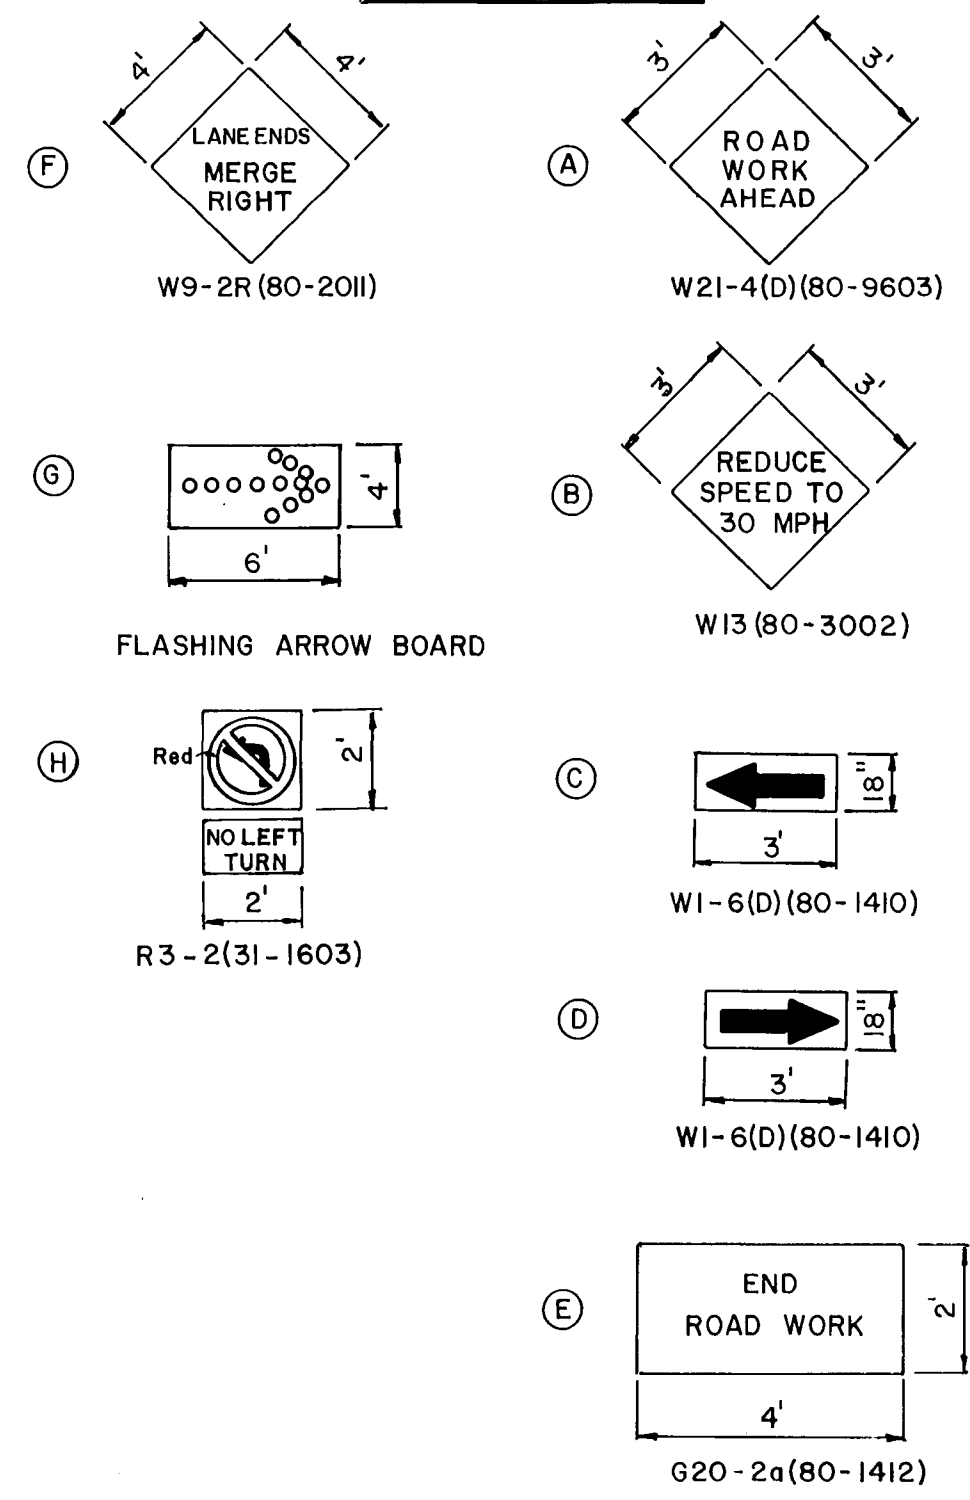

LEGEND

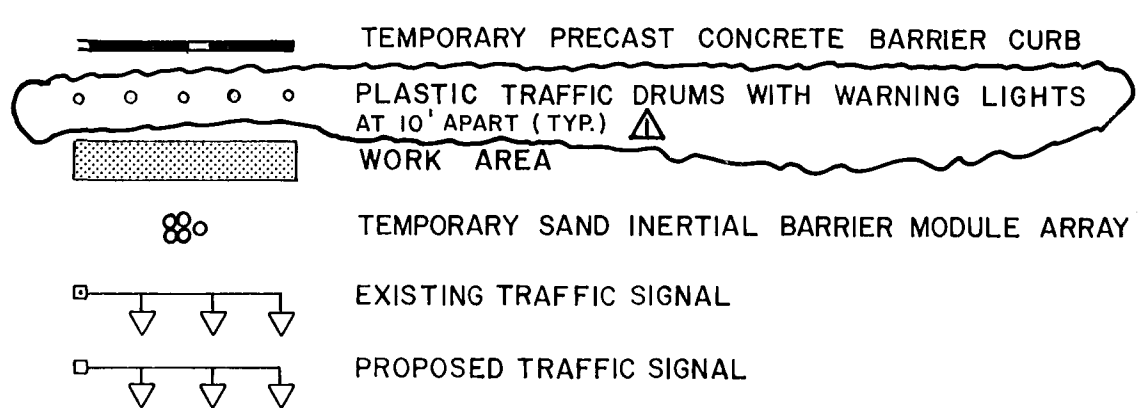

* DENOTES SIGN PLACED IN STAGE 1A TO REMAIN THROUGHOUT DURATION OF PROJECT.

SUPPLEMENTAL INFORMATION		
CITY OF HARTFORD, CONNECTICUT		
DEPARTMENT OF PUBLIC WORKS		
BUREAU OF ENGINEERING SERVICES		
HARTFORD PEDESTRIAN TRANSIT PROJECT		
MAINTENANCE AND PROTECTION OF TRAFFIC		
STAGE - 1A		
SUBMITTED	RECOMMENDED	APPROVED
PROJECT ENGINEER	DIVISION MANAGER	CITY ENGINEER, ESB
DRAWN	SCALE	DAYBOOK NO.
CHECKED		DATE

2/28/90			
REVISION	MADE BY	CHECKED BY	DESCRIPTION

SHEET NO. T - 7.1

603/66