


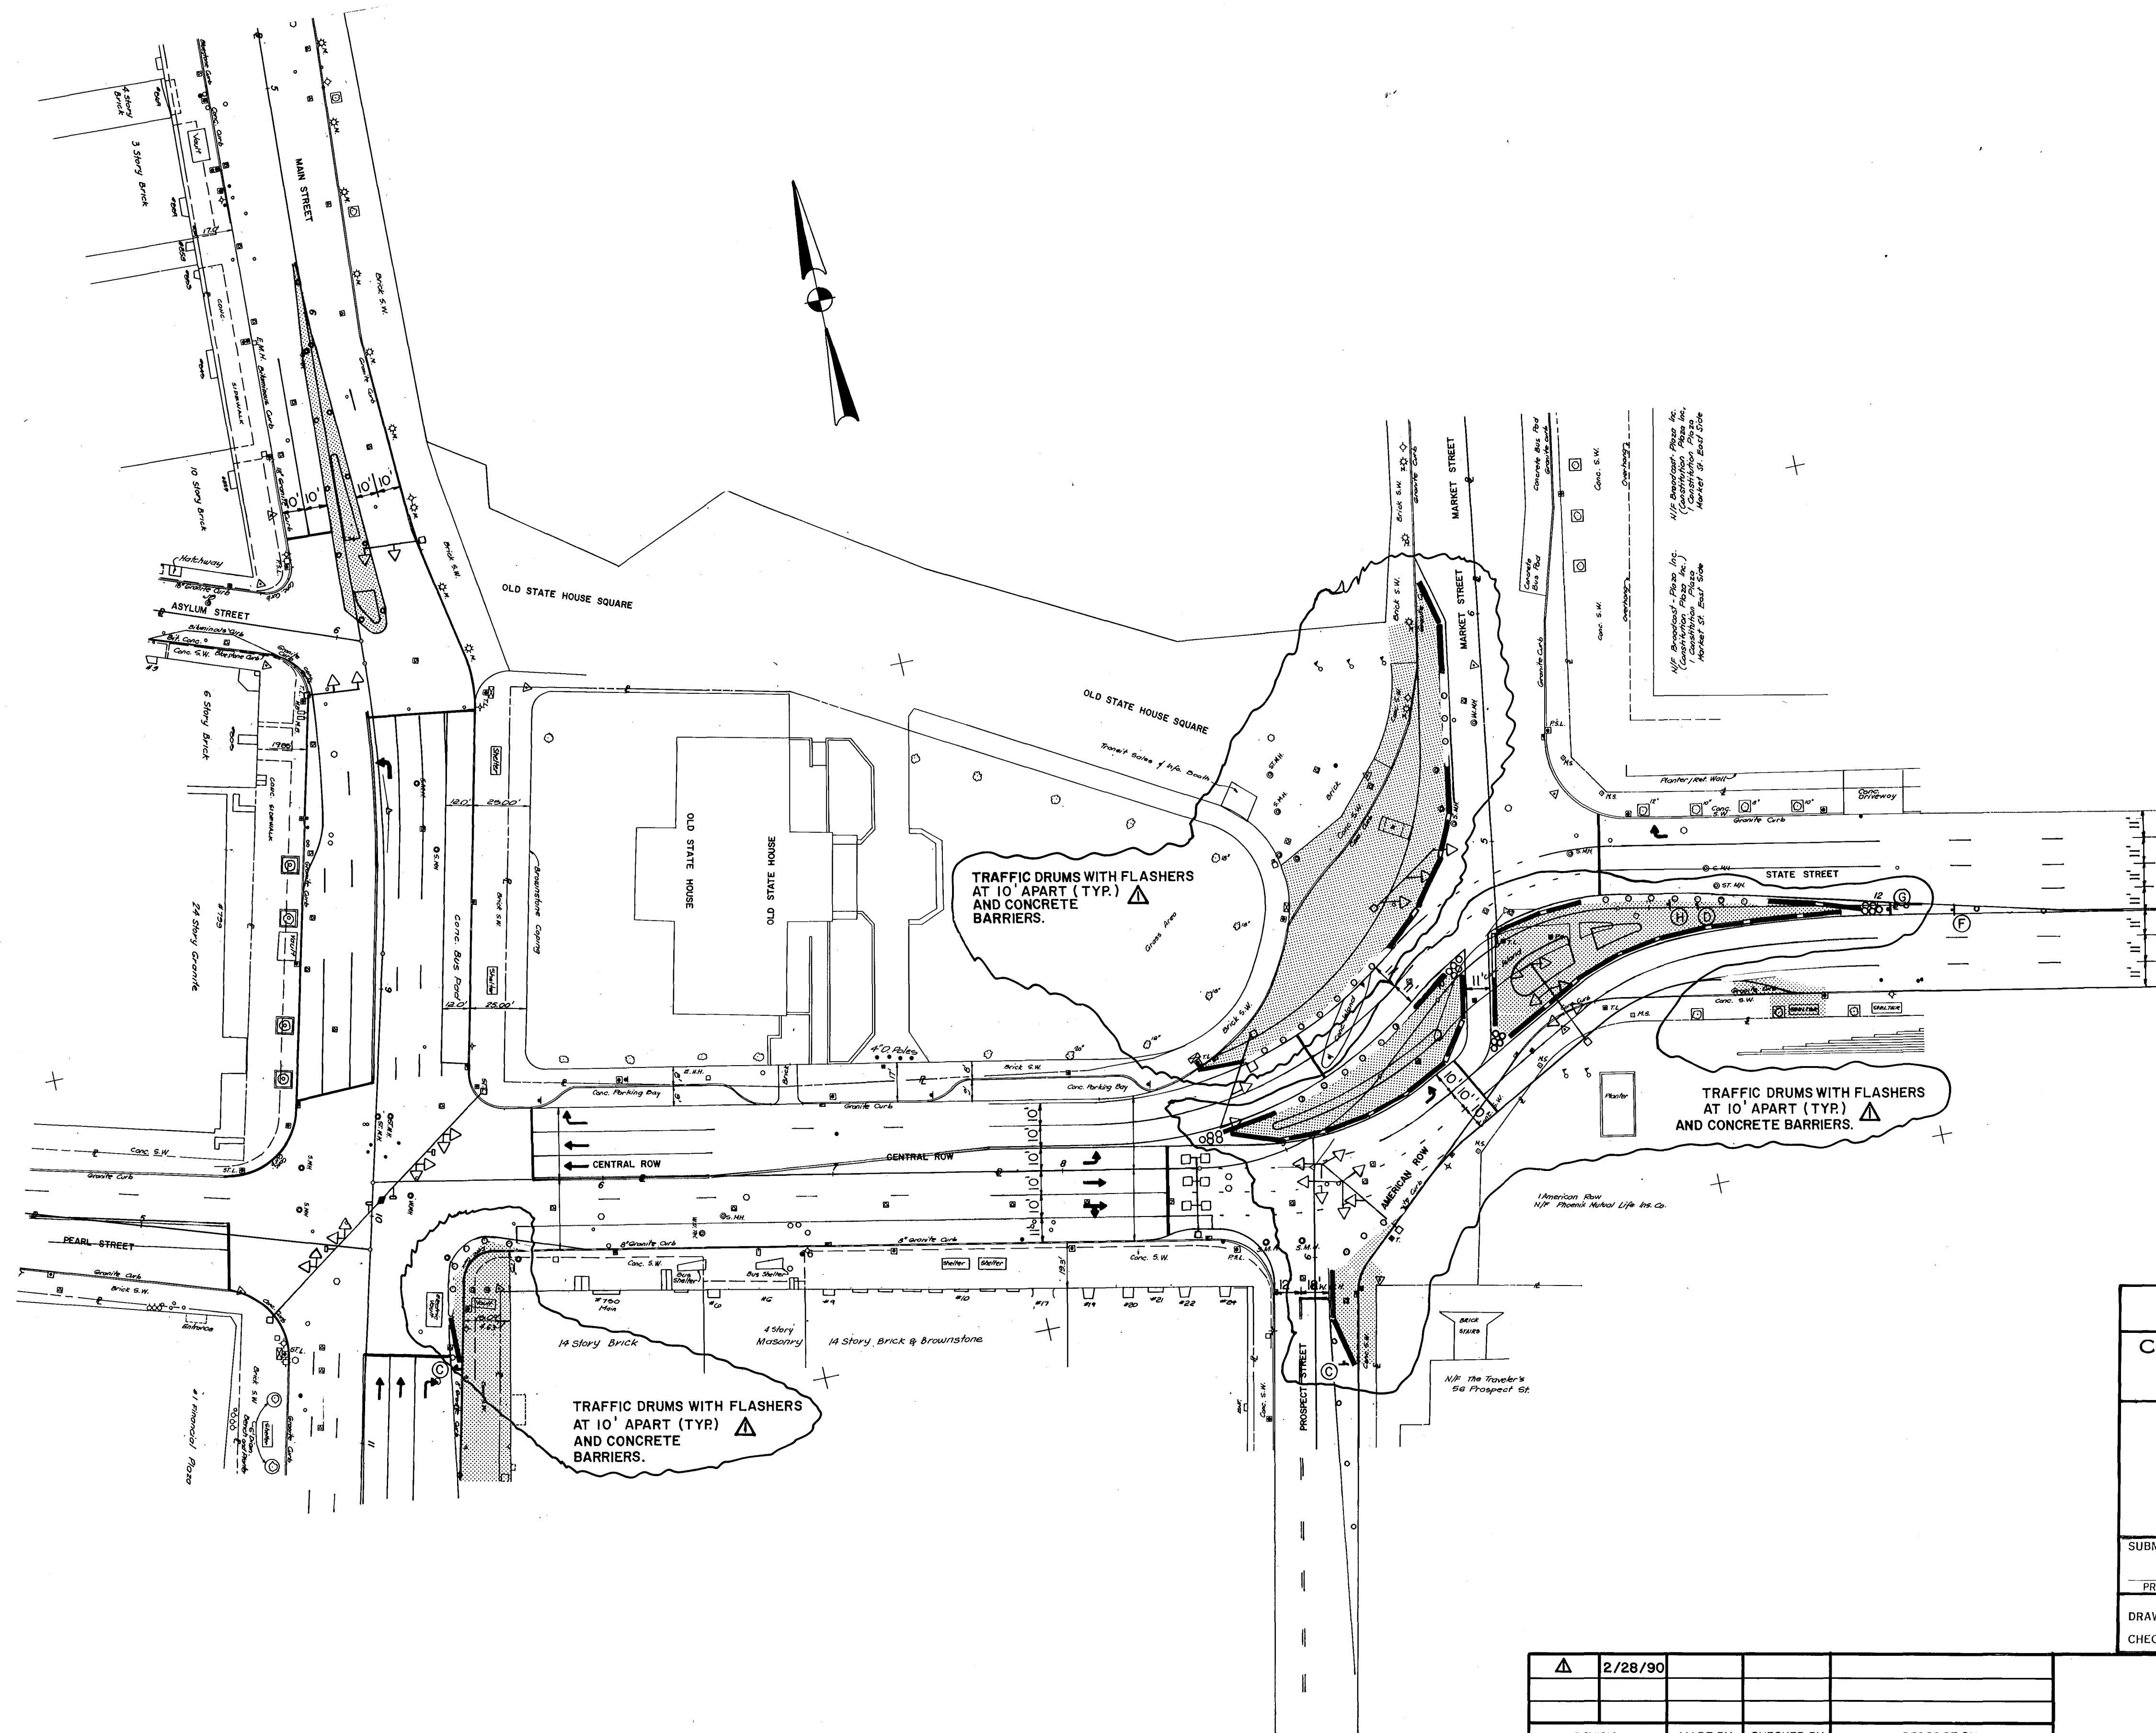

SUPPLEMENTAL INFORMATION			
CITY OF HARTFORD, CONNECTICUT			
DEPARTMENT OF PUBLIC WORKS			
BUREAU OF ENGINEERING SERVICES			
HARTFORD PEDESTRIAN TRANSIT PROJECT			
MAINTENANCE AND PROTECTION OF TRAFFIC			
STAGE 1C			
SUBMITTED	RECOMMENDED	APPROVED	
PROJECT ENGINEER	DIVISION MANAGER	CITY ENGINEER	
DRAWN	SCALE	DAYBOOK NO.	
CHECKED		DATE	
SHEET NO. T-9.1			

2/28/90				
REVISION	MADE BY	CHECKED BY	DESCRIPTION	