


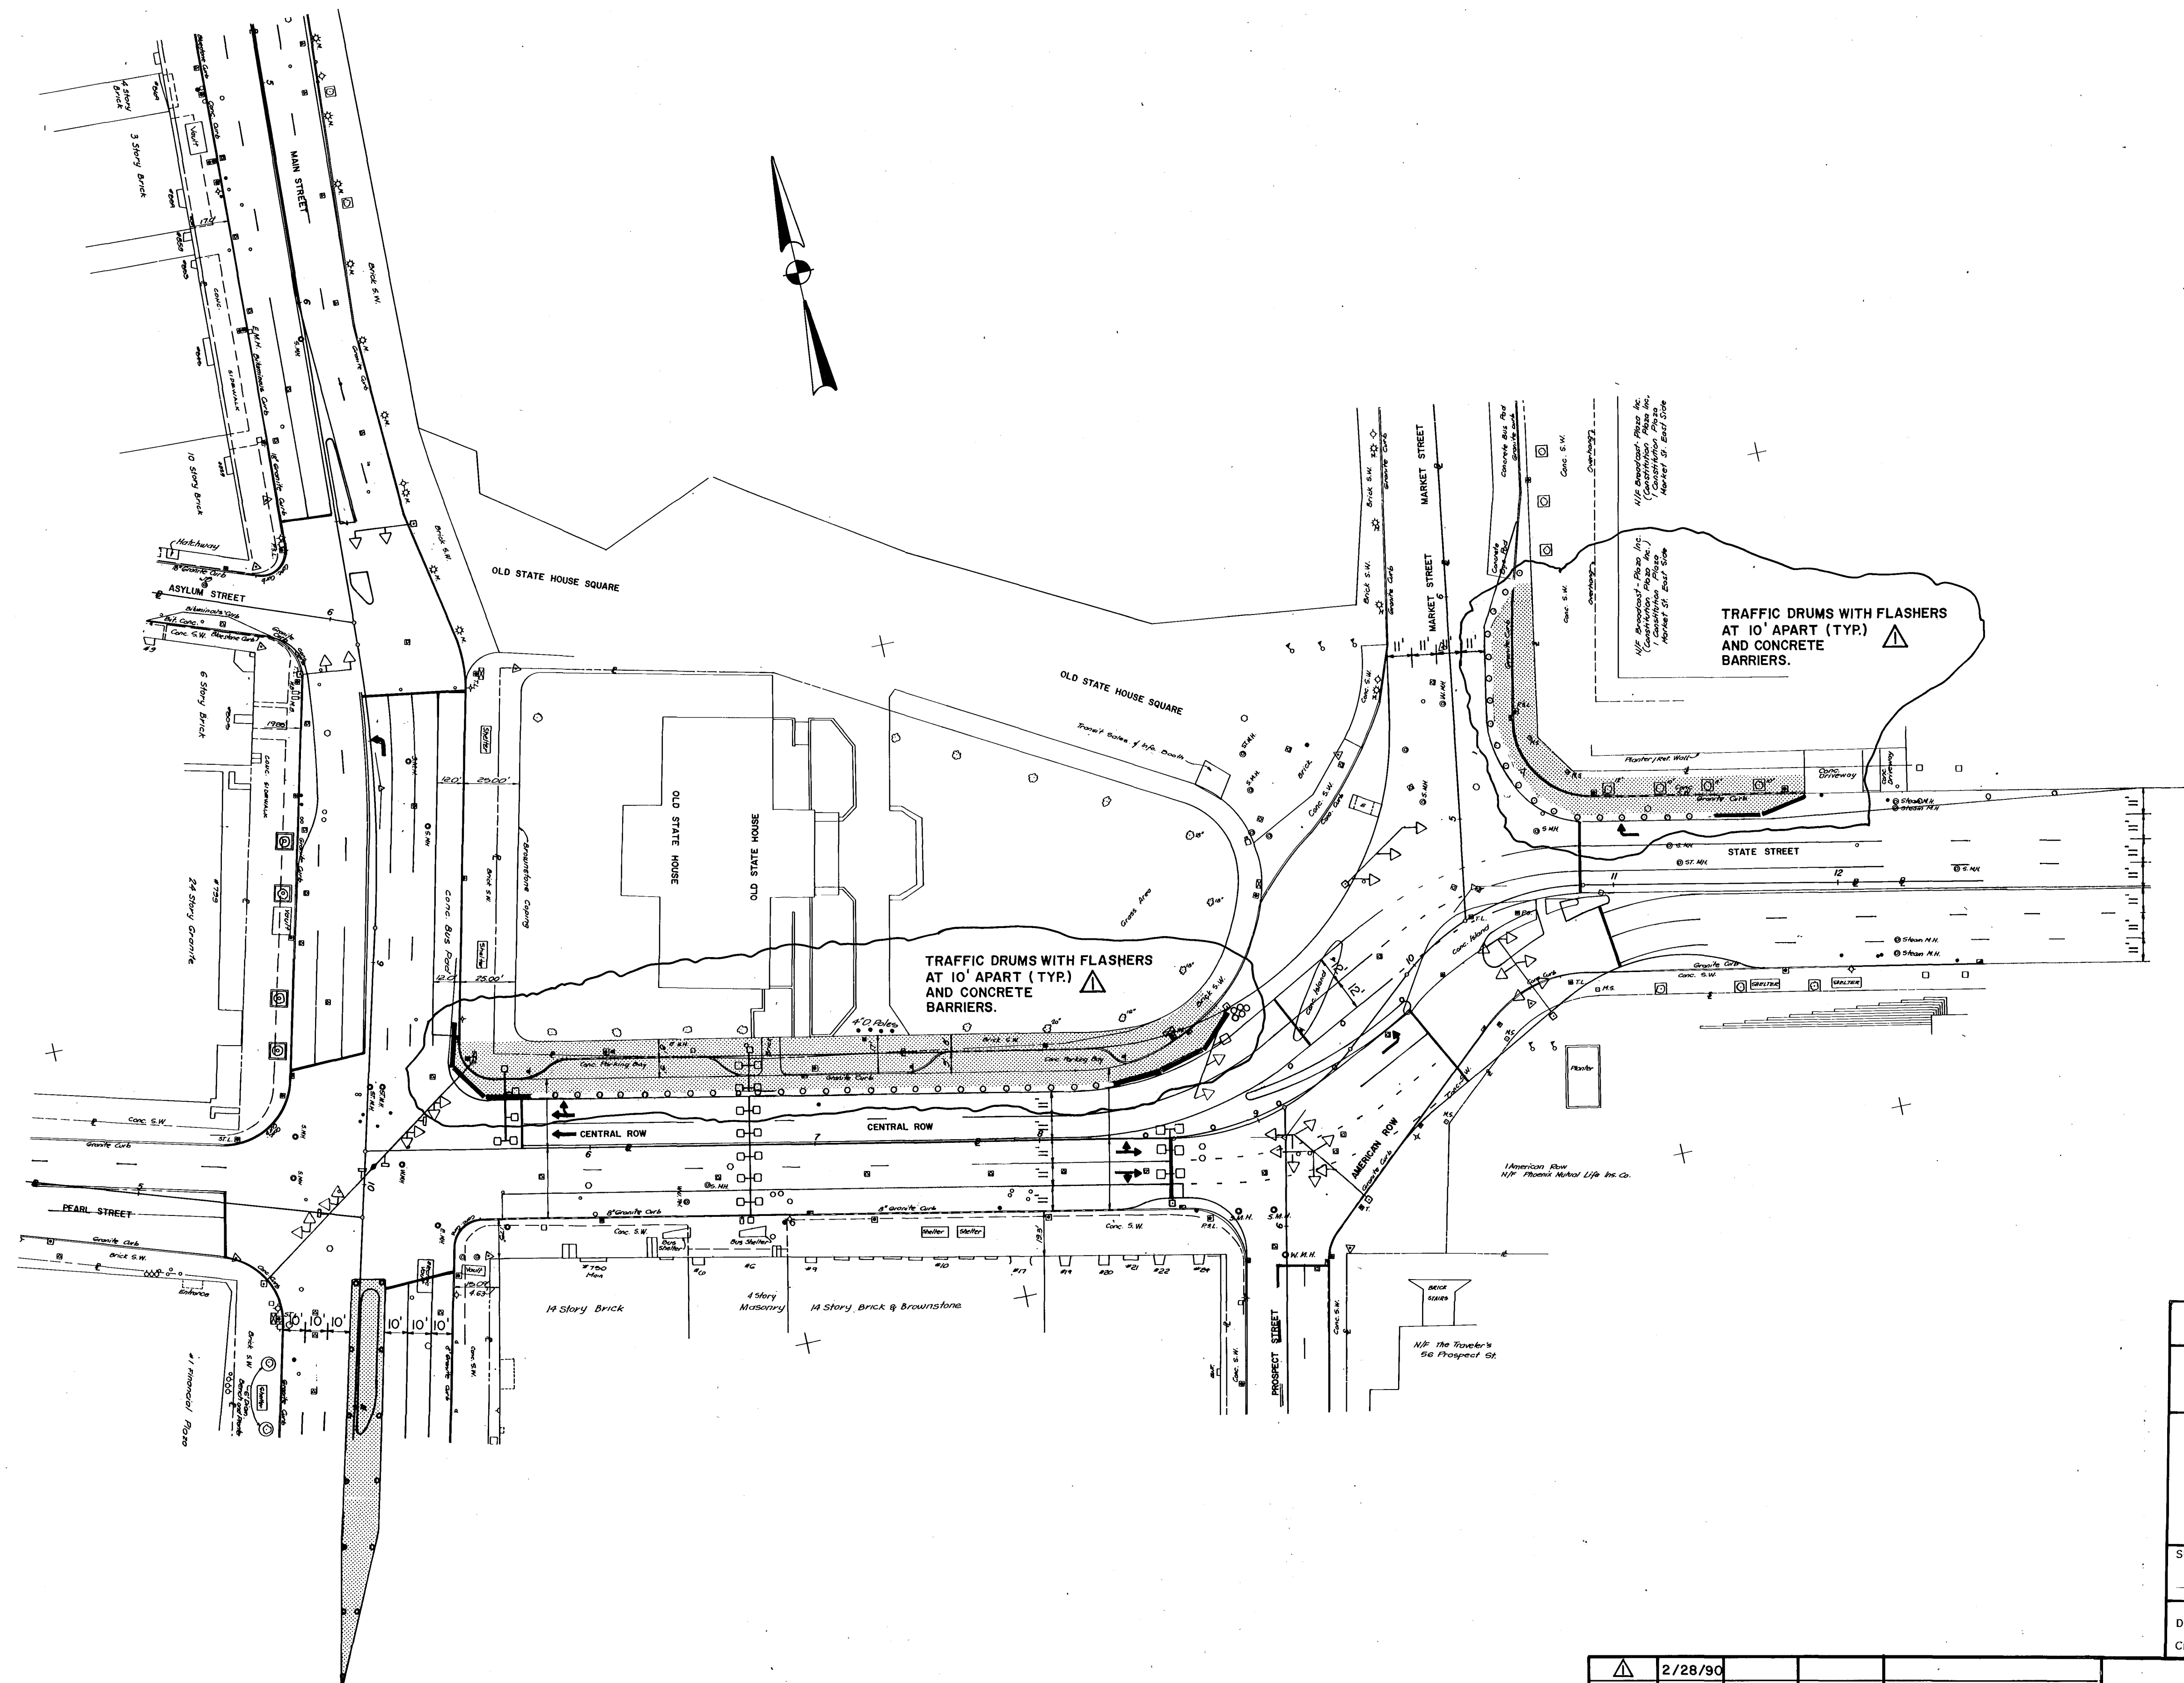

|                                                                                               |                  |                   |
|-----------------------------------------------------------------------------------------------|------------------|-------------------|
| SUPPLEMENTAL INFORMATION                                                                      |                  |                   |
| CITY OF HARTFORD, CONNECTICUT<br>DEPARTMENT OF PUBLIC WORKS<br>BUREAU OF ENGINEERING SERVICES |                  |                   |
| HARTFORD PEDESTRIAN TRANSIT PROJECT<br>MAINTENANCE AND PROTECTION OF TRAFFIC<br>STAGE 1 D     |                  |                   |
| SUBMITTED                                                                                     | RECOMMENDED      | APPROVED          |
| PROJECT ENGINEER                                                                              | DIVISION MANAGER | CITY ENGINEER ESD |
| DRAWN                                                                                         | SCALE            | DAYBOOK NO.       |
| CHECKED                                                                                       |                  | DATE              |

|          |         |            |             |
|----------|---------|------------|-------------|
| 2/28/90  |         |            |             |
| REVISION | MADE BY | CHECKED BY | DESCRIPTION |

SHEET NO. T-10.1

603/69