


CONSTRUCTION NOTES

- WHEN EXCAVATING CLOSE TO TREES, USE ONLY HAND TOOLS. CARE SHALL BE TAKEN TO ENSURE THAT TREE ROOTS ARE NOT DAMAGED IN ANY WAY. THE INSPECTOR SHALL BE NOTIFIED IMMEDIATELY WHENEVER TREE ROOTS ARE ENCOUNTERED. FURTHER EXCAVATING AT THAT LOCATION SHALL BE AS DIRECTED BY THE INSPECTOR.
- 2. CONTRACTOR SHALL INFORM UTILITY COMPANY OF REQUIRED POLE RELOCATION AND COORDINATE WORK WITH UTILITY COMPANY.
- 3. TOP OF CURB SHALL BE 6"ABOVE GUTTER GRADE UNLESS OTHERWISE NOTED.
- 4. CITY ACCEPTED SIDEWALK, SHALL BE CONSTRUCTED AS PART OF THIS CONTRACT AND PAID FOR AT THE CONTRACT UNIT PRICE PER SQUARE FOOT FOR "5" CONCRETE WALK ON NEW FOUNDATION". THE APPROXIMATE QUANITY OF THIS ADDITIONAL WORK IS 265 S.F.

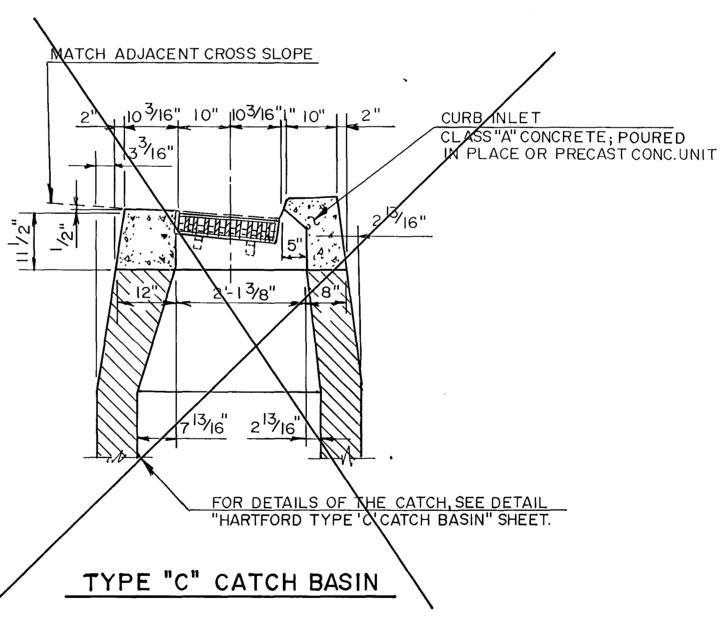

NO. DATE

DESIGNED: A.M.

DRAWN: T.N.S.

APPROVED: R.C.G.

CHECKED: P.L.

REVISION

DATE MAY 14, 1990

SCALE N.T.S.

N. I. C.

WILBUR STREET OLIVER STREET

MISCELLANEOUS DETAILS

THE CITY OF

HARTFORD, CONNECTICUT

SHEET NO.

5 OF 11