



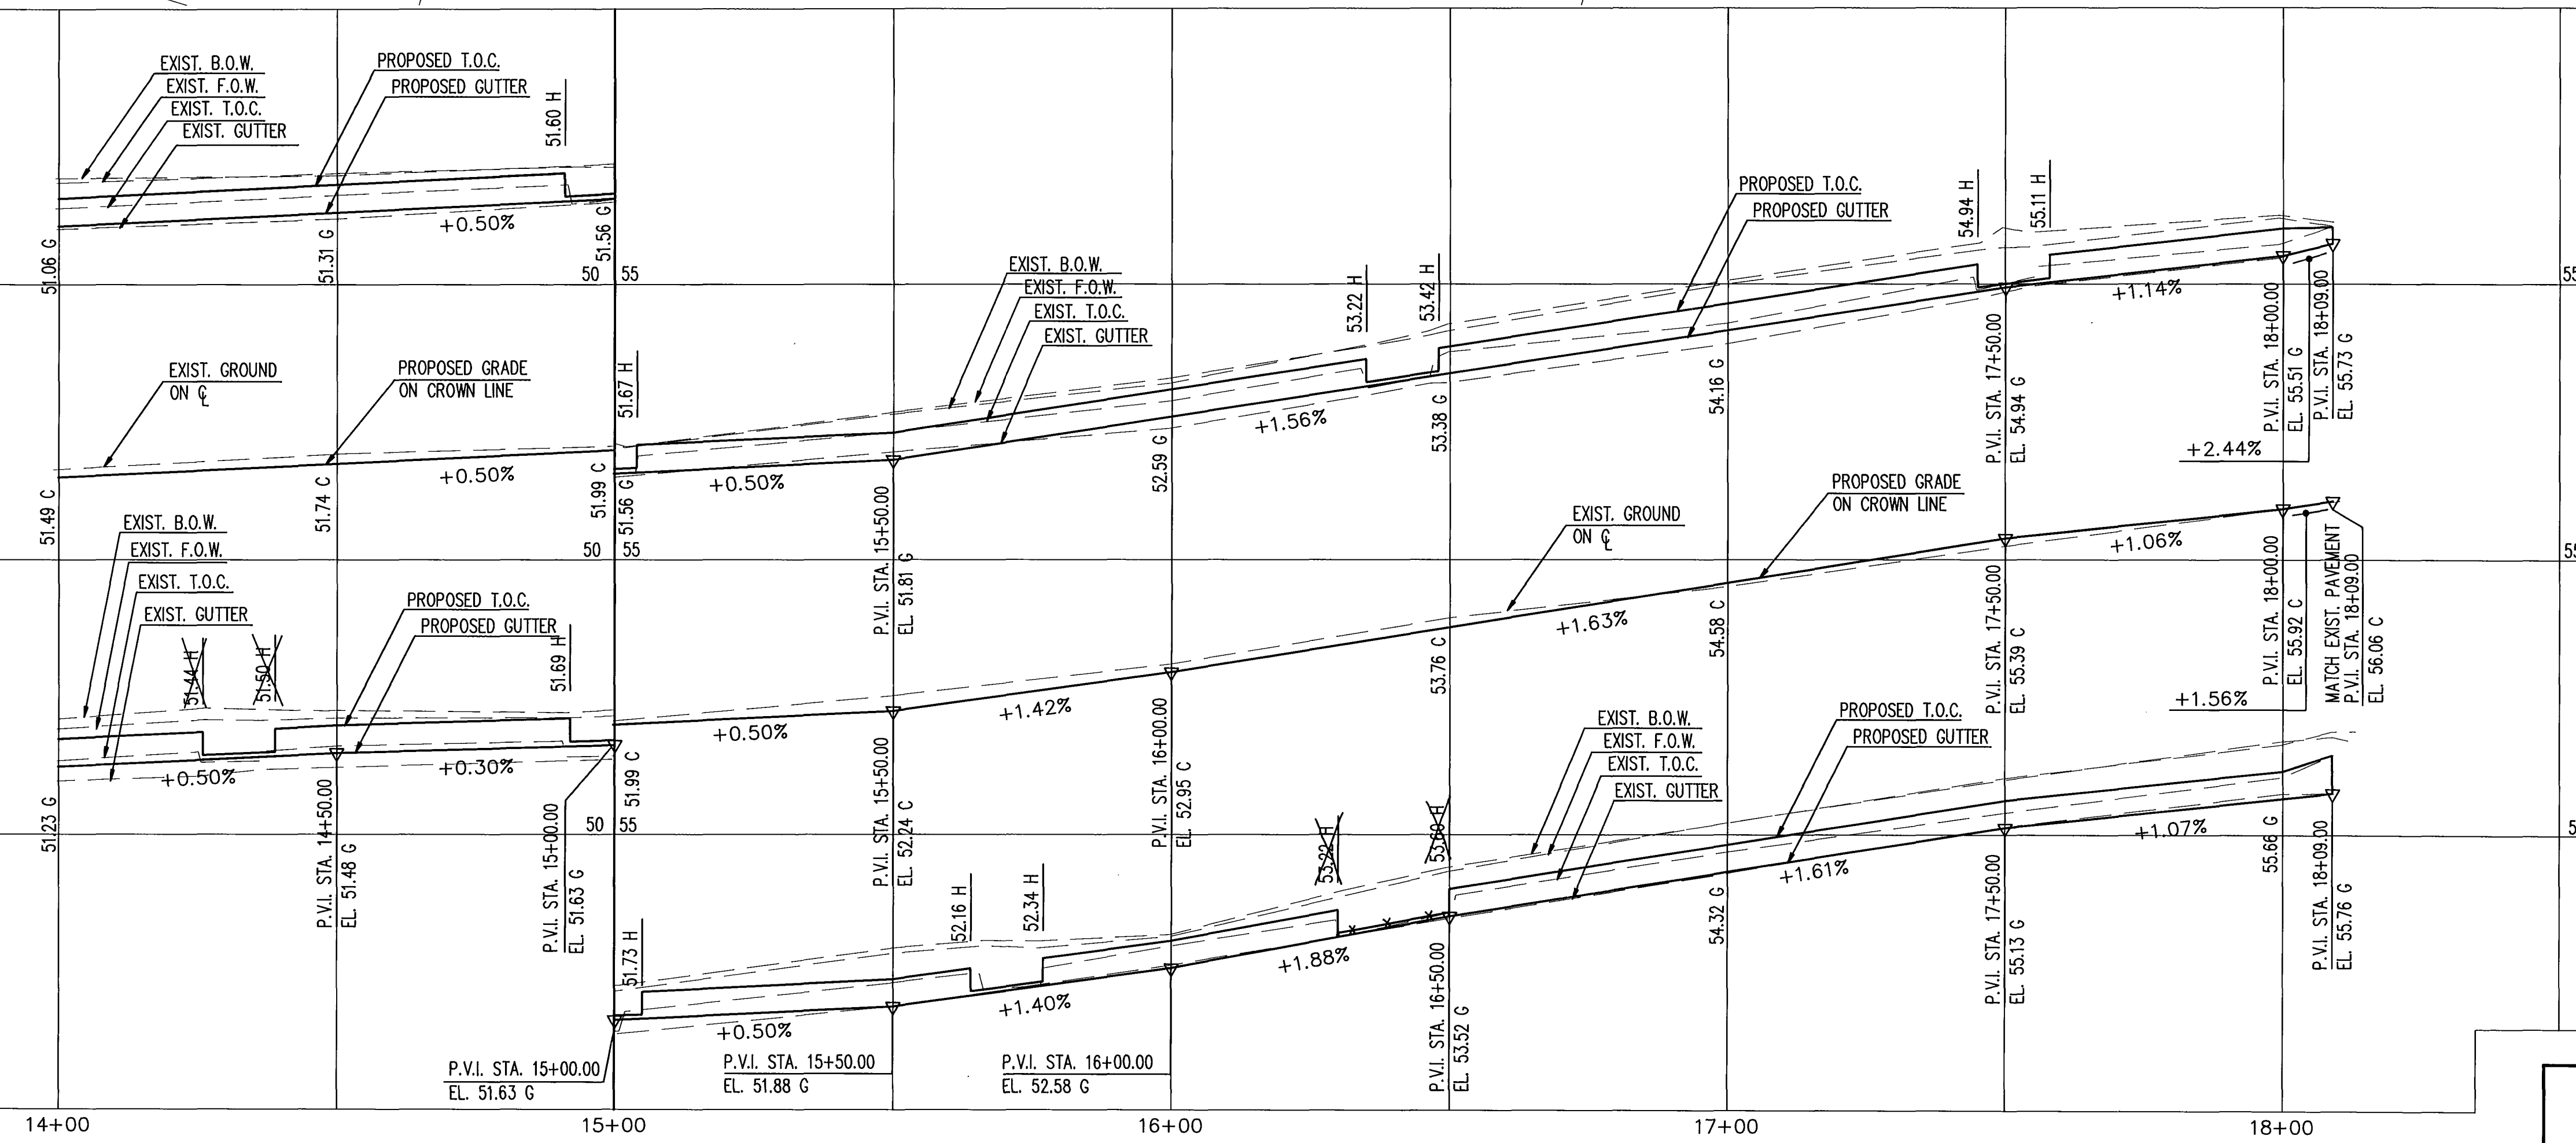

1. (B) SAWCUT BETWEEN EXISTING RAMPED SECTION AND SIDEWALK, AND CONSTRUCT 8" REINFORCED CONC. DRIVEWAY RAMP.
- (C) *EXISTING DRIVEWAY RAMP TO REMAIN.*
- (F) SEEDING AND MULCHING.
2. FOR GENERAL NOTES AND LIST OF ABBREVIATIONS, SEE SHEET NO. 2.
3. FOR CONSTRUCTION NOTES SEE SHEET NO. 5
4. SURVEY BASELINE IS LOCATED 23.00 FT. WEST OF C.M.S.—2.

Page 10

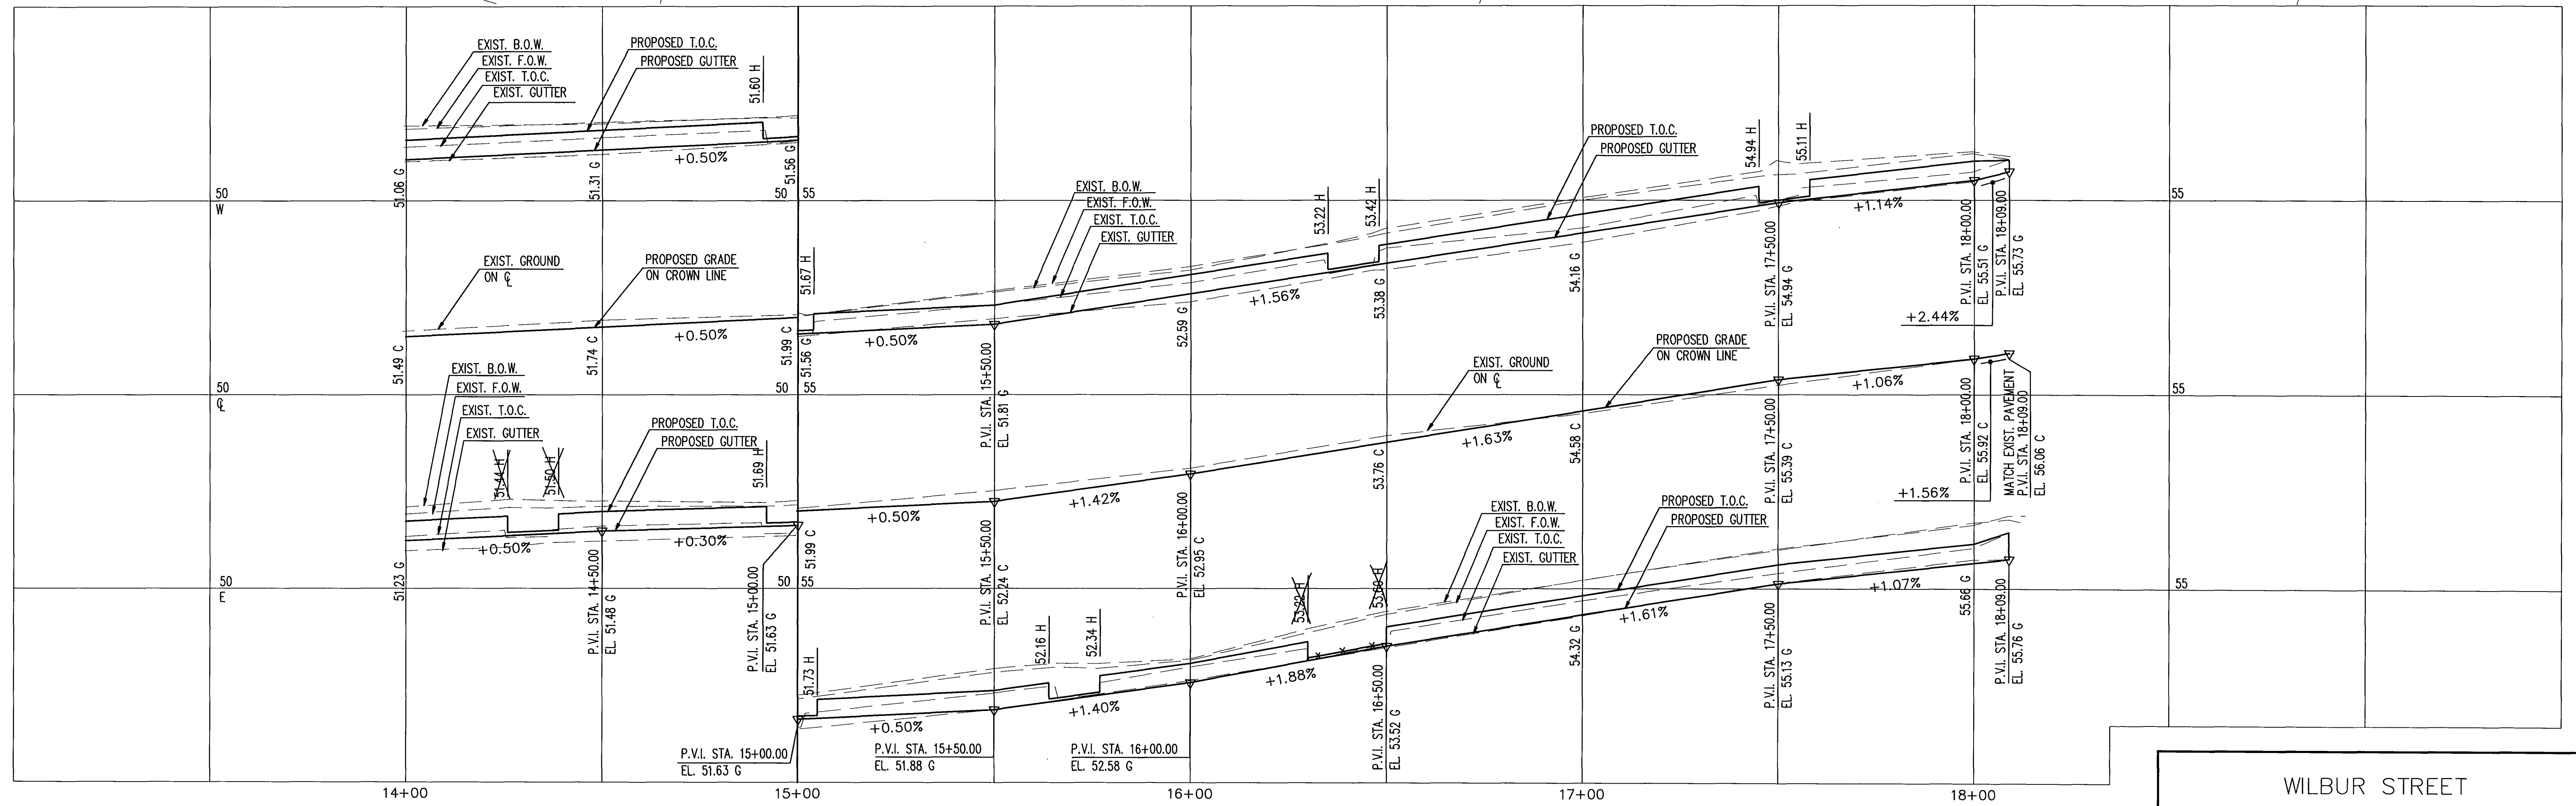

---

SHEET

---

2/11/20