

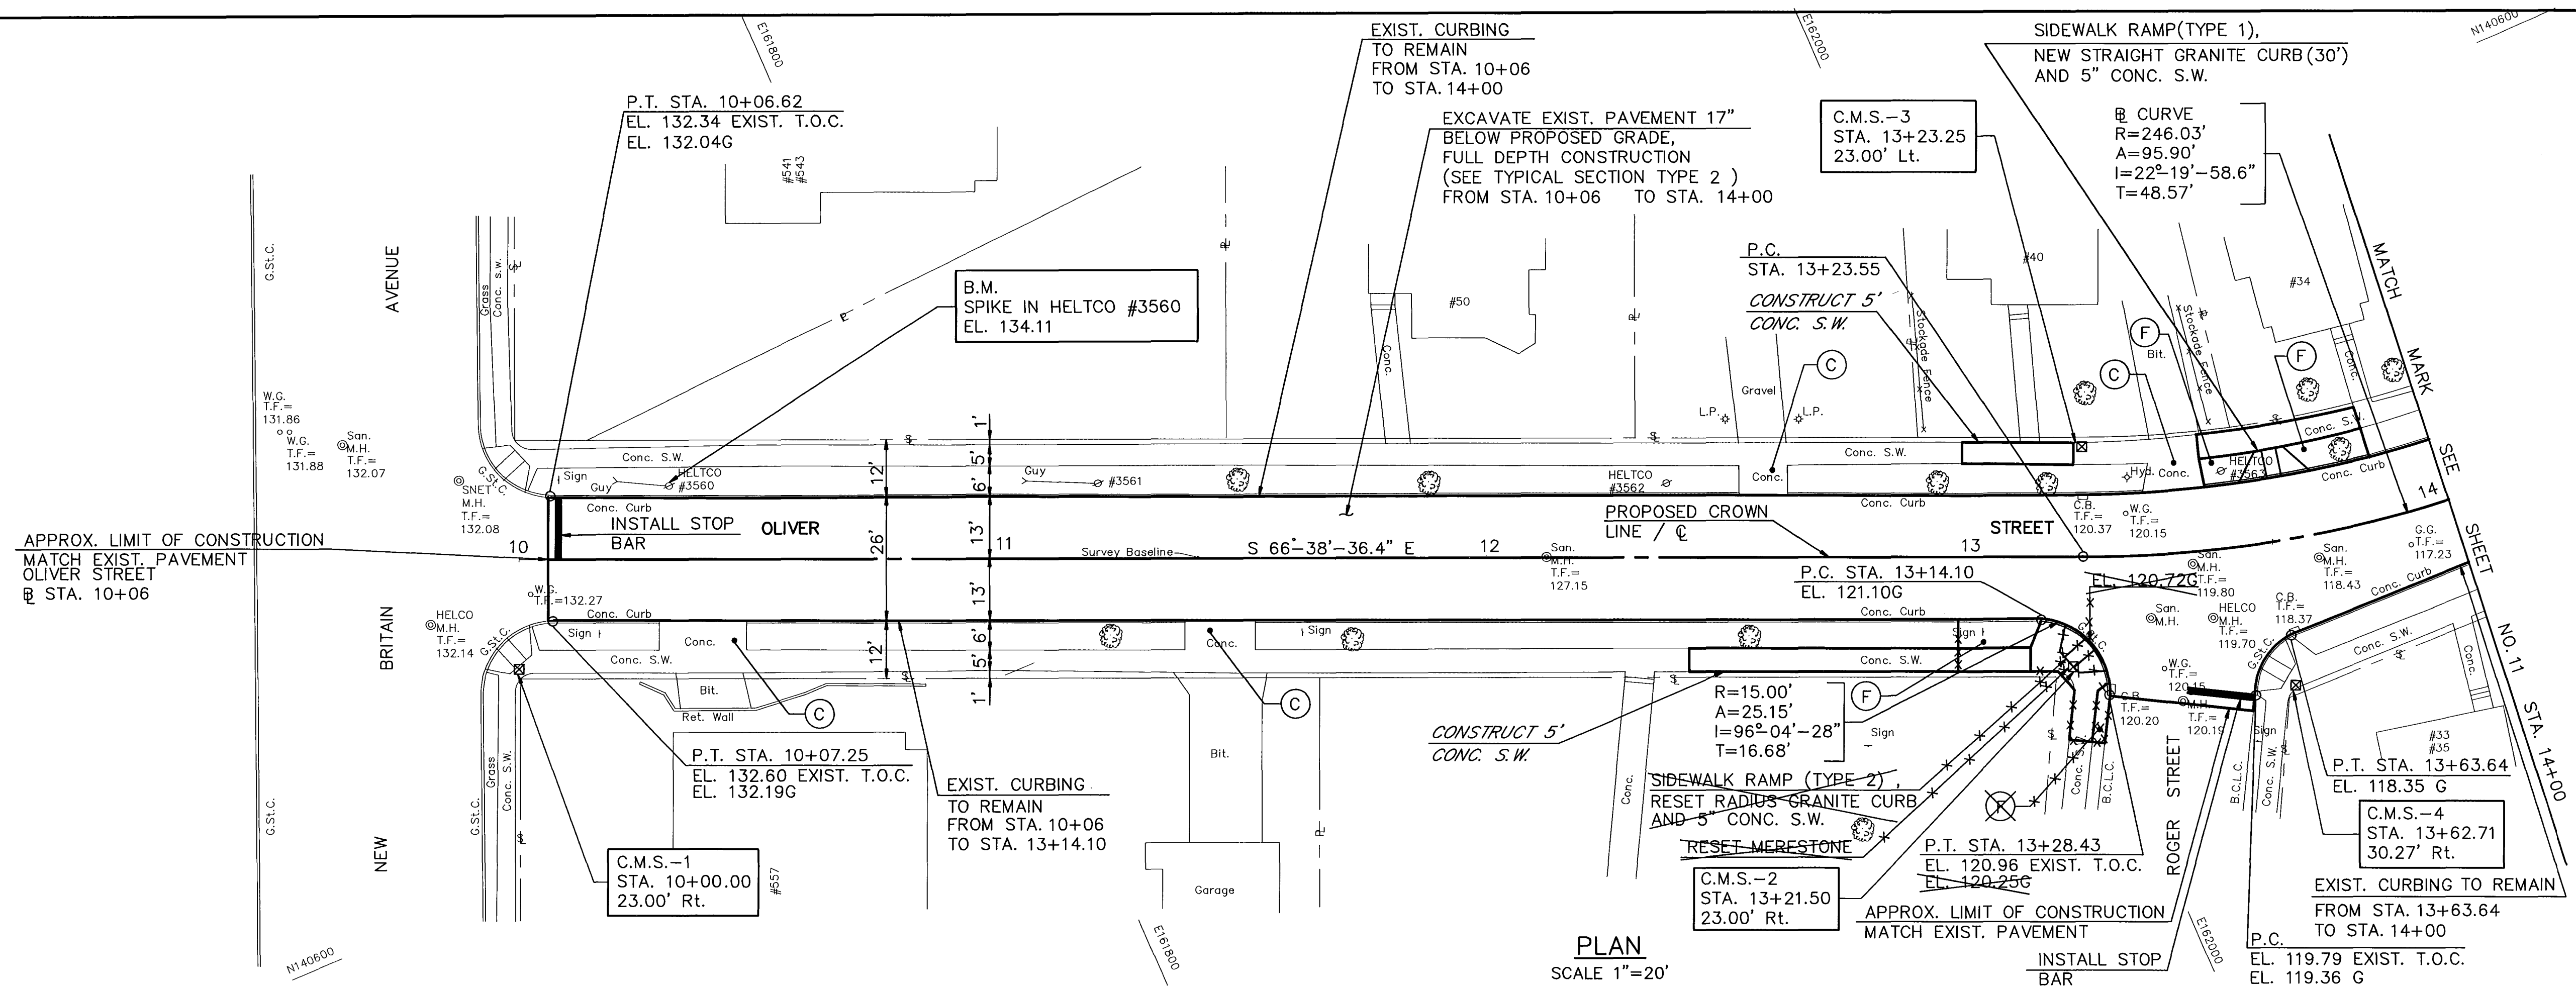


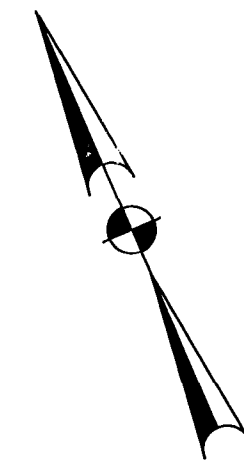

- NOTES:
1. (C) EXISTING DRIVEWAY RAMP TO REMAIN.
 2. (F) SEEDING AND MULCHING.
 3. FOR GENERAL NOTES AND LIST OF ABBREVIATIONS, SEE SHEET NO. 2.
 4. FOR CONSTRUCTION NOTES SEE SHEET NO. 5.
 5. SURVEY BASELINE IS LOCATED 23.00 FT. NORTH OF C.M.S.-1.

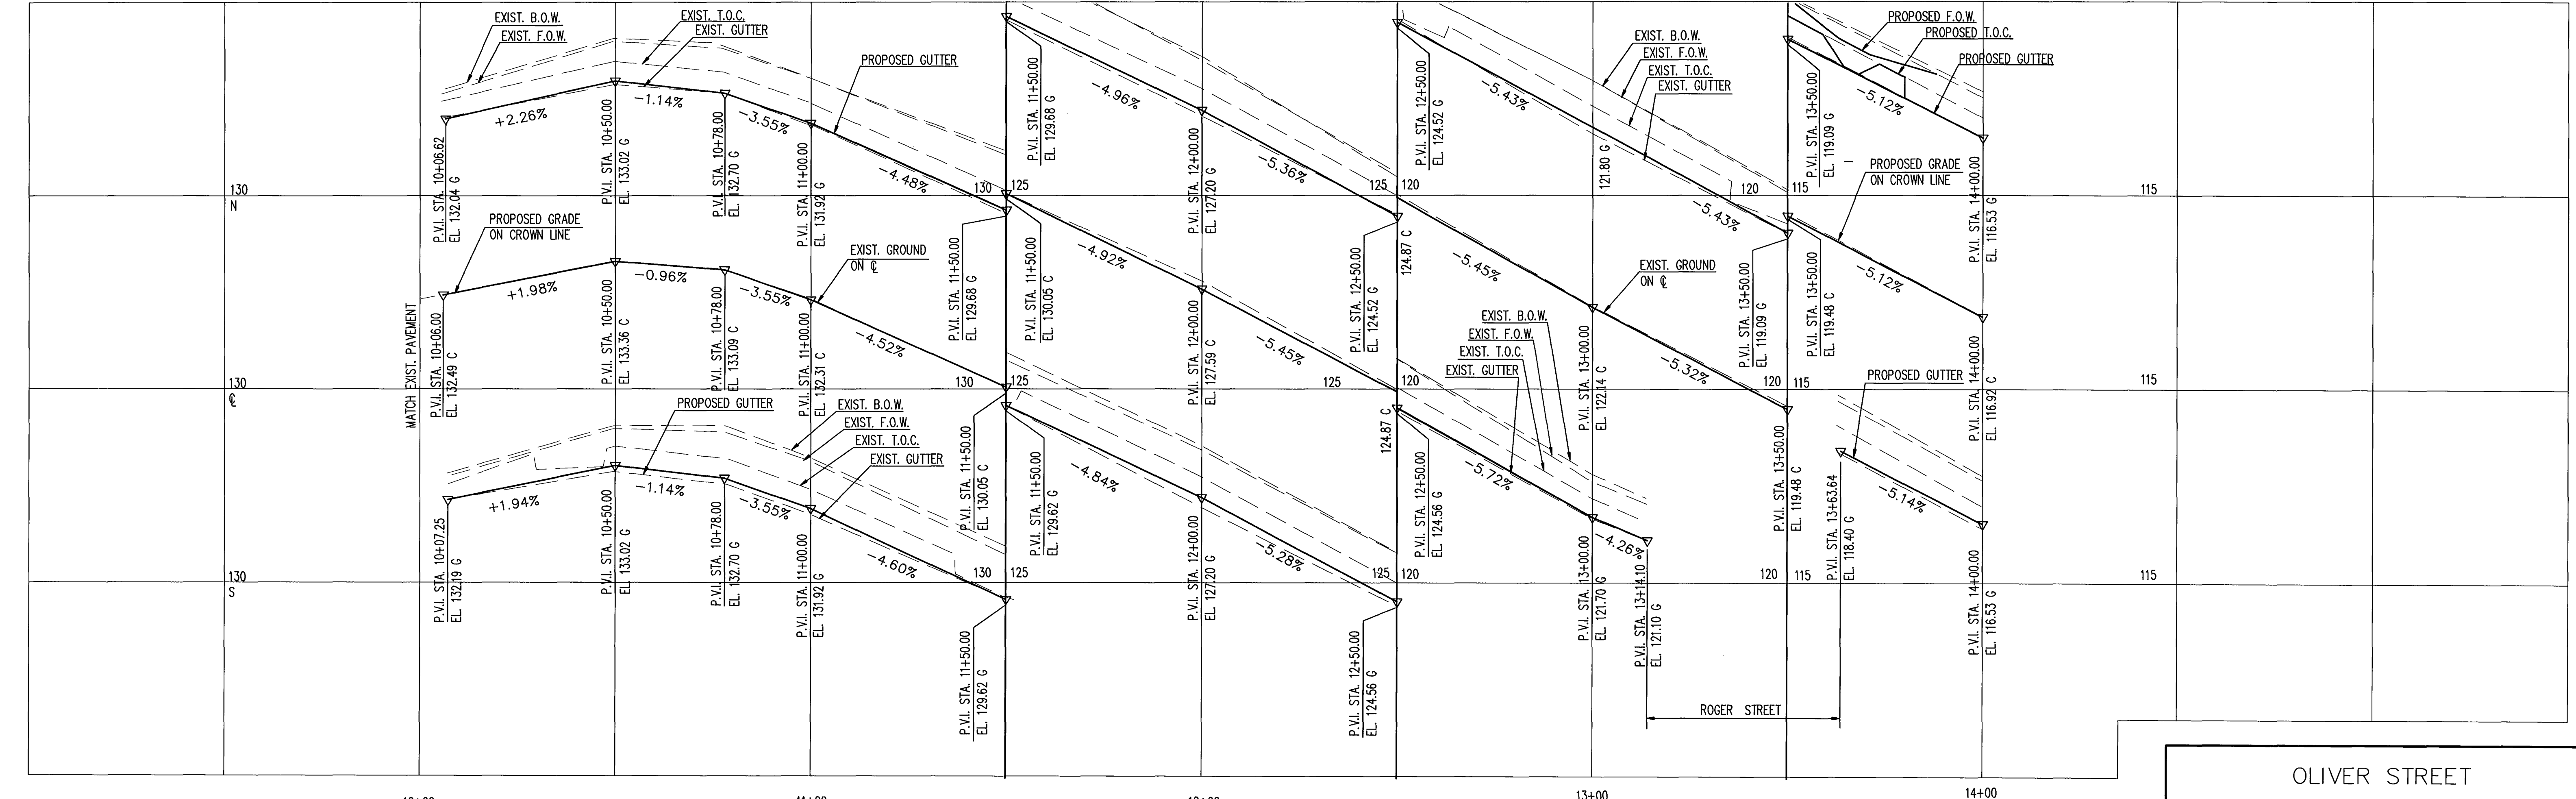

NO.		DATE	REVISION
1			
2			
3			
4			
5			
6			
7			
8			
9			
10			

DESIGNED: M.M.M.	DATE: MAY 14, 1990
DRAWN: T.N.S.	SCALE: AS NOTED
CHECKED: A.M.	
APPROVED: R.C.G.	

OLIVER STREET	
PLAN AND PROFILE	
THE CITY OF HARTFORD, CONNECTICUT	
PURCELL ASSOCIATES	
SHEET NO. 10 OF 11	DAYBOOK NO. 011210B