



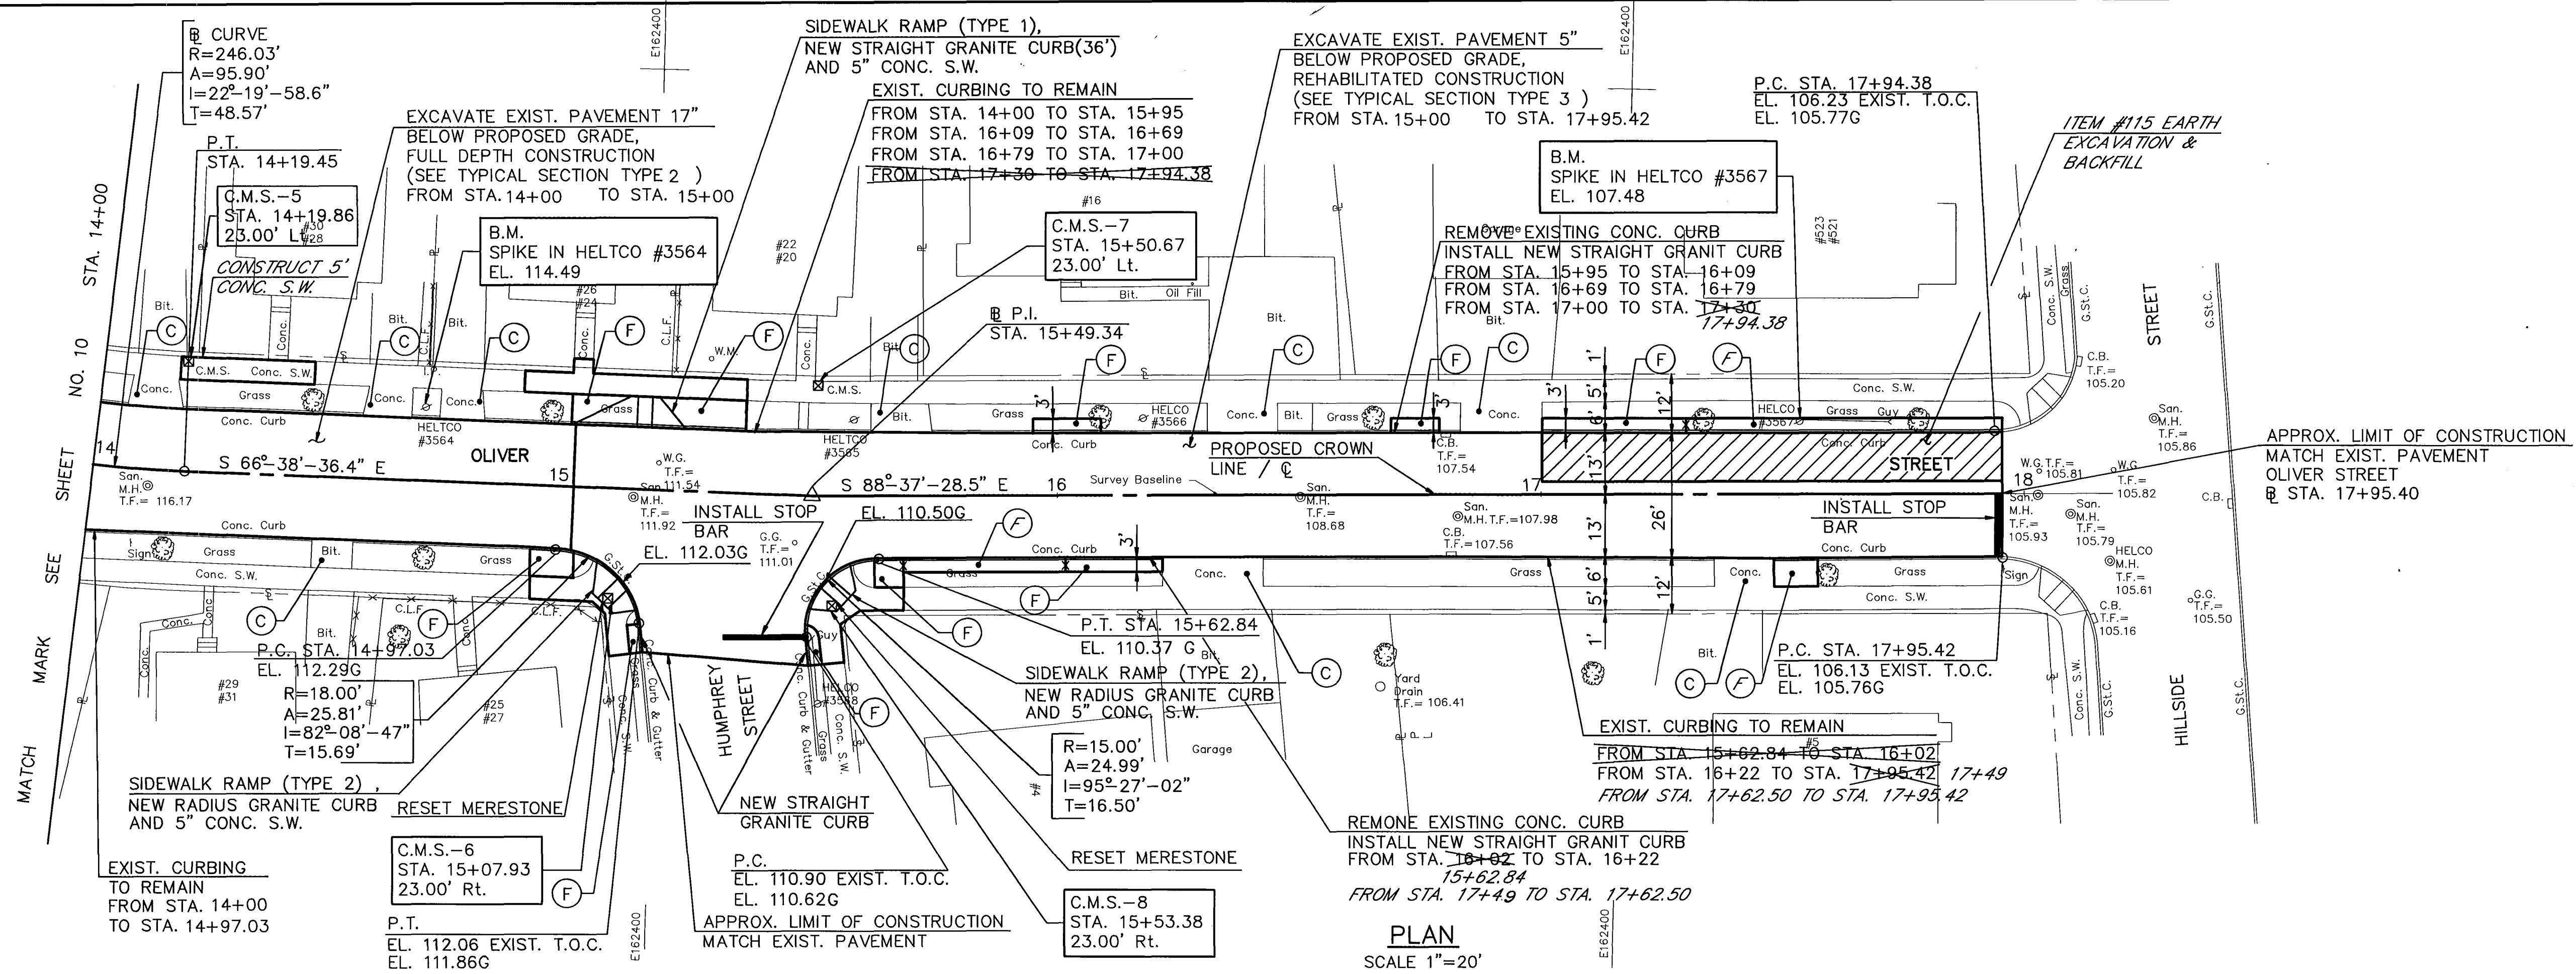

NOTES:

1. (C) EXISTING DRIVEWAY RAMP TO REMAIN.
2. (F) SEEDING AND MULCHING.
3. FOR GENERAL NOTES AND LIST OF ABBREVIATIONS, SEE SHEET NO. 2.
4. FOR CONSTRUCTION NOTES SEE SHEET NO. 5.
5. SURVEY BASELINE IS LOCATED 23.00 FT. SOUTH OF C.M.S.-5.

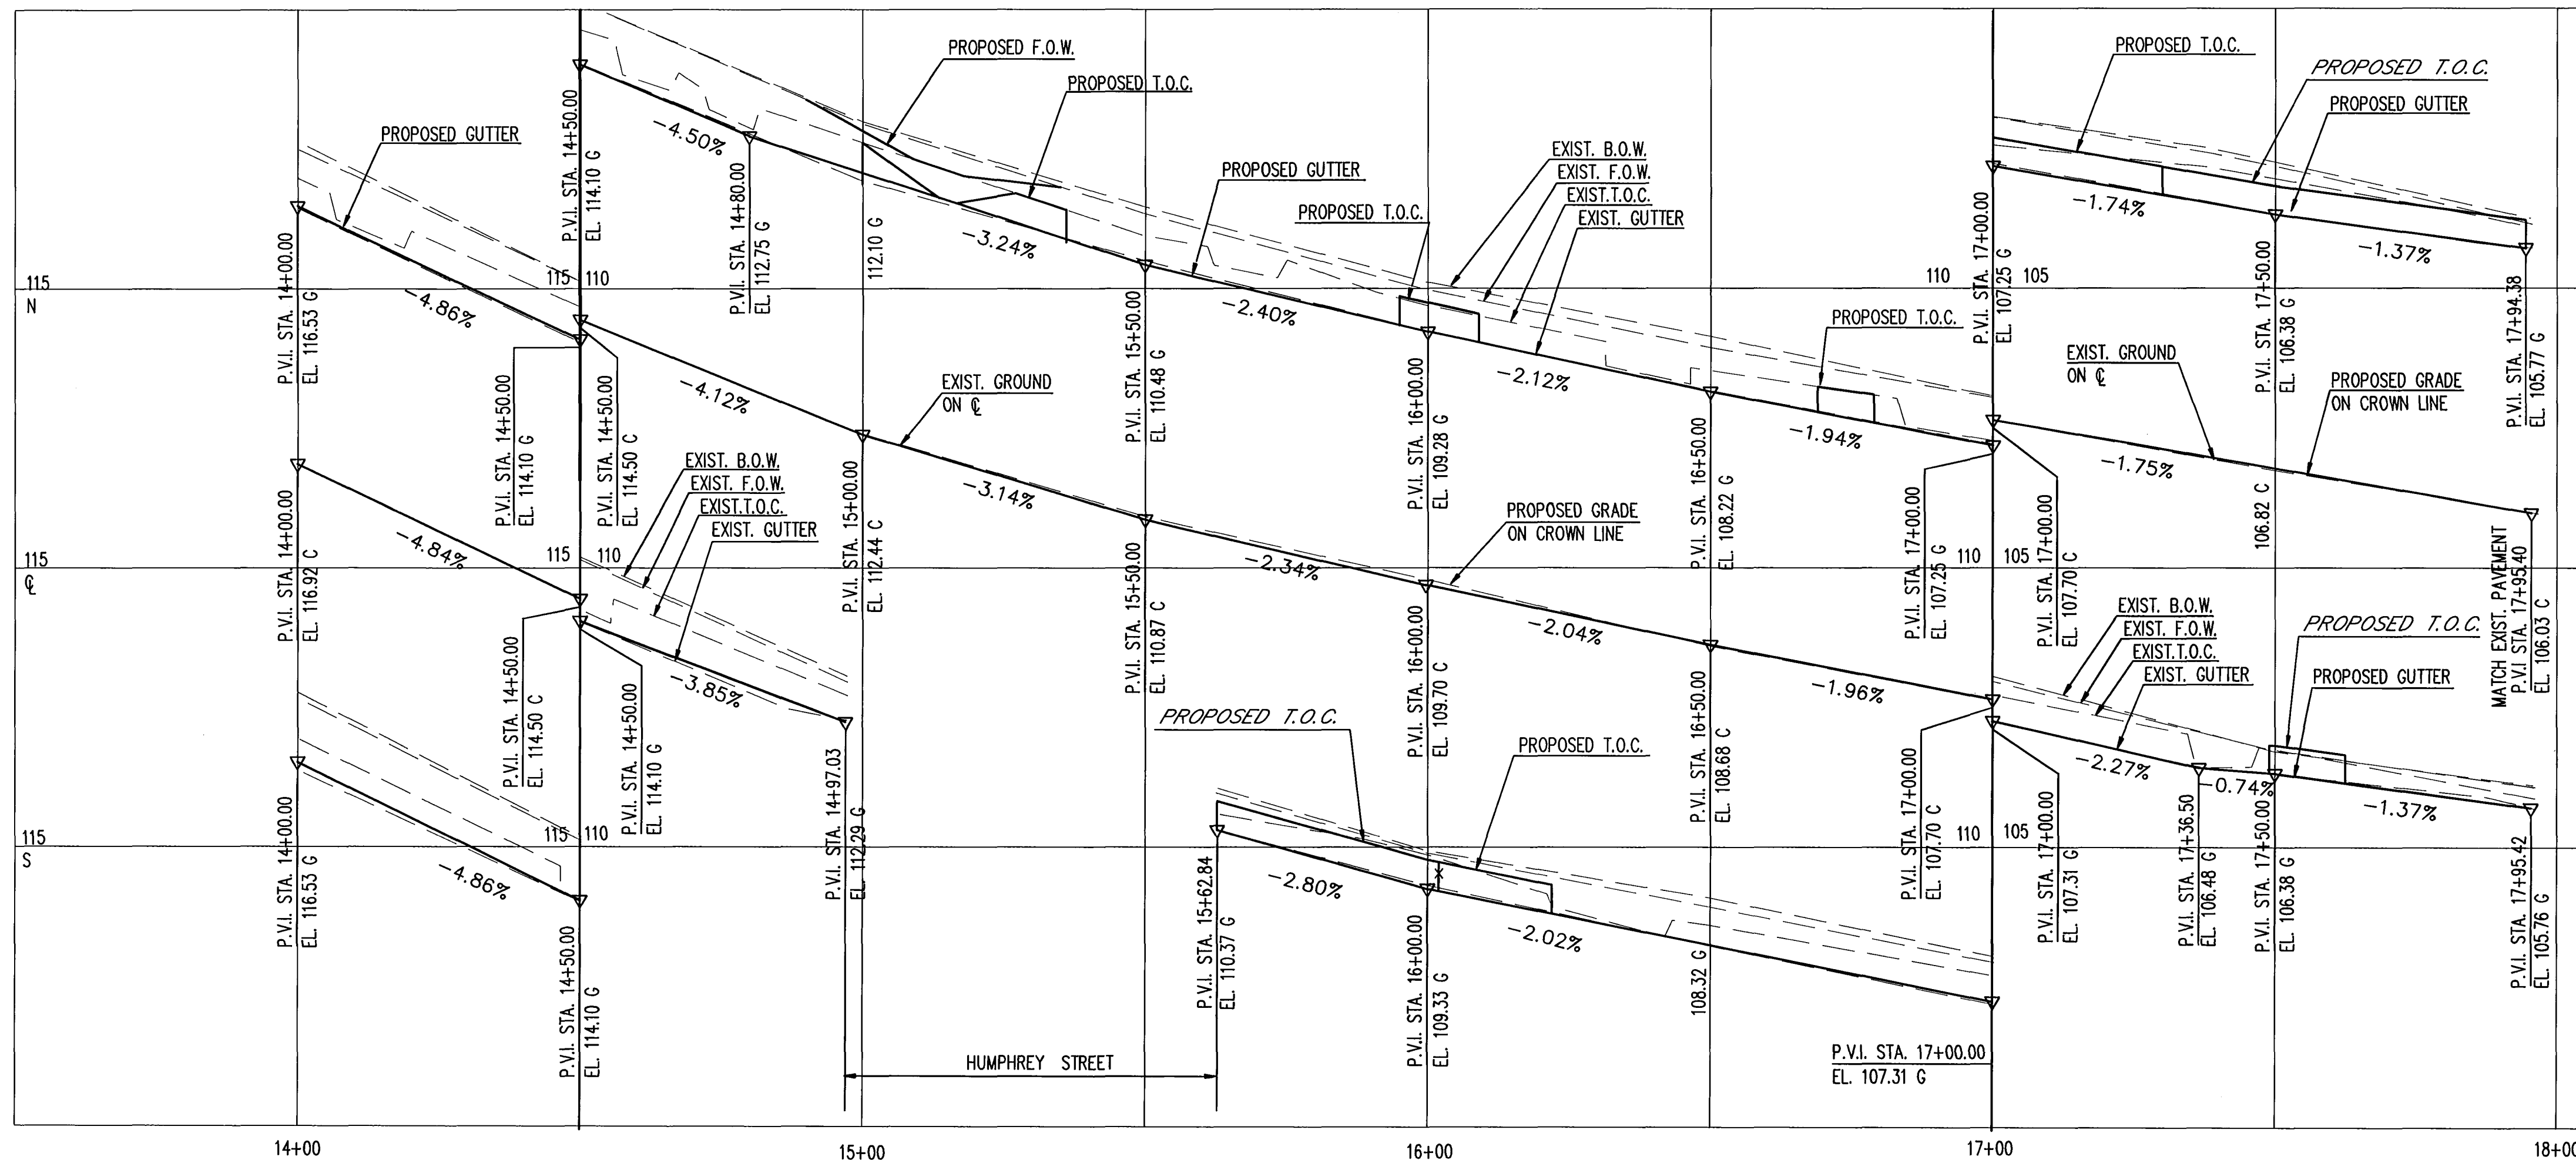

OLIVER STREET

PLAN AND PROFILE

THE CITY OF
HARTFORD, CONNECTICUT

NO.	DATE	REVISION
DESIGNED: M.M.M.		
DRAWN: T.N.S.		
CHECKED: A.M.		
APPROVED: R.C.G.		
DATE: MAY 14, 1990		
SCALE: AS NOTED		

PURCELL
ASSOCIATESSHEET NO.
11 OF 11
DAYBOOK NO.
011210B