


2/607

2/607

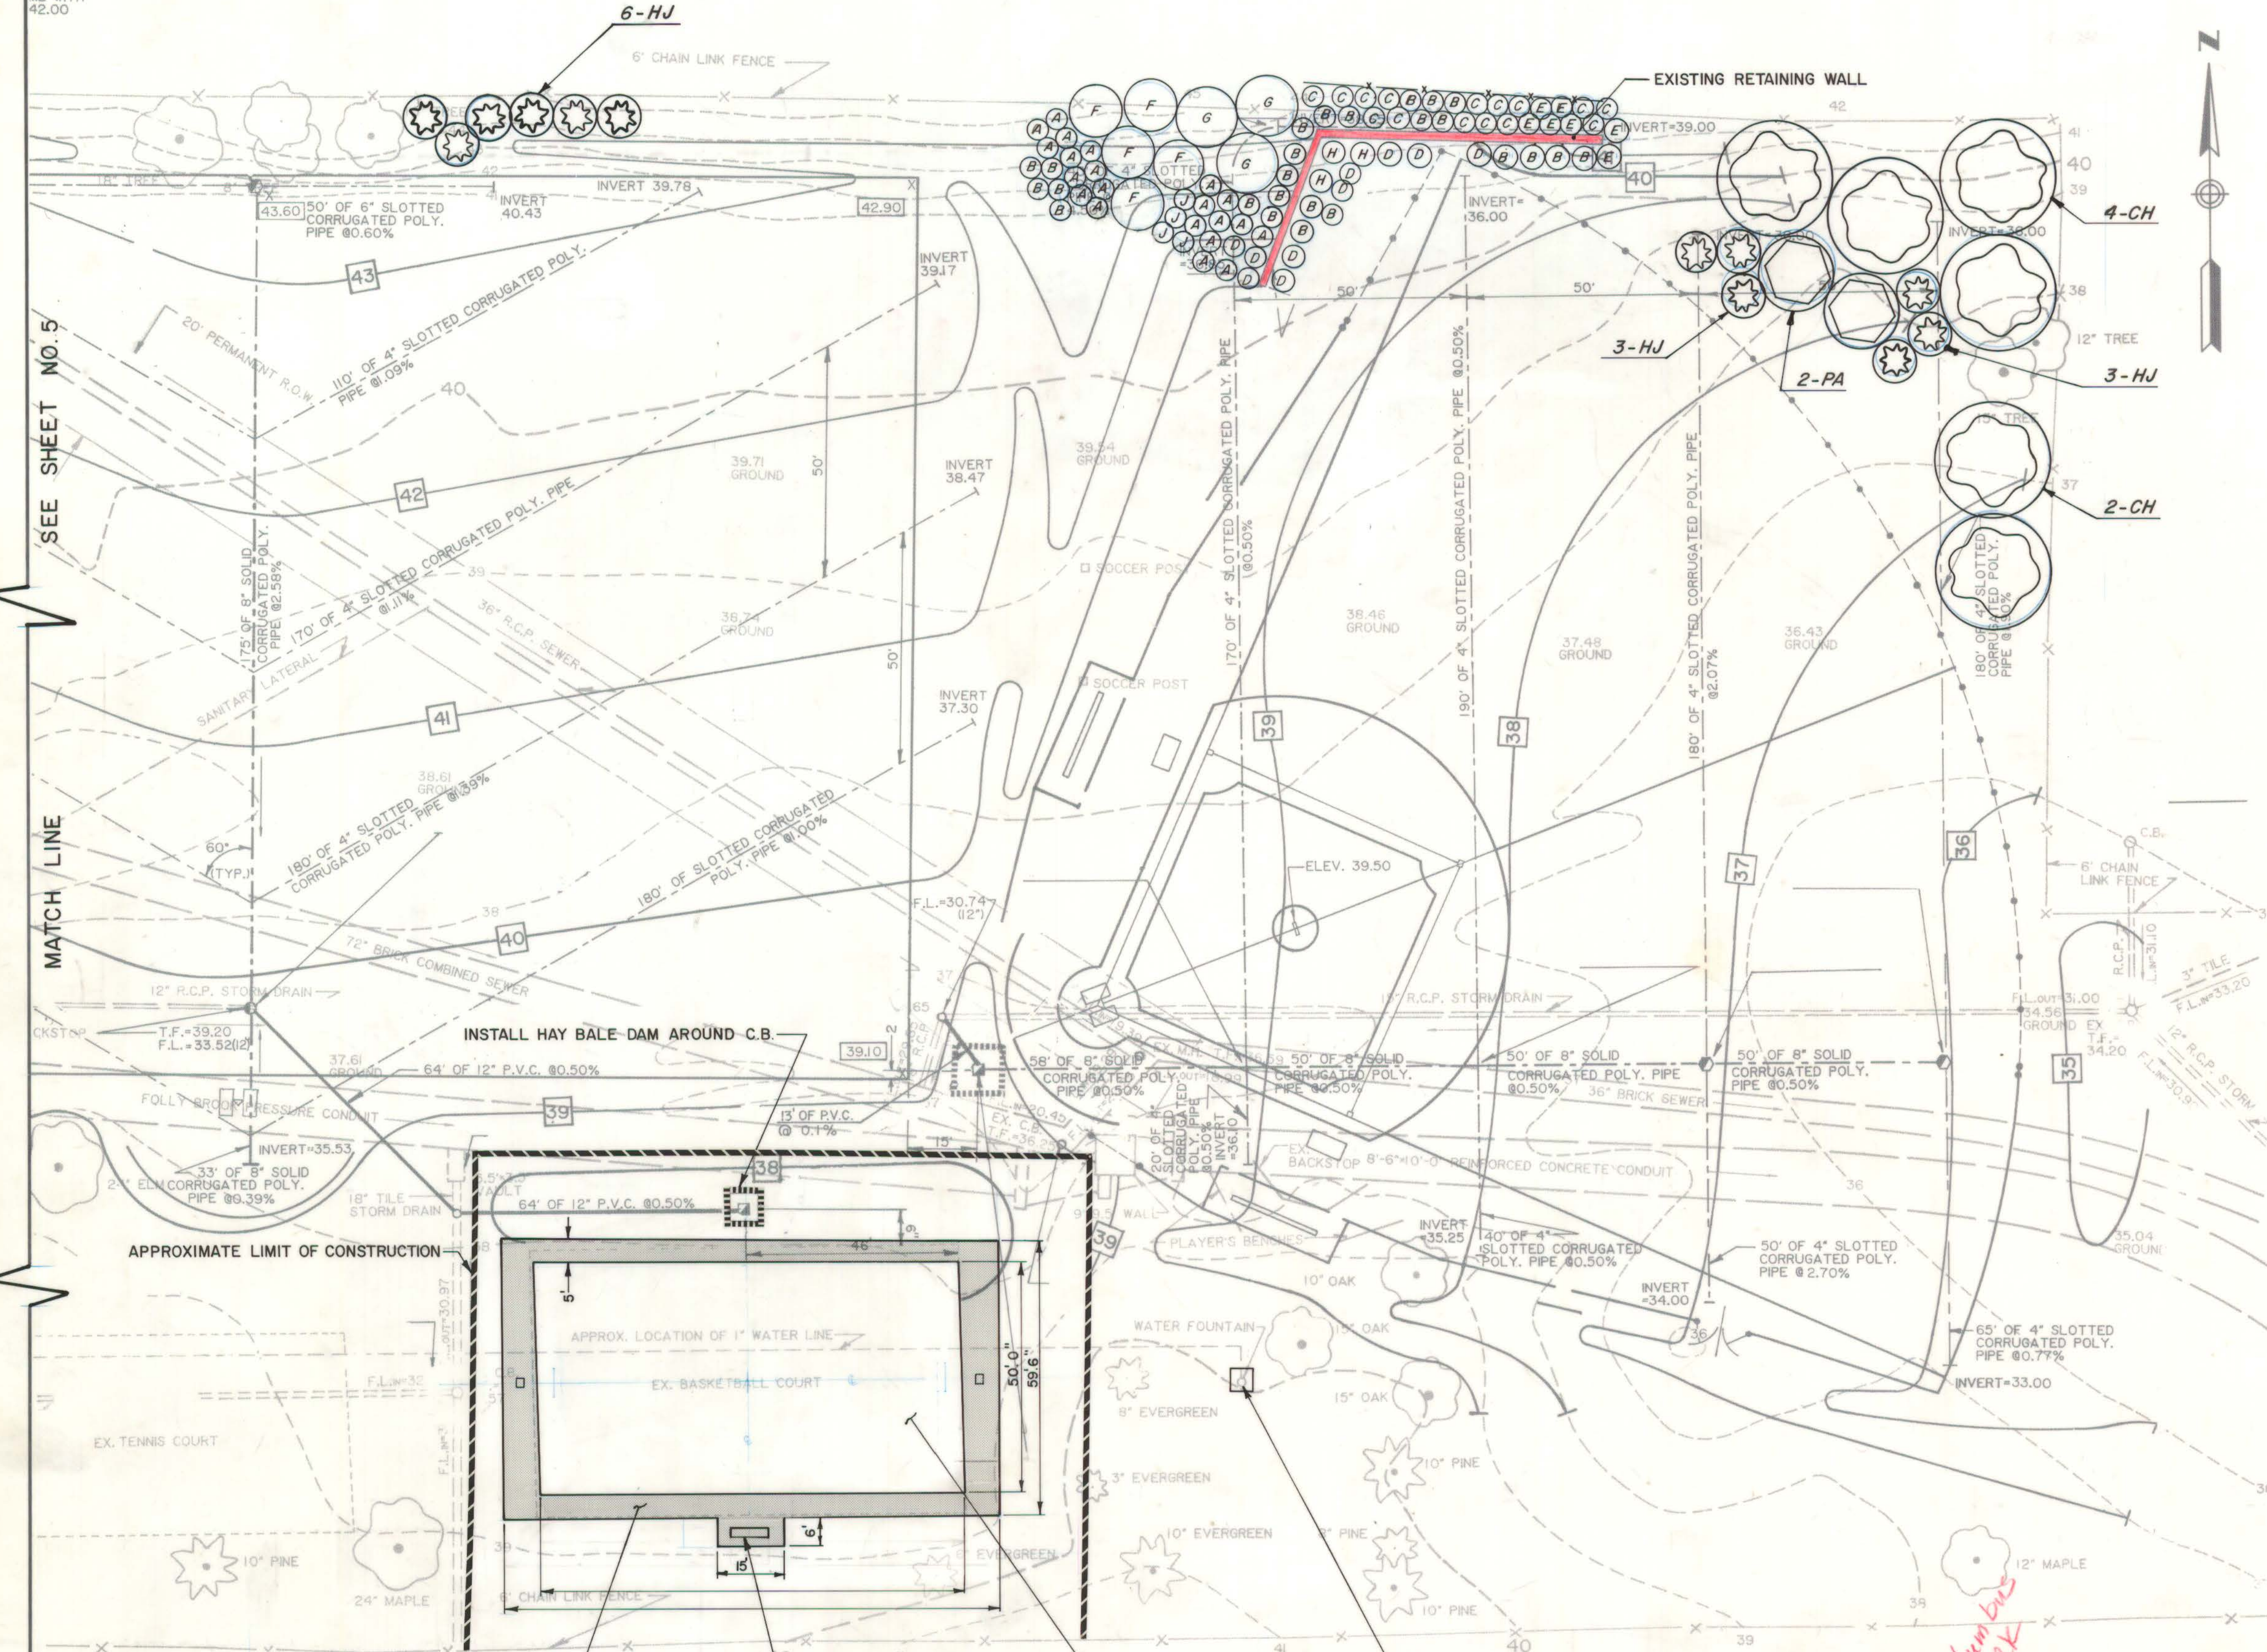

RETAINING WALL AREA SHRUBS SCHEDULE				
SYMBOL	QUANT.	COMMON NAME	DISTANCE APART	SIZE
A	20	J. CHINENSIS PHITZERIANA	6'-0"	2'- 2 1/2'
B	25	JAPANESE RED LEAVED BARBERRY	6'-0"	18"-24"
C	14	J. CHINENSIS PHITZERIANA NANA	6'-0"	18"-24"
D	10	PYRACANTHA COCCINEA LOWBOY	6'-0"	5 GAL.
E	7	RUGOSA ROSE WHITE	6'-0"	18"-24"
F	5	JUNIPERS HETZI JUNIPER	10'-0"	2'- 2 1/2'
G	3	ROSA MULTIFLORA	6'-0"	2 YR.
H	3	RUGOSA ROSE PINK	6'-0"	18"-24"
J	3	J. CHINENSIS MOUNTBATTEN	10'-0"	3'-4'

PLANTING TREES & SHRUBS SCHEDULE				
QUANT.	SYMBOL	COMMON NAME	SPACE	SIZE
DECIDUOUS TREES				
3	PD	DOGWOOD	AS SHOWN	6'-7"HT.
1	WD	WHITE DOGWOOD	AS SHOWN	6'-7"HT.
1	BC	BIRCH CLUMP	AS SHOWN	4'-5"HT.
EVERGREEN TREES				
9	MSC	MOSS SAWARA CYPRESS	20'	5'-6"HT.
5	PA	DOUGLAS PYRAMIDAL ARBORVITAE	15'	3'-4"HT.
1	WMP	WEeping WHITE PINE	AS SHOWN	6'-7"HT.
6	CH	CANADIAN HEMLOCK	25'	4'-5"HT.
DECIDUOUS SHRUBS				
2	OH	OAKLEAF HYDRANGA	6'	2 YR.
EVERGREEN SHRUBS				
14	SC	SPREADING COTONEASTEN DIVARICATUS	7'	3'-4"SPD.
10	CPJ	COMPACT PHITZER JUNIPER	7'	2'-2.5"SPD.
19	HJ	HETZ GLAUCA JUNIPER	10'	3'-4"SPD.
35	AJ	COMPACT ANDORRA JUNIPER	5'	15"-18"SPD
14	ML	MOUNTAIN LAUREL	5'	18"-24"SPD.
21	HY	HICKS YEW	5'	15"-18"SPD
10	HH	HELLERIS HOLLY	5'	15"-18"SPD
6	RC	ROCK COTONEASTEN	4'	15"-18"SPD

EXCAVATE 11" INSTALL 9" OF PROCESSED TRAP-ROCK BASE AND 2" ± OF BIT. CONC. CLASS 2.

INSTALL ATHLETIC BENCH

STRIFE 2" ± BIT. CONC., COMPACT SUBBASE AS REQUIRED, AND OVERLAY ENTIRE COURT WITH 2" ± BIT. CONC. CLASS 2

REMOVE EXISTING WATER FOUNTAIN AND REPLACE BY NEW WHEELCHAIR ACCESSIBLE WATER FOUNTAIN

APPROVED: *Bernard E. Gaurin* 2/10/92
CITY OF HARTFORD PARKS AND RECREATION DEPT. DATE

CITY OF HARTFORD, CONNECTICUT
DEPARTMENT OF PUBLIC WORKS
BUREAU OF ENGINEERING SERVICES

SITE LAYOUT
AND
INSTALLATION PLAN

SUBMITTED
Bernard E. Gaurin
PROJECT ENGINEER

RECOMMENDED
[Signature]
DIVISION MANAGER

APPROVED
2/18/92
[Signature]
CITY ENGINEER

SHEET NO.
6 OF 6

DRAWN L.A.L.G.S.
CHECKED H.J.O.

SCALE
1" = 20'-0"

DAYBOOK NO. 010751
DATE: FEBRUARY, 1992