


PLAN	DATE	BY	CHECKED BY
PLAN	4/1/88	AA	AA
NOTEBOOK	4/1/88	AA	AA
NO.			

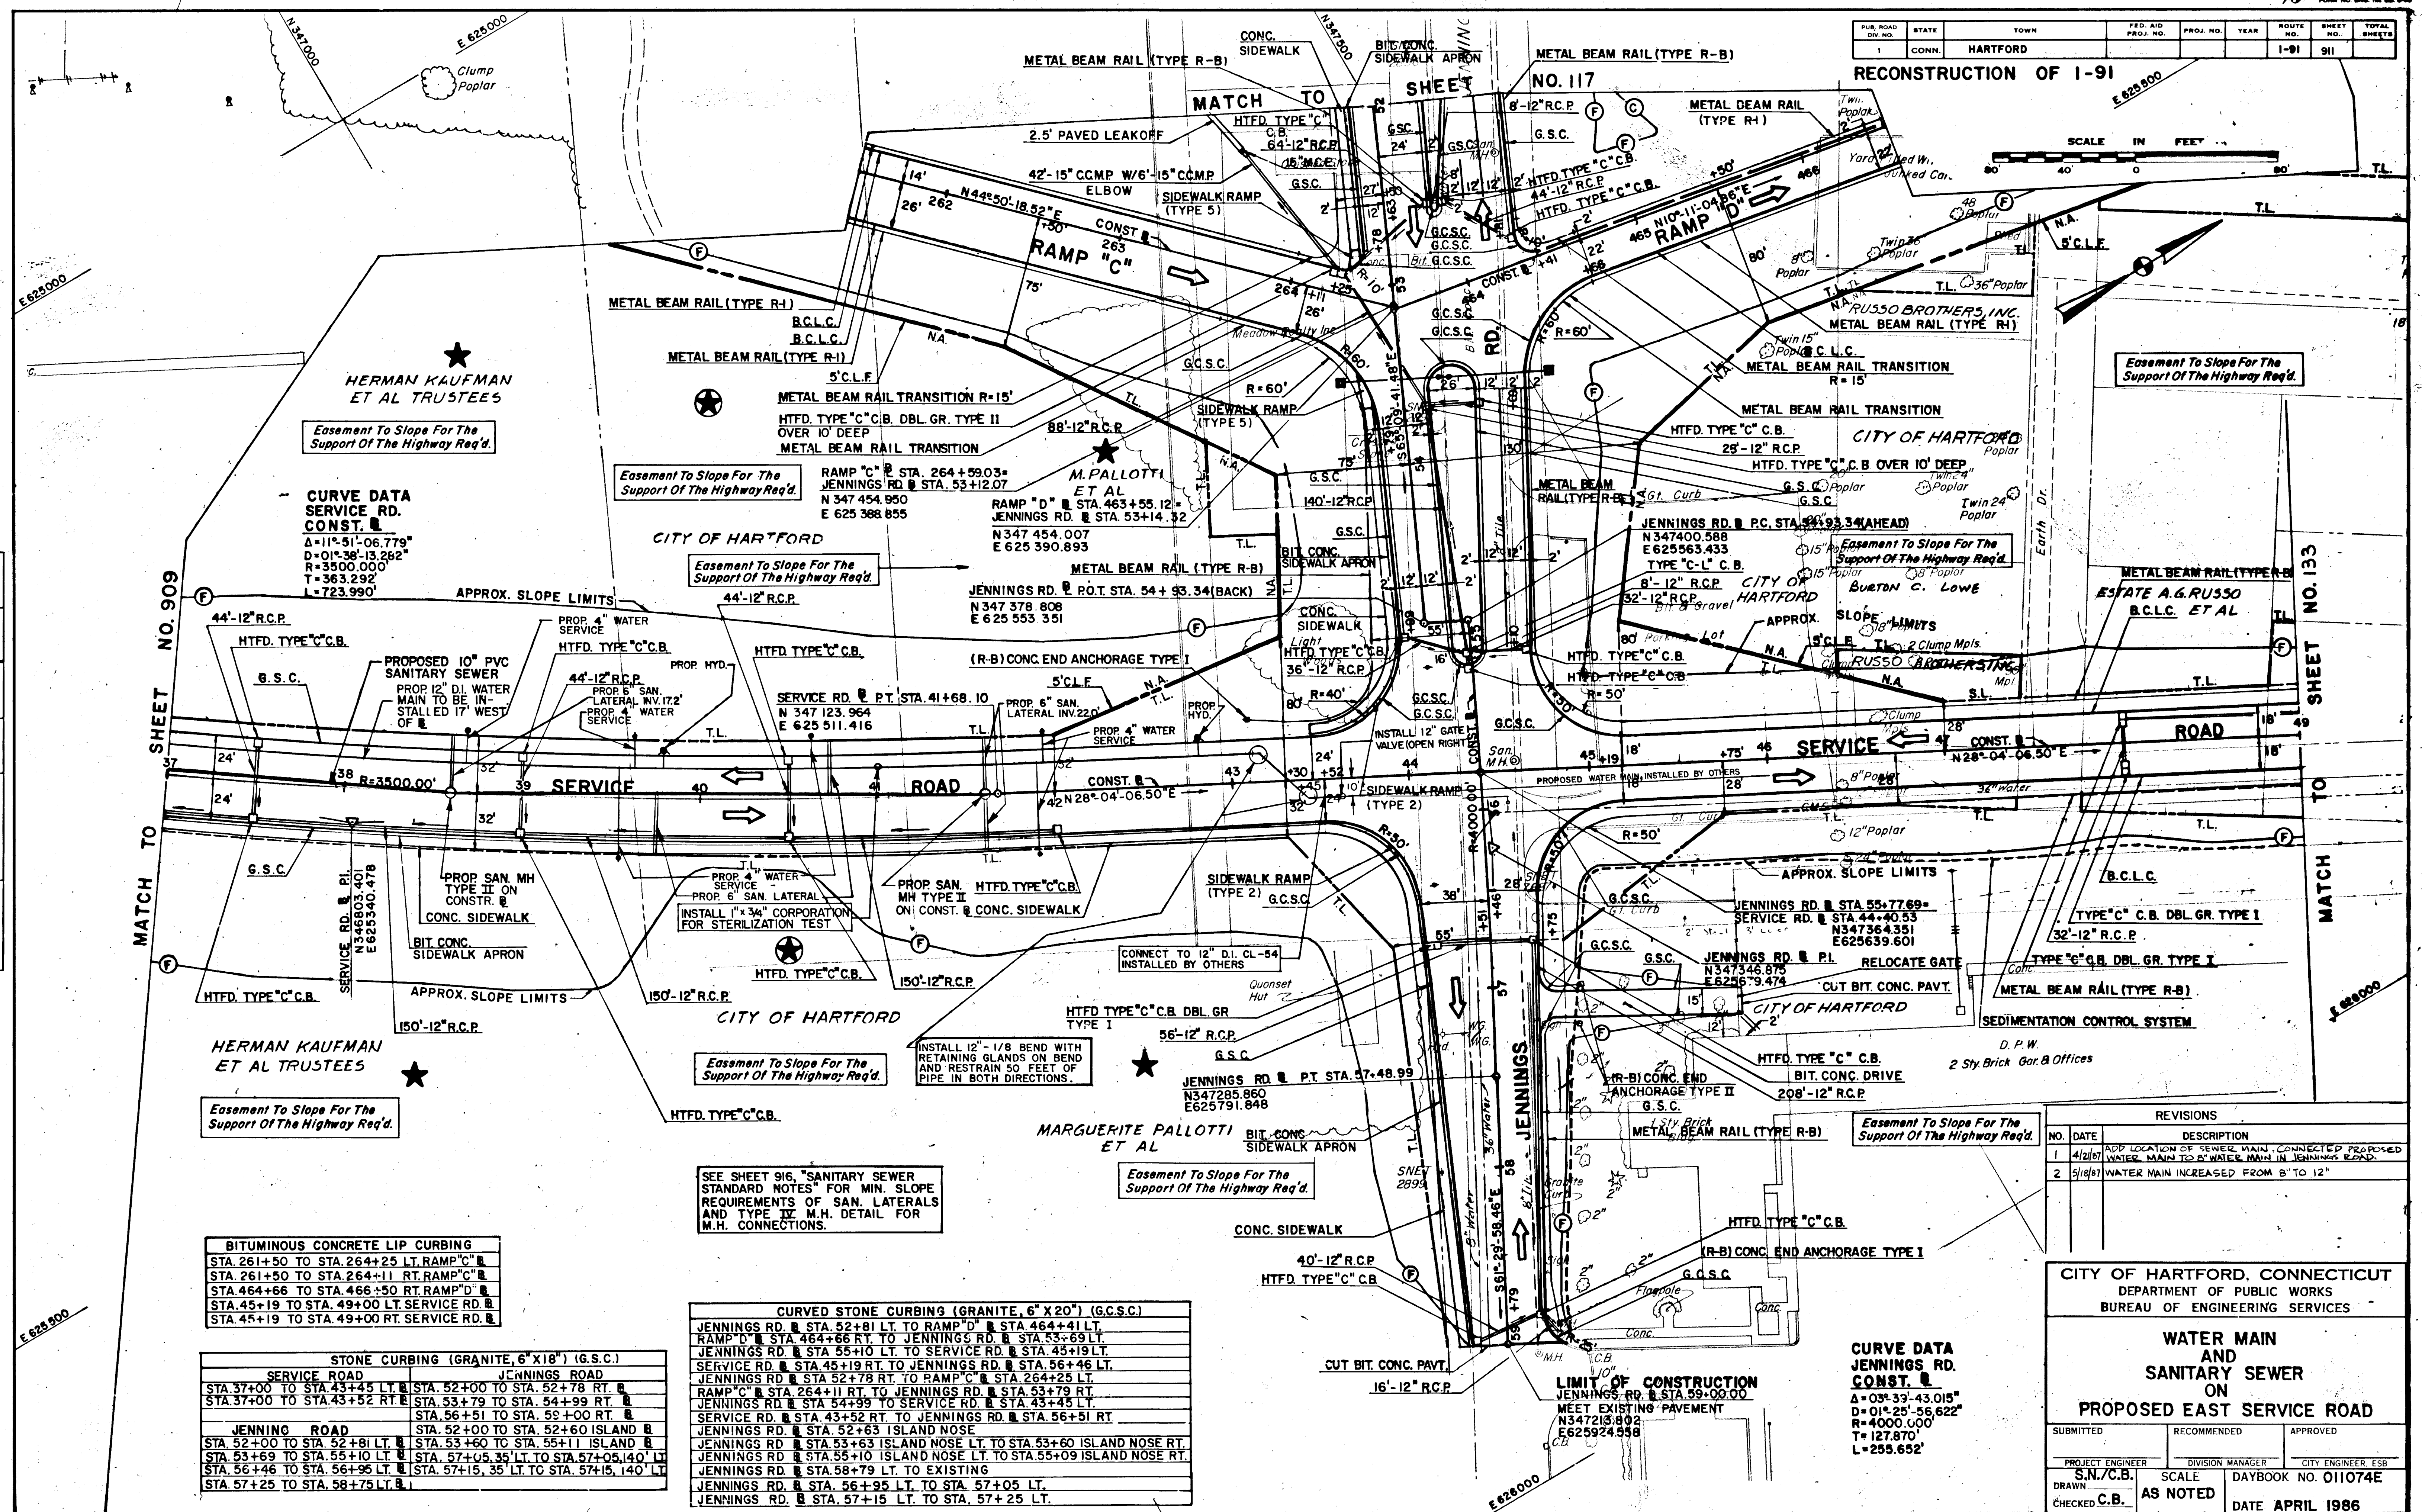

CURVE DATA SERVICE RD. CONST.
 A=11°31'-06.77°
 D=01°38'-13.28°
 R=3500.000'
 L=363.292'
 T=723.990'

HERMAN KAUFMAN ET AL TRUSTEES
 Easement To Slope For The Support Of The Highway Req'd.

BITUMINOUS CONCRETE LIP CURBING
 STA. 261+50 TO STA. 264+25 LT. RAMP "C"
 STA. 261+50 TO STA. 264+11 RT. RAMP "C"
 STA. 464+66 TO STA. 466+50 RT. RAMP "D"
 STA. 45+19 TO STA. 49+00 LT. SERVICE RD.
 STA. 45+19 TO STA. 49+00 RT. SERVICE RD.

STONE CURBING (GRANITE, 6" X 18") (G.S.C.)
SERVICE ROAD
 STA. 37+00 TO STA. 43+45 LT.
 STA. 37+00 TO STA. 43+52 RT.
JENNINGS ROAD
 STA. 52+00 TO STA. 52+81 LT.
 STA. 52+00 TO STA. 52+60 ISLAND
 STA. 53+69 TO STA. 55+10 LT.
 STA. 56+46 TO STA. 56+95 LT.
 STA. 57+25 TO STA. 58+75 LT.

CURVED STONE CURBING (GRANITE, 6" X 20") (G.S.C.)
 JENNINGS RD. STA. 52+81 LT. TO RAMP "D" STA. 464+41 LT.
 RAMP "D" STA. 464+66 RT. TO JENNINGS RD. STA. 53+69 LT.
 JENNINGS RD. STA. 55+10 LT. TO SERVICE RD. STA. 45+19 LT.
 SERVICE RD. STA. 45+19 RT. TO JENNINGS RD. STA. 56+46 LT.
 JENNINGS RD. STA. 52+78 RT. TO RAMP "C" STA. 264+25 LT.
 RAMP "C" STA. 264+11 RT. TO JENNINGS RD. STA. 53+79 RT.
 JENNINGS RD. STA. 54+99 TO SERVICE RD. STA. 43+45 LT.
 SERVICE RD. STA. 43+52 RT. TO JENNINGS RD. STA. 56+51 RT.
 JENNINGS RD. STA. 52+63 ISLAND NOSE
 JENNINGS RD. STA. 53+63 ISLAND NOSE LT. TO STA. 53+60 ISLAND NOSE RT.
 JENNINGS RD. STA. 55+10 ISLAND NOSE LT. TO STA. 55+09 ISLAND NOSE RT.
 JENNINGS RD. STA. 58+79 LT. TO EXISTING
 JENNINGS RD. STA. 56+95 LT. TO STA. 57+05 LT.
 JENNINGS RD. STA. 57+15 LT. TO STA. 57+25 LT.

CURVE DATA JENNINGS RD. CONST.
 A=03°39'-43.01°
 D=01°25'-56.62°
 R=4000.000'
 L=127.870'
 T=255.652'

NO.	DATE	DESCRIPTION
1	4/2/88	ADD LOCATION OF SEWER MAIN, CONNECTED PROPOSED WATER MAIN TO B' WATER MAIN IN JENNINGS ROAD.
2	5/18/88	WATER MAIN INCREASED FROM 8" TO 12"

CITY OF HARTFORD, CONNECTICUT
 DEPARTMENT OF PUBLIC WORKS
 BUREAU OF ENGINEERING SERVICES

WATER MAIN AND SANITARY SEWER ON PROPOSED EAST SERVICE ROAD		
SUBMITTED	RECOMMENDED	APPROVED
PROJECT ENGINEER	DIVISION MANAGER	CITY ENGINEER, ESB
S.N./C.B.	SCALE	DAYBOOK NO. 011074E
DRAWN	AS NOTED	DATE
CHECKED C.B.		APRIL 1988