


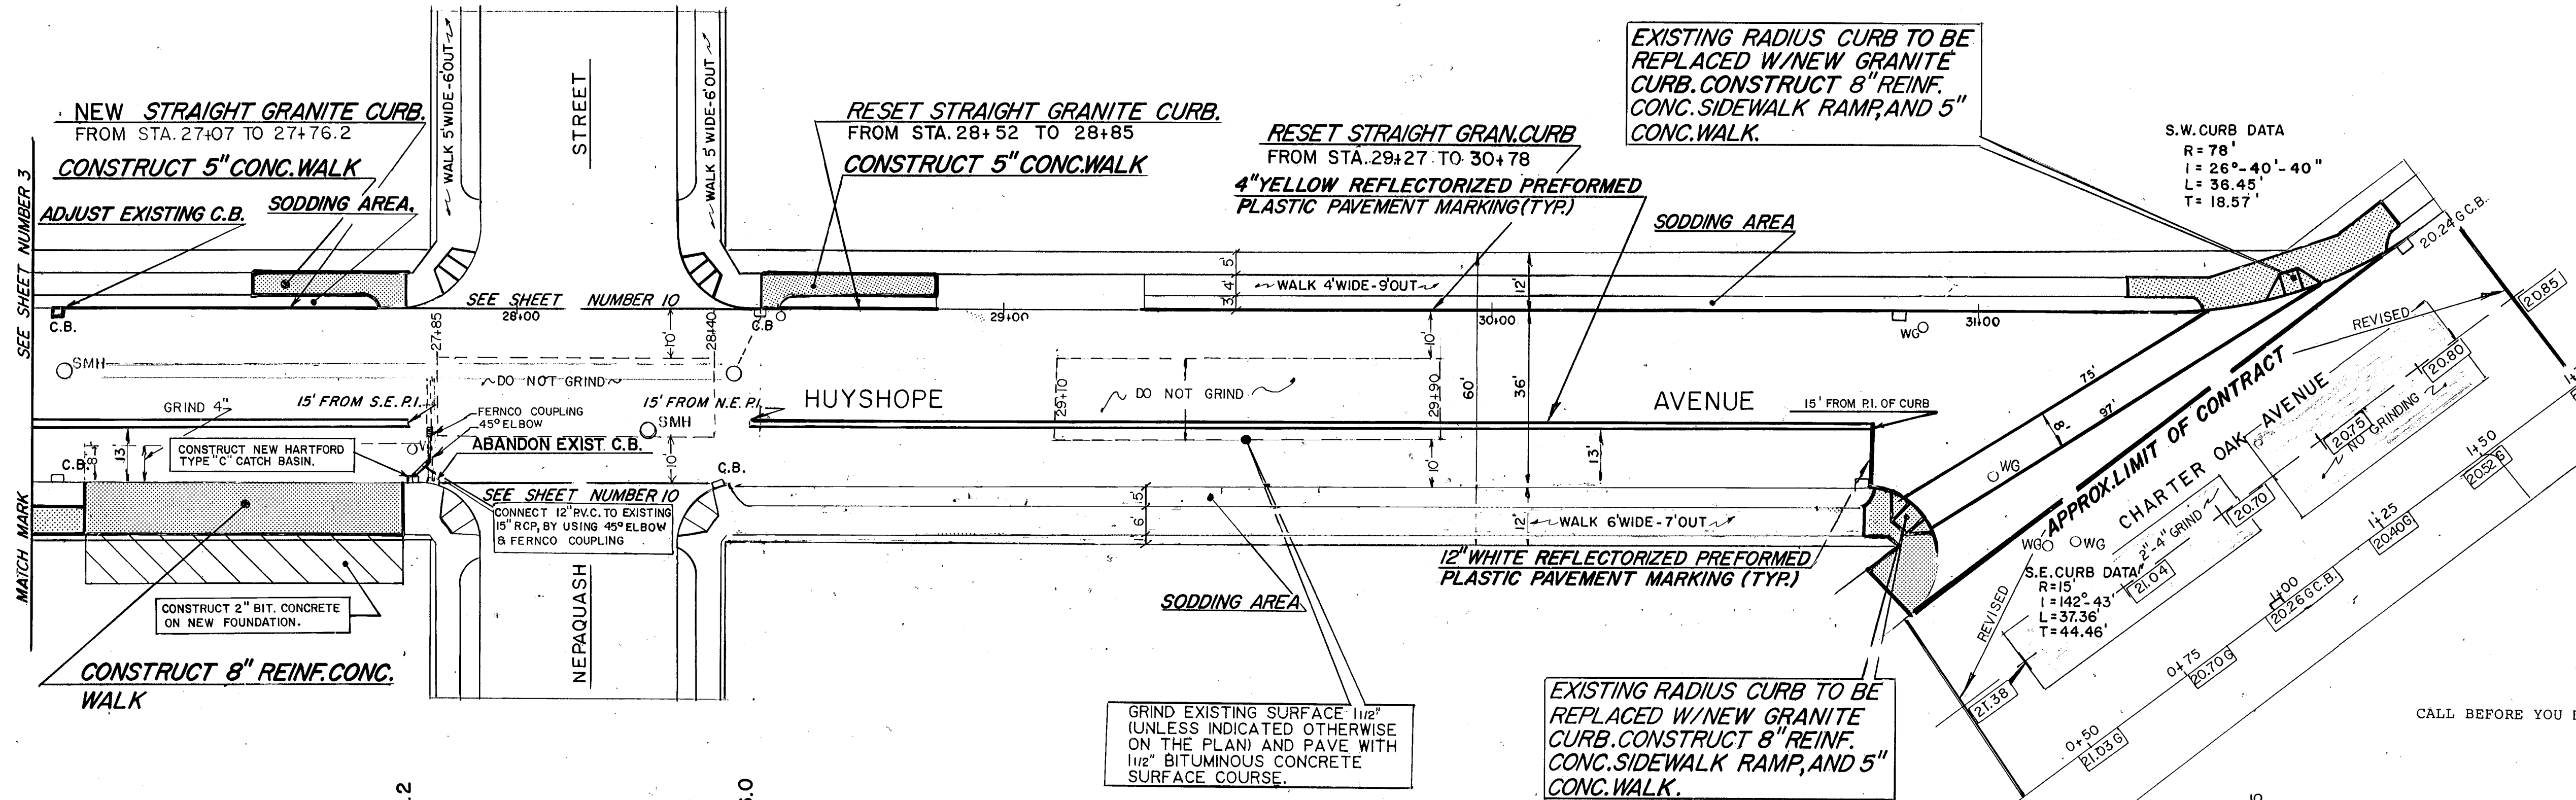

NOTE: BENCH MARK S.W. CORNER AT TOP OF BROWN STONE W.T. "BLISS HOUSE" CHARTER OAK AVE. STATIONS MEASURED ON SLOPE OF WEST CURB LINE.

CALL BEFORE YOU DIG - The contractor is hereby reminded that Public Act 87-71 requires notification to the Department of Public Utility or Central Clearing House of proposed excavation, orally or in writing, at least two full days, excluding Saturdays, Sundays and holidays but not more than (one month) THIRTY DAYS before commencing said excavation. C.B.Y.D. number- 1-800-922-4455

