



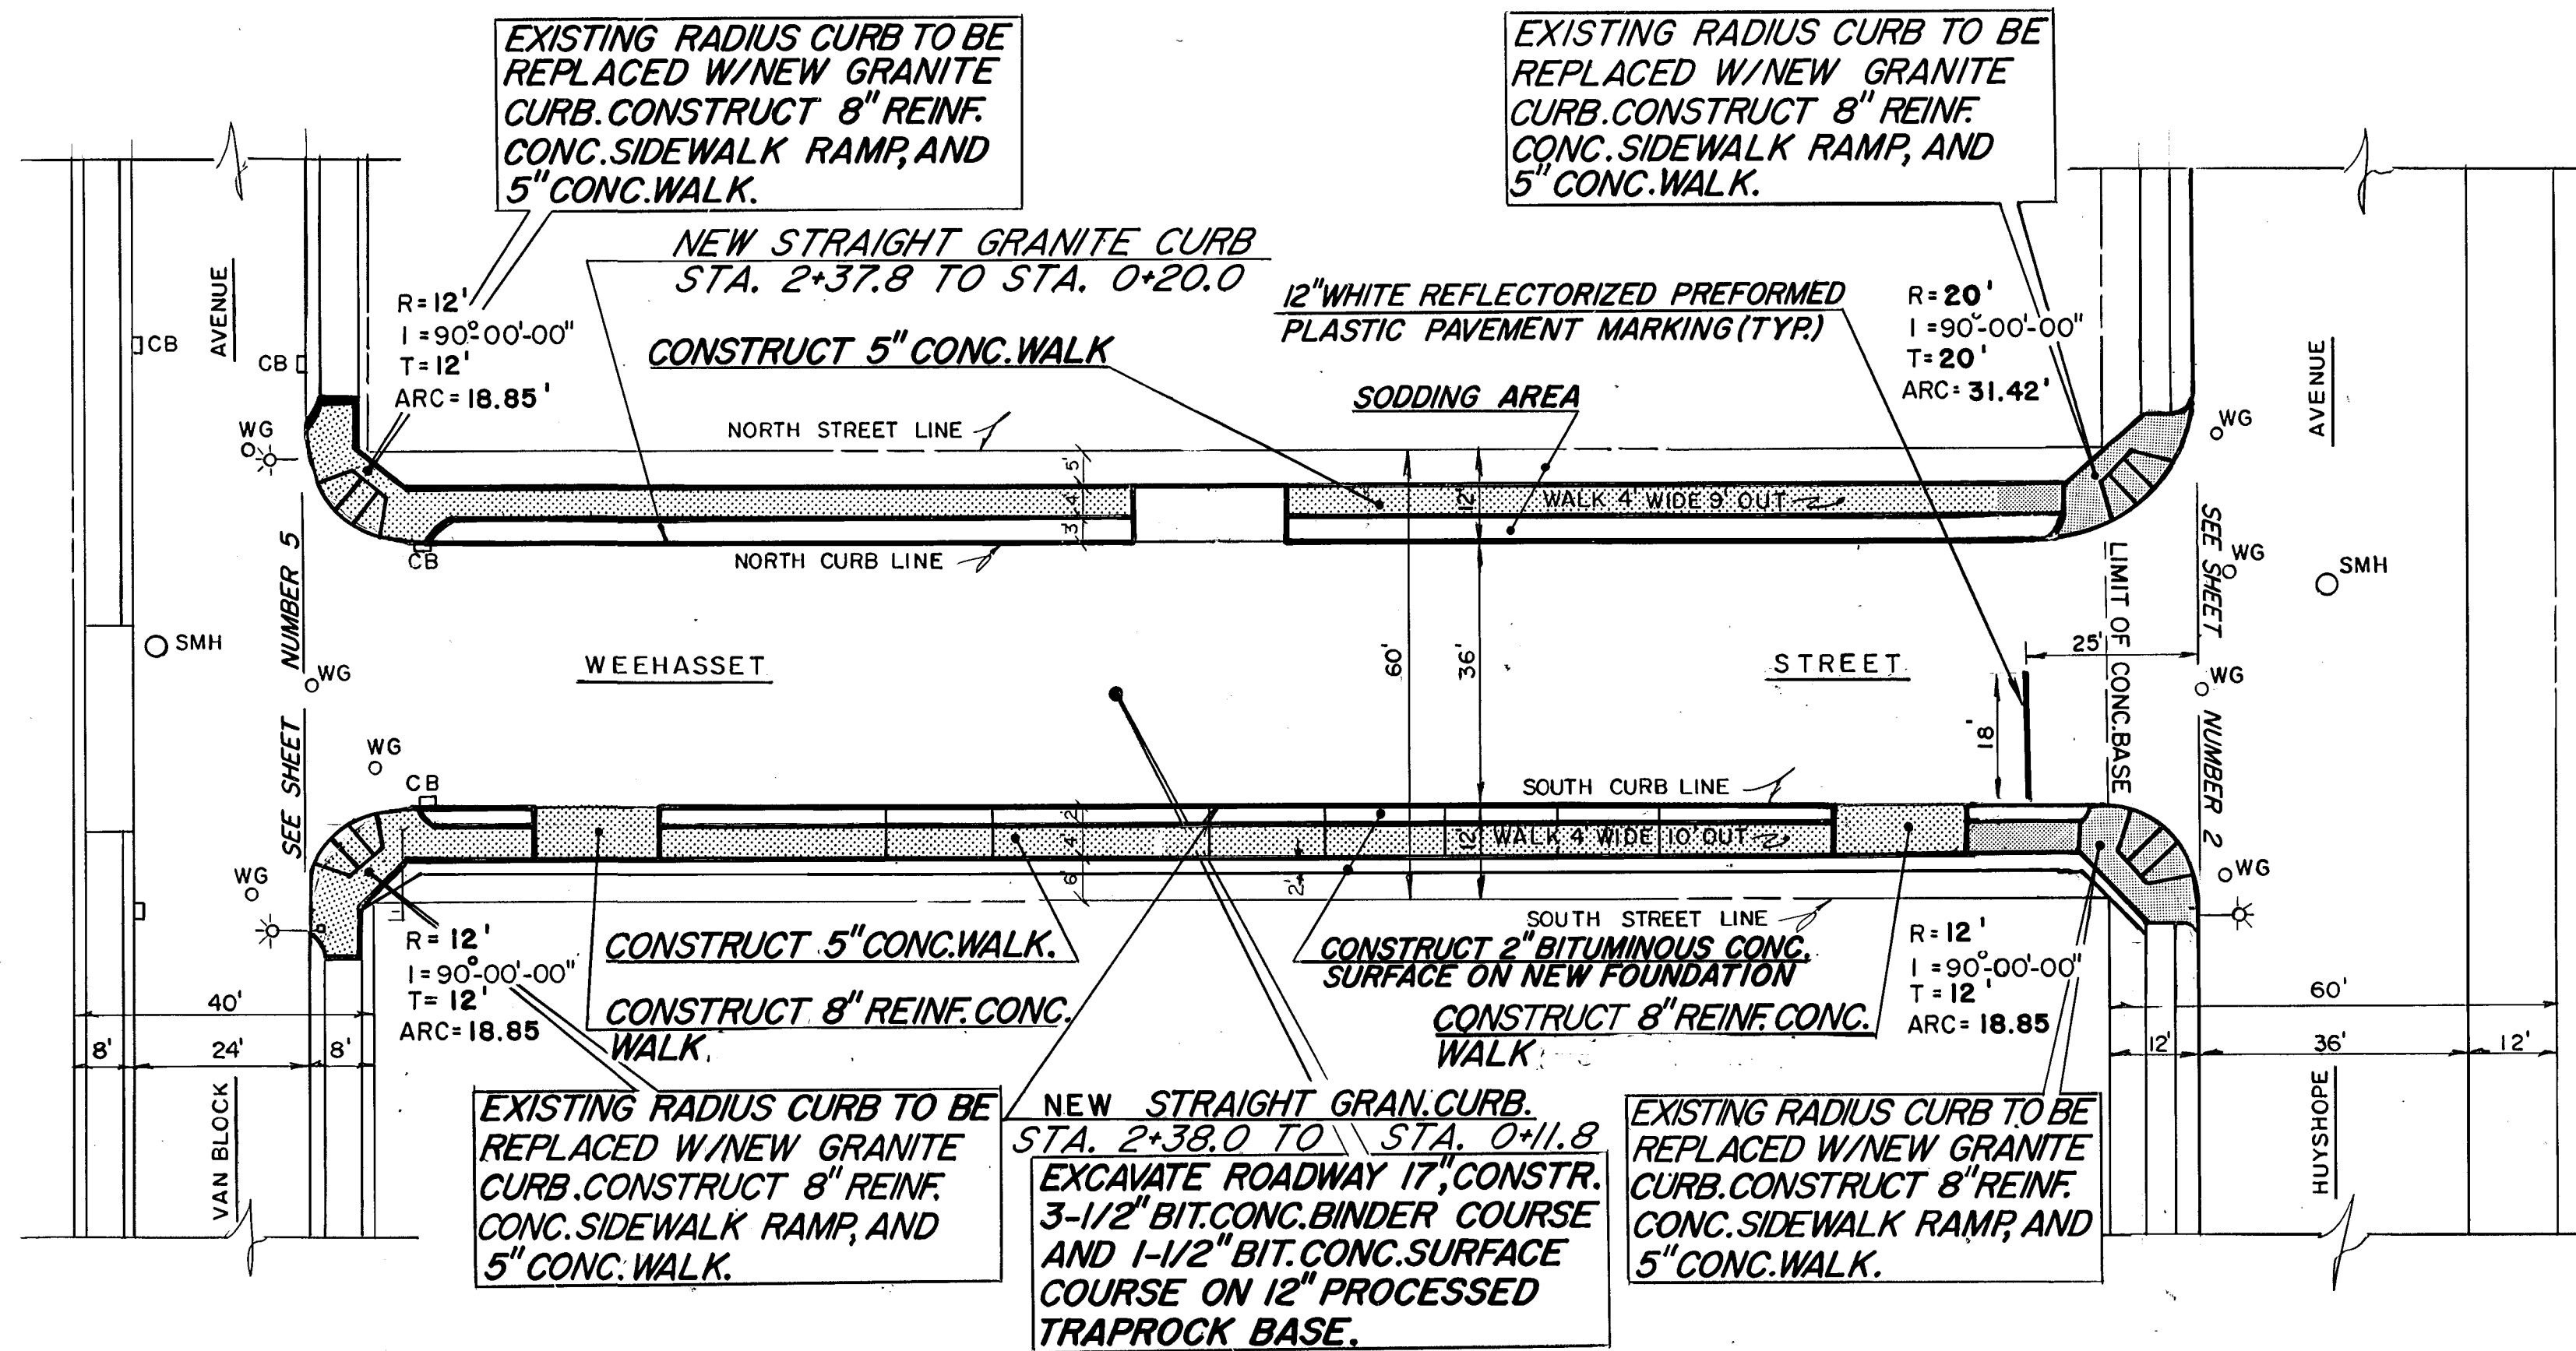

CALL BEFORE YOU DIG - The contractor is hereby reminded that Public Act 87-71 requires notification to the Department of Public Utility or Central Clearing House of proposed excavation, orally or in writing, at least two full days, excluding Saturdays, Sundays and holidays but not more than (one month) THIRTY DAYS before commencing said excavation. C.B.Y.D. number- 1-800-922-4455

NOTE: BENCH MARK, C.M.S. AT N.W. CORNER OF HUYSHOPE AVENUE AND WEEHASSET ST. ELEVATION=20.86'

STATIONS MEASURED ON SLOPE OF NORTH CURB LINE.

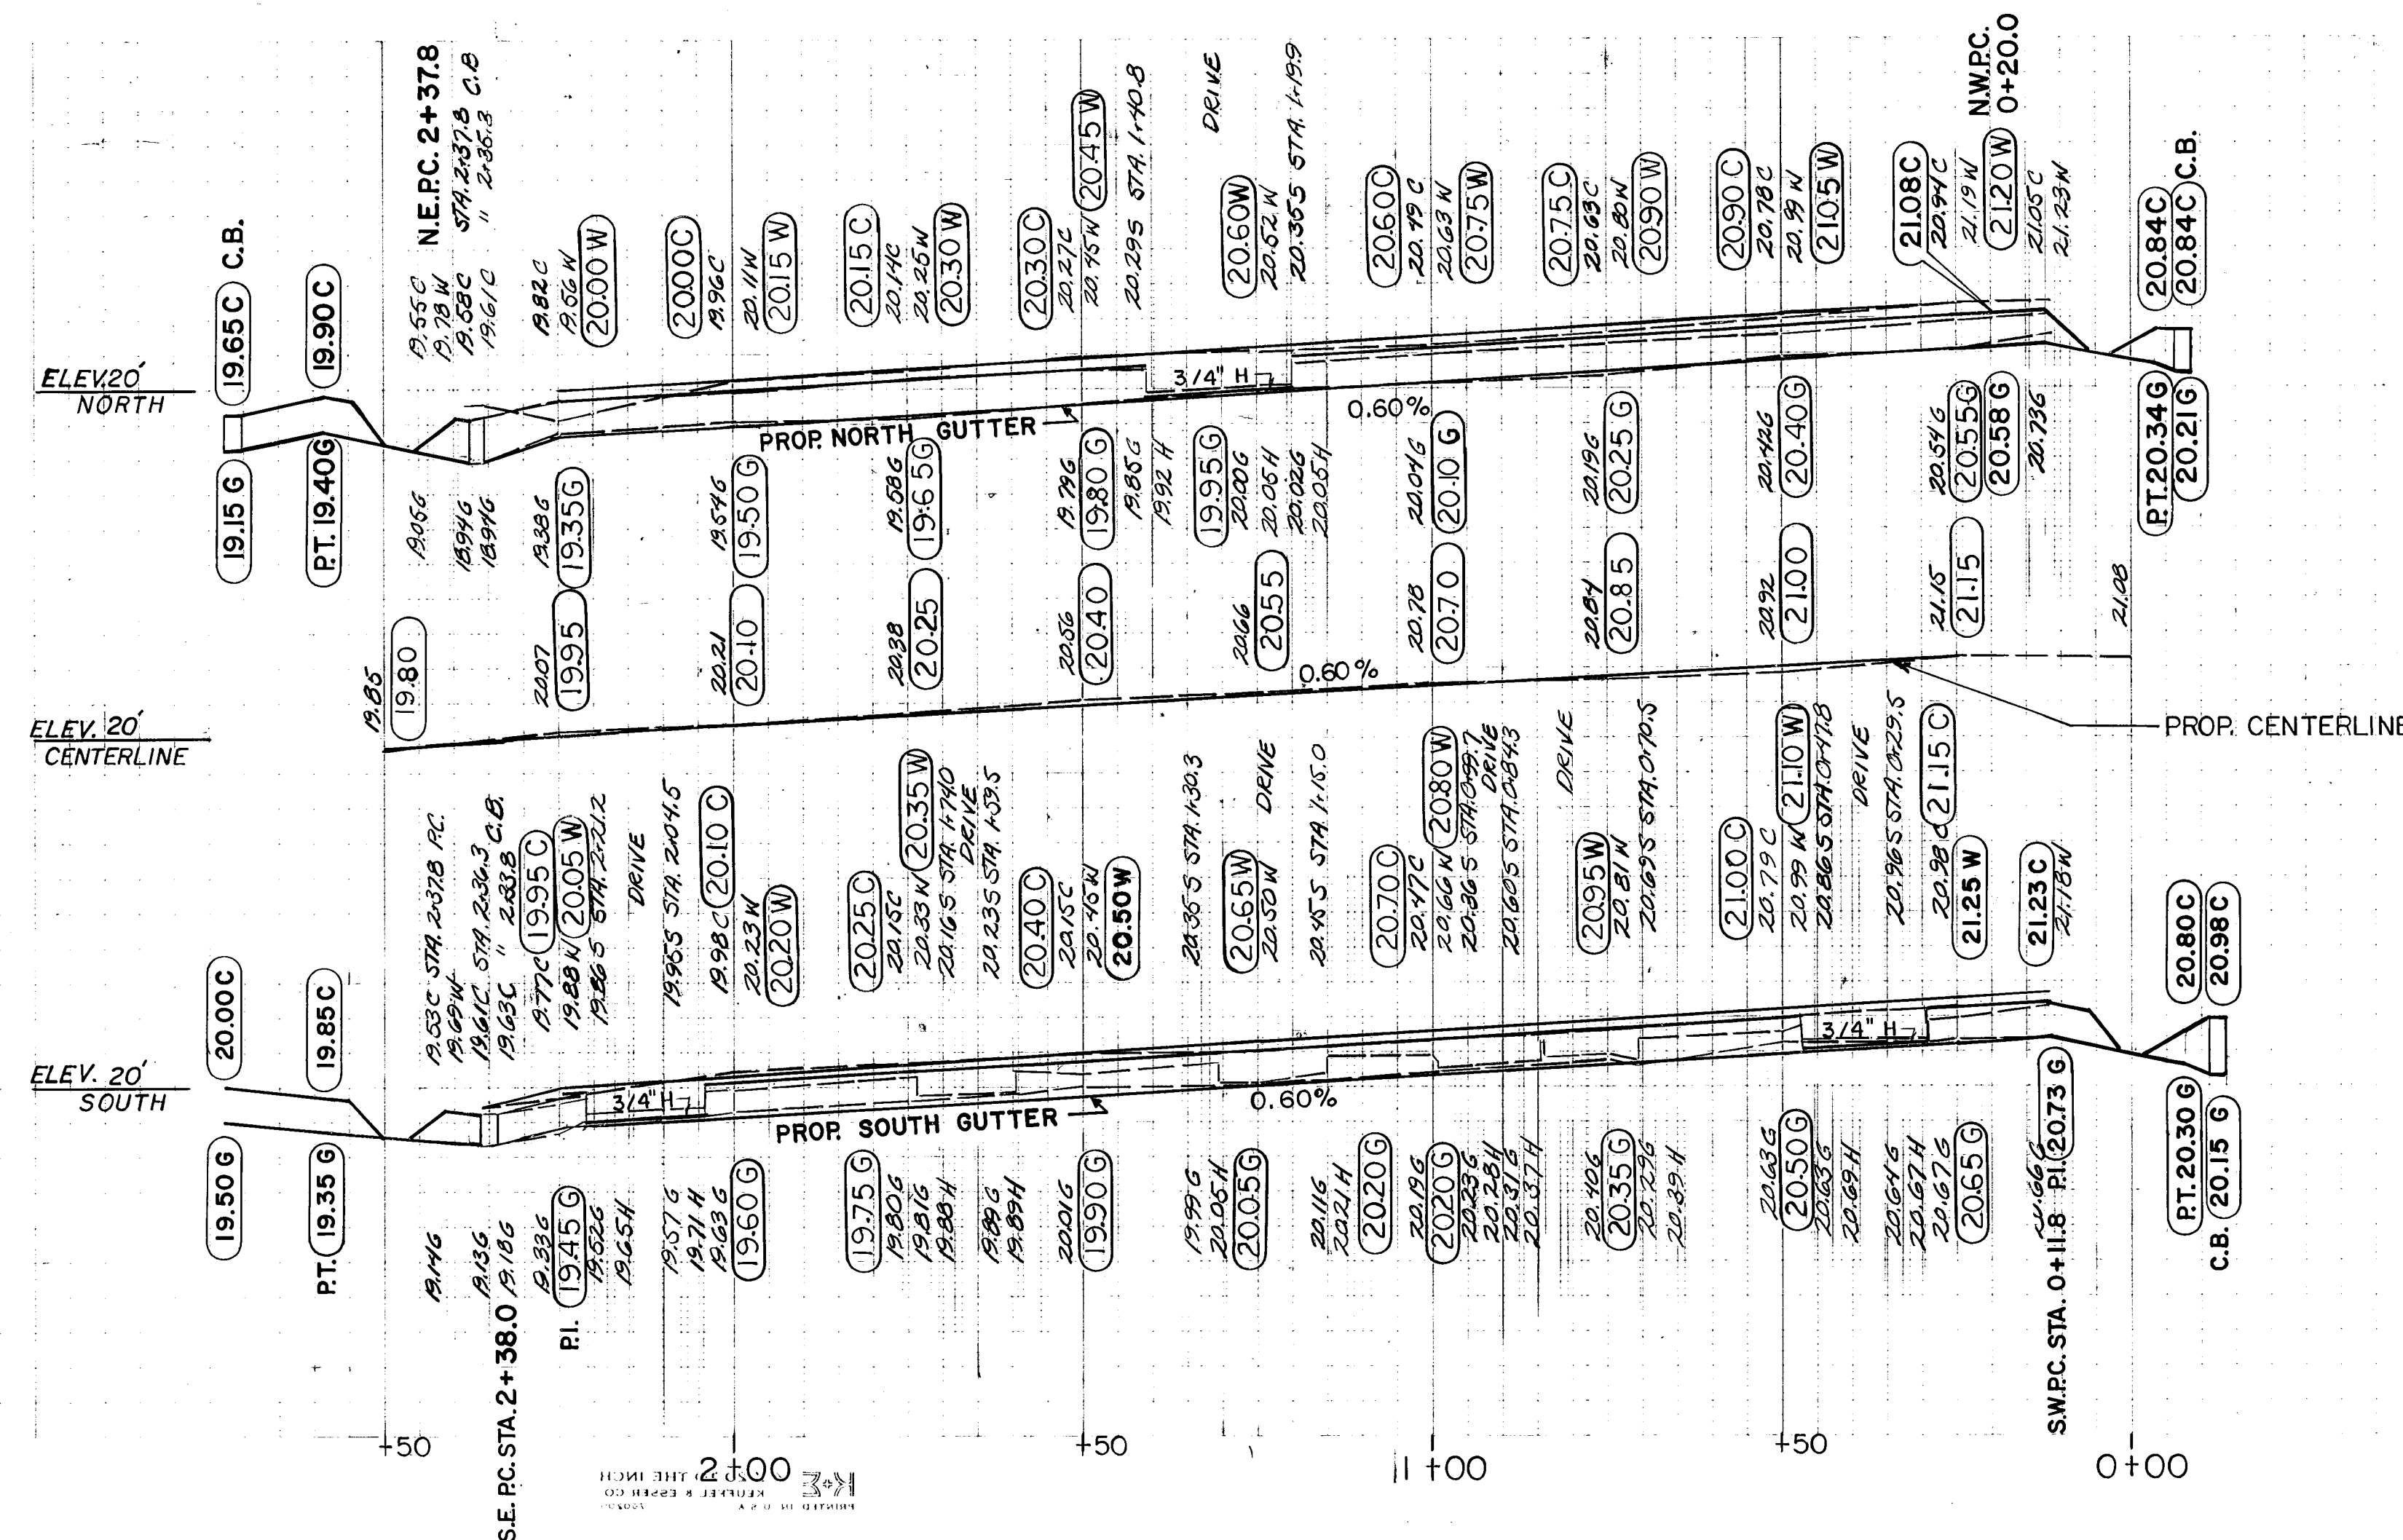

SHEET 8 OF 13

CITY OF HARTFORD, CONNECTICUT
DEPARTMENT OF PUBLIC WORKS
BUREAU OF ENGINEERING SERVICES

WEEHASSET STREET
PLAN AND PROFILE
FROM HUYSHOPE TO VANBLOCK AVE.

SUBMITTED PROJECT ENGINEER <i>[Signature]</i>	RECOMMENDED DIVISION MANAGER <i>[Signature]</i>	APPROVED CITY ENGINEER <i>[Signature]</i>
DRAWN M-KH	SCALE 1"=20' HORZ. 1"=2' VERT.	DAYBOOK NO. 10872 REVISED APRIL 1989 DATE JANUARY 1984