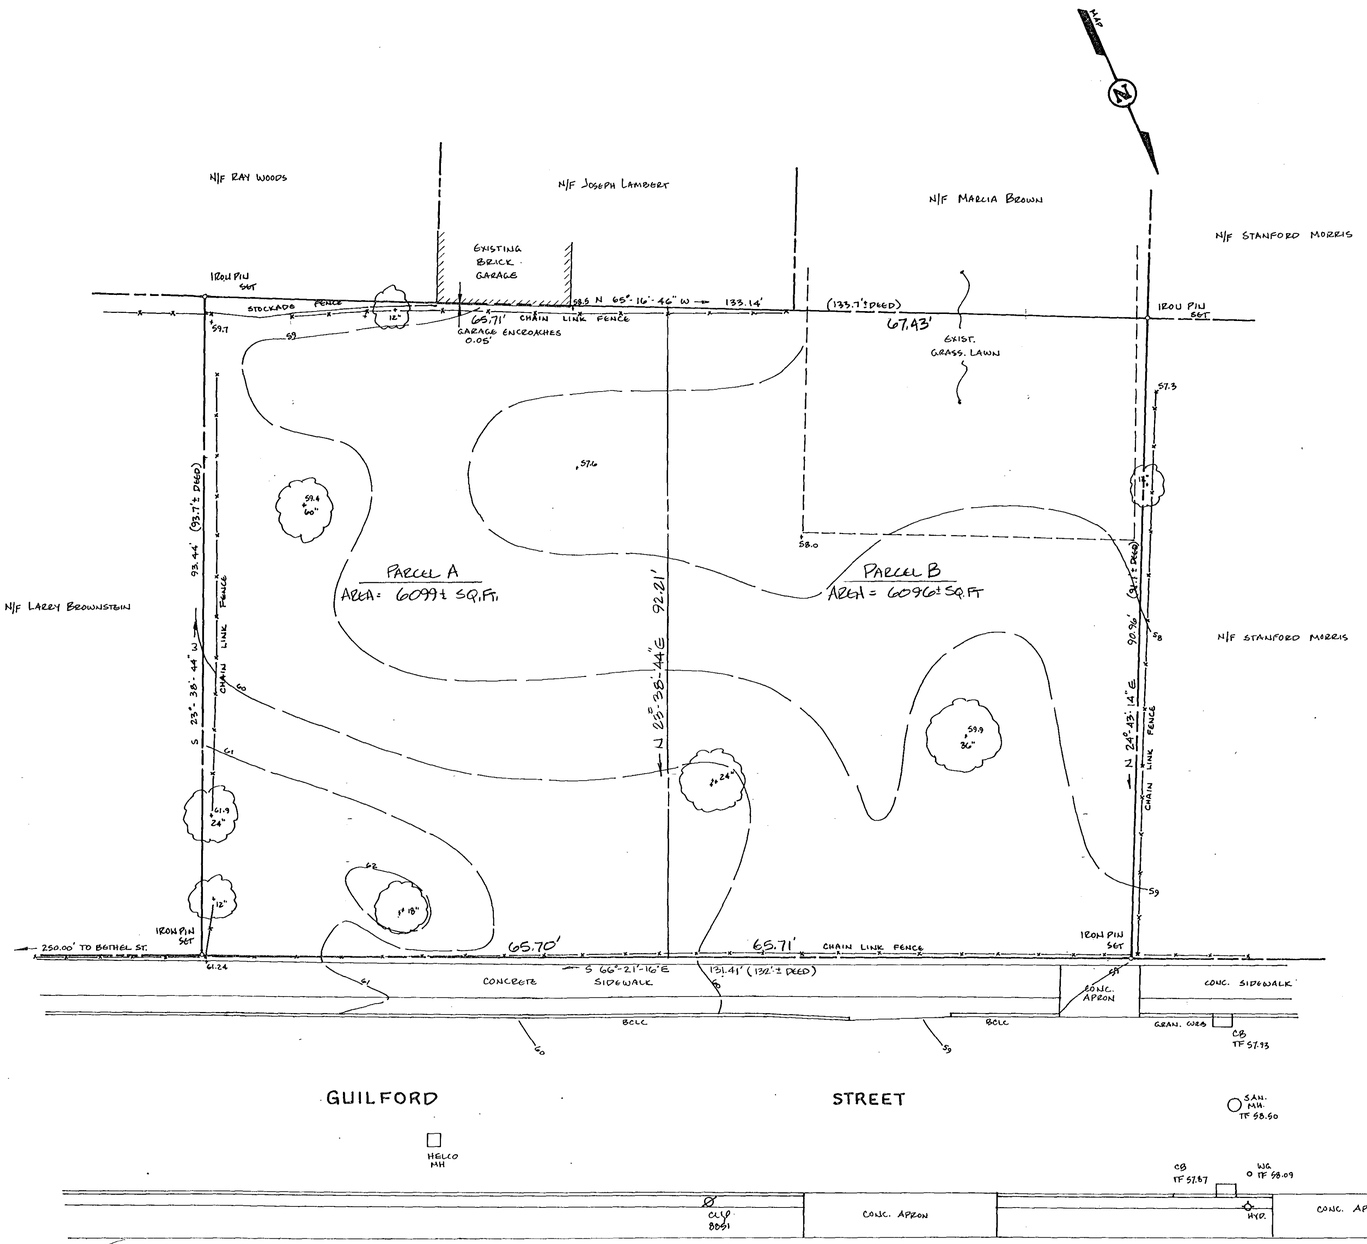

NOTES.

1. TOPOGRAPHY SHOWN IS FROM AND ACTUAL FIELD SURVEY AND IS BASED ON AN ASSUMED DATUM.

GRAPHIC SCALE

0 10 20 30

REPROGRAPHICS UNLIMITED
FIXED LINE MYLAR

BOUNDARY SURVEY
PREPARED FOR
HABITAT FOR HUMANITY
GUILFORD STREET HARTFORD, CT

20 JAN 1992 1"=10' 91026

MALINOSKI ASSOCIATES
58 BROAD OAK DR. ASHFORD, CT 06278

REV. 14 AUG 93 - CREATED PARCELS A & B

RECEIVED
SEP 27 1 33 PM '93

REFERENCE MAP

MAP No. 2, OF LOTS OWNED BY WALTER S. MATHER. HARTFORD CONN. SCALE 50 FEET TO AN INCH AUG. 1897.

NO CERTIFICATION IS EXPRESSED OR IMPLIED ON ORIGINAL OR ANY DUPLICATE OF THIS MAP UNLESS IT BEARS THE ORIGINAL SIGNATURE AND IMPRESSION TYPE SEAL OF THE SURVEYOR WHOSE SIGNATURE APPEARS HEREON.

I HEREBY DECLARE THAT THIS MAP IS SUBSTANTIALLY CORRECT. THIS MAP AND SURVEY WERE PREPARED IN ACCORDANCE WITH THE STANDARDS OF A CLASS A-2 SURVEY AS DEFINED IN THE "RECOMMENDED STANDARDS FOR SURVEYS AND MAPS PREPARED IN THE STATE OF CONNECTICUT" AS PREPARED AND ADOPTED BY THE CONNECTICUT ASSOCIATION OF LAND SURVEYORS INC. ON SEPTEMBER 13, 1984. EXCEPT FOR MONUMENTATION.

DAVID A. MALINOSKI JR. #13046