


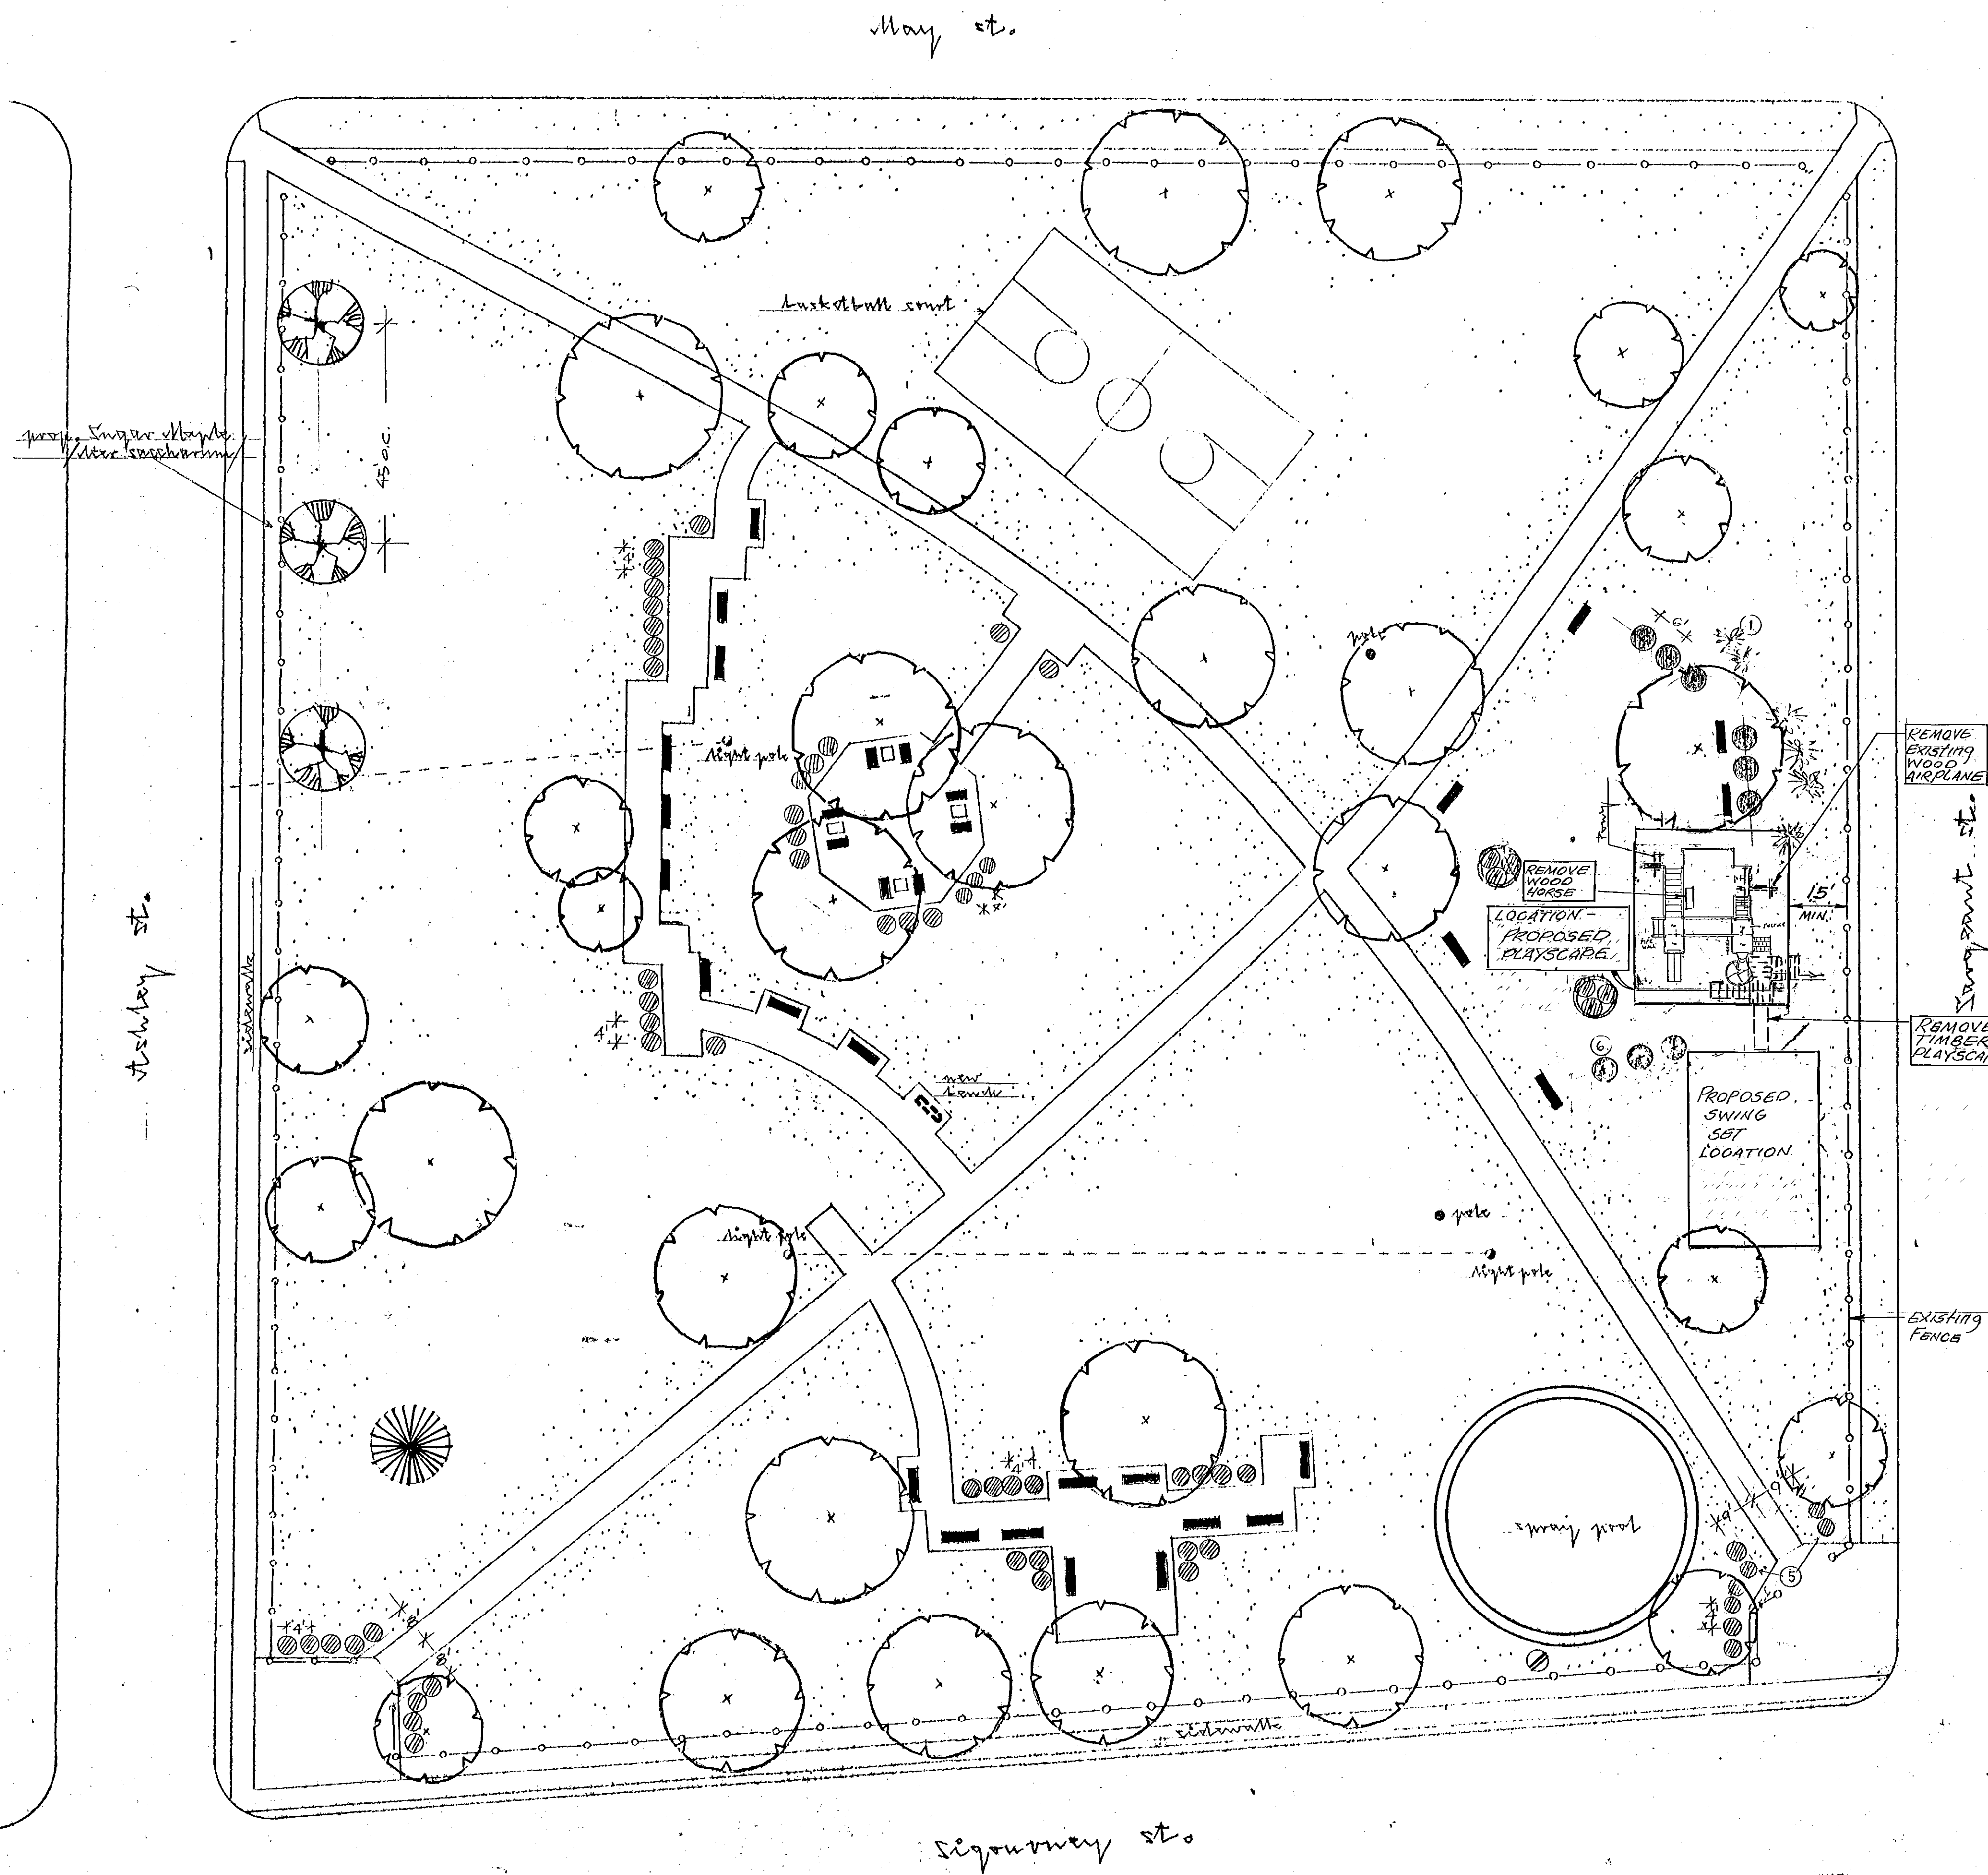

ONLY BOXED-WRITTEN WORDS PERTAIN TO THIS BIDDING.

# LOCATION PLAN PLAYSCAPE & SWINGS

NOTE: PLAN INDICATES LOCATION OF PLAYSCAPE ONLY. DO NOT SCALE A PLAN. REFER TO PROPER GENERAL DESCRIPTION OR SPECIFICATION FOR EACH PLAYSCAPE. FIELD LOCATION SHALL BE APPROVED BY THE ENGINEER.