


This drawing is the property of Spring City Elect. Mfg. Co., and is issued to the recipient with the understanding that it shall not be copied, duplicated, passed on to unauthorized parties, nor used for any purpose other than that for which it is specifically furnished except with Spring City's written permission.

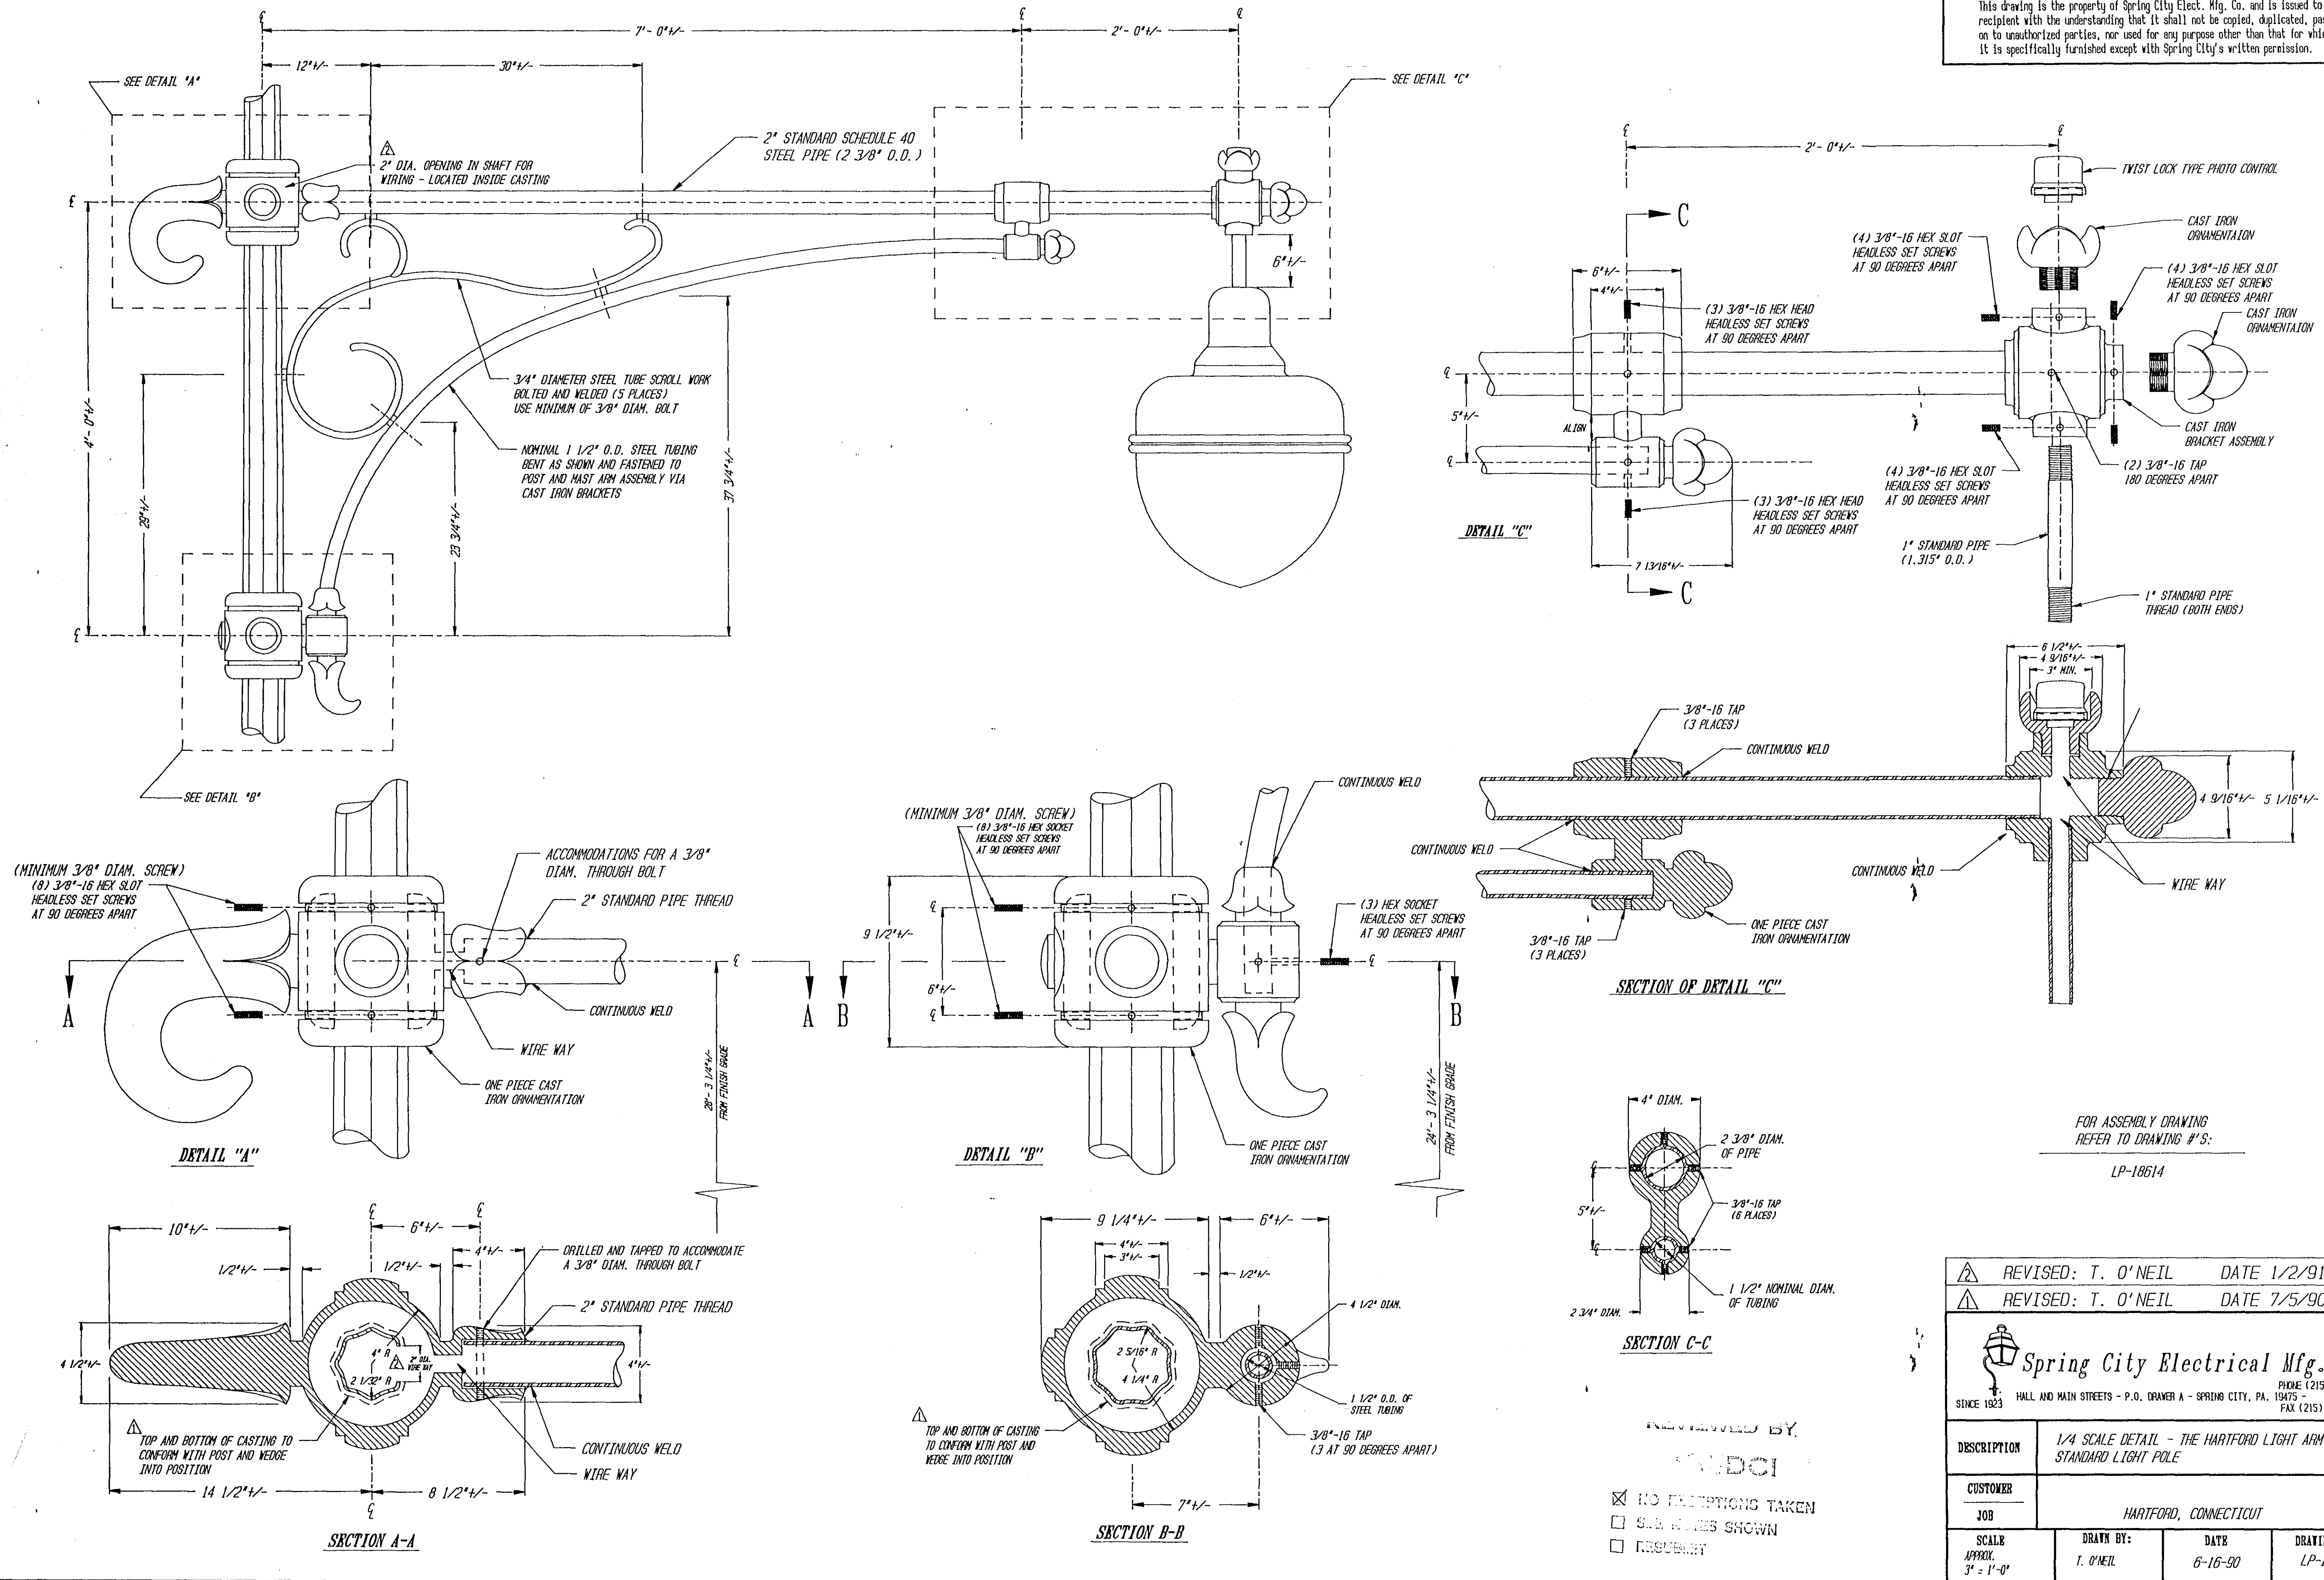

REVISED: T. O'NEIL	DATE 1/2/91
REVISED: T. O'NEIL	DATE 7/5/90
 Spring City Electrical Mfg. Co. HALL AND MAIN STREETS - P.O. DRAWER A - SPRING CITY, PA. 19475 - SINCE 1923 PHONE (215) 948-4000 FAX (215) 948-5577	
DESCRIPTION	1/4 SCALE DETAIL - THE HARTFORD LIGHT ARM FOR STANDARD LIGHT POLE
CUSTOMER	HARTFORD, CONNECTICUT
SCALE APPROX. 3" = 1'-0"	DRAWN BY: T. O'NEIL
	DATE: 6-16-90
	DRAWING NO. LP-18606