


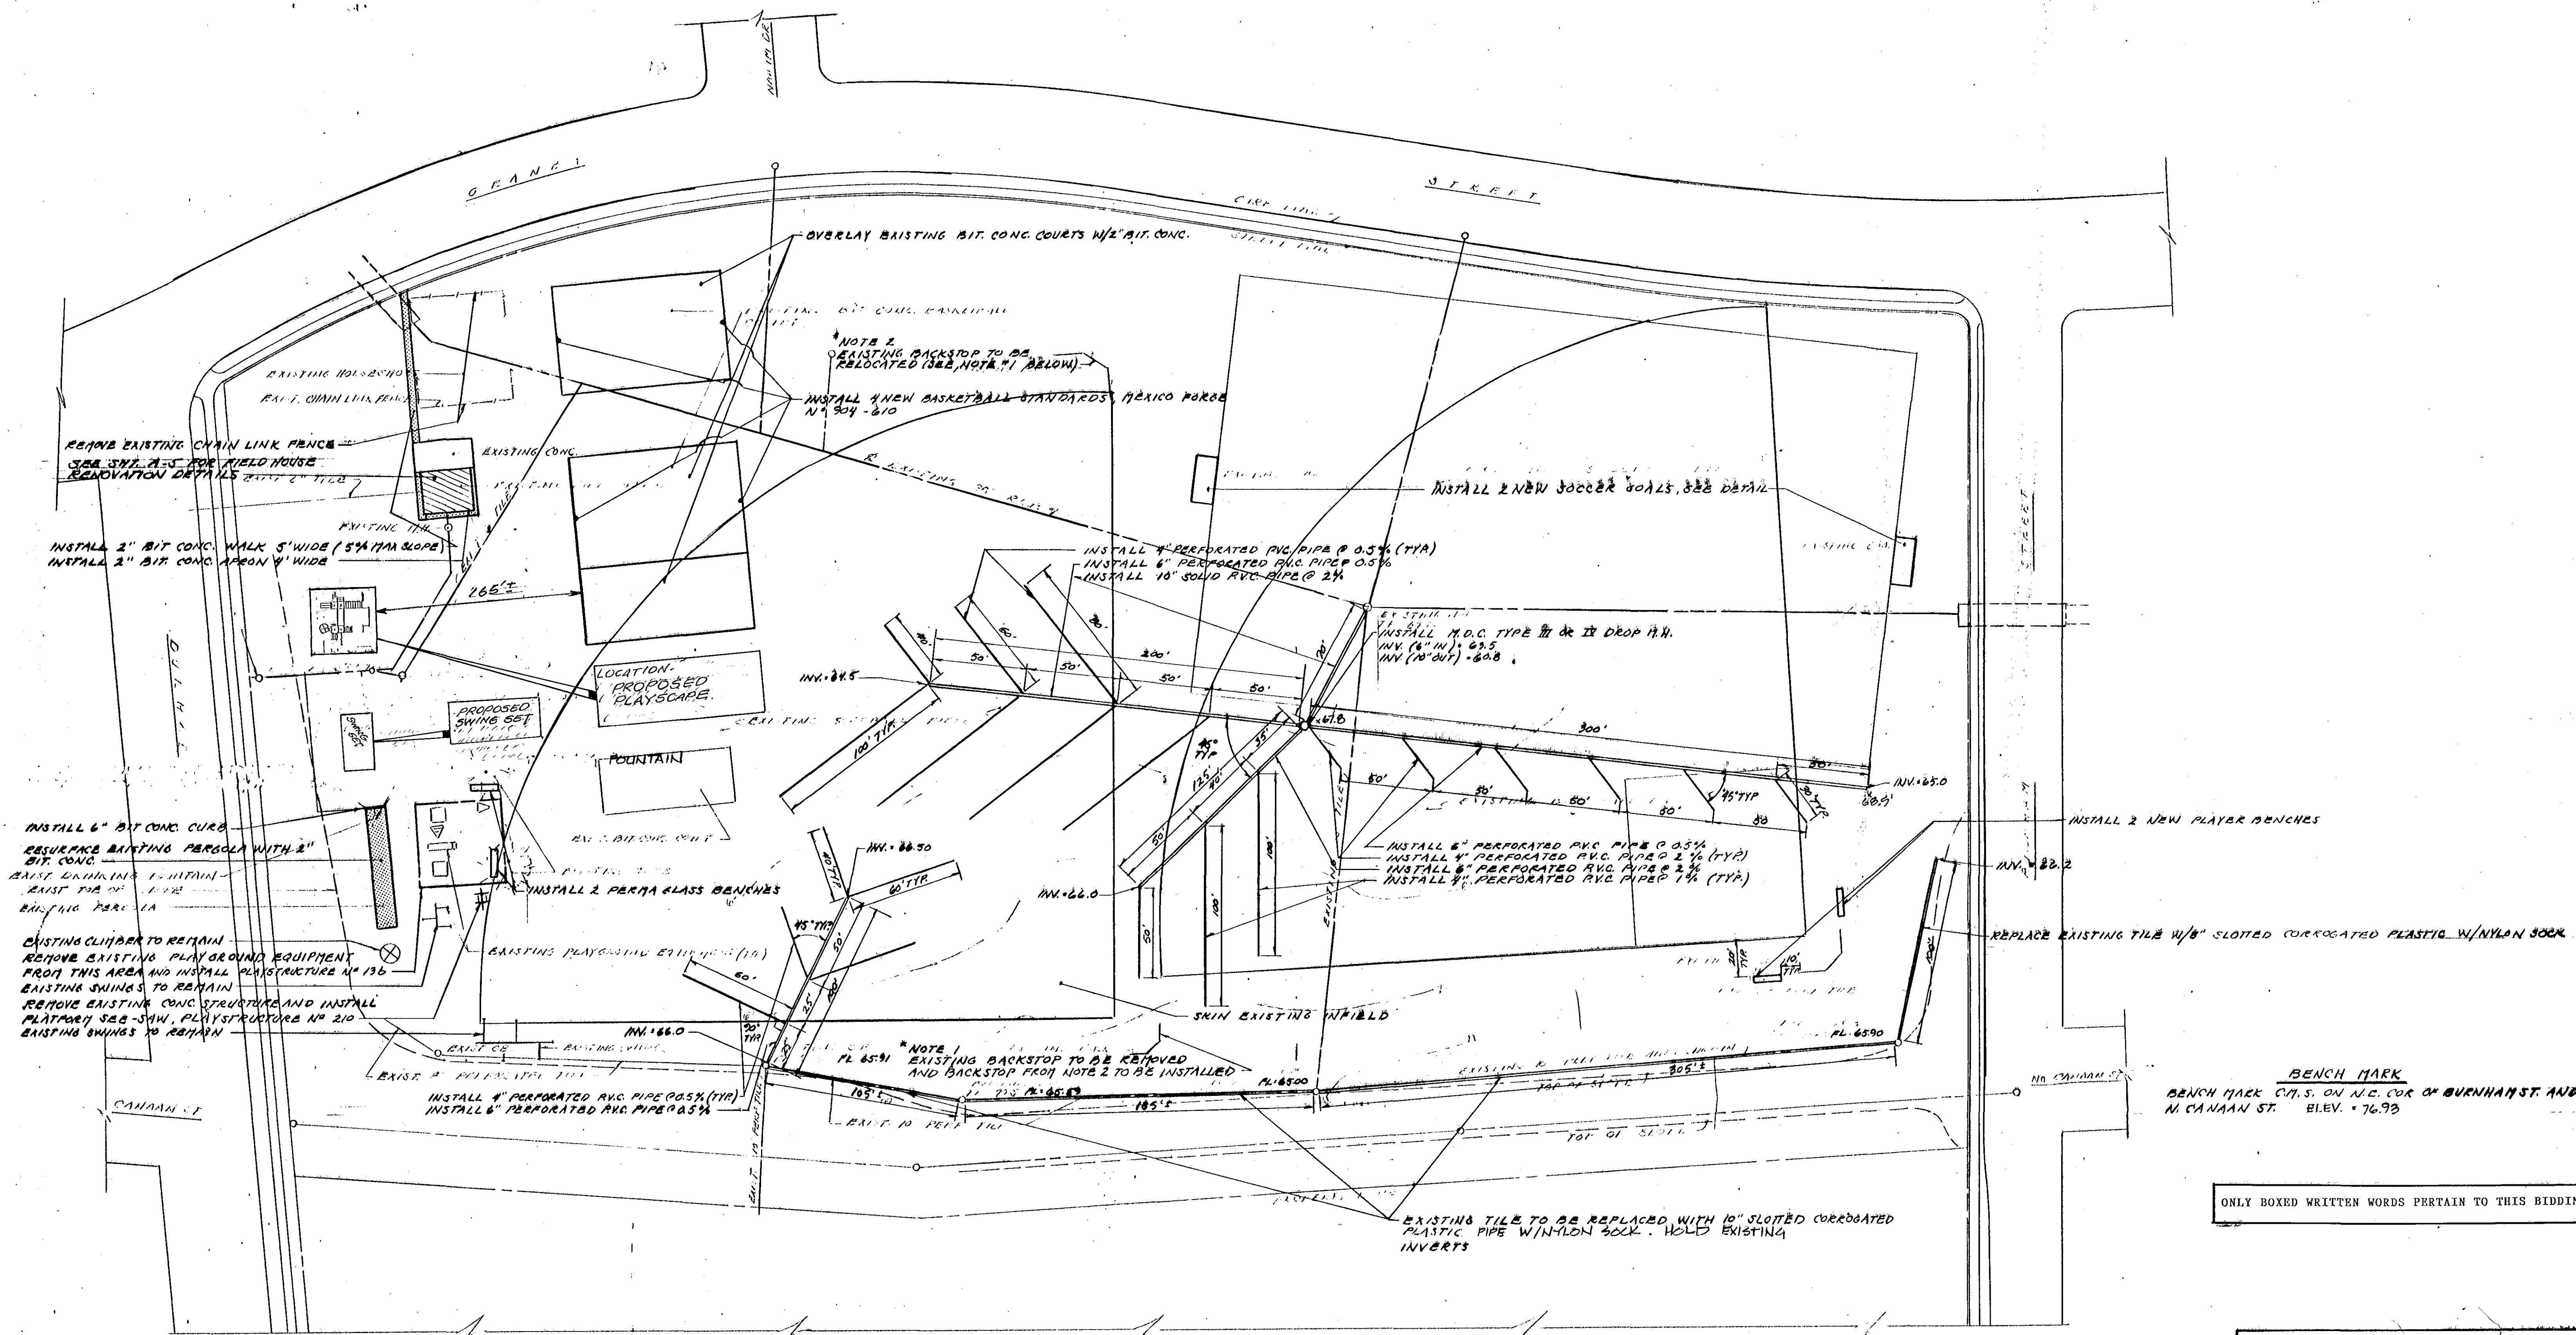

BENCH MARK
BENCH MARK C.T.S. ON N.E. COR. OF BURNHAM ST. AND
N. CANAAN ST. ELEV. = 76.93

ONLY BOXED WRITTEN WORDS PERTAIN TO THIS BIDDING.

PLAN OF CRONIN PARK
SCALE: 1" = 60'

LOCATION PLAN PLAYSCAPE & SWINGS

NOTE: PLAN INDICATES LOCATION OF PLAYSCAPE ONLY. DO NOT SCALE A PLAN. REFER TO
PROPER GENERAL DESCRIPTION OR SPECIFICATION FOR EACH PLAYSCAPE. FIELD LOCATION
SHALL BE APPROVED BY THE ENGINEER.

CITY OF HARTFORD, CONNECTICUT DEPARTMENT OF PUBLIC WORKS FACILITIES SERVICES BUREAU		
HARTFORD PARKS REHABILITATION II		
CRONIN PARK		
SUBMITTED	APPROVED	APPROVED
DRAWN	CHECKED	DATE
CHECKED	DATE	DATE
SCALE	SCALE	SCALE