
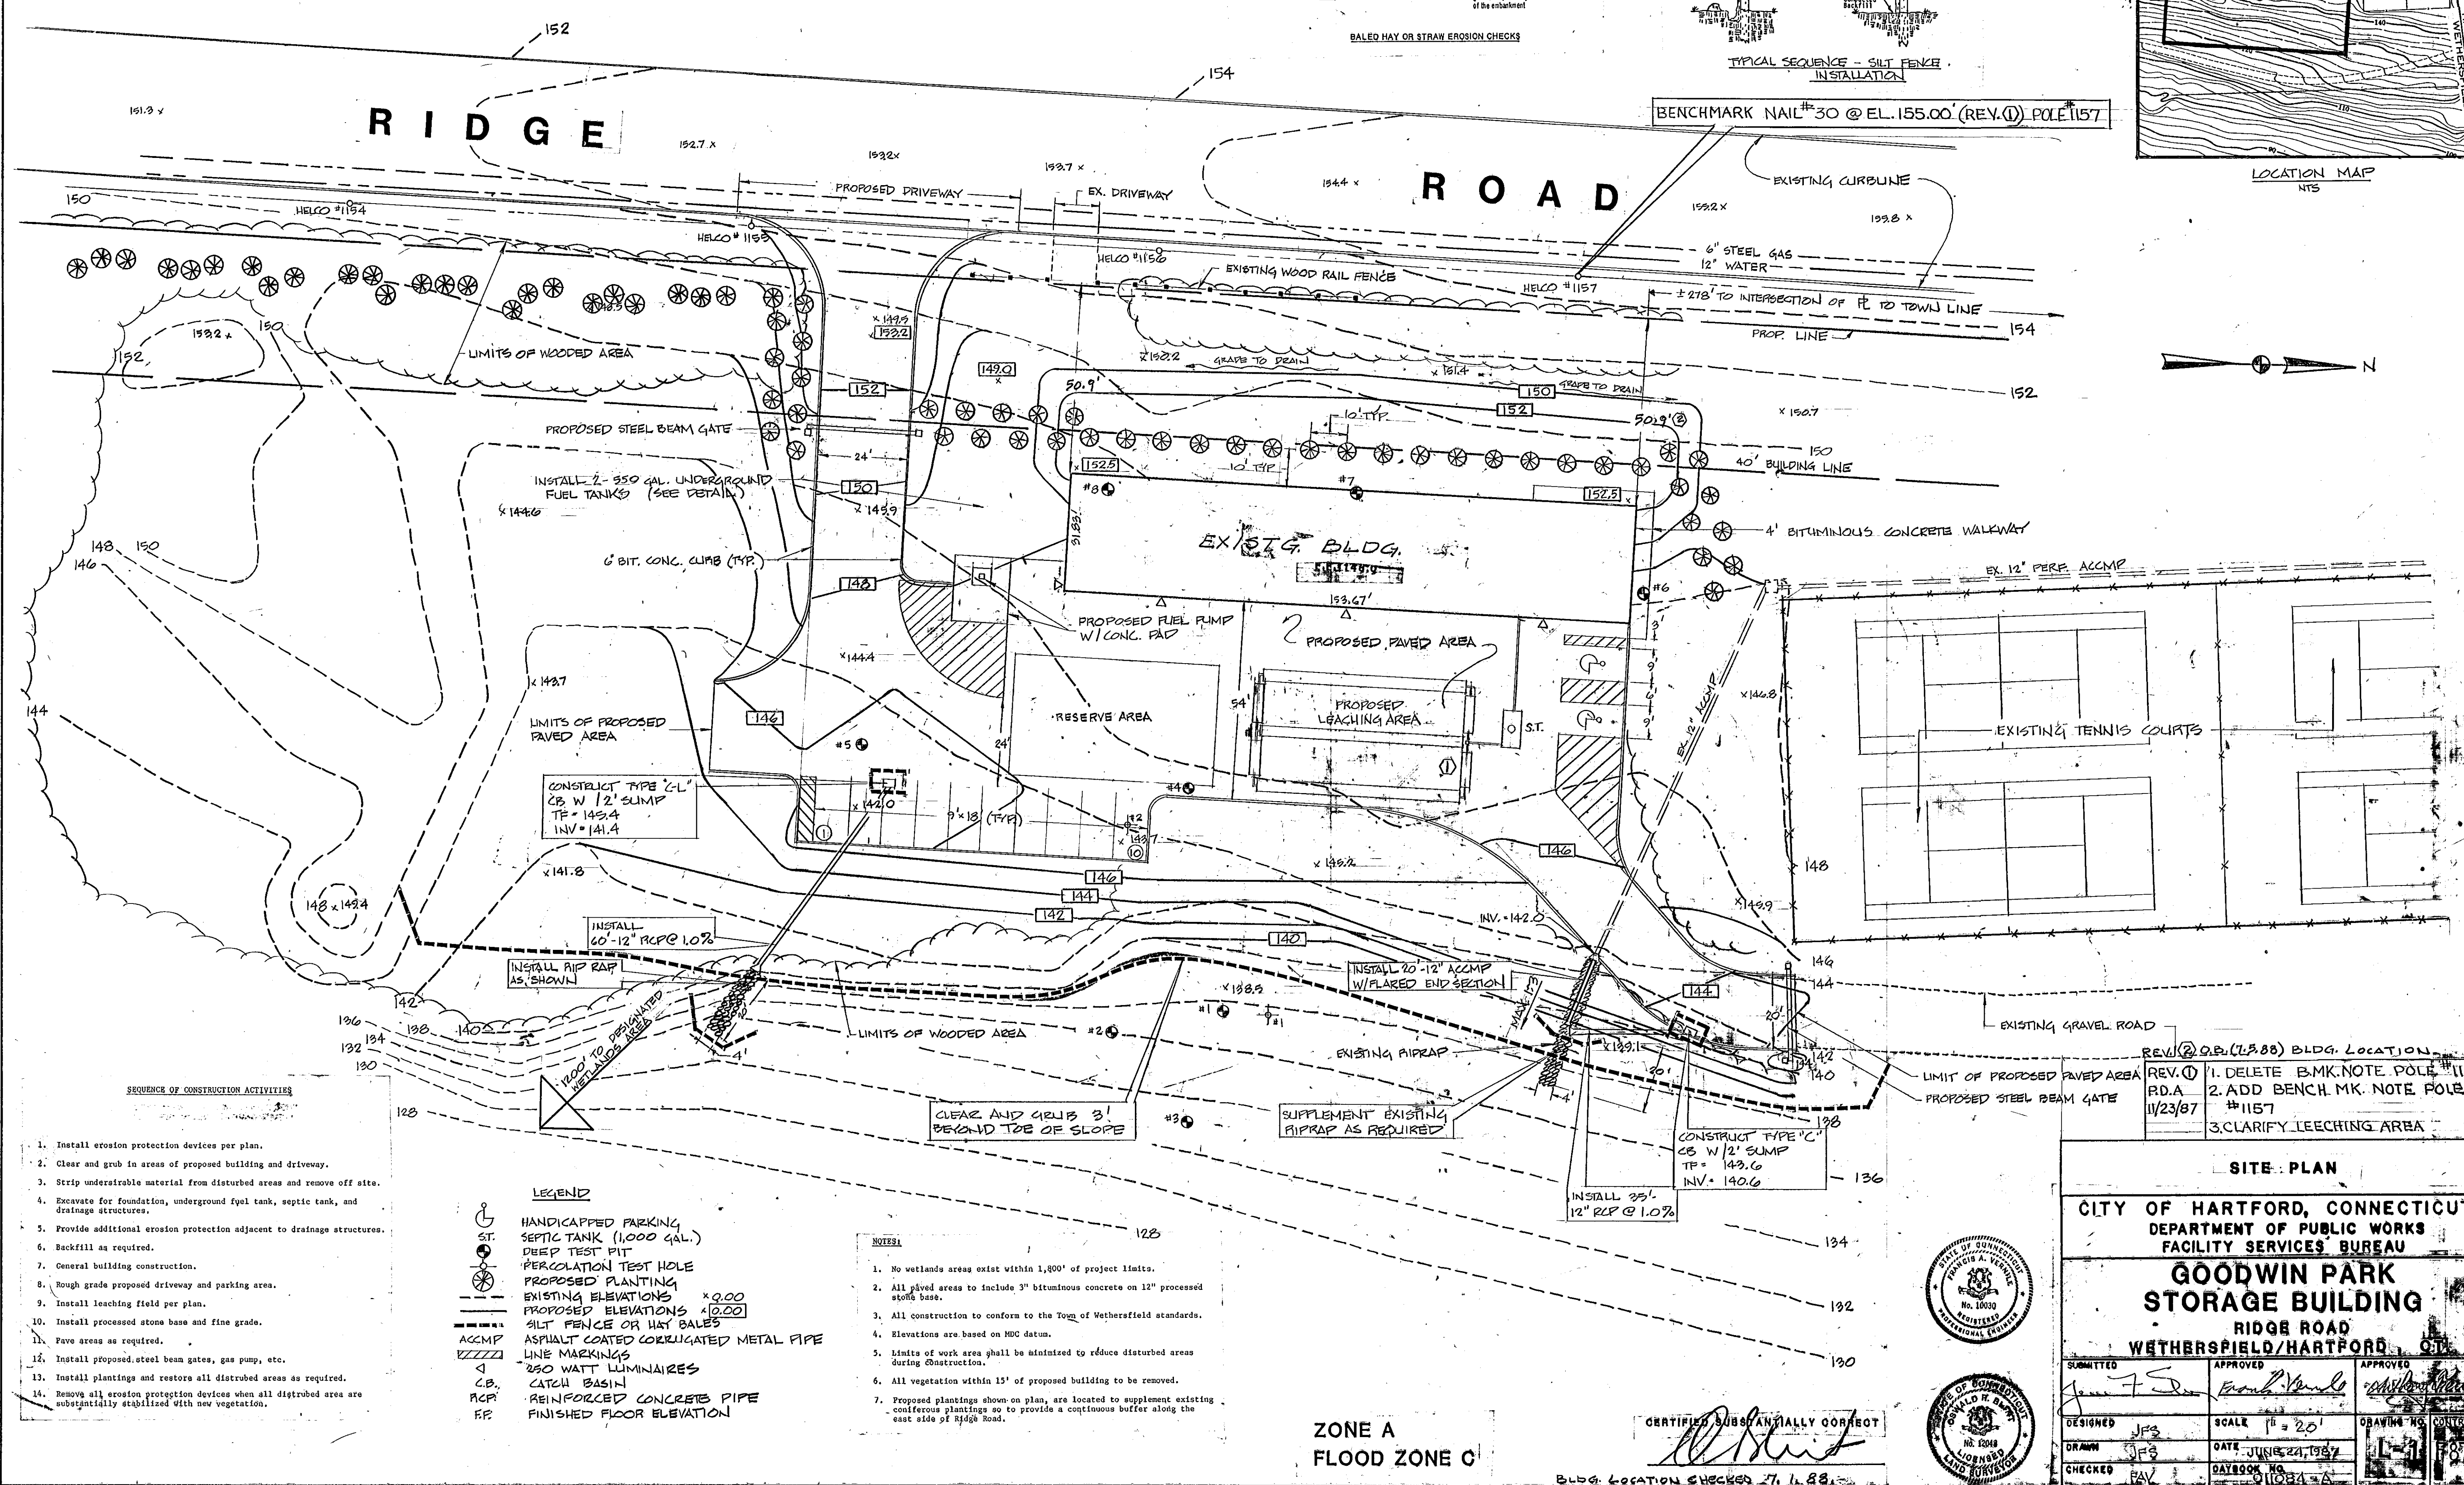
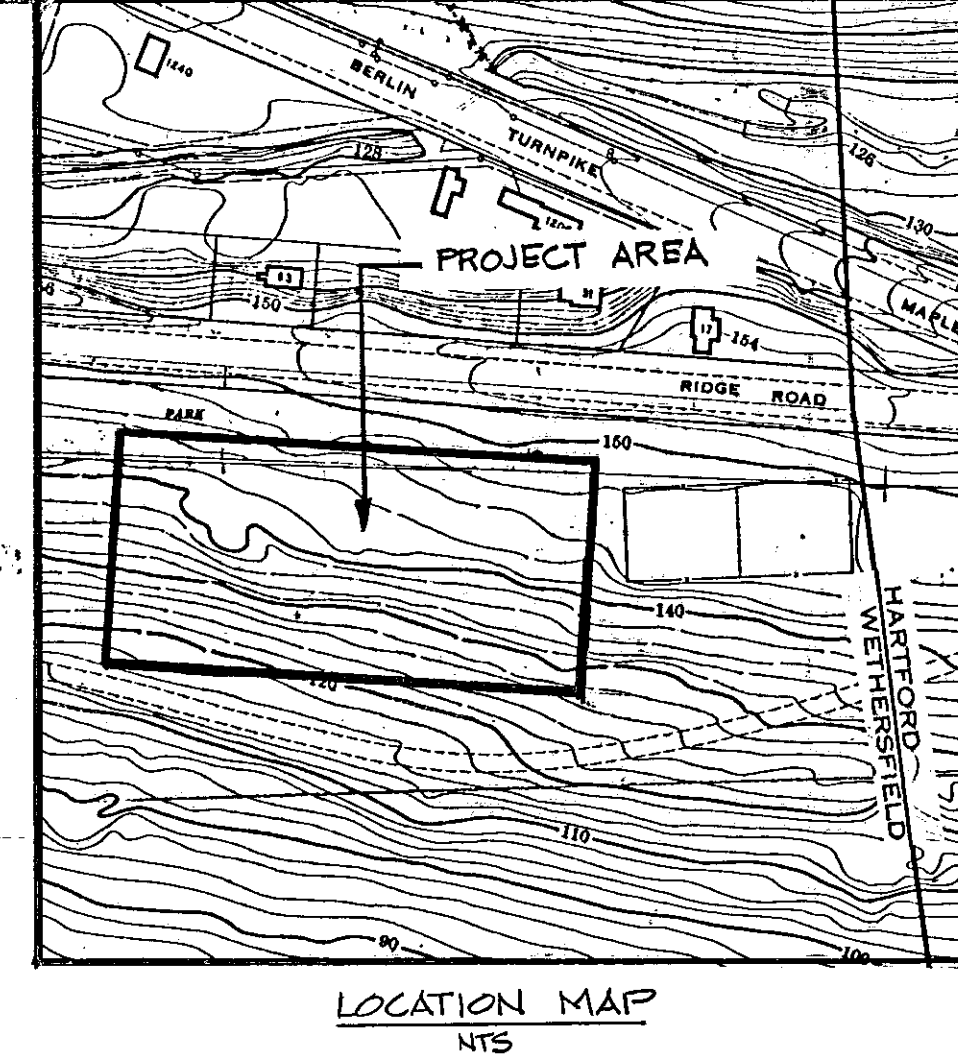
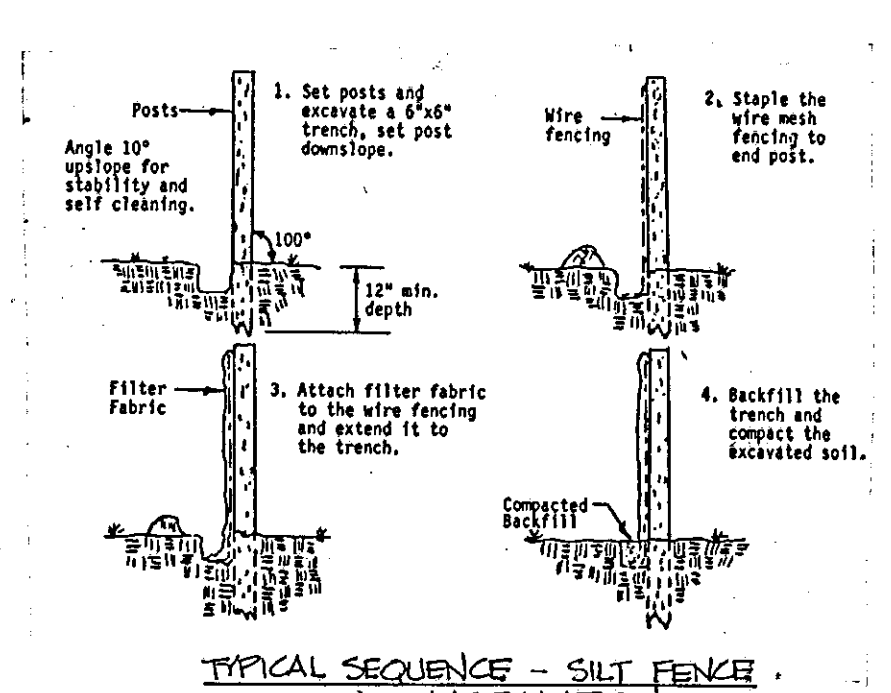


TYPE	SIZE	NO.
Taiga Canadensis (Eastern Hemlock)	5'-6" B & B	44
II (ALTERNATE # 2)		24

DELETE NOTE ①

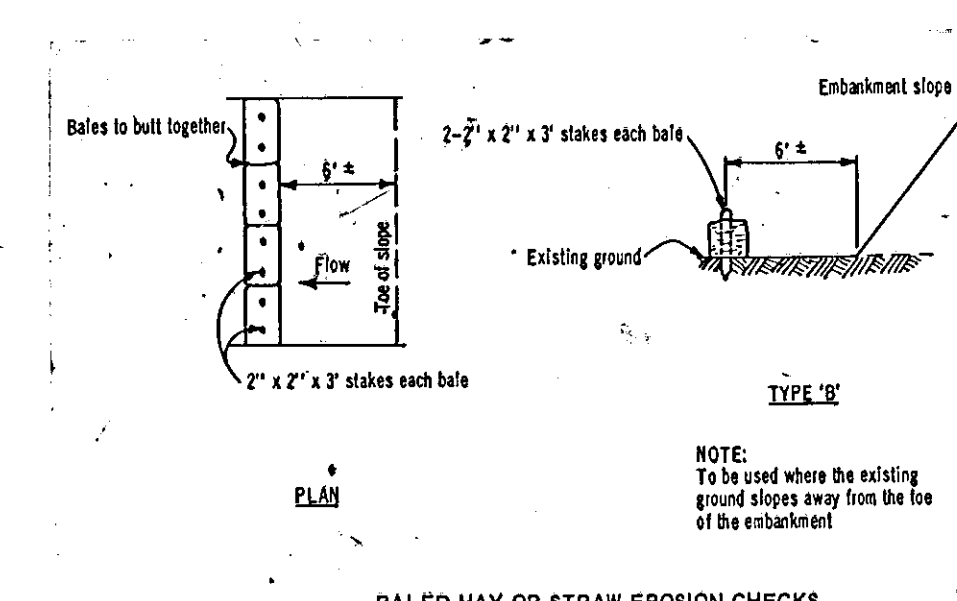

- SEQUENCE OF CONSTRUCTION ACTIVITIES**
1. Install erosion protection devices per plan.
 2. Clear and grub in areas of proposed building and driveway.
 3. Strip understable material from disturbed areas and remove off site.
 4. Excavate for foundation, underground fuel tank, septic tank, and drainage structures.
 5. Provide additional erosion protection adjacent to drainage structures.
 6. Backfill as required.
 7. General building construction.
 8. Rough grade proposed driveway and parking area.
 9. Install leaching field per plan.
 10. Install processed stone base and fine grade.
 11. Pave areas as required.
 12. Install proposed steel beam gates, gas pump, etc.
 13. Install plantings and restore all disturbed areas as required.
 14. Remove all erosion protection devices when all disturbed area are substantially stabilized with new vegetation.

- LEGEND**
- HANDICAPPED PARKING
 - SEPTIC TANK (1,000 GAL.)
 - DEEP TEST PIT
 - PERCOLATION TEST HOLE
 - PROPOSED PLANTING
 - EXISTING ELEVATIONS
 - PROPOSED ELEVATIONS
 - SILT FENCE OR HAY BALES
 - ASPHALT COATED CORRUGATED METAL PIPE
 - LINE MARKINGS
 - 250 WATT LUMINAIRES
 - CATCH BASIN
 - REINFORCED CONCRETE PIPE
 - FINISHED FLOOR ELEVATION

- NOTES**
1. No wetlands areas exist within 1,800' of project limits.
 2. All paved areas to include 3" bituminous concrete on 12" processed stone base.
 3. All construction to conform to the Town of Wethersfield standards.
 4. Elevations are based on MDC datum.
 5. Limits of work area shall be minimized to reduce disturbed areas during construction.
 6. All vegetation within 15' of proposed building to be removed.
 7. Proposed plantings shown on plan, are located to supplement existing coniferous plantings so to provide a continuous buffer along the east side of Ridge Road.

ZONE A
FLOOD ZONE C

CERTIFIED SUBSTANTIALLY CORRECT

BLDG. LOCATION CHECKED 7.1.88

- REV. ② O.B. (L.S. 88) BLDG. LOCATION
1. DELETE B.M.K. NOTE POLE #1155
 2. ADD BENCH. MK. NOTE POLE #1157
 3. CLARIFY LEECHING AREA

SITE PLAN

CITY OF HARTFORD, CONNECTICUT DEPARTMENT OF PUBLIC WORKS FACILITY SERVICES BUREAU			
GOODWIN PARK STORAGE BUILDING RIDGE ROAD WETHERSFIELD/HARTFORD, CT			
SUBMITTED JUN 7 1987	APPROVED [Signature]	APPROVED [Signature]	DESIGNED JFS
DRAWN JFS	CHECKED PAV	SCALE 1" = 20'	DATE JUNE 24, 1987
OBTAINING NO. 1-1		CONTRACT NO. 1878	