


MAP REFERENCE:

- 1). MAP ENTITLED, "SOUTH PROPERTY LINE OF PROPERTIES ON SOUTH SIDE OF CLEVELAND AVENUE CITY OF HARTFORD DEPARTMENT OF ENGINEERING SCALE 1"=40 JANUARY 1959 DAYBOOK NO. 09563."
- 2). MAP ENTITLED, "MAP OF PROPERTY OF W.L. MATSON, SITUATED ON MAIN & FRANKFORT STREETS HARTFORD, CONN SCALE OF MAP 100 FEET TO 1 INCH APRIL 1897 CE BEACH C.E."
- 3). MAP ENTITLED, "PLAN OF 2975-2995 MAIN ST. HARTFORD, CONNECTICUT SCALE: 1"=10' DATE 7-24-84 PREPARED FOR HITESH KATHARI PRAMOD SHAH & SEJAL SHAH OSWALD BLINT L.S."
- 4). MAP ENTITLED, "PLAN OF 29-35 CLEVELAND AVENUE HARTFORD, CONNECTICUT SCALE: 1"=40' 1-21-97 OSWALD BLINT L.S."
- 5). MAP ENTITLED, "PROPERTY OF HARRY SHOR SITUATED ON EARL ST. SCALE 1 INCH=60 FEET FEB 1916 L.W. BURT & SON C.E."
- 6). MAP ENTITLED, "MAP SHOWING PROPERTY OF E.P. YATES, WINDSOR AVE. HARTFORD, CT. SCALE 1"=40' MAY 1900 C.B. VORCE ENGR."
- 7). MAP ENTITLED, "MAP OF KENSINGTON MANOR HARTFORD, CONNECTICUT OWNED BY EDWARD J. HOLL SCALE 1"=100' JUNE 1925 EDGAR T. DUNCAN C.E."
- 8). MAP ENTITLED, "PROPERTY OF HARRY SHOR SITUATED ON EARL ST. SCALE 1"=60' AUGUST 1915 L.W. BURT & SON C.E."
- 9). MAP ENTITLED, "HARTFORD HOUSING AUTHORITY PARCEL PROPERTY LINE MAP CONN 3-1 HENRY N. LOOMIS, CIVIL ENGINEER DATED APRIL 24, 1950, REVISED MAY 23, 1950 1 INCH EQUALS 150 FEET."
- 10). MAP ENTITLED, "PROPERTY OF JOHN W. BEEBE 2939 MAIN STREET HARTFORD, CONN. SEPT. 79 P.F. 79100 1"=40' PETER D. FLYNN L.S."

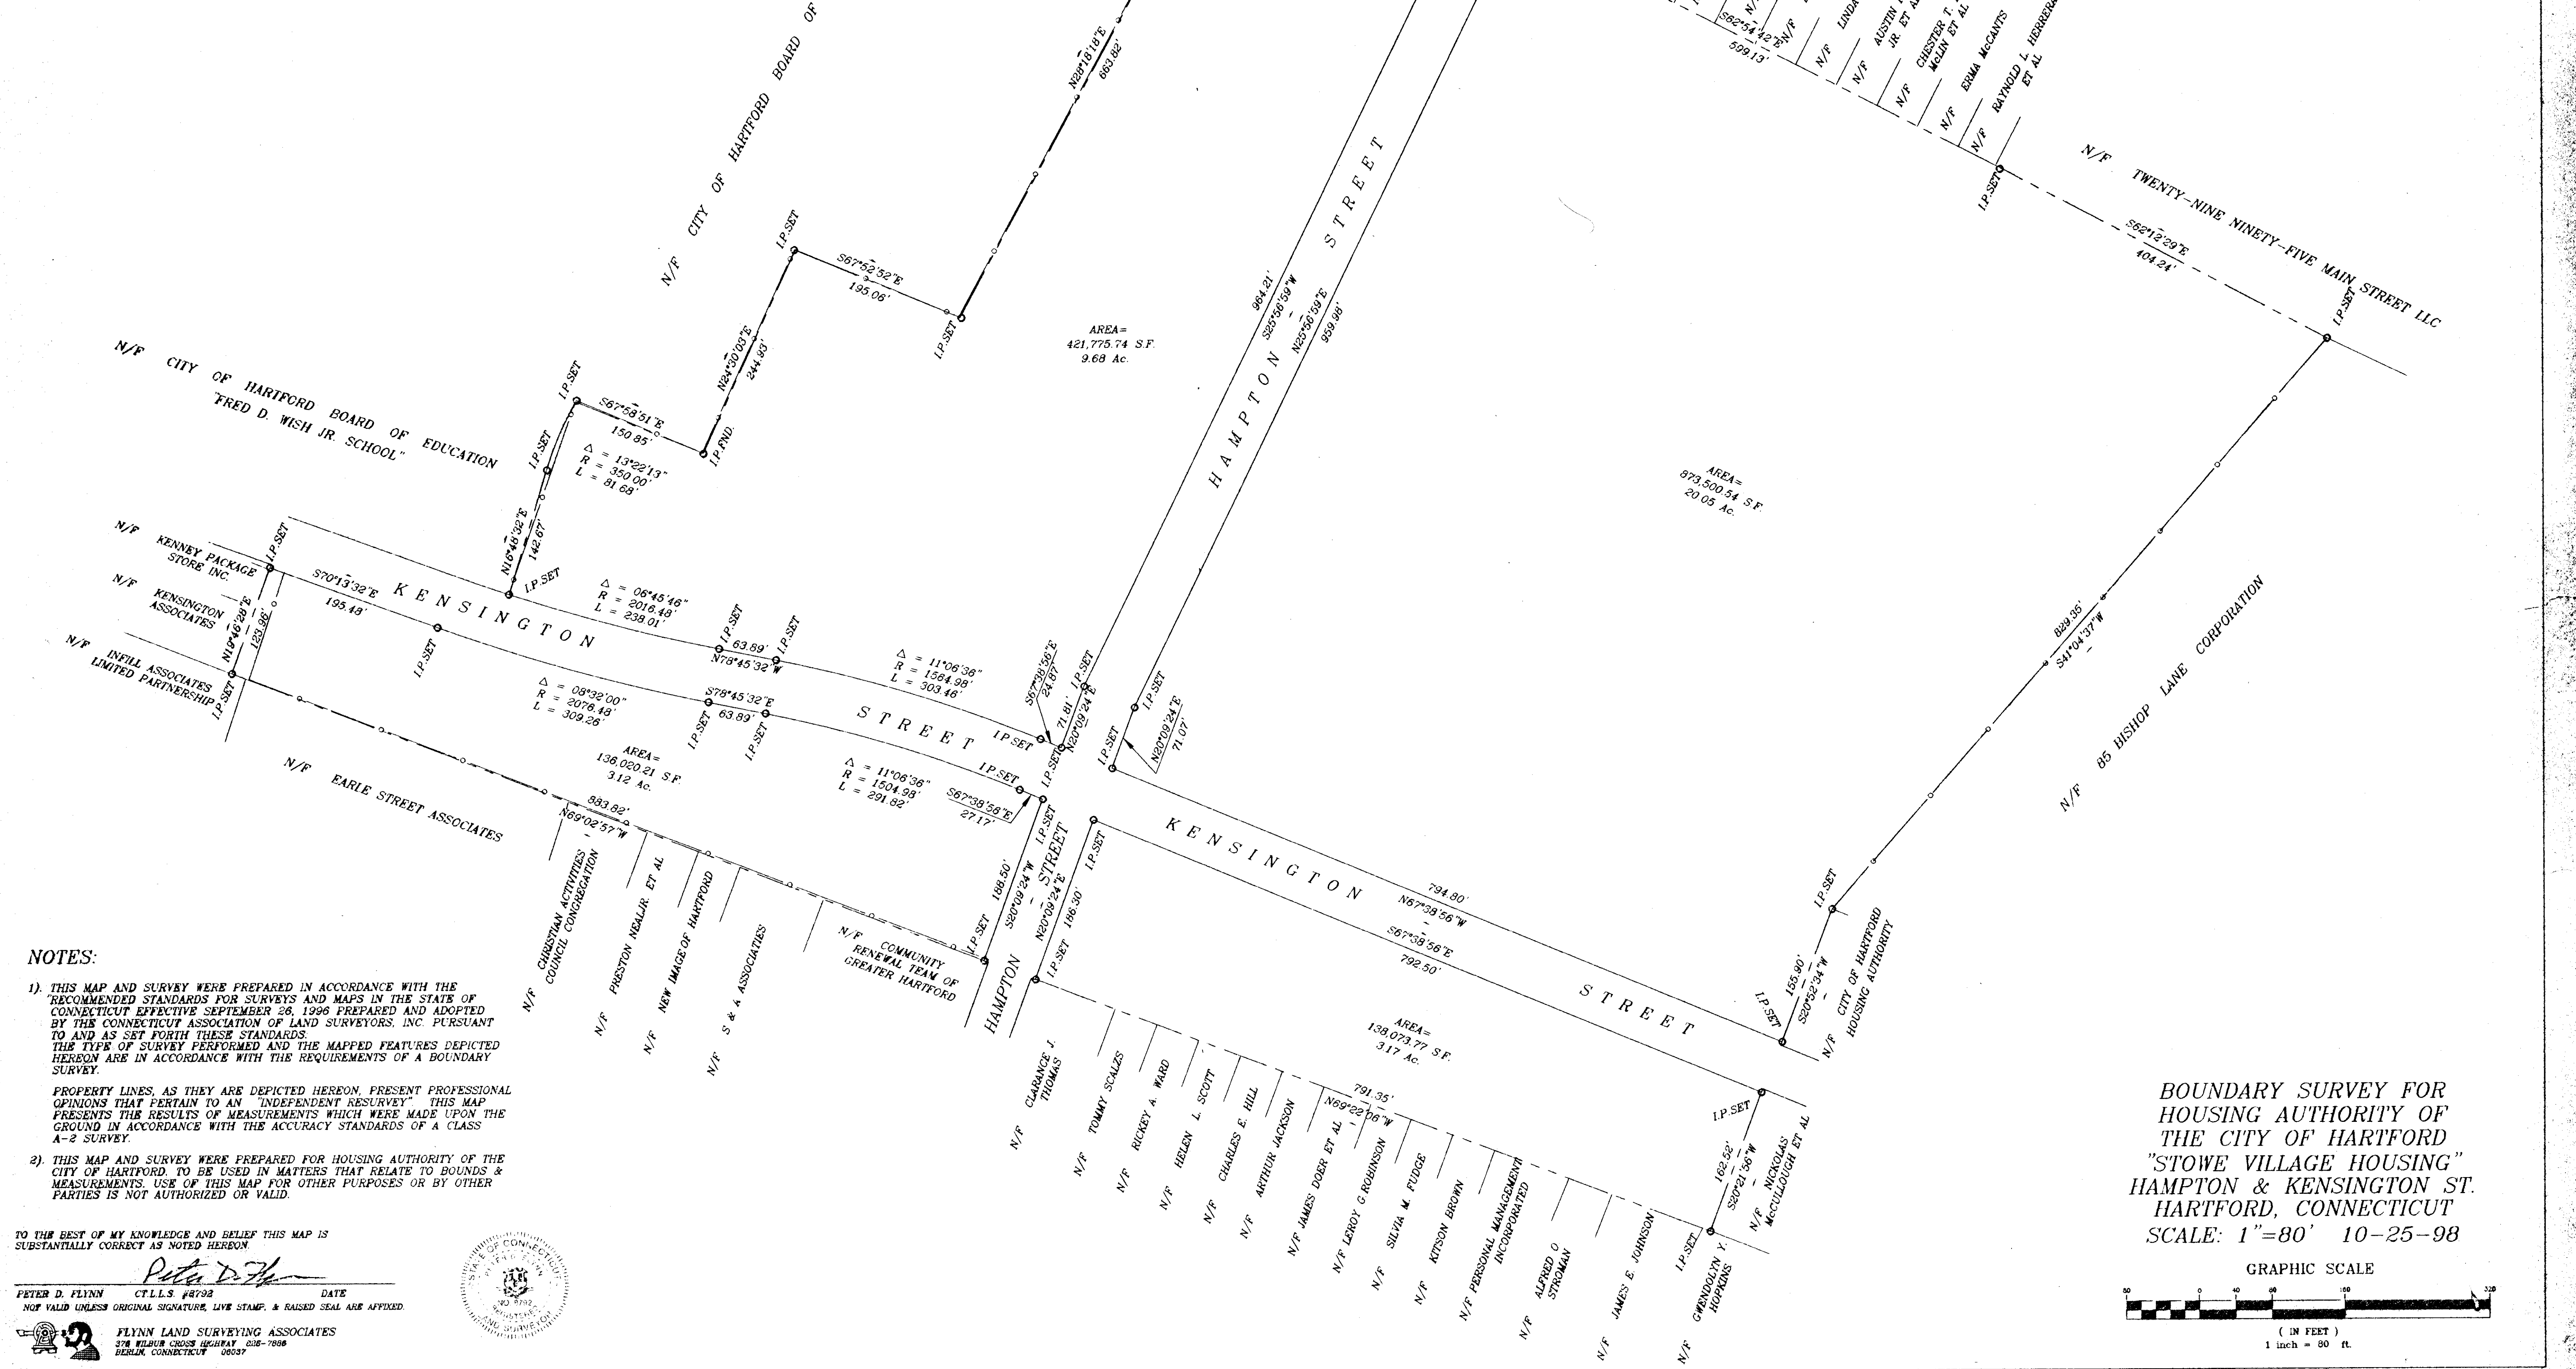

NOTES:


- 1). THIS MAP AND SURVEY WERE PREPARED IN ACCORDANCE WITH THE RECOMMENDED STANDARDS FOR SURVEYS AND MAPS IN THE STATE OF CONNECTICUT EFFECTIVE SEPTEMBER 26, 1996 PREPARED AND ADOPTED BY THE CONNECTICUT ASSOCIATION OF LAND SURVEYORS, INC. PURSUANT TO AND AS SET FORTH THESE STANDARDS. THE TYPE OF SURVEY PERFORMED AND THE MAPPED FEATURES DEPICTED HEREON ARE IN ACCORDANCE WITH THE REQUIREMENTS OF A BOUNDARY SURVEY.
- 2). THIS MAP AND SURVEY WERE PREPARED FOR HOUSING AUTHORITY OF THE CITY OF HARTFORD. TO BE USED IN MATTERS THAT RELATE TO BOUNDS & MEASUREMENTS. USE OF THIS MAP FOR OTHER PURPOSES OR BY OTHER PARTIES IS NOT AUTHORIZED OR VALID.

PROPERTY LINES, AS THEY ARE DEPICTED HEREON, PRESENT PROFESSIONAL OPINIONS THAT PERTAIN TO AN "INDEPENDENT RESURVEY" THIS MAP PRESENTS THE RESULTS OF MEASUREMENTS WHICH WERE MADE UPON THE GROUND IN ACCORDANCE WITH THE ACCURACY STANDARDS OF A CLASS A-2 SURVEY.

TO THE BEST OF MY KNOWLEDGE AND BELIEF THIS MAP IS SUBSTANTIALLY CORRECT AS NOTED HEREON

Peter D. Flynn
PETER D. FLYNN C.T.L.S. #8792 DATE
NOT VALID UNLESS ORIGINAL SIGNATURE, LIVE STAMP, & RAISED SEAL ARE AFFIXED.

FLYNN LAND SURVEYING ASSOCIATES
378 WILBUR CROSS HIGHWAY 036-7886
BERLIN, CONNECTICUT 06037

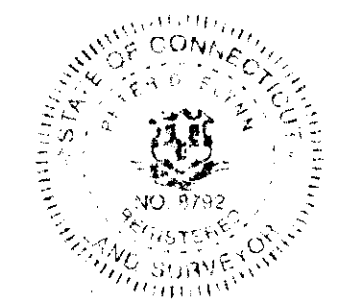

BOUNDARY SURVEY FOR
HOUSING AUTHORITY OF
THE CITY OF HARTFORD
"STOWE VILLAGE HOUSING"
HAMPTON & KENSINGTON ST.
HARTFORD, CONNECTICUT
SCALE: 1"=80' 10-25-98

GRAPHIC SCALE
(IN FEET)
1 inch = 80 ft.