
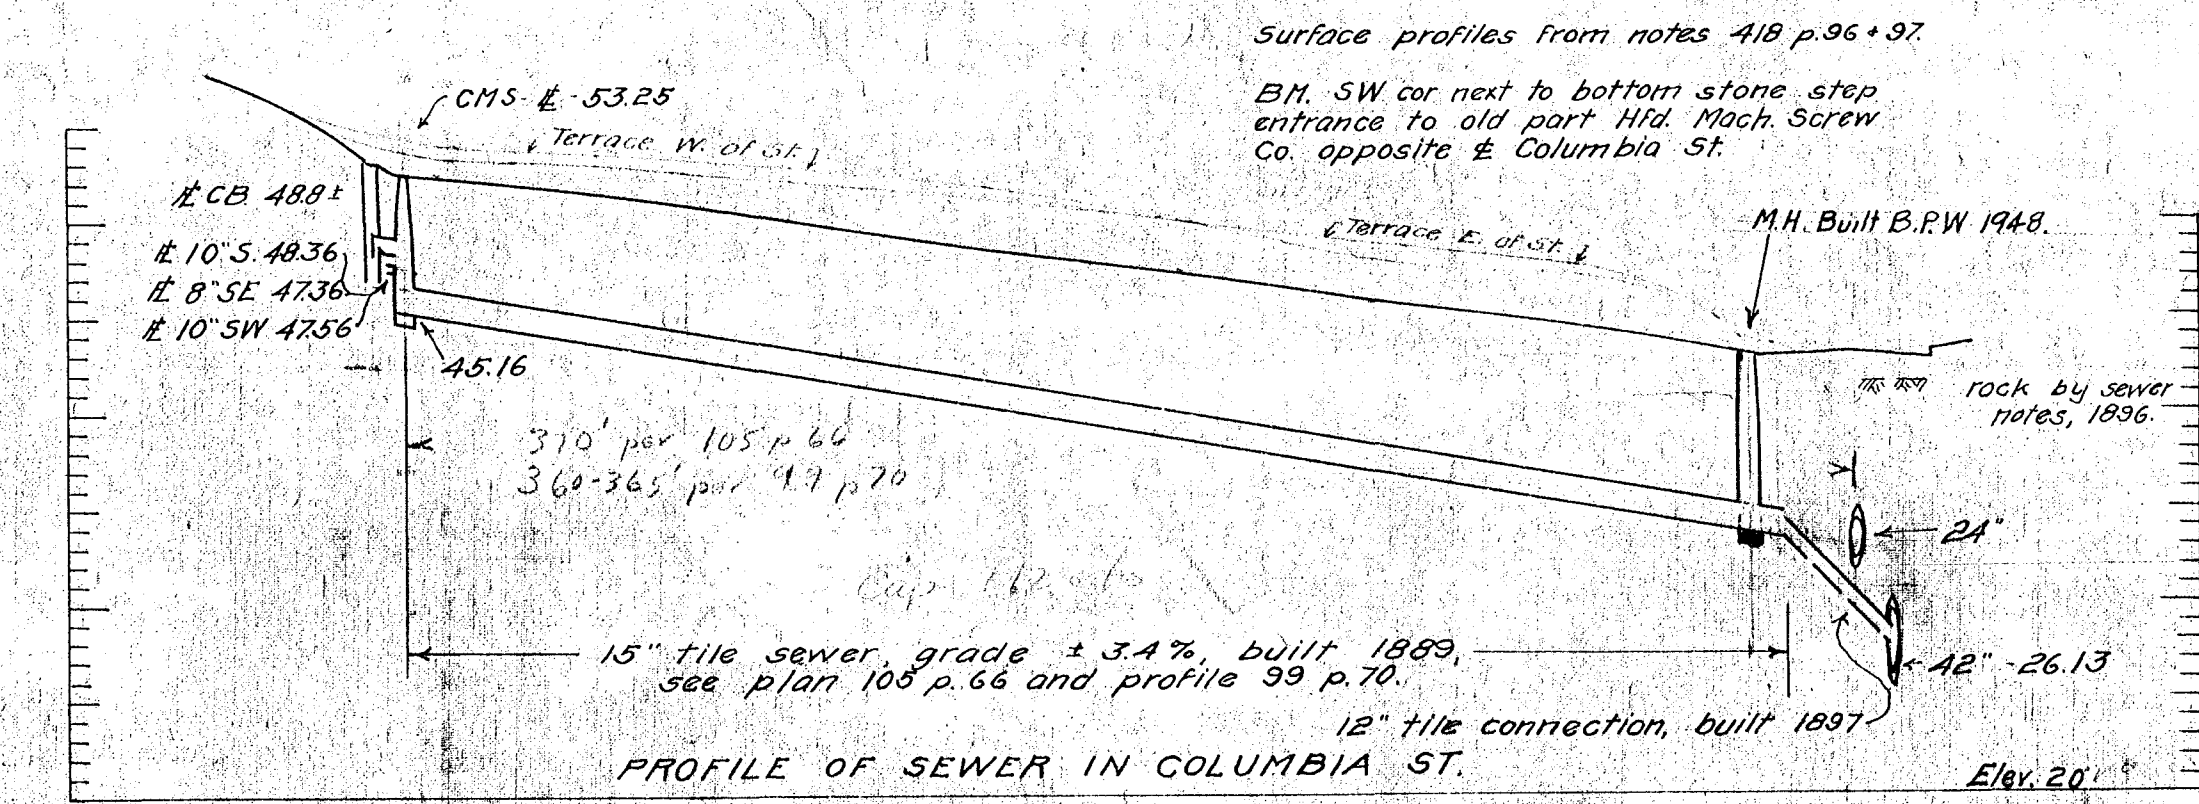
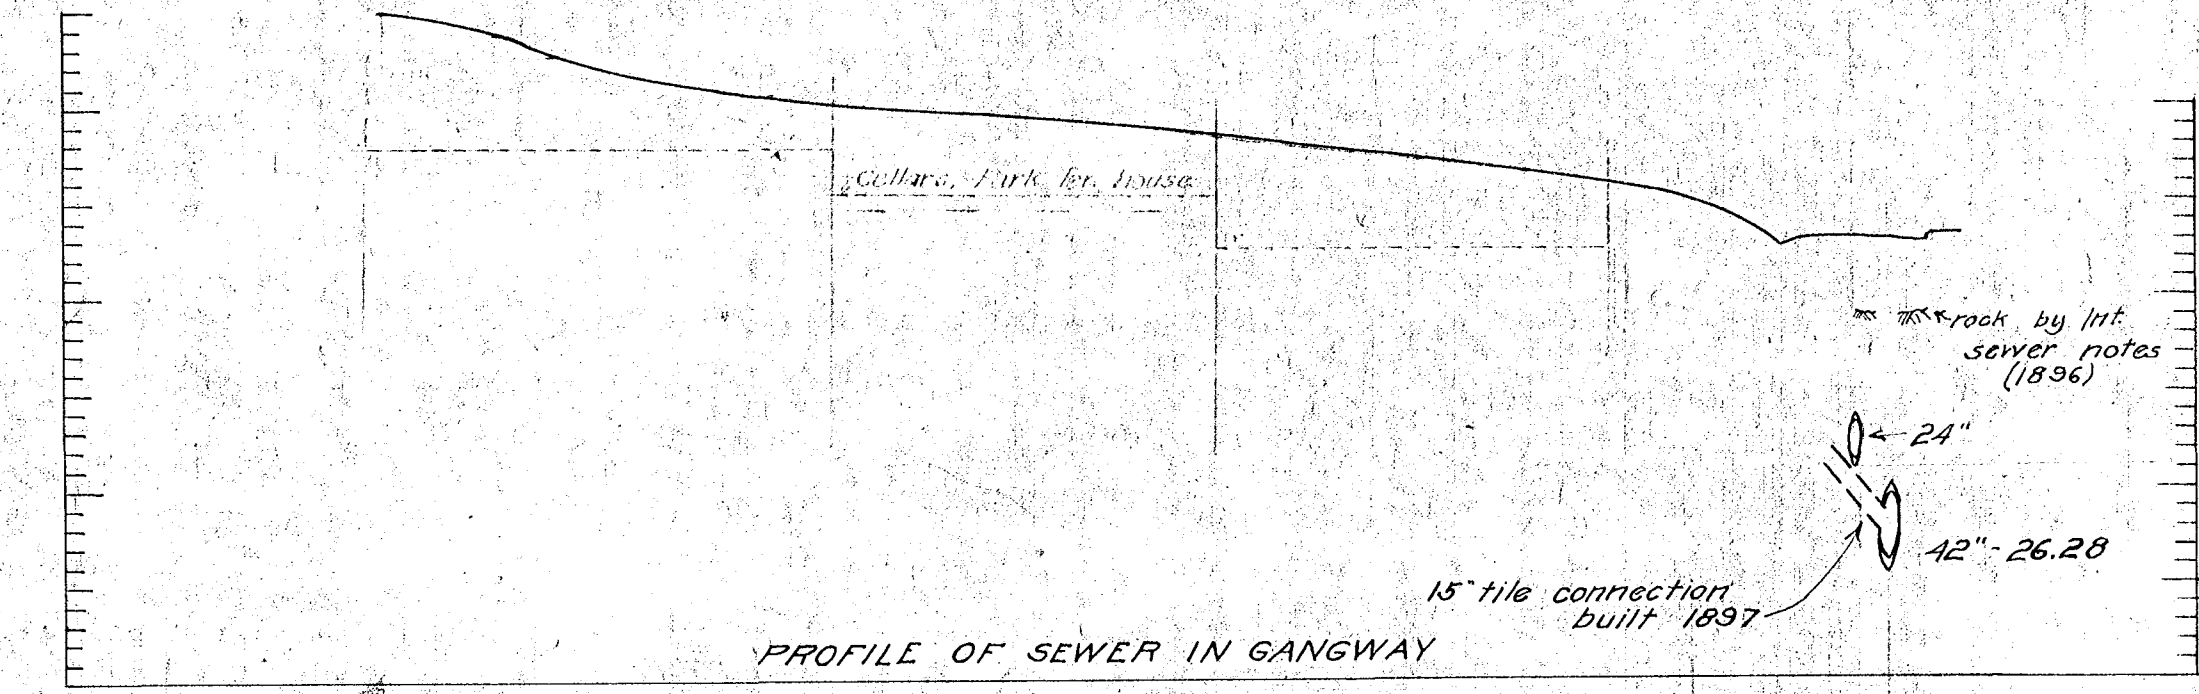


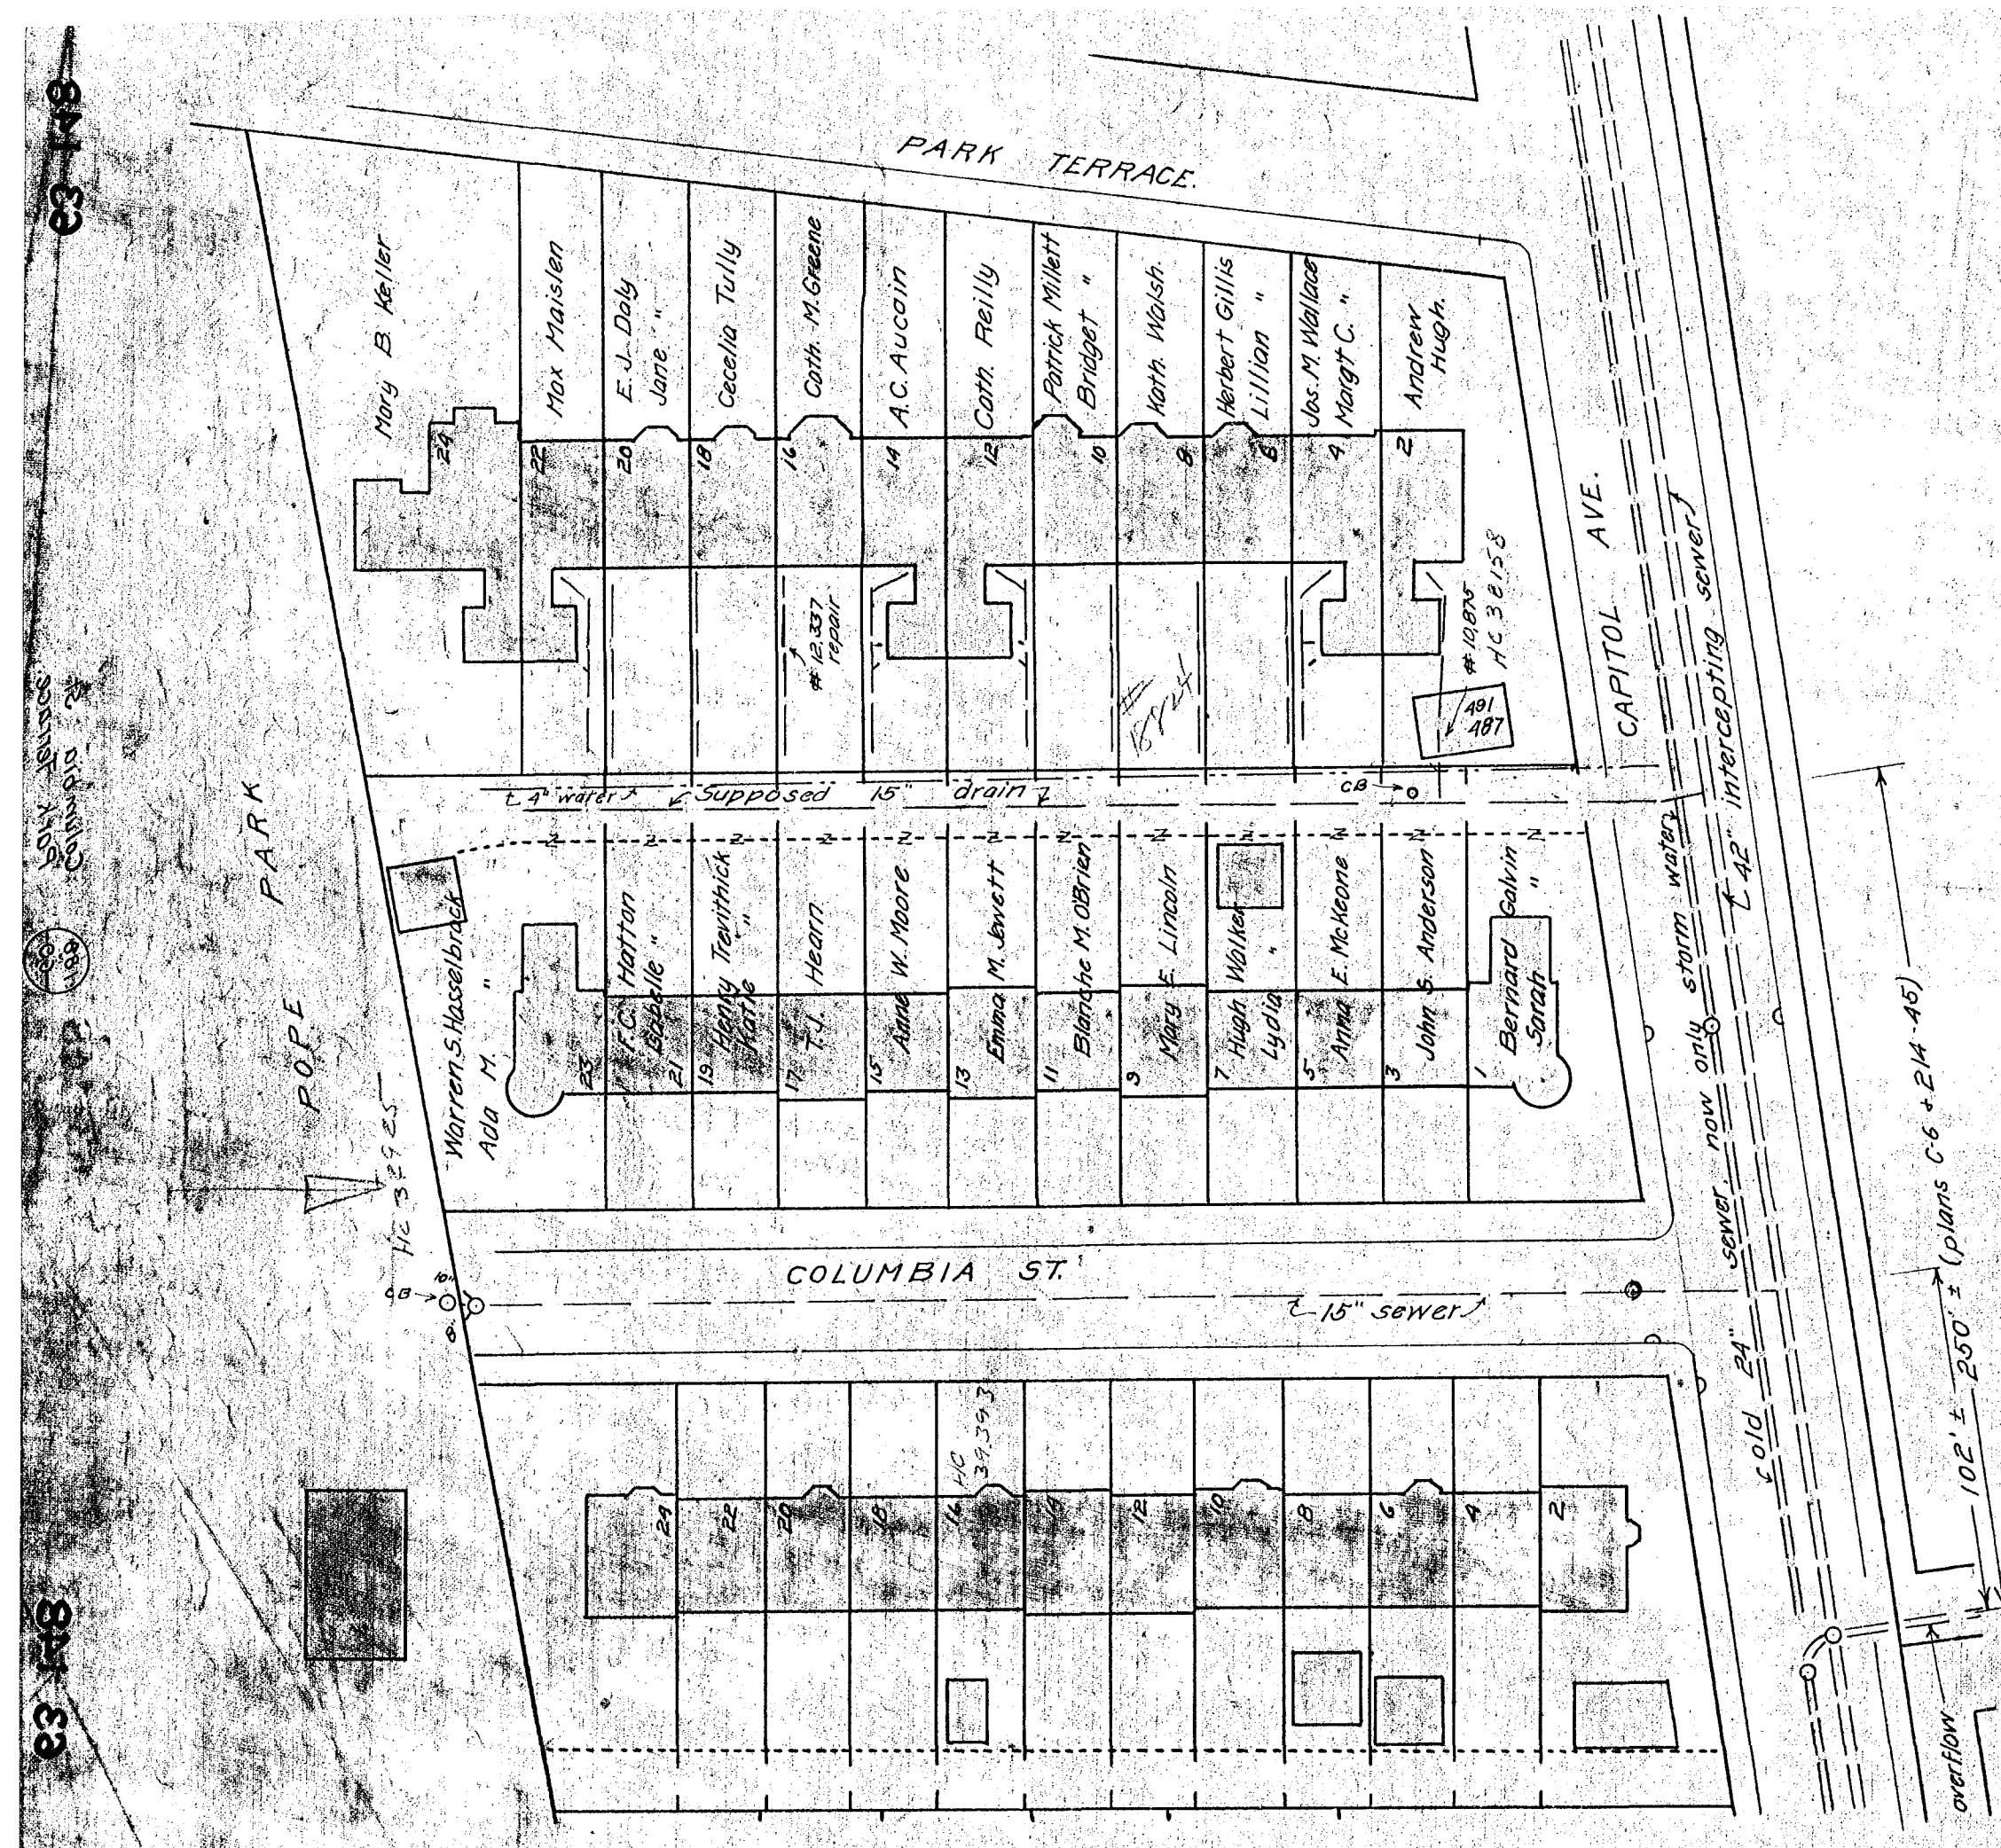

Department of Engineering, City of Hartford.  
 Day Book No. 06020. April 16, 1926.  
 Scales 1" = 50', 1" = 10'.