


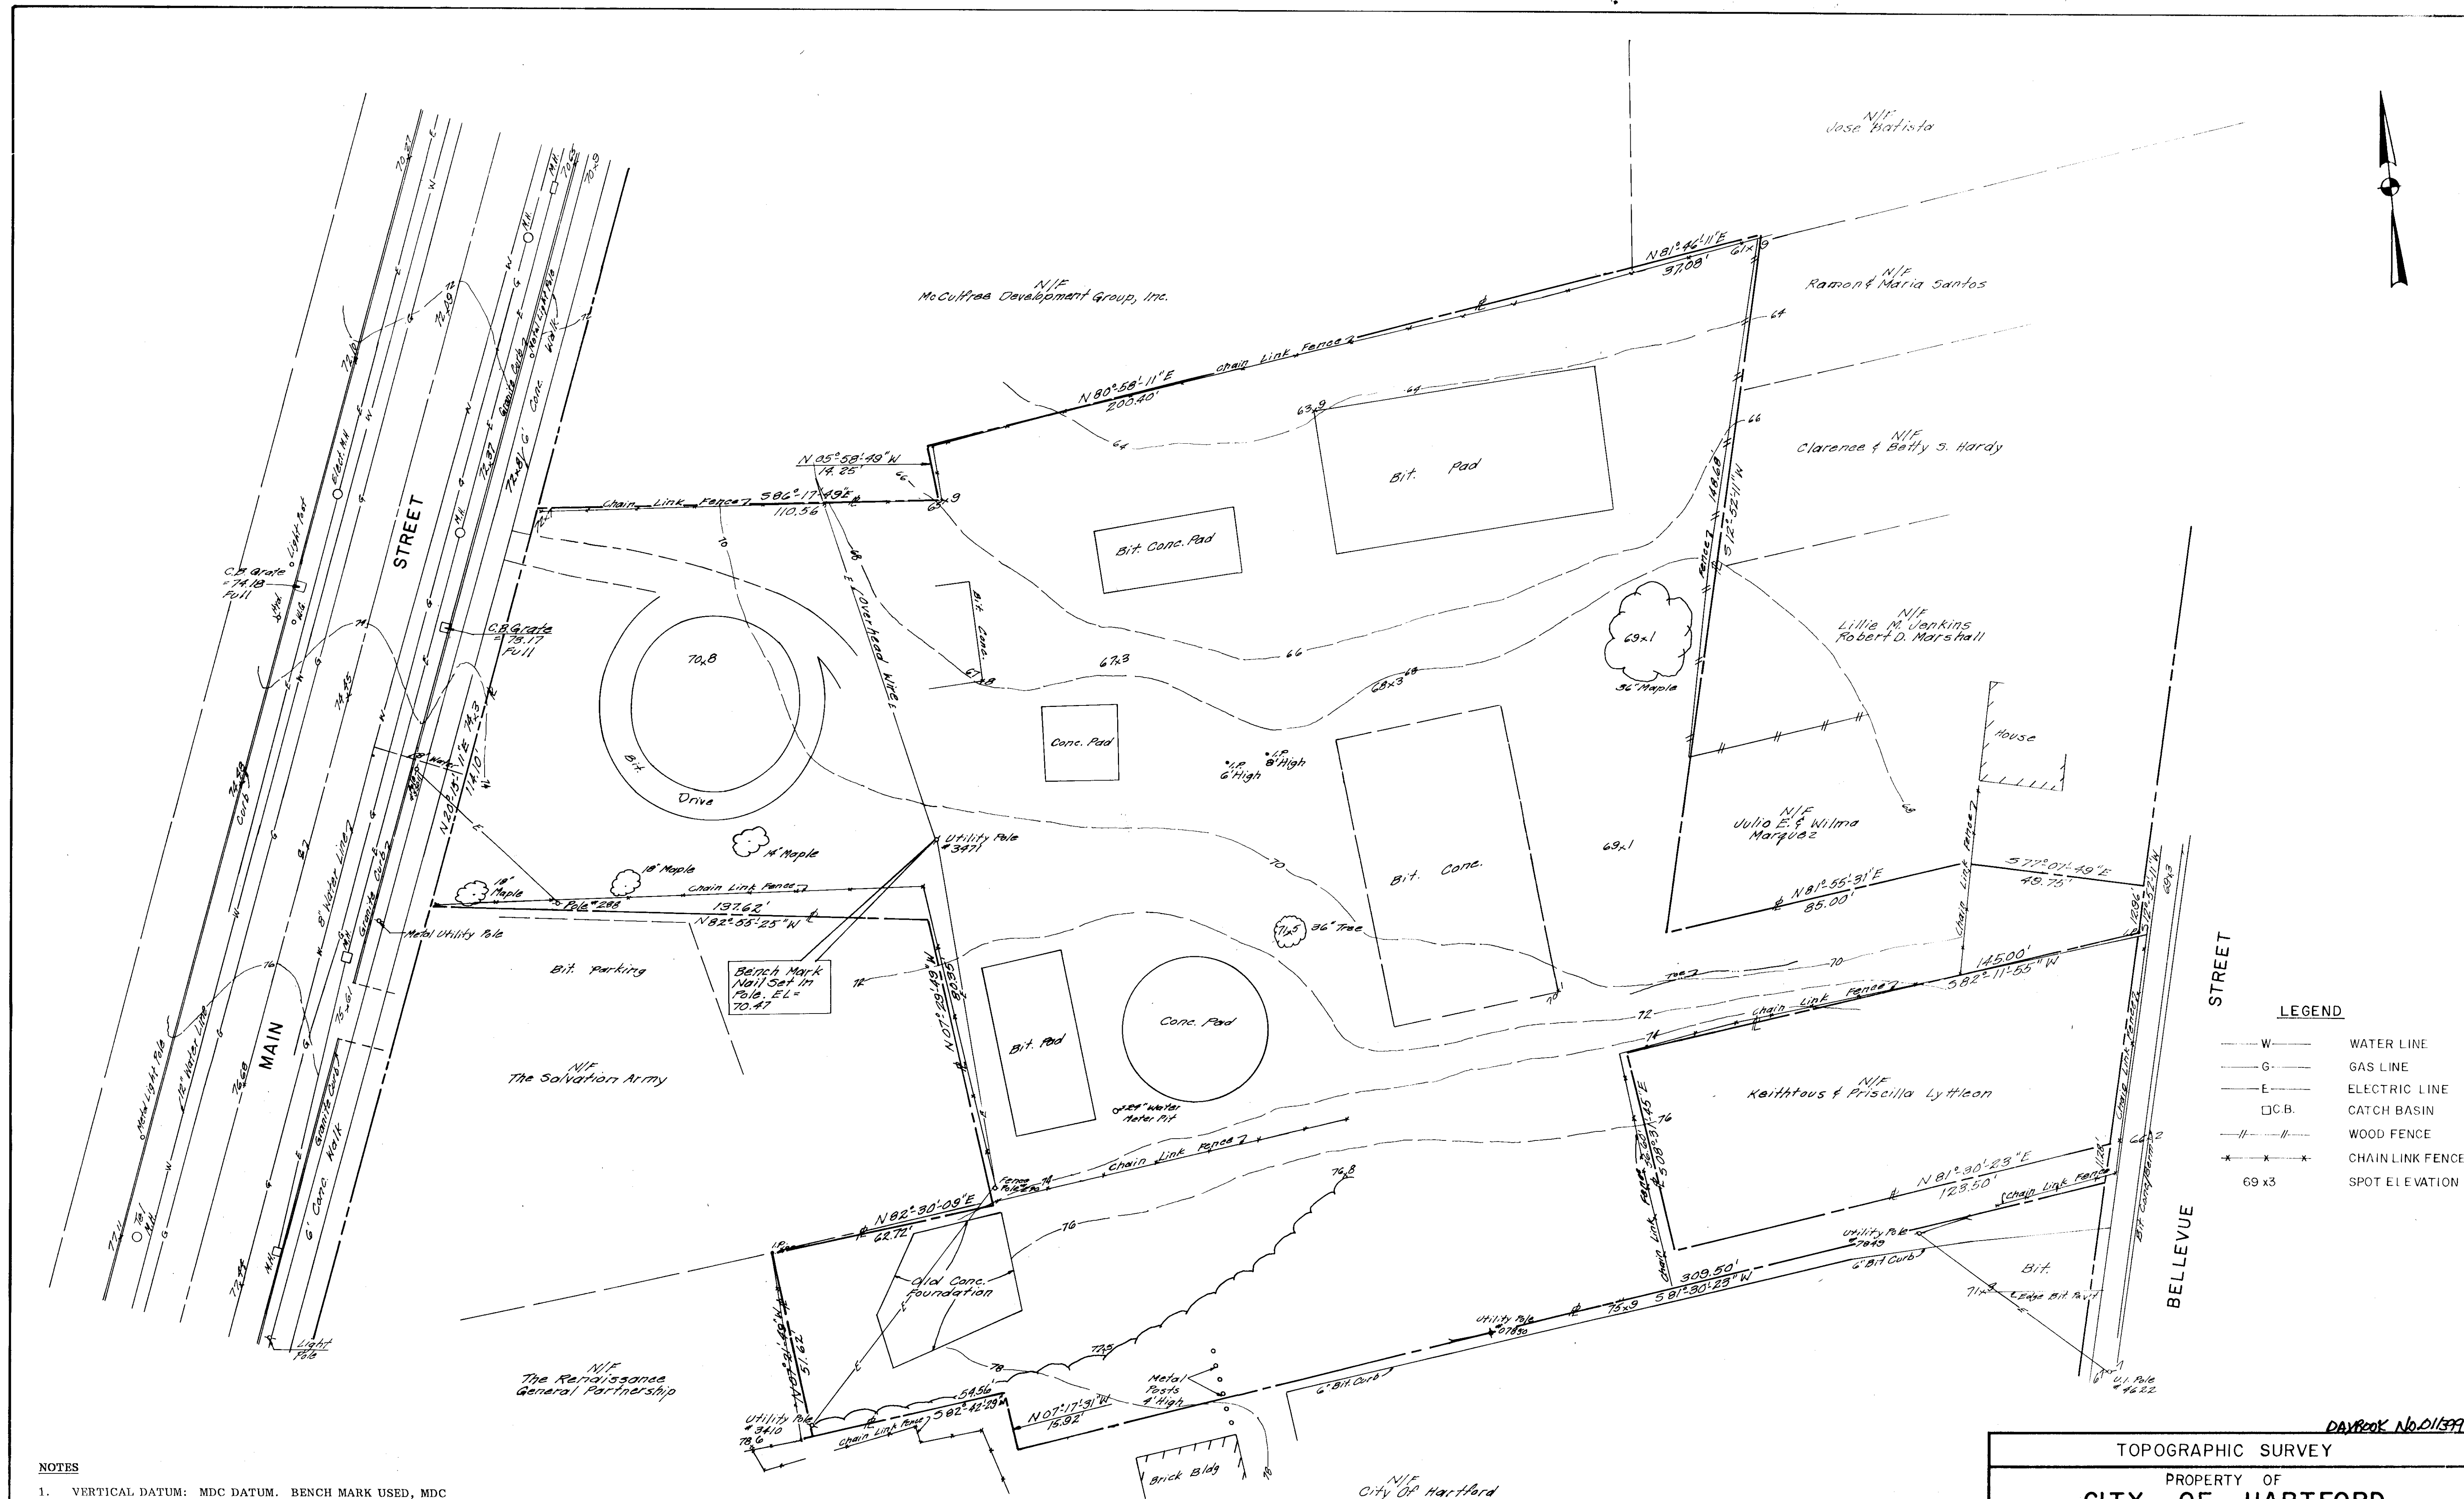


- NOTES
1. VERTICAL DATUM: MDC DATUM. BENCH MARK USED, MDC STATION X-6. ELEVATION = 91.146 MDC.
 2. REFER TO MAP ENTITLED "BOUNDARY SURVEY, PROPERTY OF CITY OF HARTFORD, 2196 MAIN STREET, HARTFORD, CONNECTICUT, NOVEMBER 16, 1990." BY FGA SERVICES, INC., NEW HAVEN, CONNECTICUT.
 3. UTILITY INFORMATION SHOWN HEREON IS BASED ON AVAILABLE UTILITY COMPANY RECORDS AND SURVEY INFORMATION FOUND IN THE FIELD. THE ACTUAL LOCATION AND DIRECTION OF ANY UNDERGROUND UTILITY LINE IS NOT CERTIFIED TO HEREON.



I HEREBY DECLARE THIS MAP TO BE SUBSTANTIALLY CORRECT AS TO THE PRECISION OF A T-2 TOPOGRAPHIC MAP AS DEFINED IN THE "RECOMMENDED STANDARDS FOR SURVEYS AND MAPS IN THE STATE OF CONNECTICUT" AS ADOPTED BY THE CONNECTICUT ASSOCIATION OF LAND SURVEYORS, INC. SEPTEMBER 13, 1984.

James E. Nagle
JAMES E. NAGLE, L.S. NO. 15195

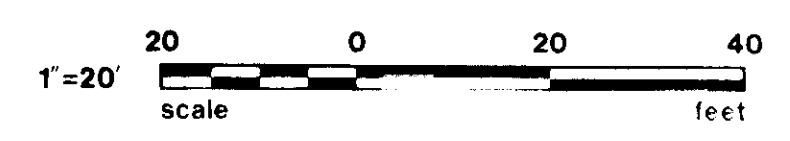

TOPOGRAPHIC SURVEY

PROPERTY OF
CITY OF HARTFORD
2196 MAIN STREET
HARTFORD, CONNECTICUT

FGA SERVICES, INC. consulting engineers	FGA Designed K.H.W.	J.E.N. Approved Date 11-12-90	Scale 1" = 20'
A Member of The Colson Group Incorporated New Haven, Hartford, Ansonia Connecticut Serving the State of Connecticut	Drawn W.P. Checked	Date 88-135-25 Project No.	Sheet No.