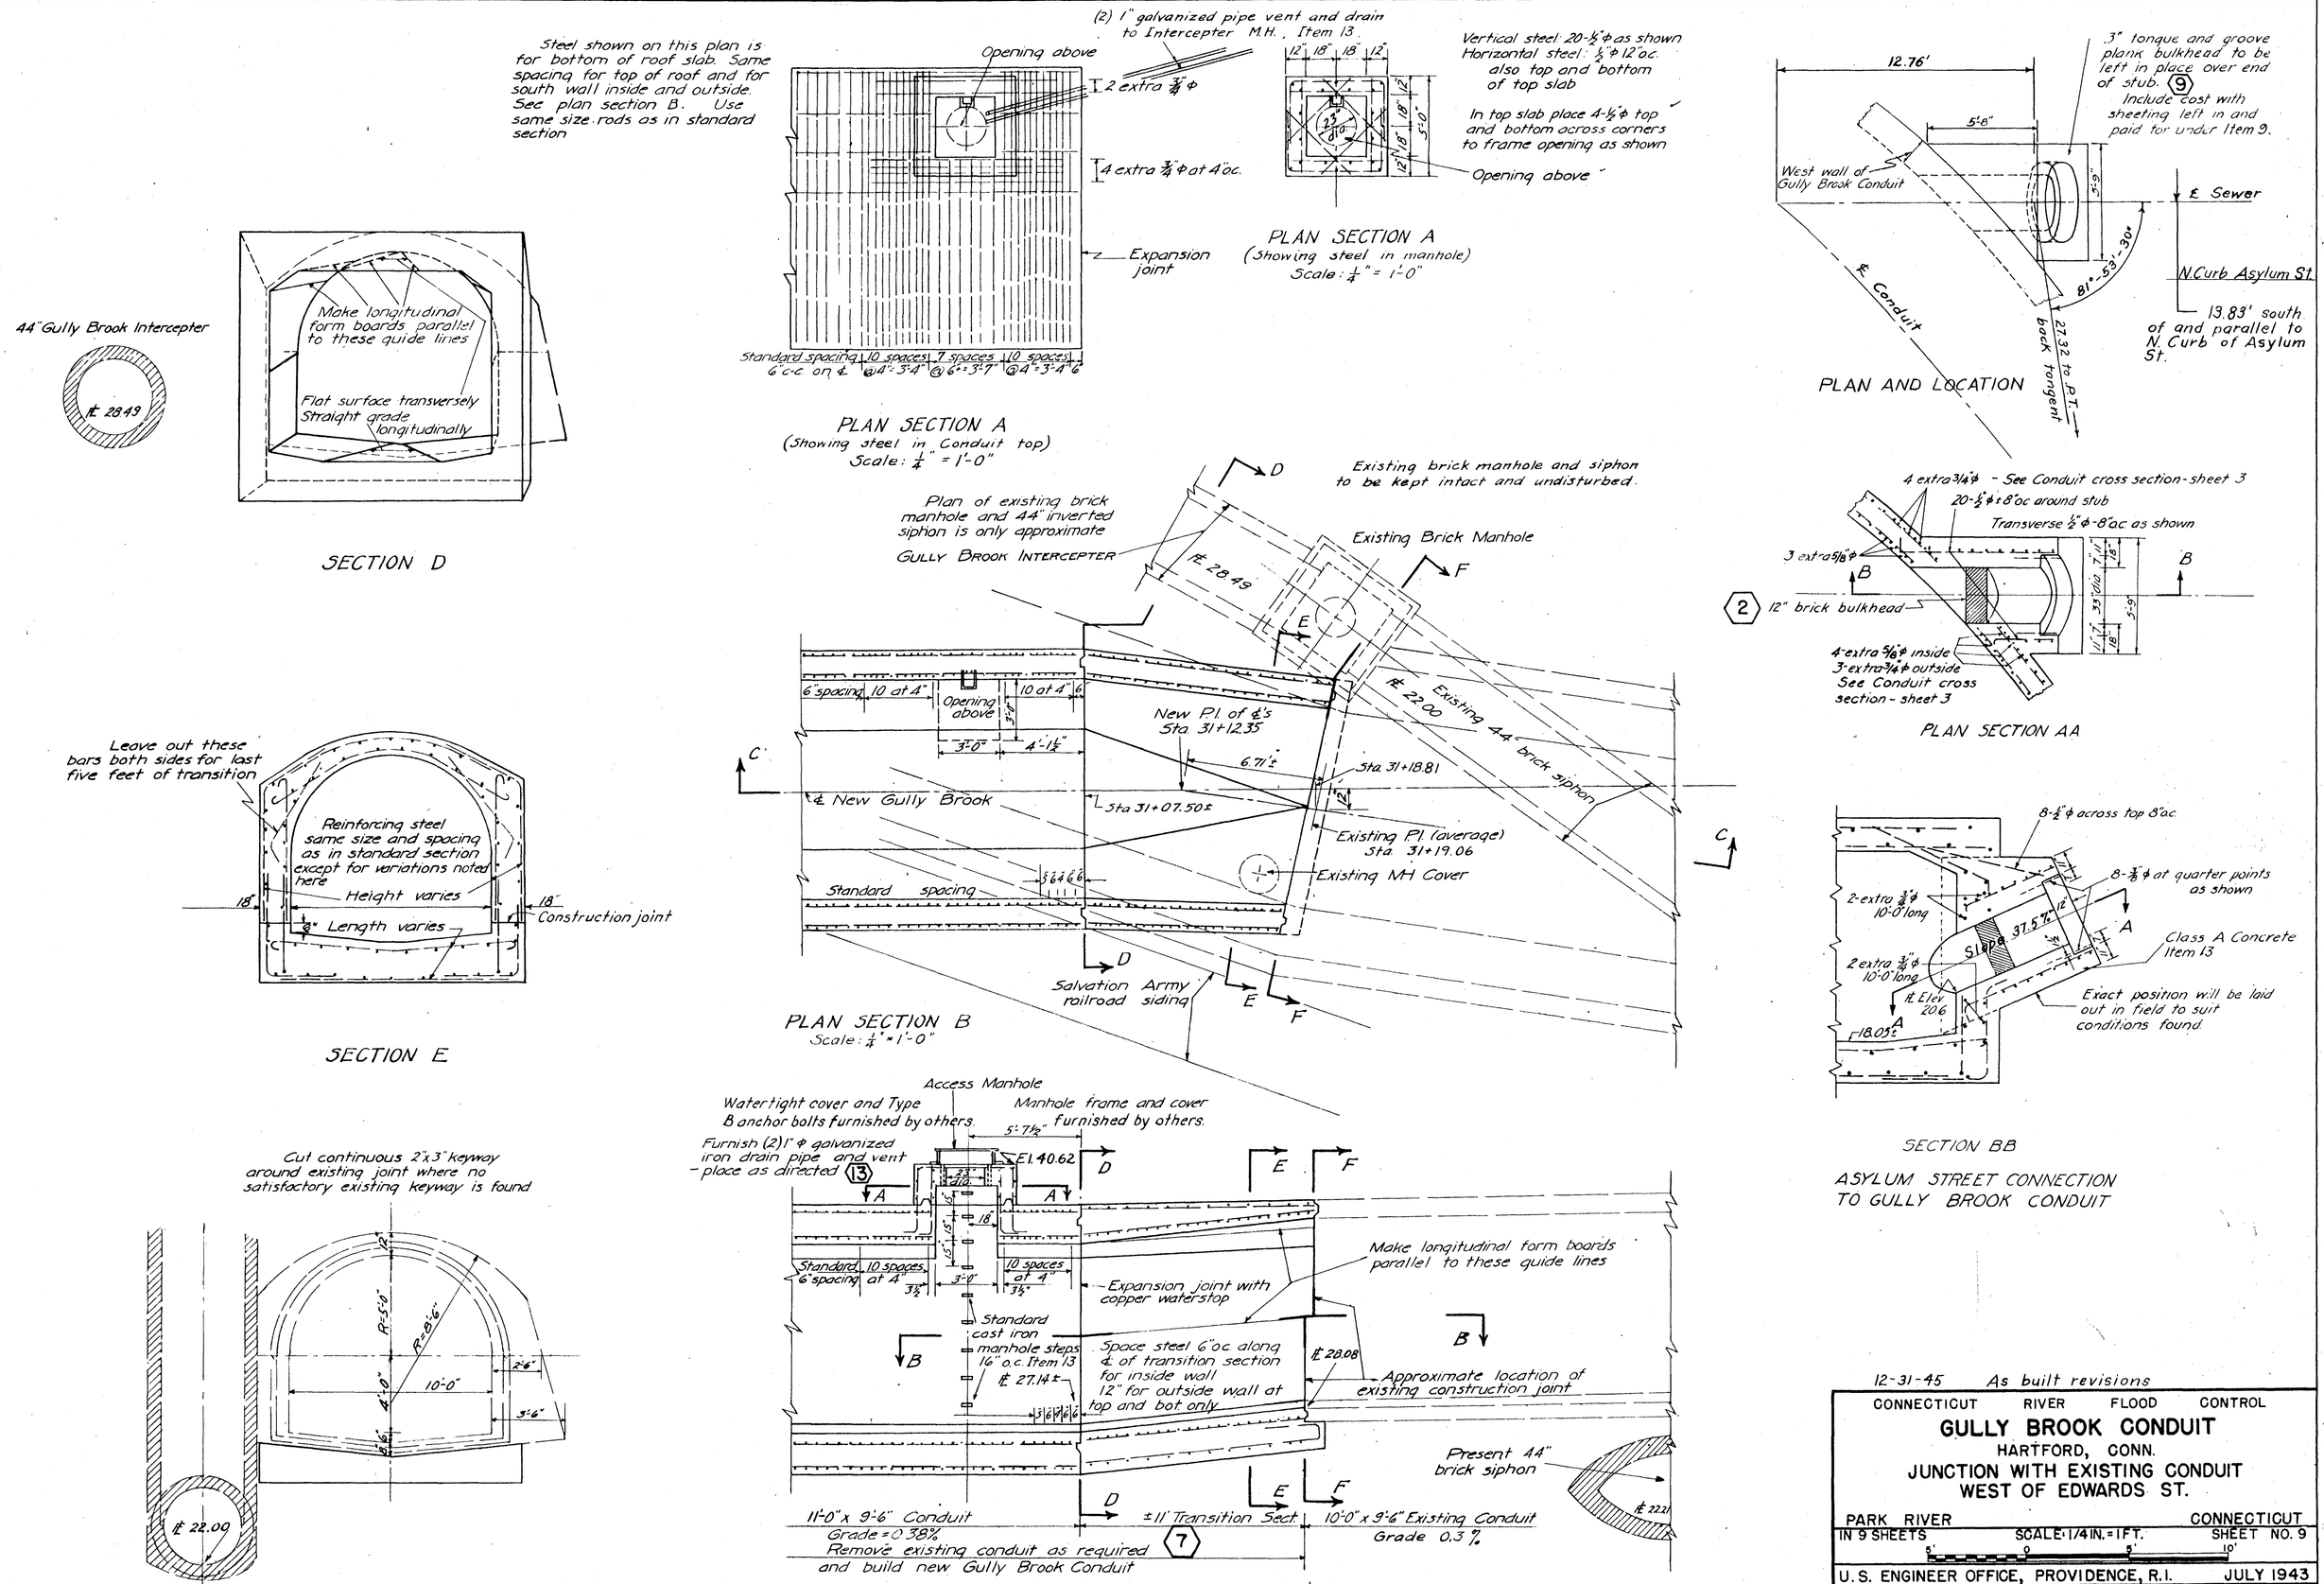

12-31-45 As built revisions

CONNECTICUT RIVER FLOOD CONTROL

GULLY BROOK CONDUIT

HARTFORD, CONN.

JUNCTION WITH EXISTING CONDUIT WEST OF EDWARDS ST.

PARK RIVER — CONNECTICUT

IN 9 SHEETS — SCALE: 1/4 IN. = 1 FT. — SHEET NO. 9

U.S. ENGINEER OFFICE, PROVIDENCE, R.I. — JULY 1943

REVIEWED BY:	APPROVAL RECOMMENDED:	APPROVED:
E. M. Vincent ENGINEER	L. Burns PRINCIPAL ENGINEER CHIEF F. C. PLANNING DIV.	LT. COL. CORPS OF ENGINEERS DISTRICT ENGINEER

BASIC DESIGN BY THE CITY OF HARTFORD	DRAWN: W.G.D. TRACED: H.E.O. CHECKED: A.W.S.	FILE NO. CT-4-3157