
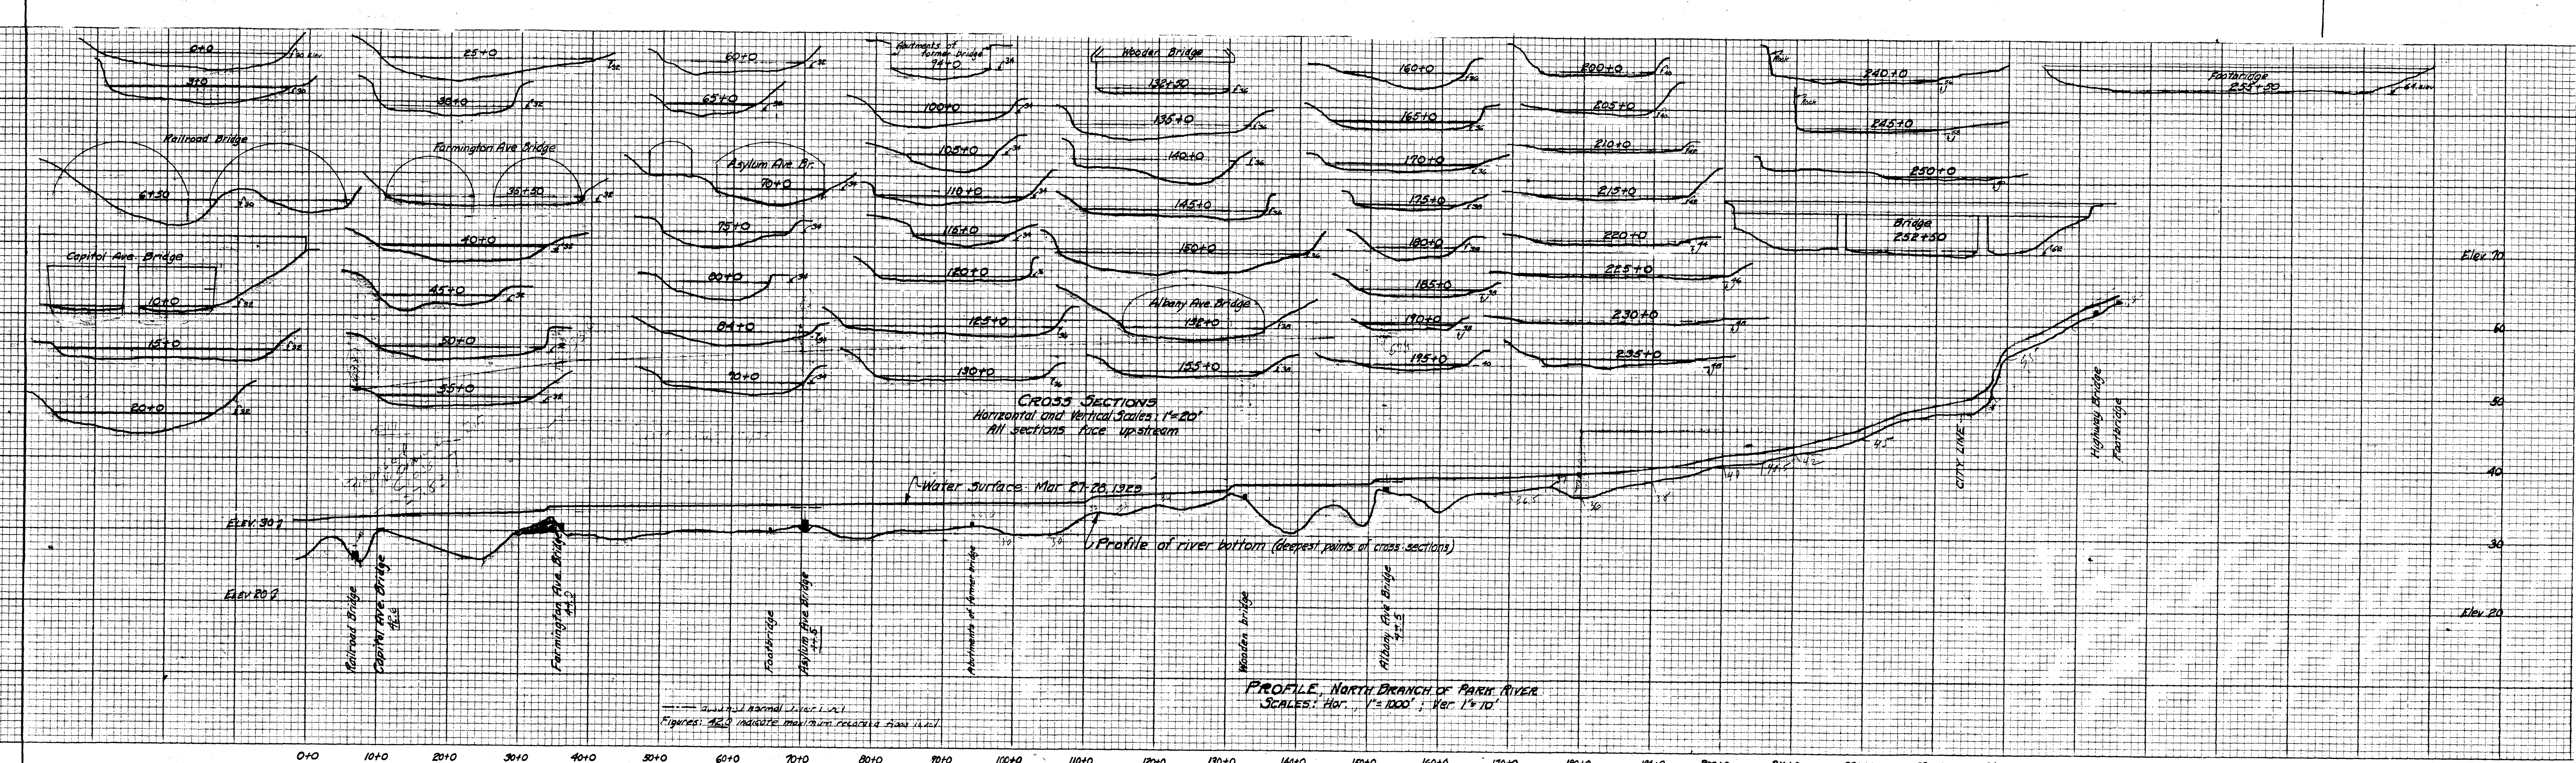
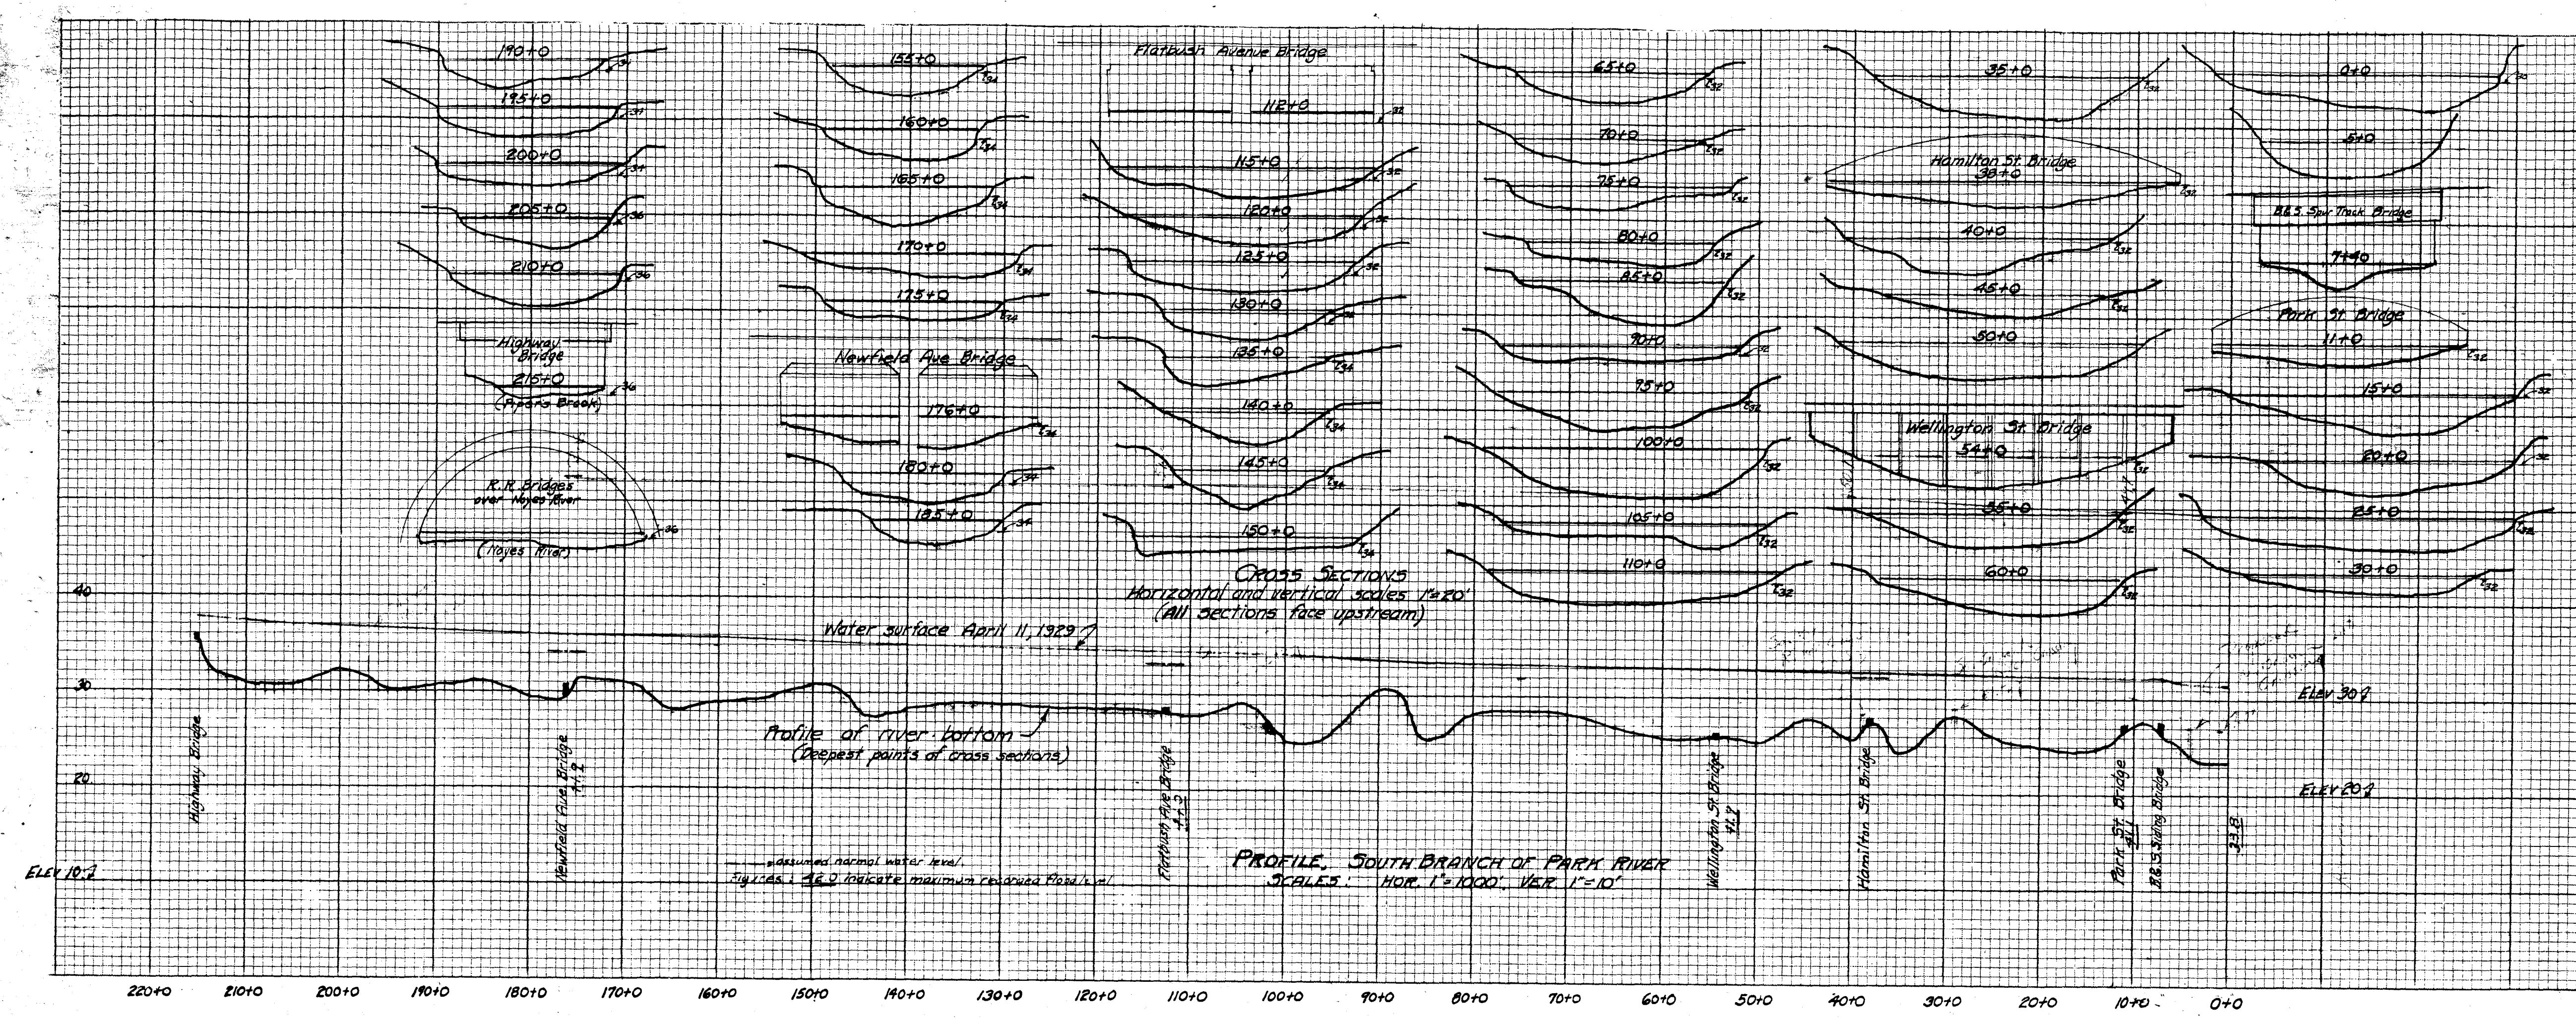
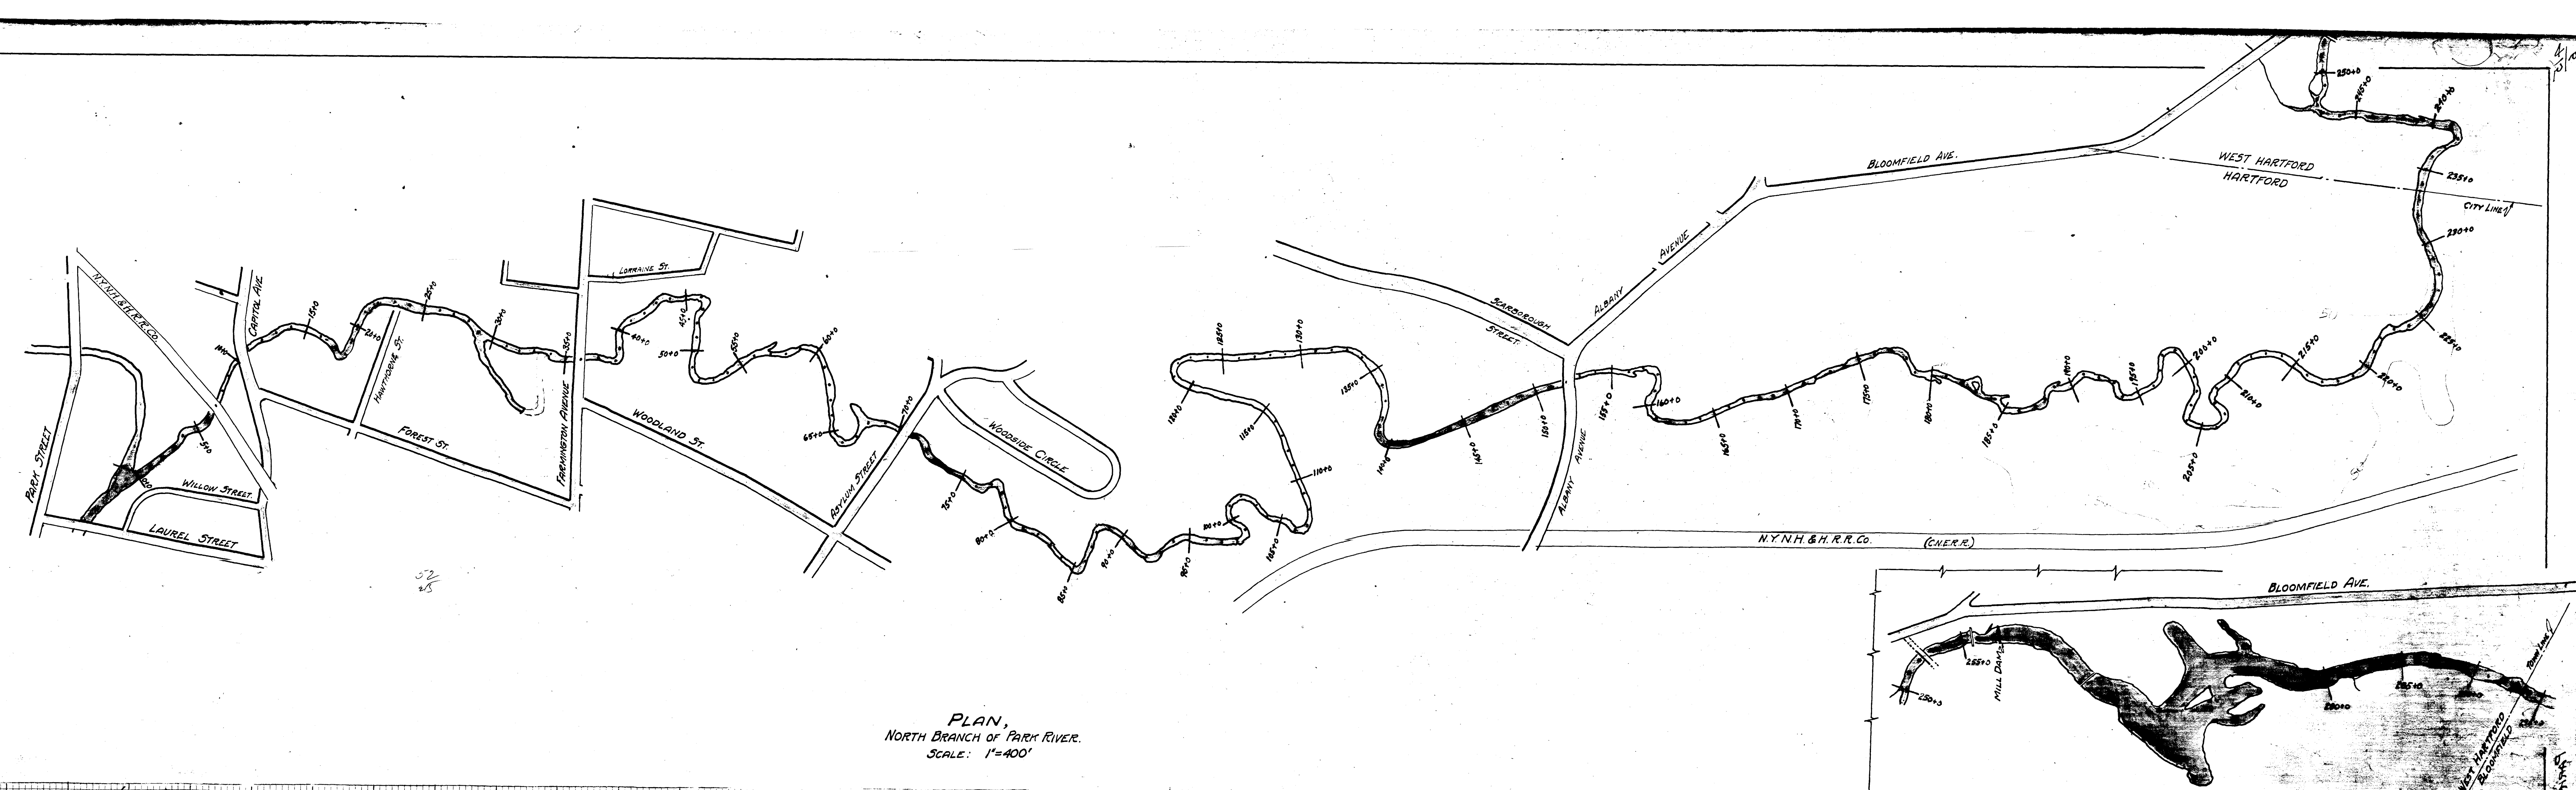


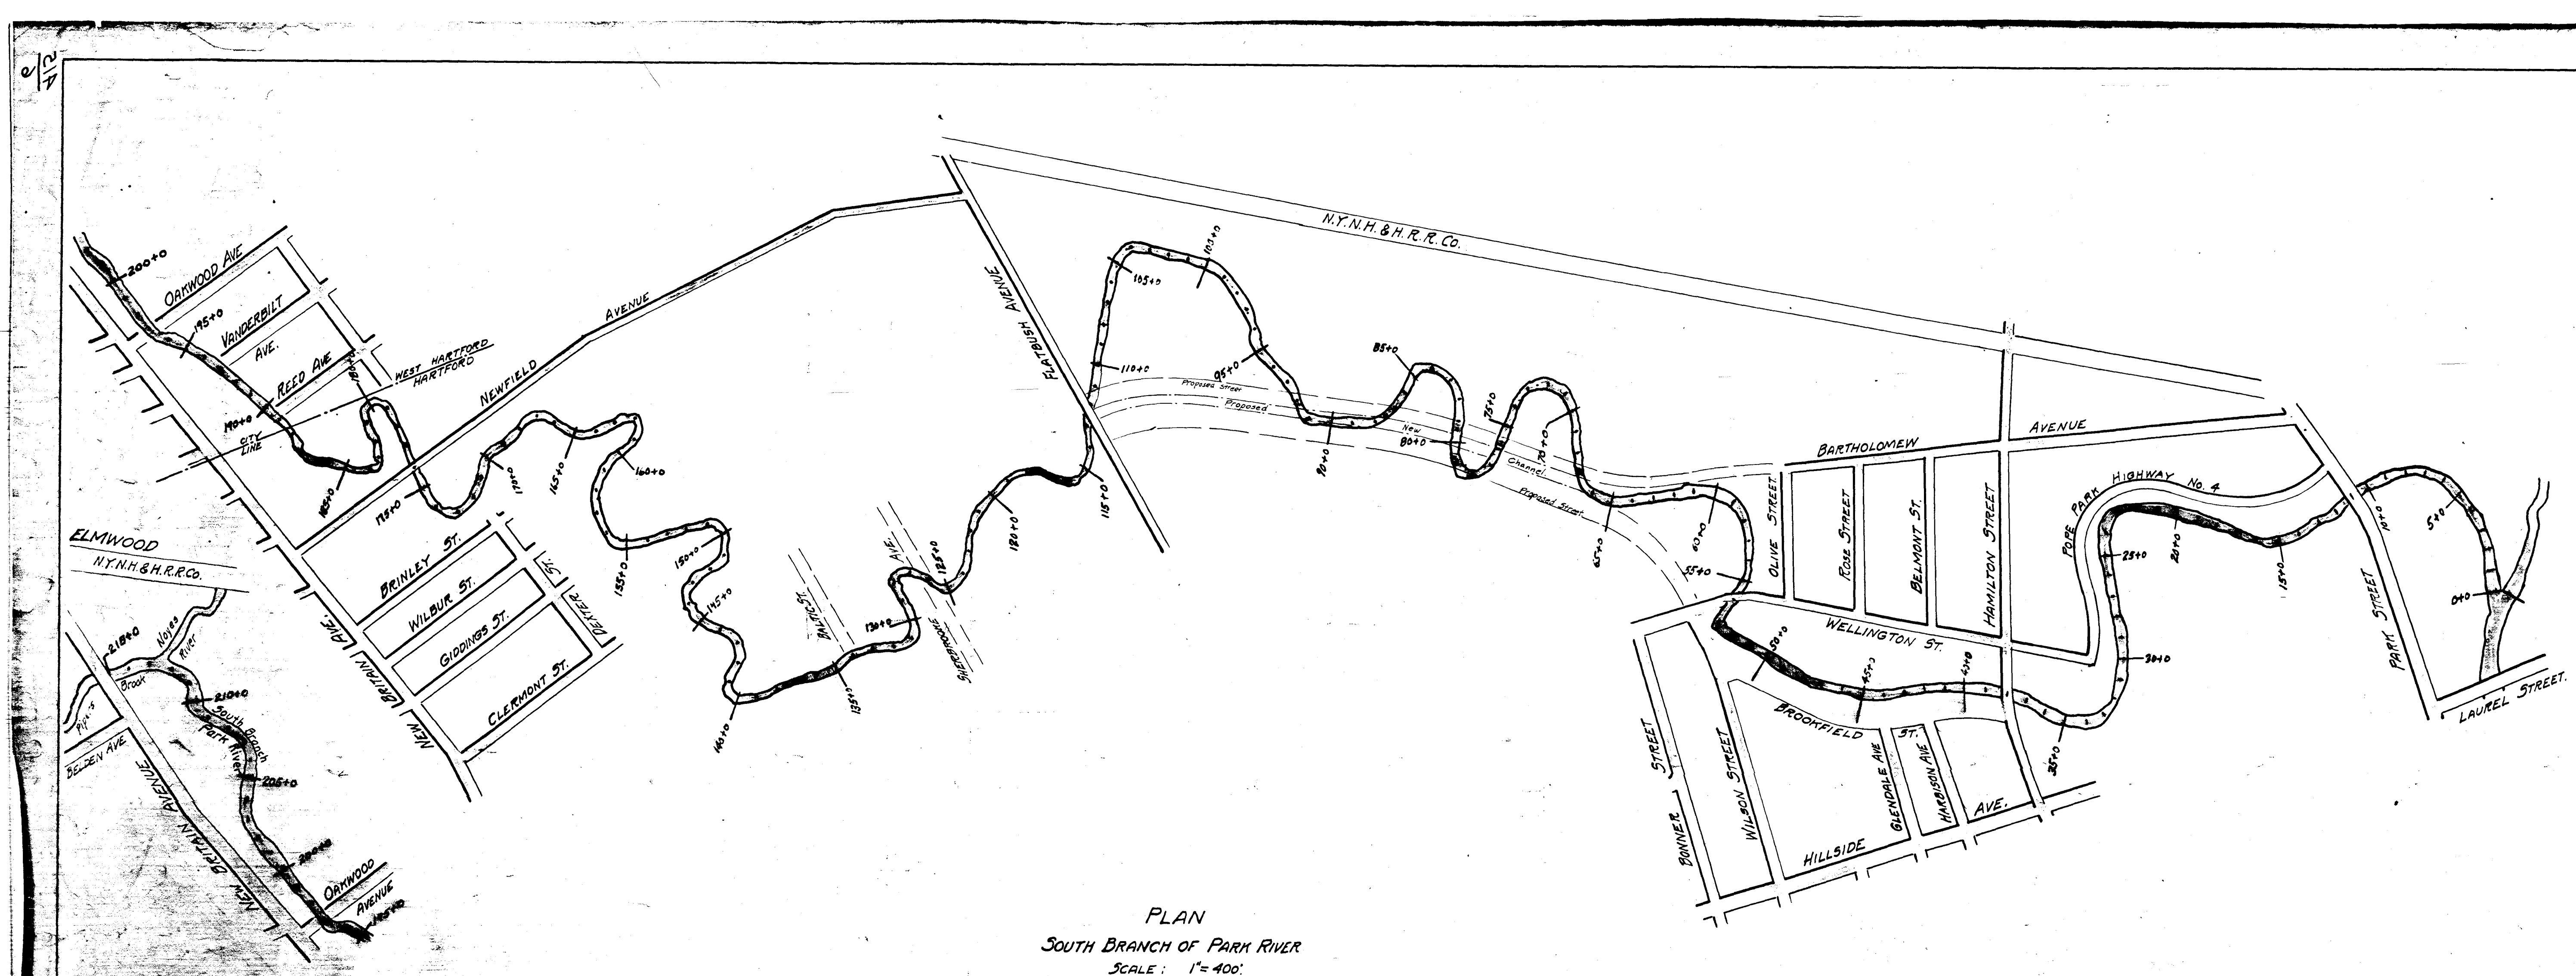

Levels and soundings taken on N. Branch March 27-28, 1929. Notes, Book 478, pp. 124-132.
Levels and soundings taken on S. Branch April 11, 1929. Notes, Book 478, pp. 133-139.
Plan within city limits traced from Aerial Survey Maps, outside of city from Town of West Hartford Maps. See also 371/4 (assess) Elevations of Bridges, etc. along Park River.

CITY OF HARTFORD
DEPARTMENT OF ENGINEERING
PLAN, PROFILE AND CROSS SECTIONS
OF THE
NORTH & SOUTH BRANCHES OF THE
PARK RIVER
Daybook No. 06596 April, 1929.
G.H.F.C. Serial No. 000489